

DURABLE 4 INCH WHITE LINE (SEE OPTION ITEMS)
 STA. A 22+75 - STA. A 28+75 (SOLID LT & RT)

TEMPORARY 4 INCH WHITE LINE, PAINT
 STA. A 22+75 - STA. A 28+75 (SOLID LT & RT)

6 INCH UNDERDRAIN PIPE
 STA. A 22+75 - STA. A 24+50 LT
 STA. A 24+68 - STA. A 27+75 LT A 27+72 LT

DURABLE 4 INCH YELLOW LINE (SEE OPTION ITEMS)
 STA. A 22+75 - STA. A 27+50 (DASHED LT, SOLID RT)
 STA. A 27+50 - STA. A 28+75 (SOLID LT & RT)



TEMPORARY 4 INCH YELLOW LINE, PAINT
 STA. A 22+75 - STA. A 27+50 (DASHED LT, SOLID RT)
 STA. A 27+50 - STA. A 28+75 (SOLID LT & RT)

SPECIAL PROVISION (CORING CONCRETE)
 STA. A 24+68 LT

REMOVING SIGNS
 AS SHOWN - 1

REMOVE AND RESET GUARDRAIL (DOUBLE-SIDED)
 STA. A 22+75 - STA. A 28+75 RT

THREATENED AND
 ENDANGERED SPECIES AREA

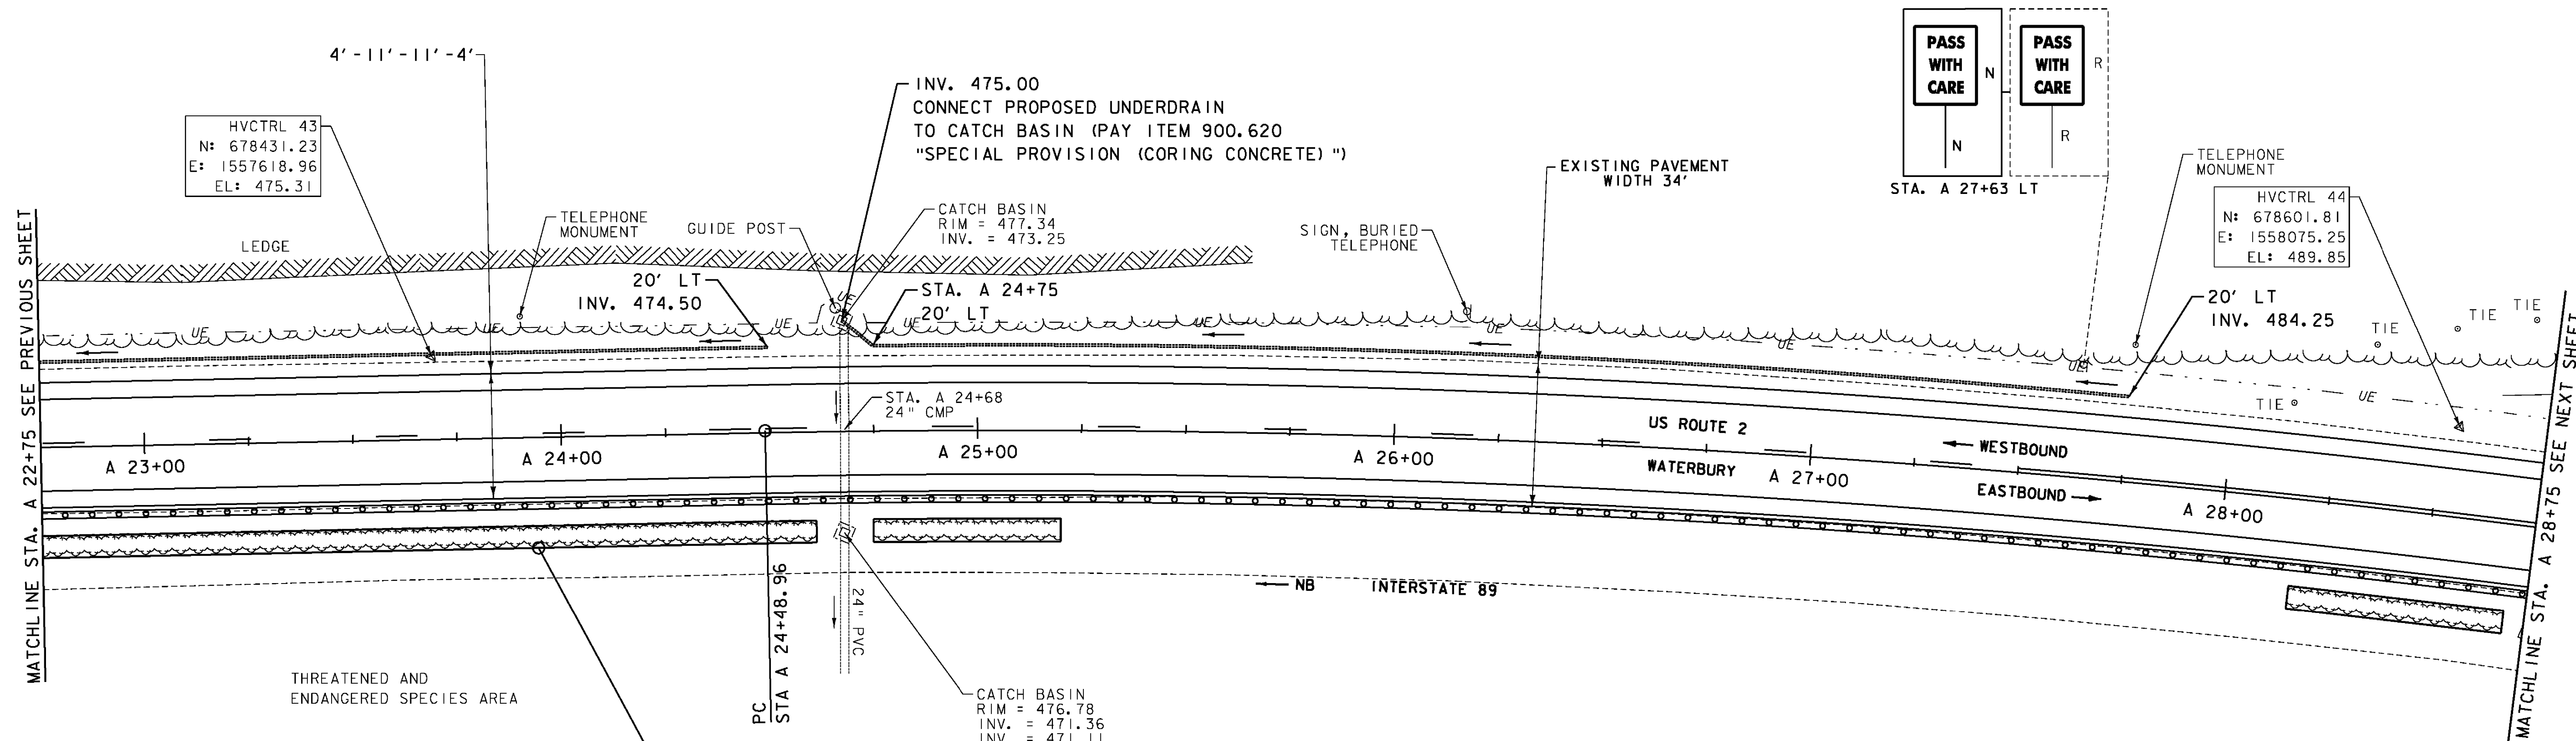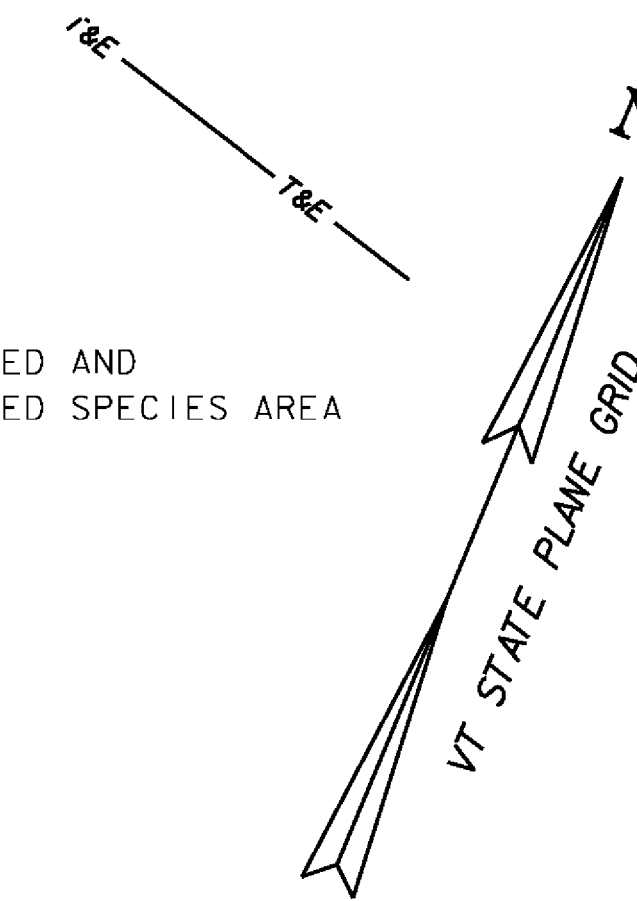

CONTRACTOR TO INSTALL TREE PROTECTION
 FENCE AROUND EXISTING TREE SCREENING
 PLANTING BEDS OR AS DIRECTED BY THE
 RESIDENT ENGINEER (TYP.).
 PAY ITEM 656.85 "TREE PROTECTION"

LEGEND

- MAILBOX
- BORING
- SIGN
- HYDRANT
- MANHOLE
- WATER SHUT OFF (WSO)
- GAS PIPELINE MARKER
- CATCH BASIN / DROP INLET
- CURB INLET
- TRAFFIC CONTROL BOX
- PARKING METER
- UTILITY POLE

SIGN LEGEND

- R = REMOVE
- R&S = REMOVE AND SALVAGE
- RET = RETAIN
- S = SALVAGE
- N = NEW
- B-B = BACK TO BACK
- = EXISTING
- = NEW

DATUM
 VERTICAL NAVD 88
 HORIZONTAL NAD 83

SCALE IN FEET
 20 0 20

**PROJECT
 LAYOUT
 SHEET 40**

PROJECT NAME: BOLTON - WATERBURY
 PROJECT NUMBER: STP 2709 (1)

FILE NAME: p07C172.dgn
 PROJECT LEADER: CDL
 DESIGNED BY: BMB
 PLOT FILE: p07C172_64.i

PLOT DATE: 4/16/2013
 DRAWN BY: JBC/BMB
 CHECKED BY: CDL
 SHEET 64 OF 217