

DURABLE 4 INCH WHITE LINE (SEE OPTION ITEMS)
STA. A 69+75 - STA. A 75+75 (SOLID LT & RT)

TEMPORARY 4 INCH WHITE LINE, PAINT
STA. A 69+75 - STA. A 75+75 (SOLID LT & RT)

REMOVING SIGNS
AS SHOWN - 2

DURABLE 4 INCH YELLOW LINE (SEE OPTION ITEMS)
STA. A 69+75 - STA. A 75+75 (SOLID LT & RT)

TEMPORARY 4 INCH YELLOW LINE, PAINT
STA. A 69+75 - STA. A 75+75 (SOLID LT & RT)

REHAB. DROP INLET, CATCH BASINS,
OR MANHOLES, CLASS 1
STA. A 73+00 LT

STONE FILL, TYPE I
STA. A 71+00 - STA. A 73+73 RT

REMOVAL AND DISPOSAL OF GUARDRAIL
STA. A 70+34 - STA. A 74+35 RT


GEOTEXTILE UNDER STONE FILL
STA. A 71+00 - STA. A 73+73 RT

STEEL BEAM GUARDRAIL, GALVANIZED W/8 FEET POSTS
STA. A 70+30 - STA. A 74+36.25 RT


GEOTEXTILE FOR SILT FENCE
STA. A 71+00 - STA. A 73+73 RT

GRUBBING MATERIAL
STA. A 71+00 - STA. A 73+73 RT


CURVE #10
DELTA = 0°14'00"
D = 0°17'11"
R = 20000.00'
T = 40.70'
L = 81.40'
E = 0.04'
BANKING NORMAL CROWN
DESIGN SPEED 50 MPH
SEE SUPERELEVATION DIAGRAMS
FOR MORE INFORMATION

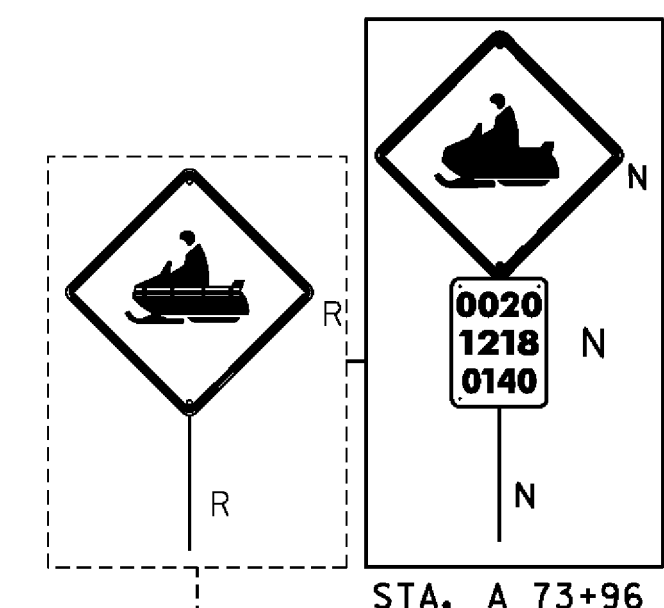

STA. A 73+96 LT

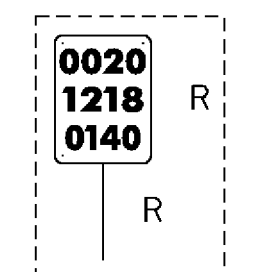

HVCTRL 53
N: 677748.93
E: 1562407.34
EL: 421.79

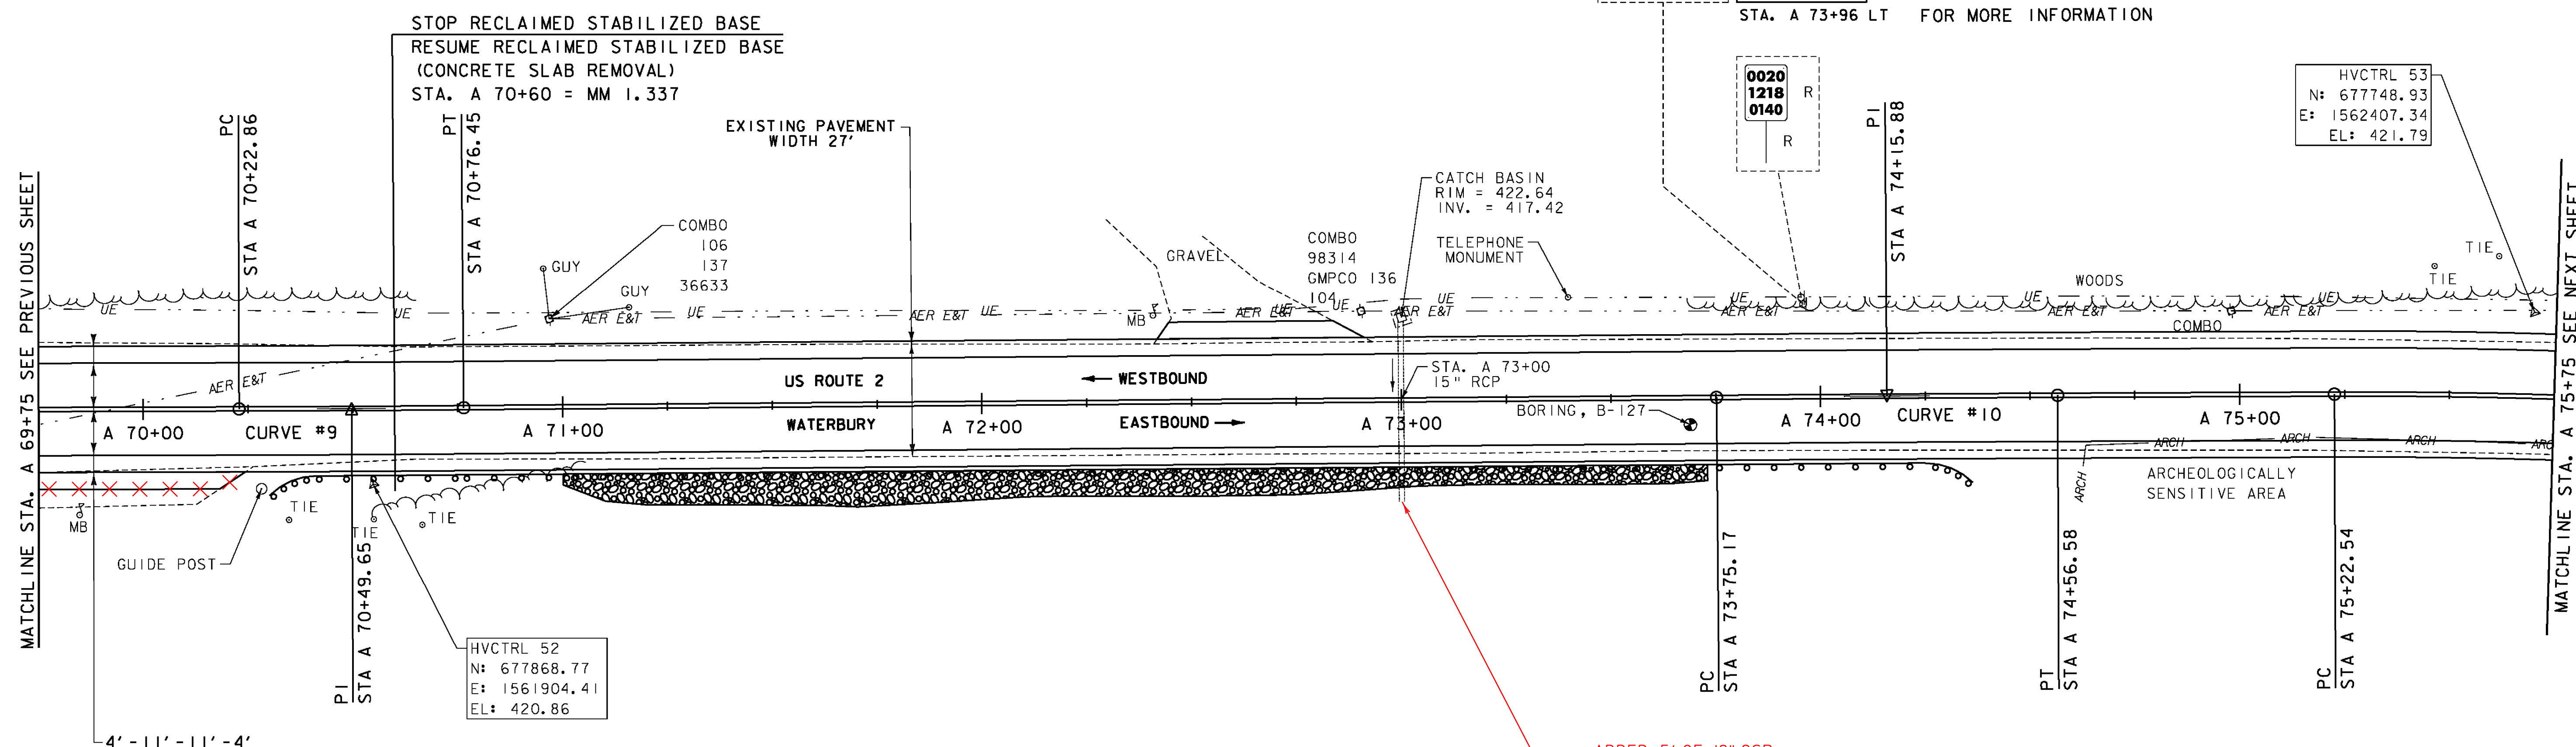

MATCHLINE STA. A 69+75 SEE PREVIOUS SHEET

MATCHLINE STA. A 75+75 SEE NEXT SHEET

CURVE #9
DELTA = 0°18'25"
D = 0°34'23"
R = 10000.00'
T = 26.80'
L = 53.59'
E = 0.04'
BANKING NORMAL CROWN
DESIGN SPEED 50 MPH
SEE SUPERELEVATION DIAGRAMS
FOR MORE INFORMATION


LEGEND

- MAILBOX
- BORING
- SIGN
- HYDRANT
- MANHOLE
- WATER SHUT OFF (WSO)
- GAS PIPELINE MARKER
- CATCH BASIN / DROP INLET
- CURB INLET
- ⊗ TRAFFIC CONTROL BOX
- ⊕ PARKING METER
- UTILITY POLE

SIGN LEGEND

- R = REMOVE
- R&S = REMOVE AND SALVAGE
- RET = RETAIN
- S = SALVAGE
- N = NEW
- B-B = BACK TO BACK
- = EXISTING
- = NEW

DATUM
VERTICAL NAVD 88
HORIZONTAL NAD 83

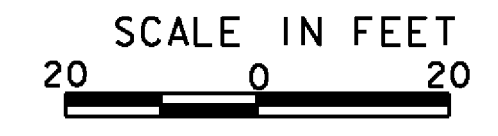

PROJECT LAYOUT SHEET 48	PROJECT NAME: BOLTON - WATERBURY
	PROJECT NUMBER: STP 2709 (1)
	FILE NAME: x07C172.dgn
	PLOT DATE: 04/17/2013
PROJECT LEADER: CDL	DRAWN BY: JBC/BMB
DESIGNED BY: BMB	CHECKED BY: CDL
PLOT FILE: x07C172.72.i	SHEET 72 OF 217