

DURABLE 4 INCH WHITE LINE (SEE OPTION ITEMS)  
 STA. A 75+75 - STA. A 81+50 (SOLID LT & RT)

DURABLE 4 INCH YELLOW LINE (SEE OPTION ITEMS)  
 STA. A 75+75 - STA. A 78+25 (SOLID LT & RT)  
 STA. A 78+25 - STA. A 81+50 (SOLID LT, DASHED RT)

STEEL BEAM GUARDRAIL, GALVANIZED W/8 FEET POSTS  
 STA. A 77+82.5 - STA. A 79+32.5 RT  
 STA. A 79+10 - STA. A 79+35 LT  
 STA. A 79+57.5 - STA. A 81+50 RT  
 STA. A 79+60 - STA. A 81+50 LT

STEEL BEAM GUARDRAIL, GALVANIZED/NESTED W/8 FEET POSTS  
 STA. A 79+32.5 - STA. A 79+57.5 RT  
 STA. A 79+35 - STA. A 79+60 LT

TEMPORARY 4 INCH WHITE LINE, PAINT  
 STA. A 75+75 - STA. A 81+50 (SOLID LT & RT)


TEMPORARY 4 INCH YELLOW LINE, PAINT  
 STA. A 75+75 - STA. A 78+25 (SOLID LT & RT)  
 STA. A 78+25 - STA. A 81+50 (SOLID LT, DASHED RT)

STONE FILL, TYPE 1  
 STA. A 78+05 - STA. A 78+25 RT  
 STA. A 78+32 - STA. A 79+65 RT  
 STA. A 79+20 - STA. A 81+50 LT  
 STA. A 81+20 - STA. A 81+50 RT

GEOTEXTILE UNDER STONE FILL  
 STA. A 78+05 - STA. A 78+25 RT  
 STA. A 78+32 - STA. A 79+65 RT  
 STA. A 79+20 - STA. A 81+50 LT  
 STA. A 81+20 - STA. A 81+50 RT


GEOTEXTILE FOR SILT FENCE  
 STA. A 78+05 - STA. A 78+25 RT  
 STA. A 78+32 - STA. A 79+65 RT  
 STA. A 79+20 - STA. A 81+50 LT  
 STA. A 81+20 - STA. A 81+50 RT

GRUBBING MATERIAL  
 STA. A 78+05 - STA. A 78+25 RT  
 STA. A 78+32 - STA. A 79+65 RT  
 STA. A 79+20 - STA. A 81+50 LT  
 STA. A 81+20 - STA. A 81+50 RT

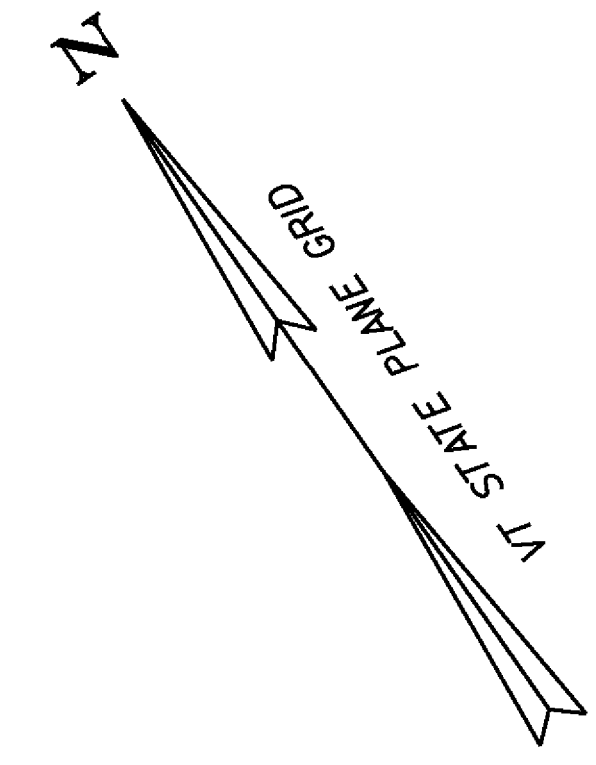

CURVE #11  
 DELTA = 17° 13' 40"  
 D = 3° 49' 11" (1) D = 2° 14' 49" (2)  
 R = 1500.00' (1) R = 2550.00' (2)  
 T = 249.38' (1) T = 323.26' (2)  
 L = 283.25' (1) L = 285.21' (2)  
 E = 20.59'  
 BANKING 0.062 FT/FT, 0.042 FT/FT  
 DESIGN SPEED 50 MPH  
 SEE SUPERELEVATION DIAGRAMS  
 FOR MORE INFORMATION

REMOVED CHANGE ORDER #7

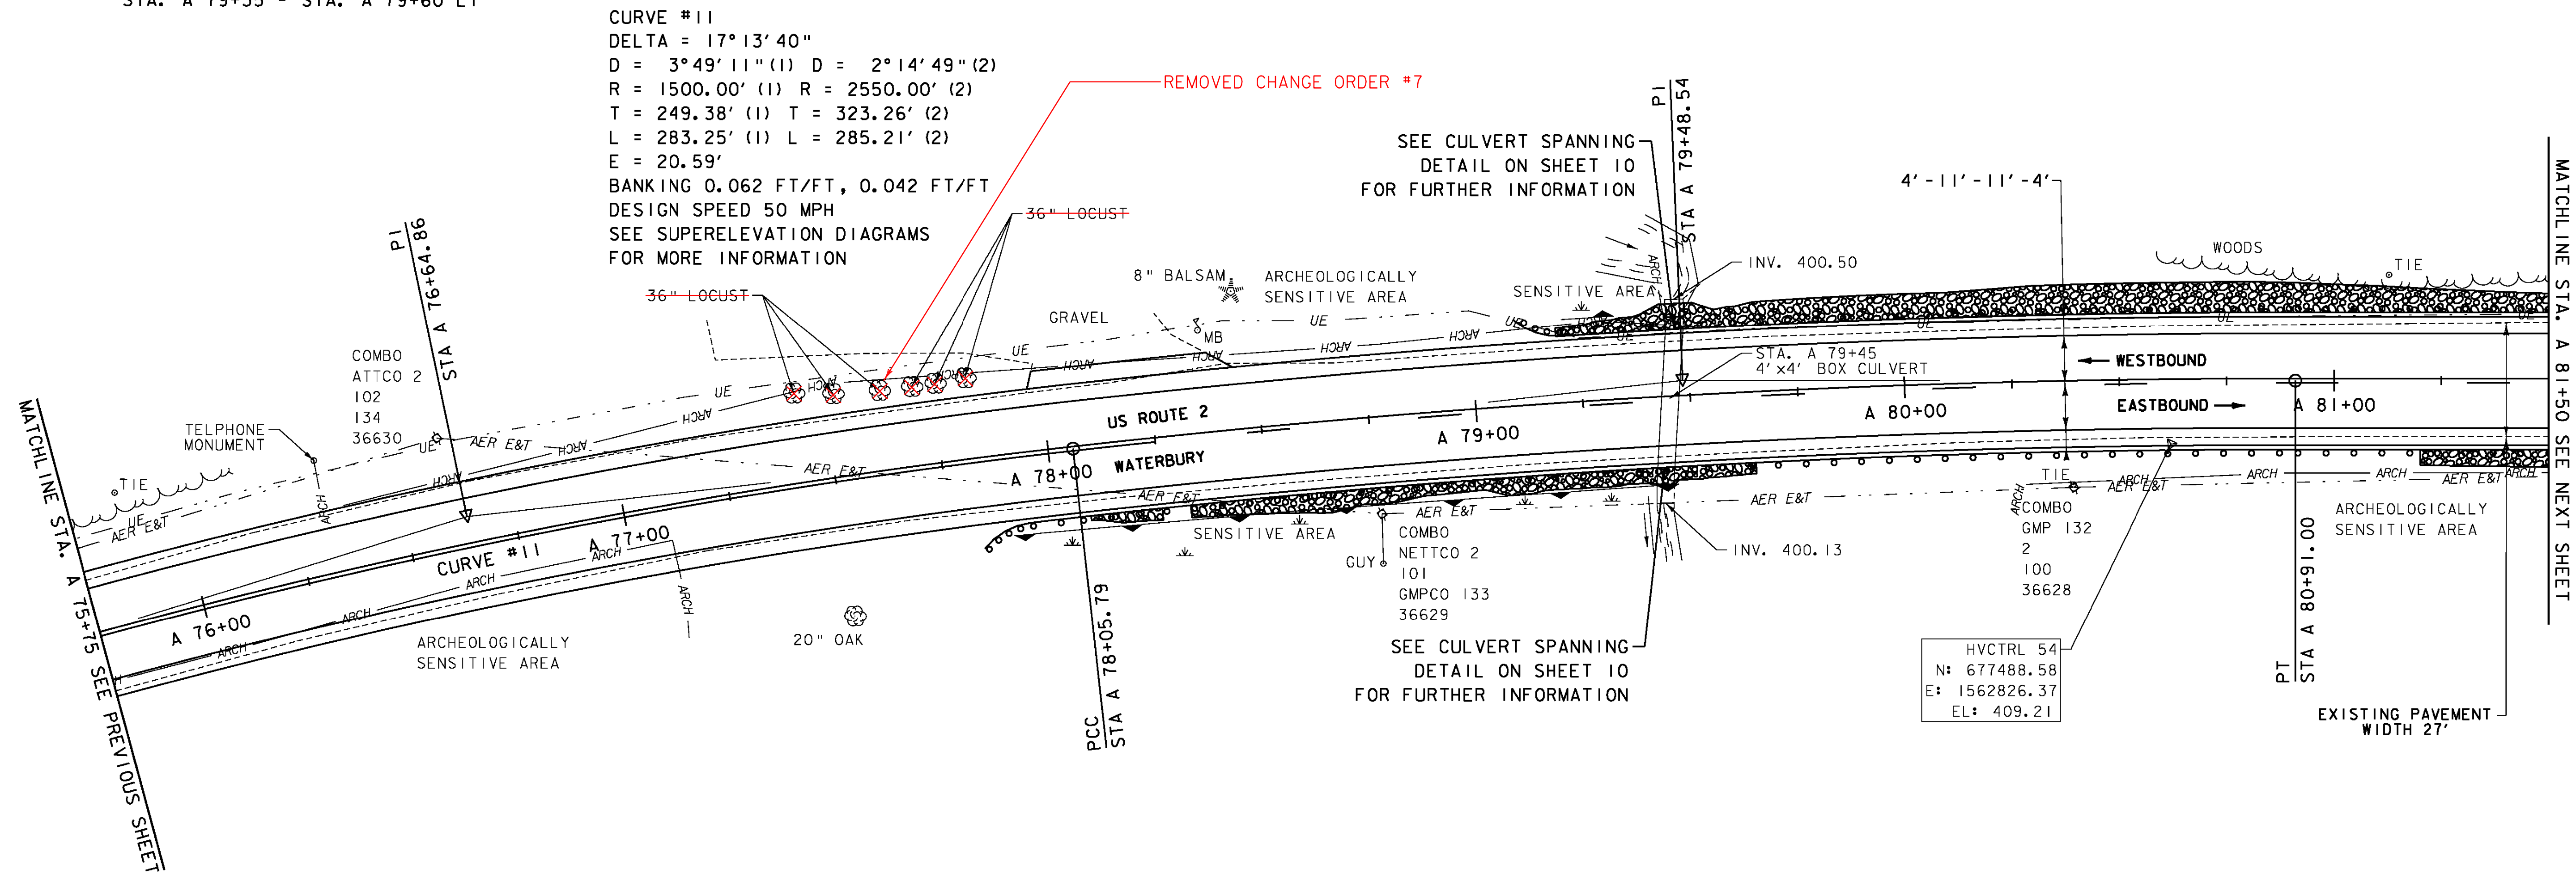


- LEGEND**
- MAILBOX
  - BORING
  - SIGN
  - HYDRANT
  - MANHOLE
  - WATER SHUT OFF (WSO)
  - GAS PIPELINE MARKER
  - CATCH BASIN / DROP INLET
  - CURB INLET
  - TRAFFIC CONTROL BOX
  - PARKING METER
  - UTILITY POLE

- SIGN LEGEND**
- R = REMOVE
  - R&S = REMOVE AND SALVAGE
  - RET = RETAIN
  - S = SALVAGE
  - N = NEW
  - B-B = BACK TO BACK
  - = EXISTING
  - = NEW

**ENVIRONMENTALLY SENSITIVE LOCATIONS:**

NO.	LIMITS	POS.	TYPE
2.	STA. A 78+89 - STA. A 79+46	RT	-
3.	STA. A 79+21 - STA. A 79+33	LT	-

DATUM  
 VERTICAL NAVD 88  
 HORIZONTAL NAD 83

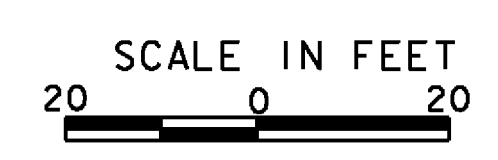

<b>PROJECT LAYOUT SHEET 49</b>	PROJECT NAME: BOLTON - WATERBURY
	PROJECT NUMBER: STP 2709 (1)
	FILE NAME: p07C172.dgn
	PLOT DATE: 4/16/2013
PROJECT LEADER: CDL	DRAWN BY: JBC/BMB
DESIGNED BY: BMB	CHECKED BY: CDL
PLOT FILE: p07C172_73.i	SHEET 73 OF 217