



DURABLE 4 INCH WHITE LINE (SEE OPTION ITEMS)
 STA. A 87+50 - STA. A 93+25 (SOLID LT & RT)

TEMPORARY 4 INCH WHITE LINE, PAINT
 STA. A 87+50 - STA. A 93+25 (SOLID LT & RT)

DURABLE 4 INCH YELLOW LINE (SEE OPTION ITEMS)
 STA. A 87+50 - STA. A 93+25 (DASHED)

TEMPORARY 4 INCH YELLOW LINE, PAINT
 STA. A 87+50 - STA. A 93+25 (DASHED)

RELOCATE MAILBOX, SINGLE SUPPORT
 STA. A 89+73 LT

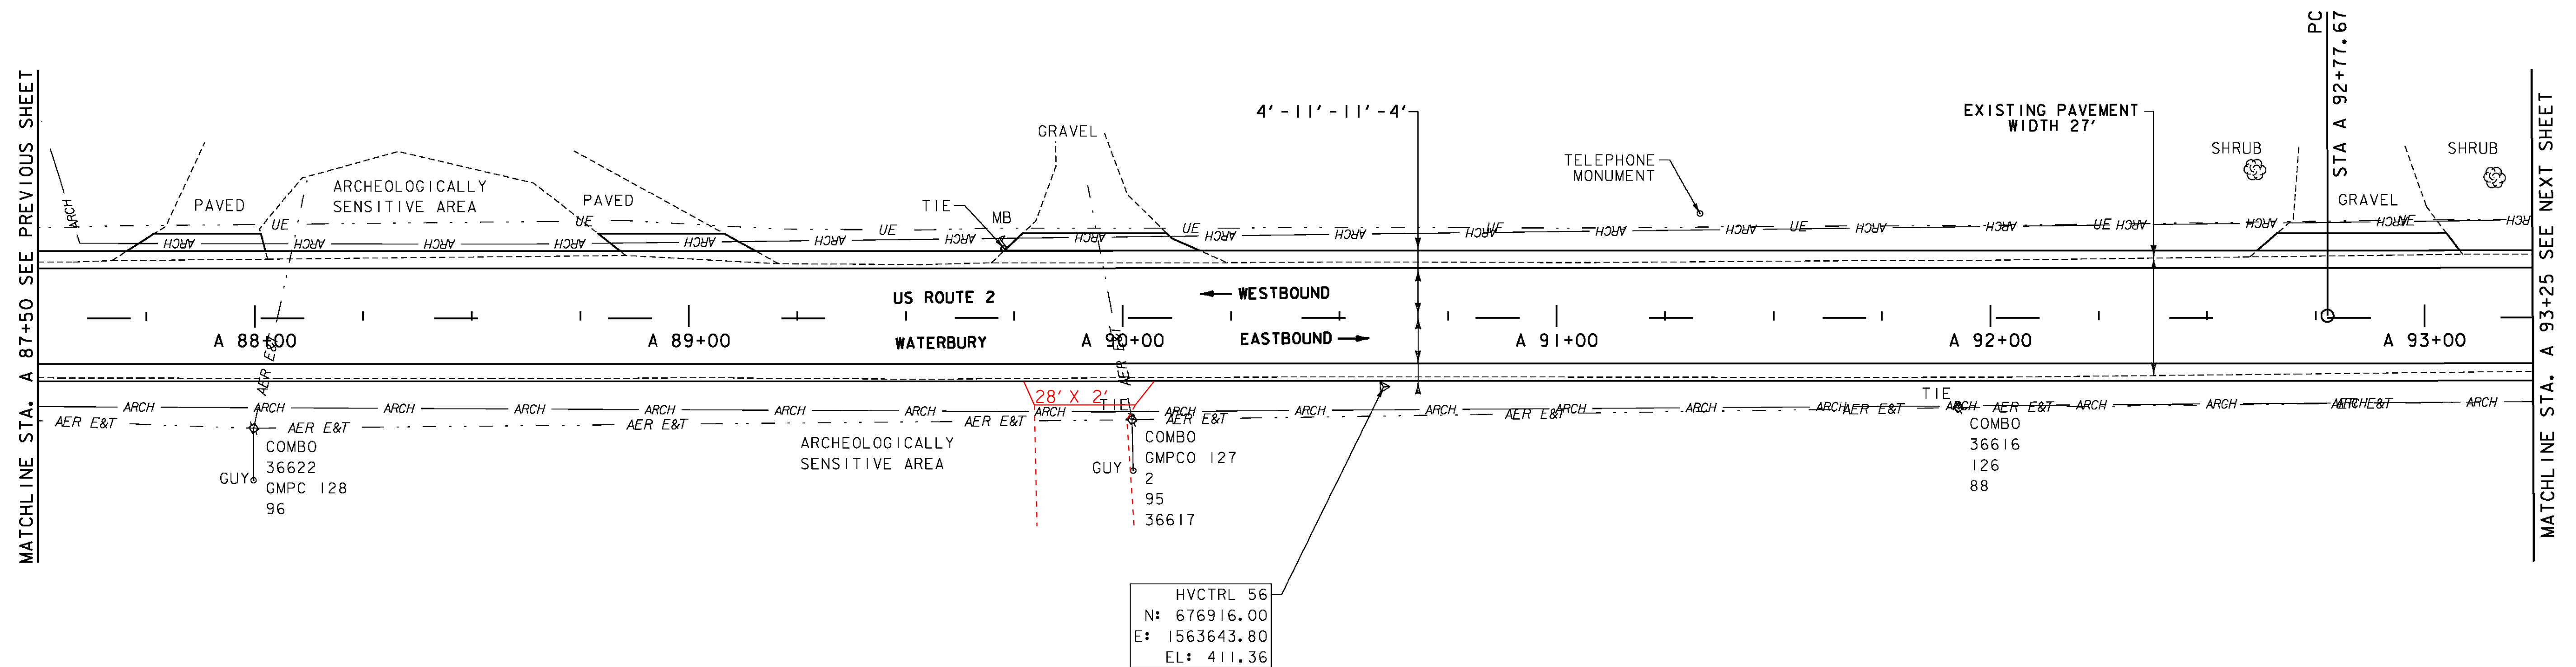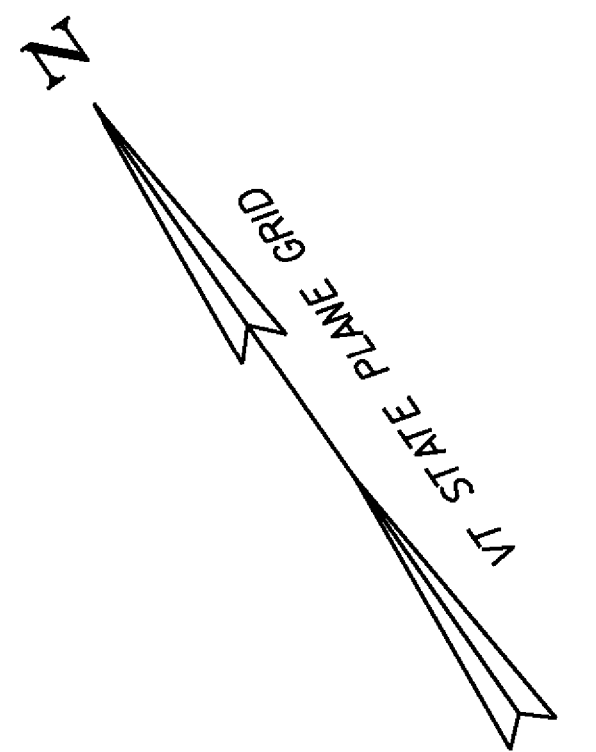

LEGEND

- MAILBOX
- BORING
- SIGN
- HYDRANT
- MANHOLE
- WATER SHUT OFF (WSO)
- GAS PIPELINE MARKER
- CATCH BASIN / DROP INLET
- CURB INLET
- TRAFFIC CONTROL BOX
- PARKING METER
- UTILITY POLE

SIGN LEGEND

- R = REMOVE
- R&S = REMOVE AND SALVAGE
- RET = RETAIN
- S = SALVAGE
- N = NEW
- B-B = BACK TO BACK
- = EXISTING
- = NEW

DATUM
 VERTICAL NAVD 88
 HORIZONTAL NAD 83

SCALE IN FEET
 20 0 20

PROJECT LAYOUT SHEET 51

PROJECT NAME: BOLTON - WATERBURY
 PROJECT NUMBER: STP 2709 (1)

FILE NAME: p07C172.dgn PLOT DATE: 4/16/2013
 PROJECT LEADER: CDL DRAWN BY: JBC/BMB
 DESIGNED BY: BMB CHECKED BY: CDL
 PLOT FILE: p07C172.75.i SHEET 75 OF 217