

DURABLE 4 INCH WHITE LINE (SEE OPTION ITEMS)  
 STA. A 93+25 - STA. A 99+25 (SOLID LT & RT)

TEMPORARY 4 INCH WHITE LINE, PAINT  
 STA. A 93+25 - STA. A 99+25 (SOLID LT & RT)



DURABLE 4 INCH YELLOW LINE (SEE OPTION ITEMS)  
 STA. A 93+25 - STA. A 97+25 (DASHED)  
 STA. A 97+25 - STA. A 99+25 (DASHED LT, SOLID RT)

TEMPORARY 4 INCH YELLOW LINE, PAINT  
 STA. A 93+25 - STA. A 97+25 (DASHED)  
 STA. A 97+25 - STA. A 99+25 (DASHED LT, SOLID RT)

RELOCATE MAILBOX, SINGLE SUPPORT  
 STA. A 98+69 LT

REMOVING SIGNS  
 AS SHOWN - I

THINNING AND TRIMMING FOR SIGNS  
 STA. A 95+04 LT

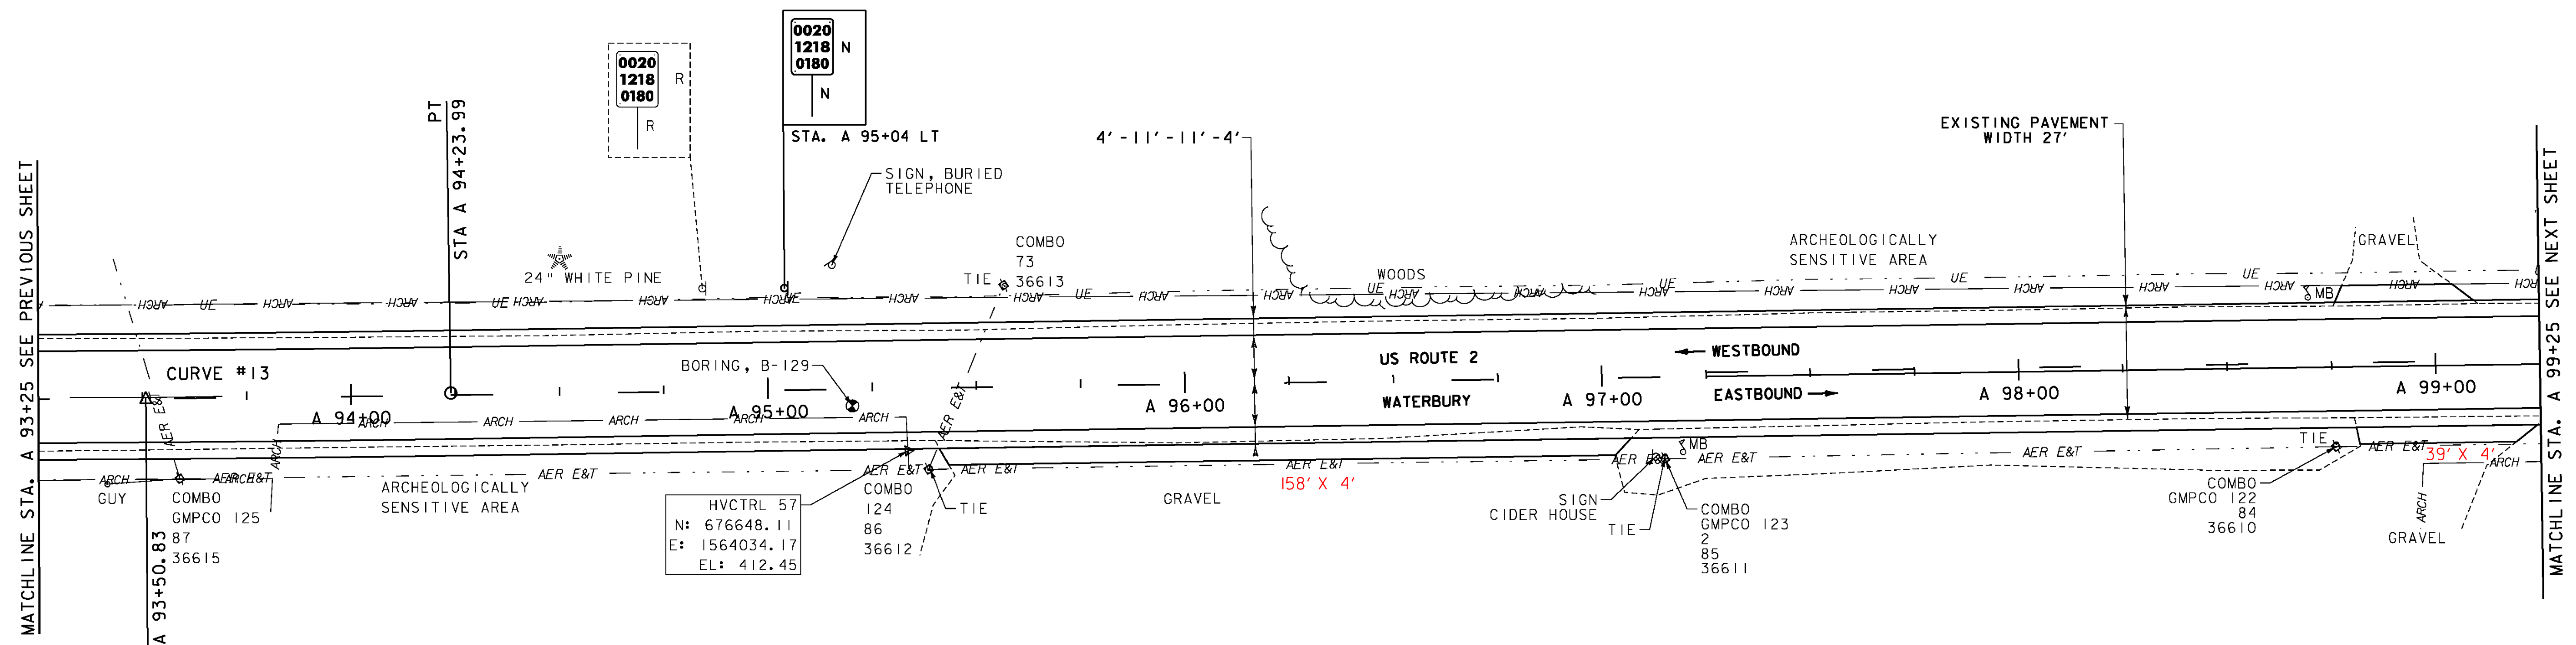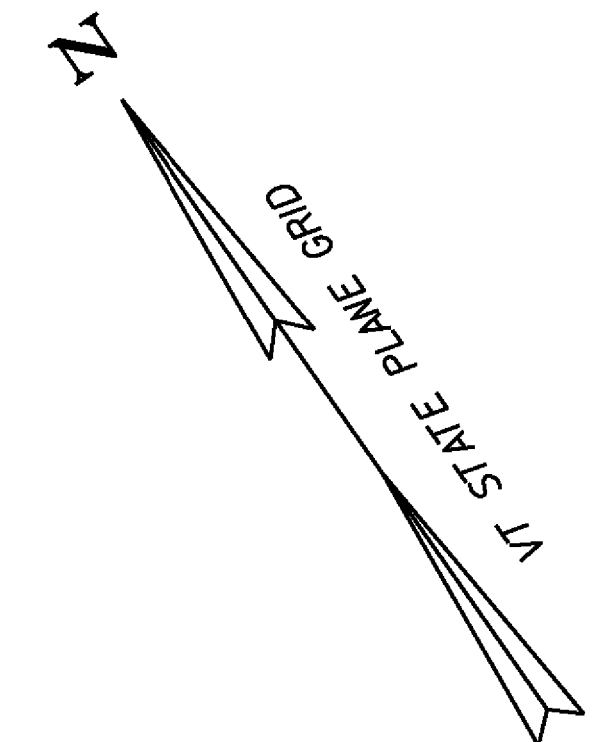

PI STA A 93+50.83  
 CURVE #13  
 DELTA = 0°50'18"  
 D = 0°34'23"  
 R = 10000.00'  
 T = 73.16'  
 L = 146.32'  
 E = 0.27'

BANKING NORMAL CROWN  
 DESIGN SPEED 50 MPH  
 SEE SUPERELEVATION DIAGRAMS  
 FOR MORE INFORMATION


**LEGEND**

- MAILBOX
- BORING
- SIGN
- HYDRANT
- MANHOLE
- WATER SHUT OFF (WSO)
- GAS PIPELINE MARKER
- CATCH BASIN / DROP INLET
- CURB INLET
- TRAFFIC CONTROL BOX
- PARKING METER
- UTILITY POLE

**SIGN LEGEND**

- R = REMOVE
- R&S = REMOVE AND SALVAGE
- RET = RETAIN
- S = SALVAGE
- N = NEW
- B-B = BACK TO BACK
- = EXISTING
- = NEW

DATUM  
 VERTICAL NAVD 88  
 HORIZONTAL NAD 83

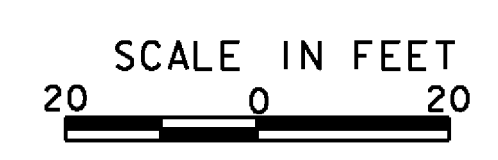

<b>PROJECT LAYOUT SHEET 52</b>	PROJECT NAME: BOLTON - WATERBURY
	PROJECT NUMBER: STP 2709 (1)
	FILE NAME: p07C172.dgn
	PLOT DATE: 4/16/2013
PROJECT LEADER: CDL	DRAWN BY: JBC/BMB
DESIGNED BY: BMB	CHECKED BY: CDL
PLOT FILE: p07C172.76.i	SHEET 76 OF 217