

DURABLE 4 INCH WHITE LINE (SEE OPTION ITEMS)
 STA. A 129+50 - STA. A 134+75 (SOLID LT & RT)

TEMPORARY 4 INCH WHITE LINE, PAINT
 STA. A 129+50 - STA. A 134+75 (SOLID LT & RT)

DURABLE 4 INCH YELLOW LINE (SEE OPTION ITEMS)
 STA. A 129+50 - STA. A 134+75 (SOLID LT & RT)


TEMPORARY 4 INCH YELLOW LINE, PAINT
 STA. A 129+50 - STA. A 134+75 (SOLID LT & RT)

REMOVING SIGNS
 AS SHOWN - 3

GRUBBING MATERIAL
 STA. A 132+54 - STA. A 133+40 LT & RT
 STA. A 132+82 - STA. A 133+84 LT
 STA. A 133+32 - STA. A 134+21 LT
 STA. A 134+30 - STA. A 134+75 LT & RT

PLACE 1'-0" THICK GRUBBING MATERIAL,
 TEMPORARY EROSION MATTING AND
 SEED ON EXISTING STONE FILL BENEATH
 I-89 BRIDGES

ADDITIONAL GRUBBING
 MATERIAL ADDED

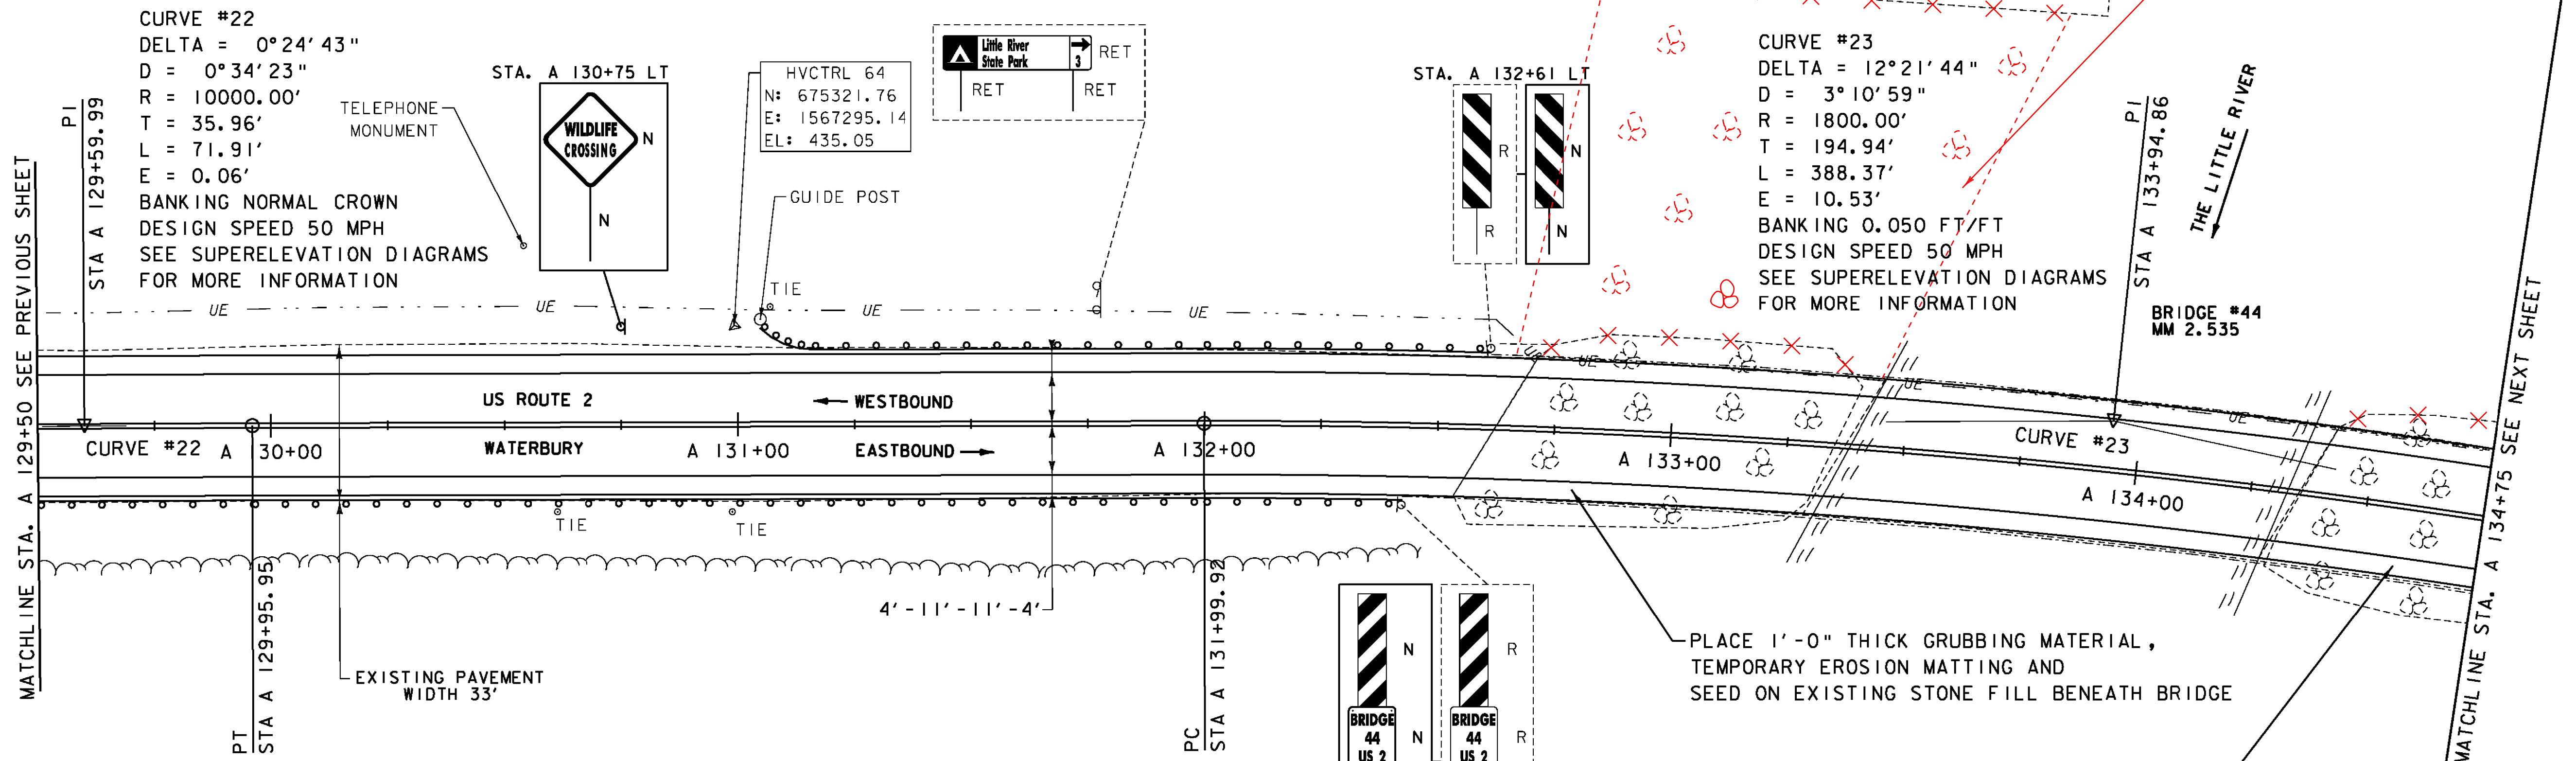

REMOVAL AND DISPOSAL OF GUARDRAIL
 STA. A 131+04.75 - STA. A 131+17.25 LT
 STA. A 132+17.75 - STA. A 132+42.75 RT
 STA. A 132+36 - STA. A 132+61 LT

REMOVE AND RESET GUARDRAIL
 STA. A 129+50 - STA. A 132+17.75 RT
 STA. A 131+17.25 - STA. A 132+36 LT

HD STEEL BEAM GUARDRAIL, GALVANIZED W/8 FEET POSTS

STA. A 132+17.75 - STA. A 132+42.75 RT
 STA. A 132+36 - STA. A 132+61 LT

STEEL BEAM GUARDRAIL, GALVANIZED W/8 FEET POSTS

STA. A 131+04.75 - STA. A 131+17.25 LT

- LEGEND**
- MAILBOX
 - BORING
 - SIGN
 - HYDRANT
 - MANHOLE
 - WATER SHUT OFF (WSO)
 - GAS PIPELINE MARKER
 - CATCH BASIN / DROP INLET
 - CURB INLET
 - TRAFFIC CONTROL BOX
 - PARKING METER
 - UTILITY POLE

- SIGN LEGEND**
- R = REMOVE
 - R&S = REMOVE AND SALVAGE
 - RET = RETAIN
 - S = SALVAGE
 - N = NEW
 - B-B = BACK TO BACK
 - = EXISTING
 - = NEW

DATUM
 VERTICAL NAVD 88
 HORIZONTAL NAD 83

SCALE IN FEET
 20 0 20

**PROJECT
 LAYOUT
 SHEET 58**

PROJECT NAME: BOLTON - WATERBURY
 PROJECT NUMBER: STP 2709 (1)

FILE NAME: p07C172.dgn
 PROJECT LEADER: CDL
 DESIGNED BY: BMB
 PLOT FILE: p07C172.82.i

PLOT DATE: 4/16/2013
 DRAWN BY: JBC/BMB
 CHECKED BY: CDL
 SHEET 82 OF 217

