

DURABLE 4 INCH WHITE LINE (SEE OPTION ITEMS)
 STA. A 134+75 - STA. A 140+50 (SOLID LT & RT)

TEMPORARY 4 INCH WHITE LINE, PAINT
 STA. A 134+75 - STA. A 140+50 (SOLID LT & RT)

REMOVAL AND DISPOSAL OF GUARDRAIL
 STA. A 135+08.75 - STA. A 135+33.75 RT
 STA. A 135+21.5 - STA. A 135+46.5 LT
 STA. A 136+84 - STA. A 136+96.5 LT

DURABLE 4 INCH YELLOW LINE (SEE OPTION ITEMS)
 STA. A 134+75 - STA. A 140+50 (SOLID LT & RT)

TEMPORARY 4 INCH YELLOW LINE, PAINT
 STA. A 134+75 - STA. A 140+50 (SOLID LT & RT)


REMOVE AND RESET GUARDRAIL
 STA. A 135+33.75 - STA. A 140+50 RT
 STA. A 135+46.5 - STA. A 136+84 LT

GRUBBING MATERIAL
 STA. A 134+75 - STA. A 135+11 LT & RT

HD STEEL BEAM GUARDRAIL, GALVANIZED W/8 FEET POSTS
 STA. A 135+08.75 - STA. A 135+33.75 RT
 STA. A 135+21.5 - STA. A 135+46.5 LT

REMOVING SIGNS
 AS SHOWN - 4

STEEL BEAM GUARDRAIL, GALVANIZED W/8 FEET POSTS
 STA. A 136+84 - STA. A 136+96.5 LT

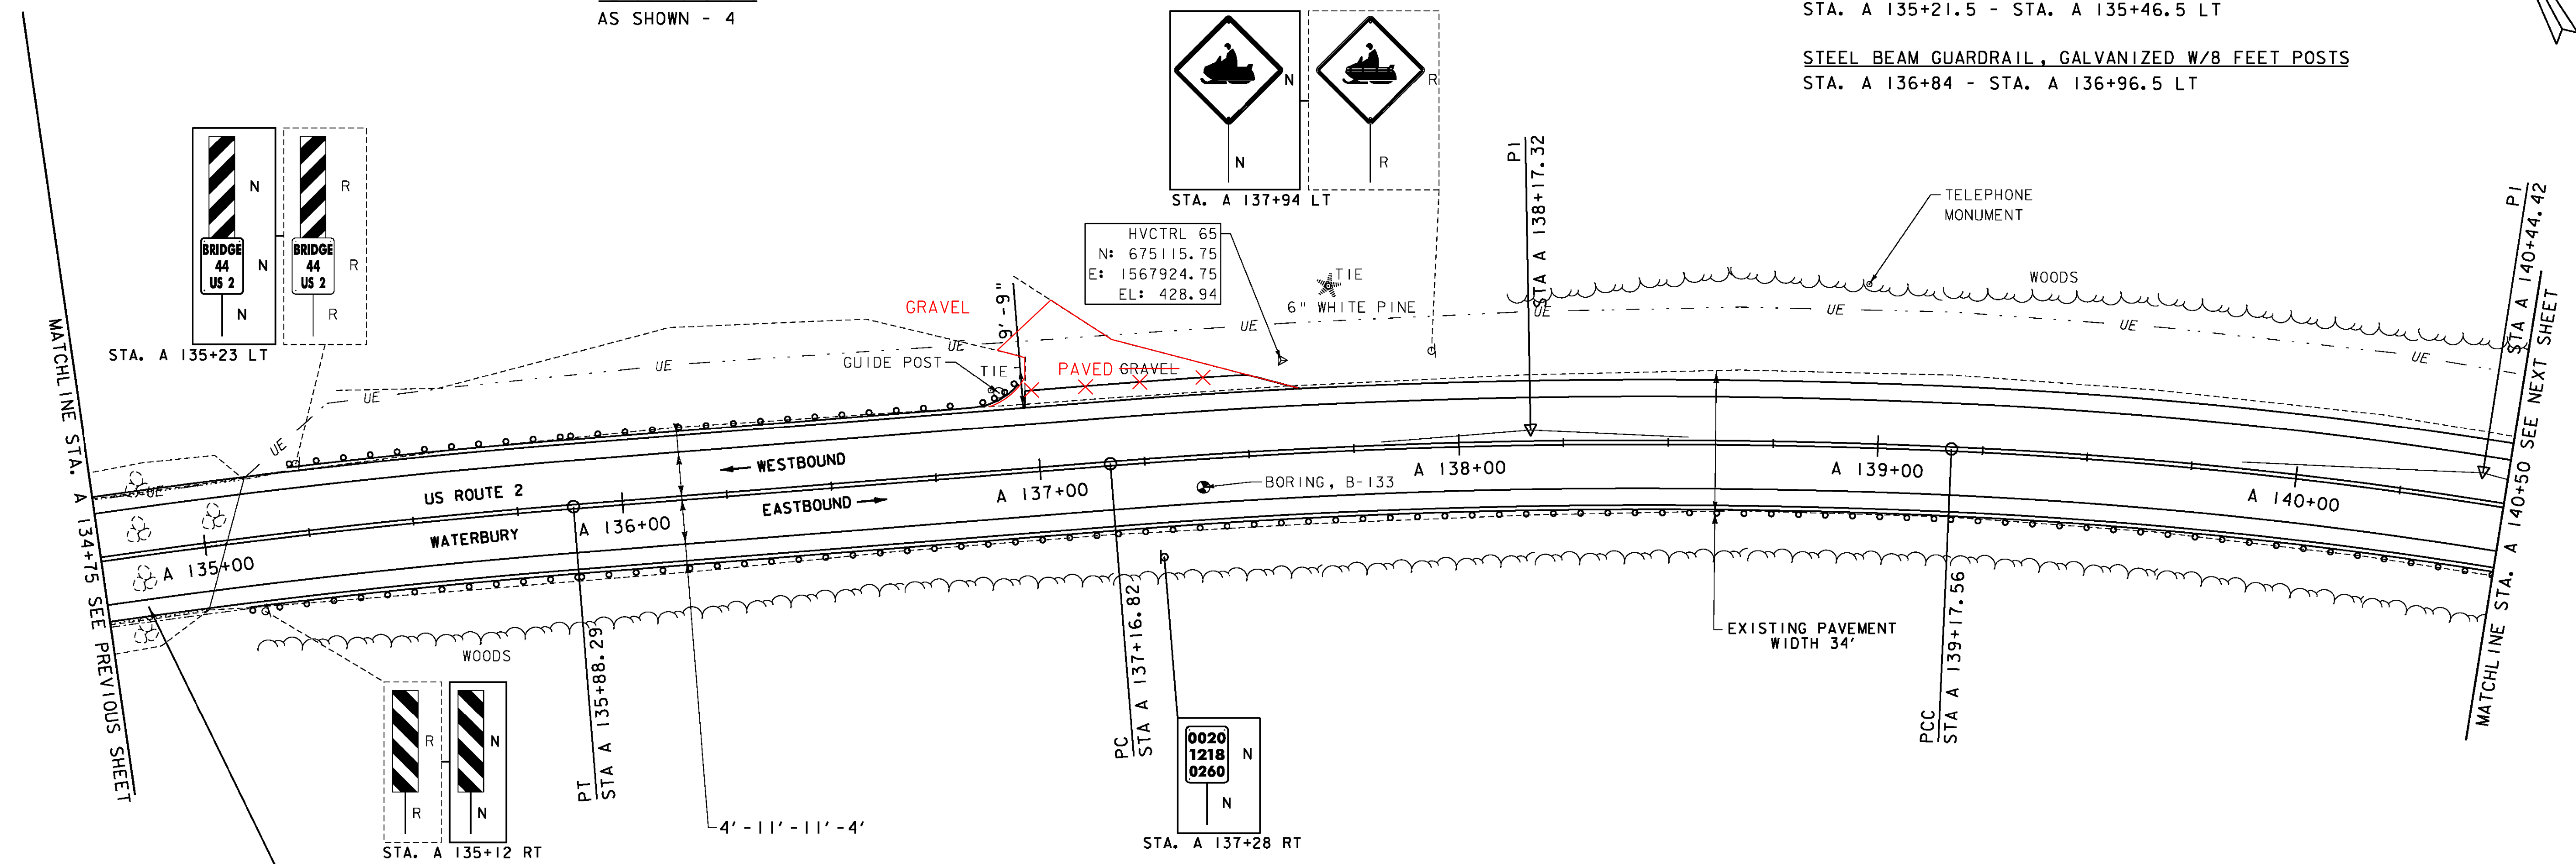

PLACE 1'-0" THICK GRUBBING MATERIAL,
 TEMPORARY EROSION MATTING AND
 SEED ON EXISTING STONE FILL BENEATH BRIDGE


LEGEND

- MAILBOX
- BORING
- SIGN
- HYDRANT
- MANHOLE
- WATER SHUT OFF (WSO)
- GAS PIPELINE MARKER
- CATCH BASIN / DROP INLET
- CURB INLET
- ⊗ TRAFFIC CONTROL BOX
- ⊕ PARKING METER
- ⊖ UTILITY POLE

SIGN LEGEND

- R = REMOVE
- R&S = REMOVE AND SALVAGE
- RET = RETAIN
- S = SALVAGE
- N = NEW
- B-B = BACK TO BACK
- = EXISTING
- = NEW

DATUM
 VERTICAL NAVD 88
 HORIZONTAL NAD 83

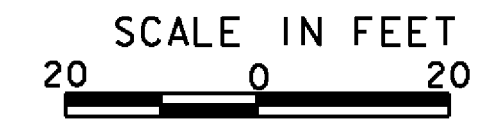

| | | |
|--------------------------------|----------------------------------|----------------------|
| PROJECT LAYOUT SHEET 59 | PROJECT NAME: BOLTON - WATERBURY | PLOT DATE: 4/16/2013 |
| | PROJECT NUMBER: STP 2709 (1) | DRAWN BY: JBC/BMB |
| | FILE NAME: p07C172.dgn | CHECKED BY: CDL |
| | DESIGNED BY: BMB | SHEET 83 OF 217 |