




99+50

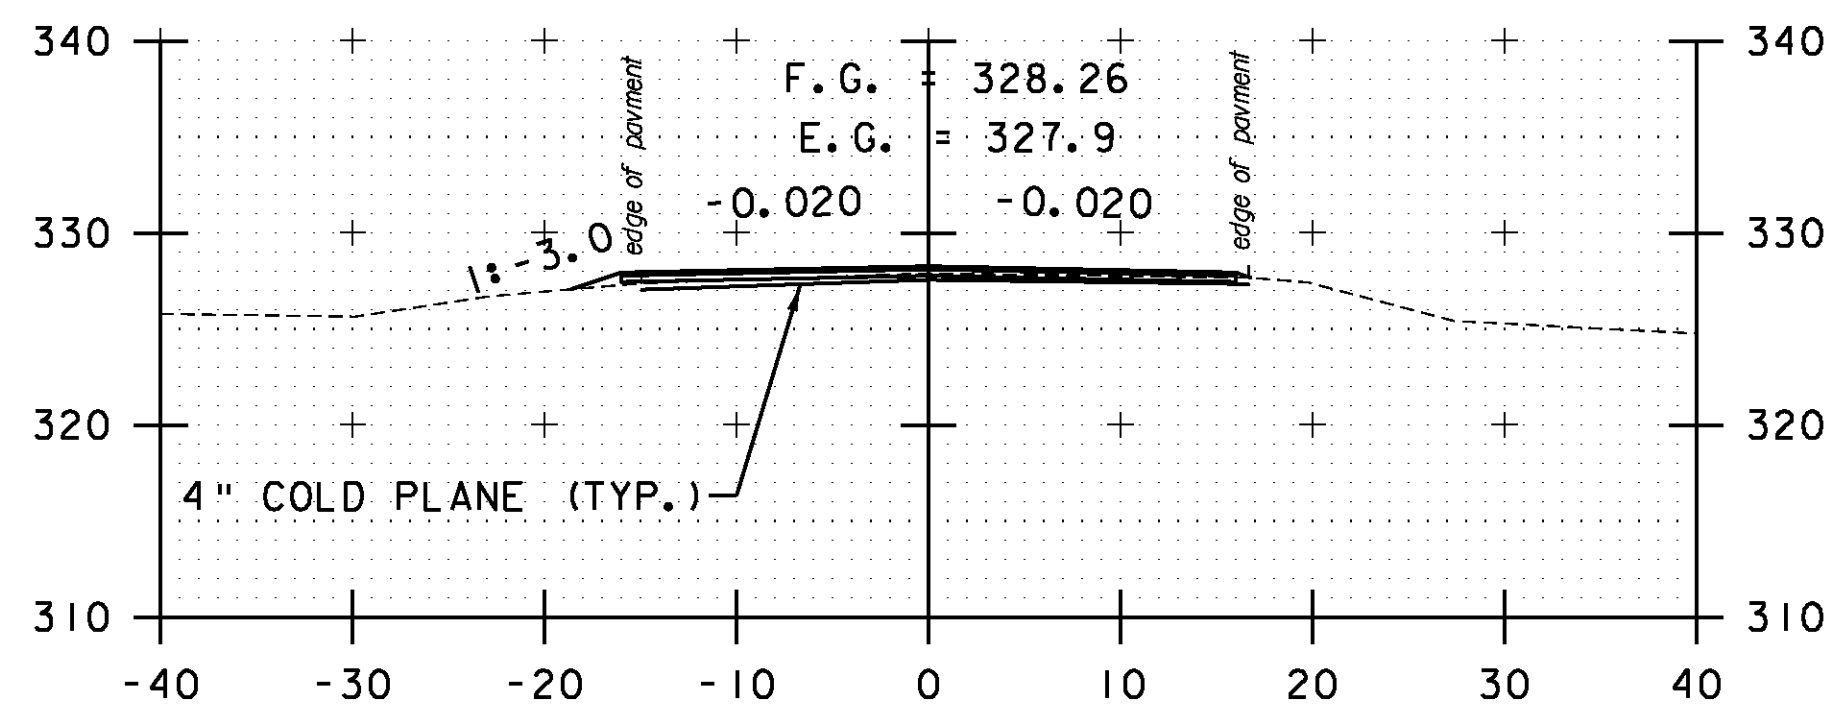


101+00

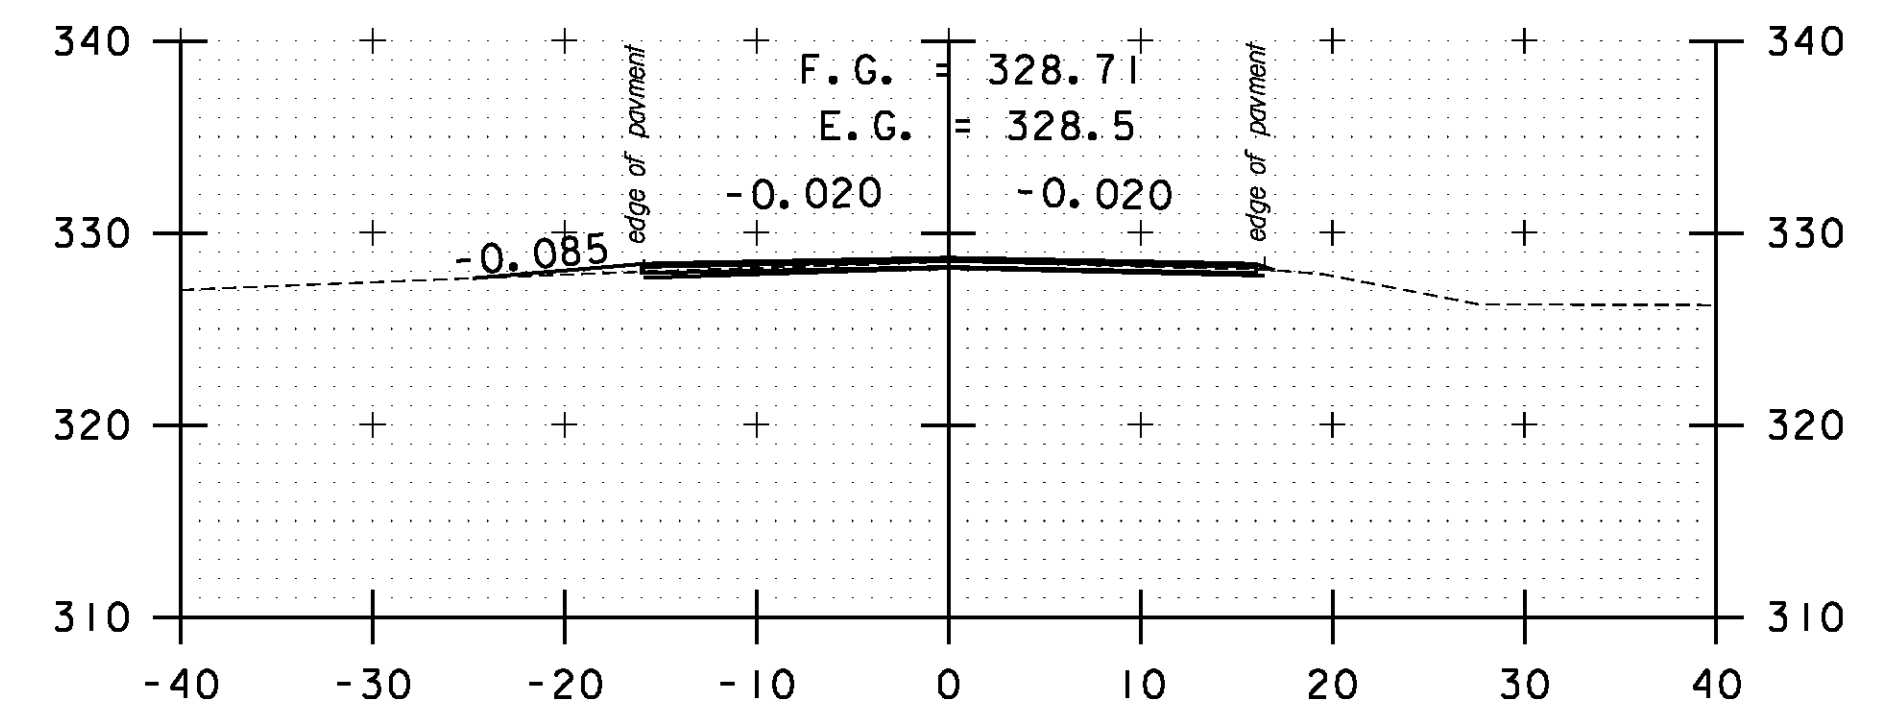


DRIVE LT  
102+50

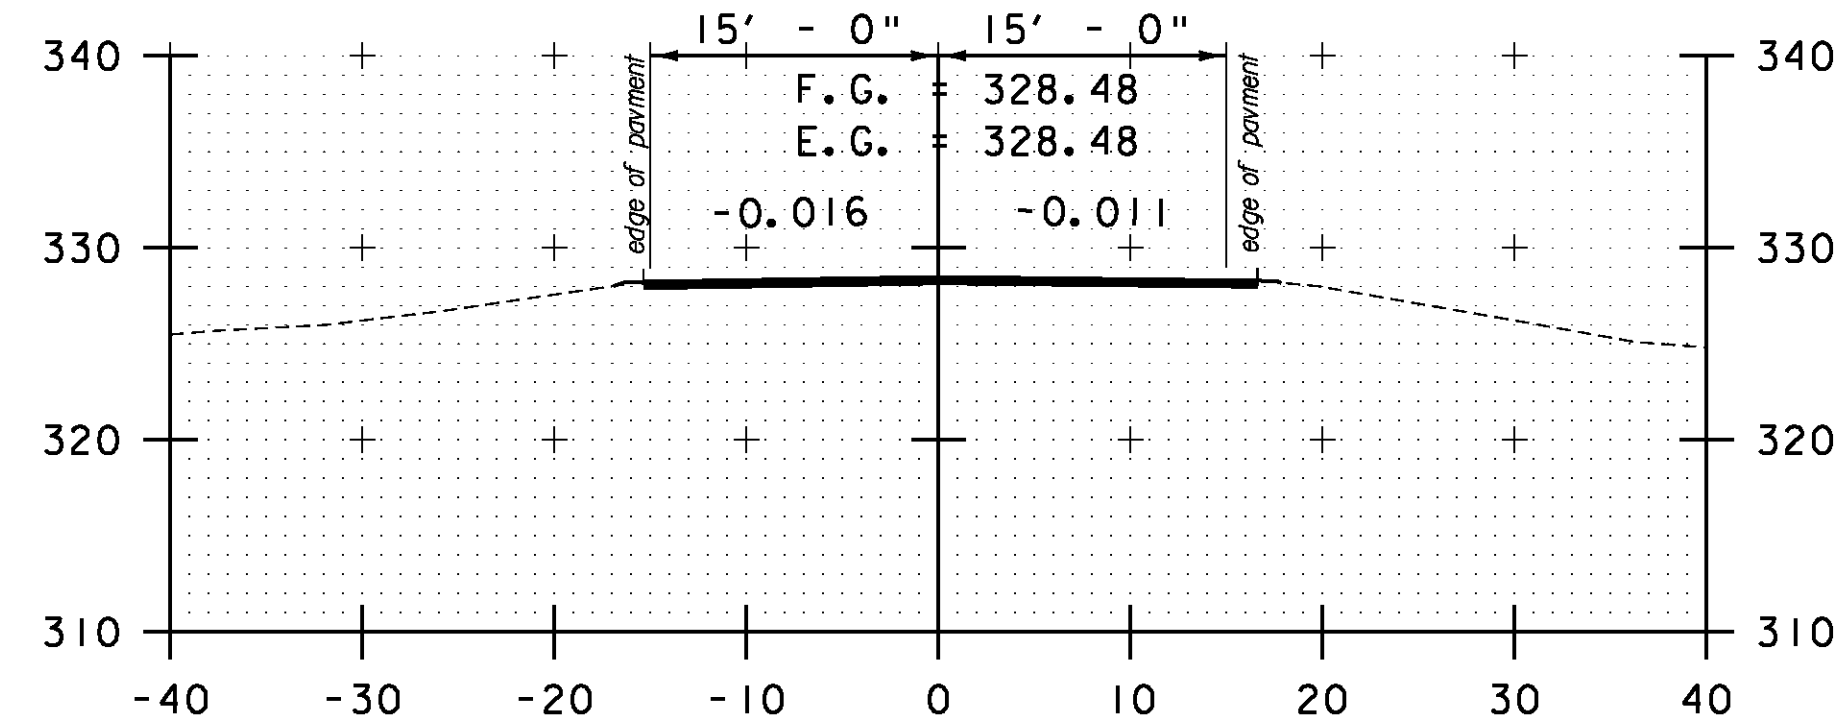


BEGIN PROJECT - MATCH EXISTING  
99+25

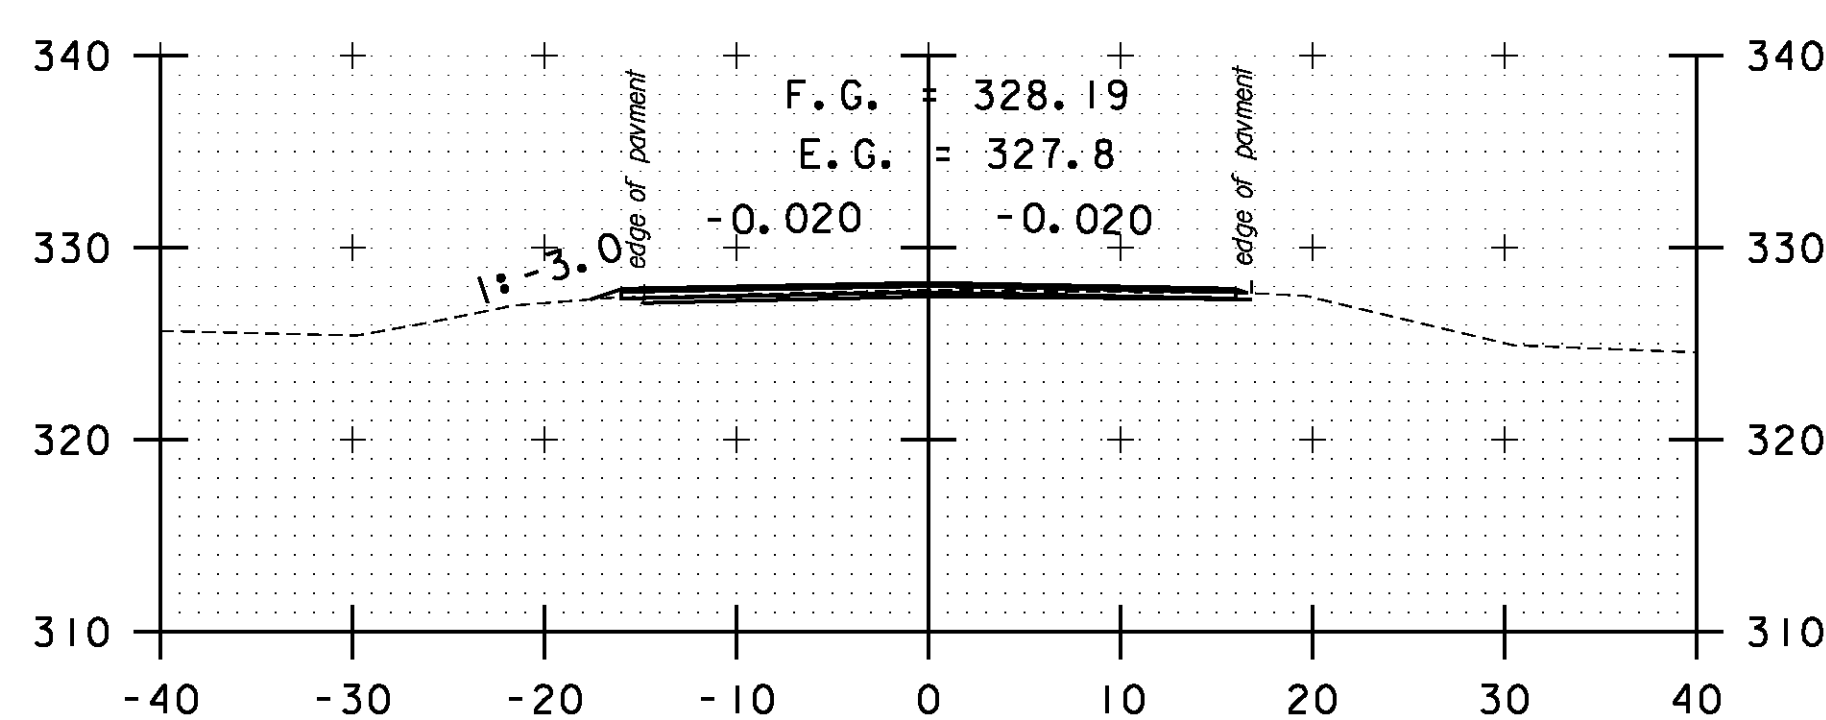


100+50

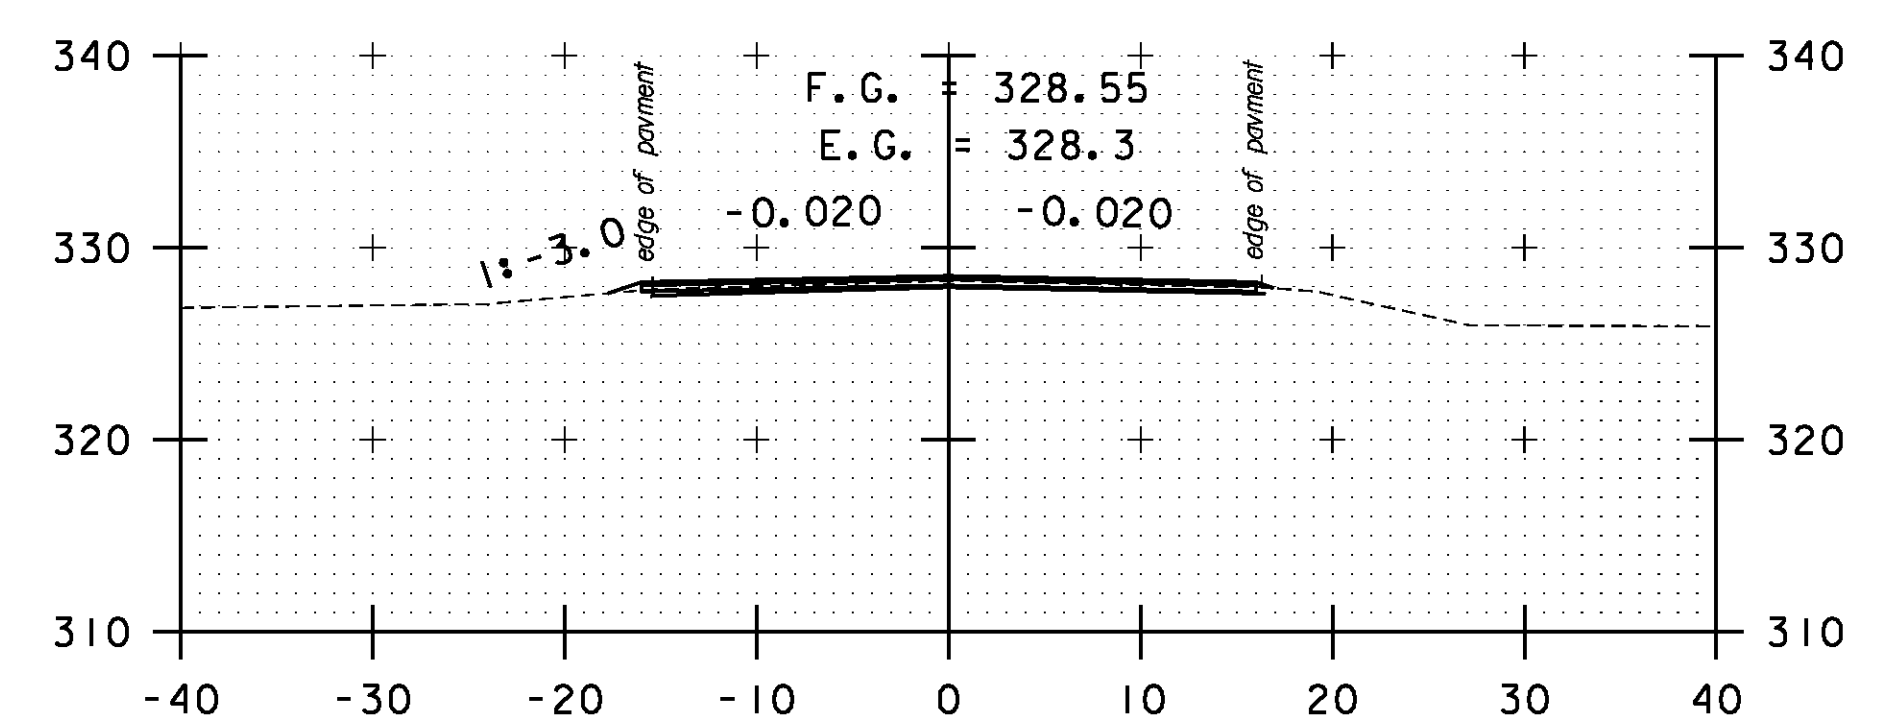


102+00

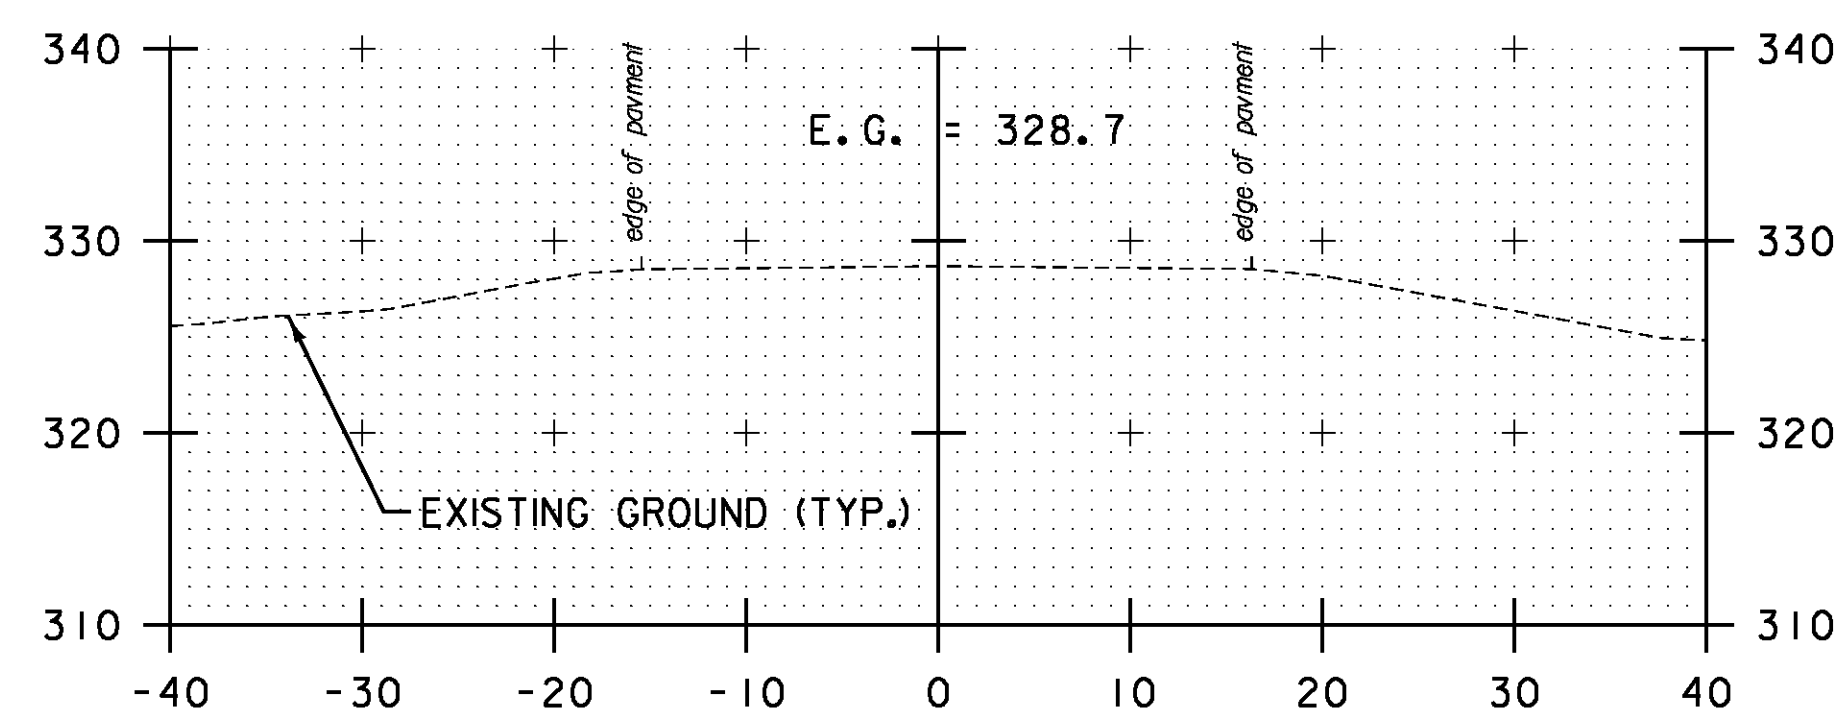

99+00

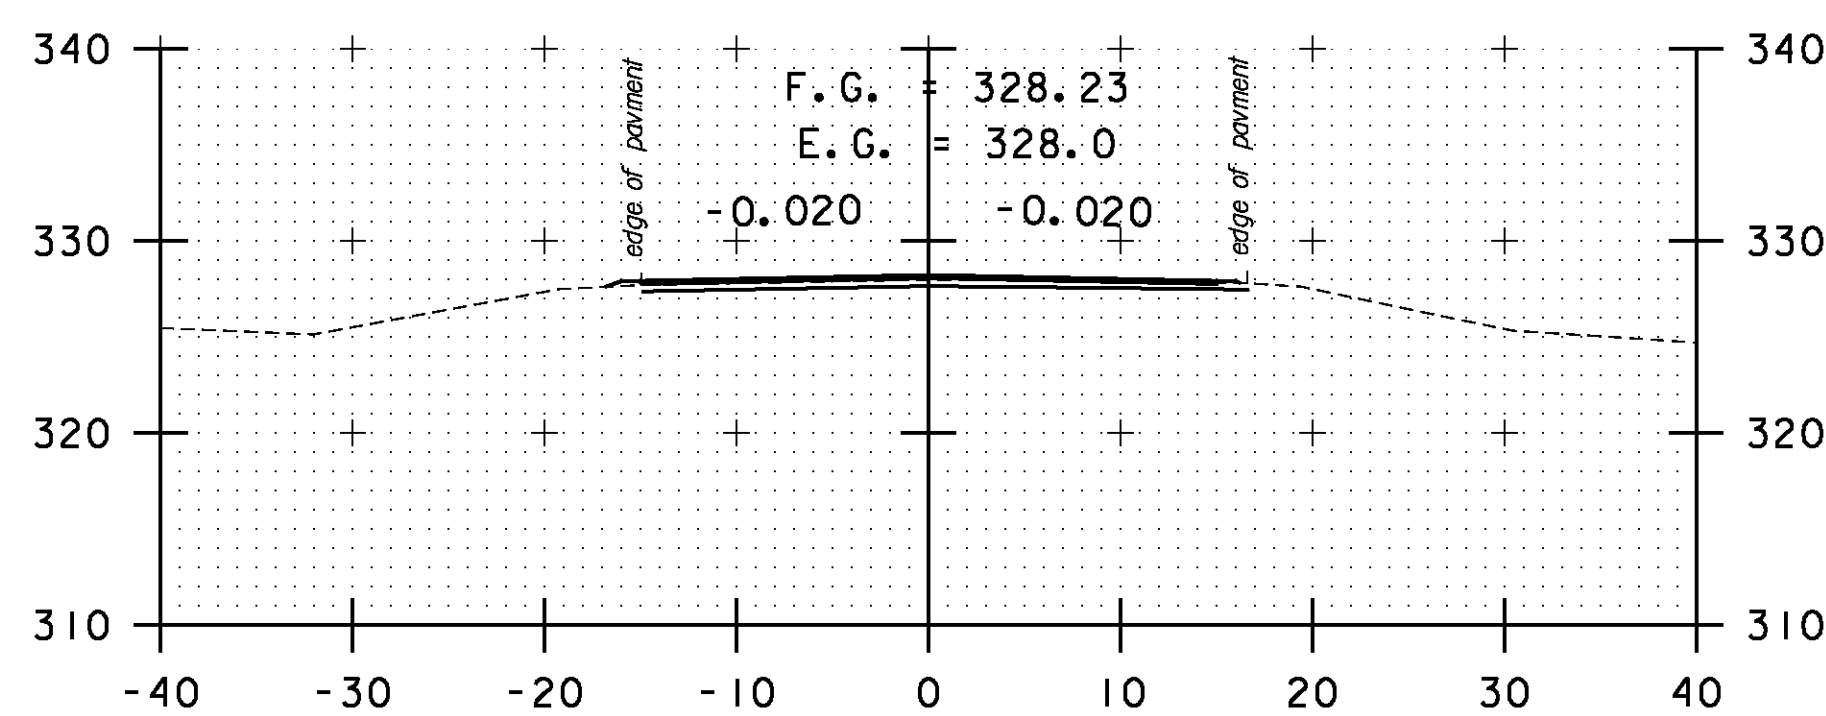

100+00

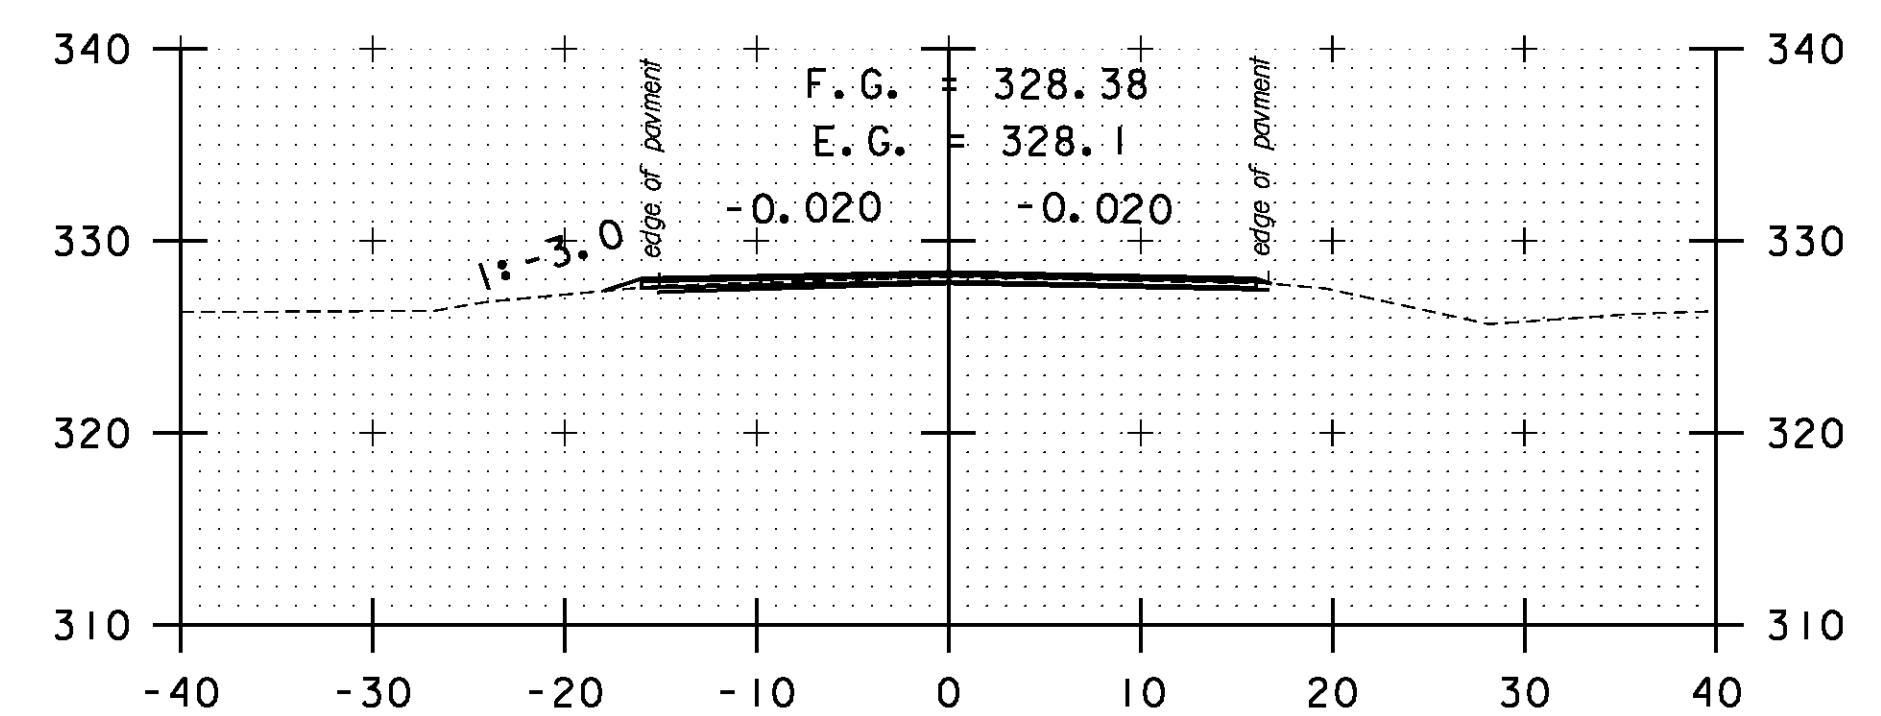

101+50

STA. 99+00 TO STA. 102+50

SCALE 1" = 10'-0"  
0 10

**CROSS SECTION SHEET 1**

PROJECT NAME: BOLTON-WATERBURY

PROJECT NUMBER: STP 2709(I)

FILE NAME: p07C172.dgn

PROJECT LEADER: CDL

DESIGNED BY: BMB

PLOT FILE: p07C172.I27.1

PLOT DATE: 4/16/2013

DRAWN BY: BMB

CHECKED BY: CDL

SHEET 127 OF 217