




DRIVE RT
104+00

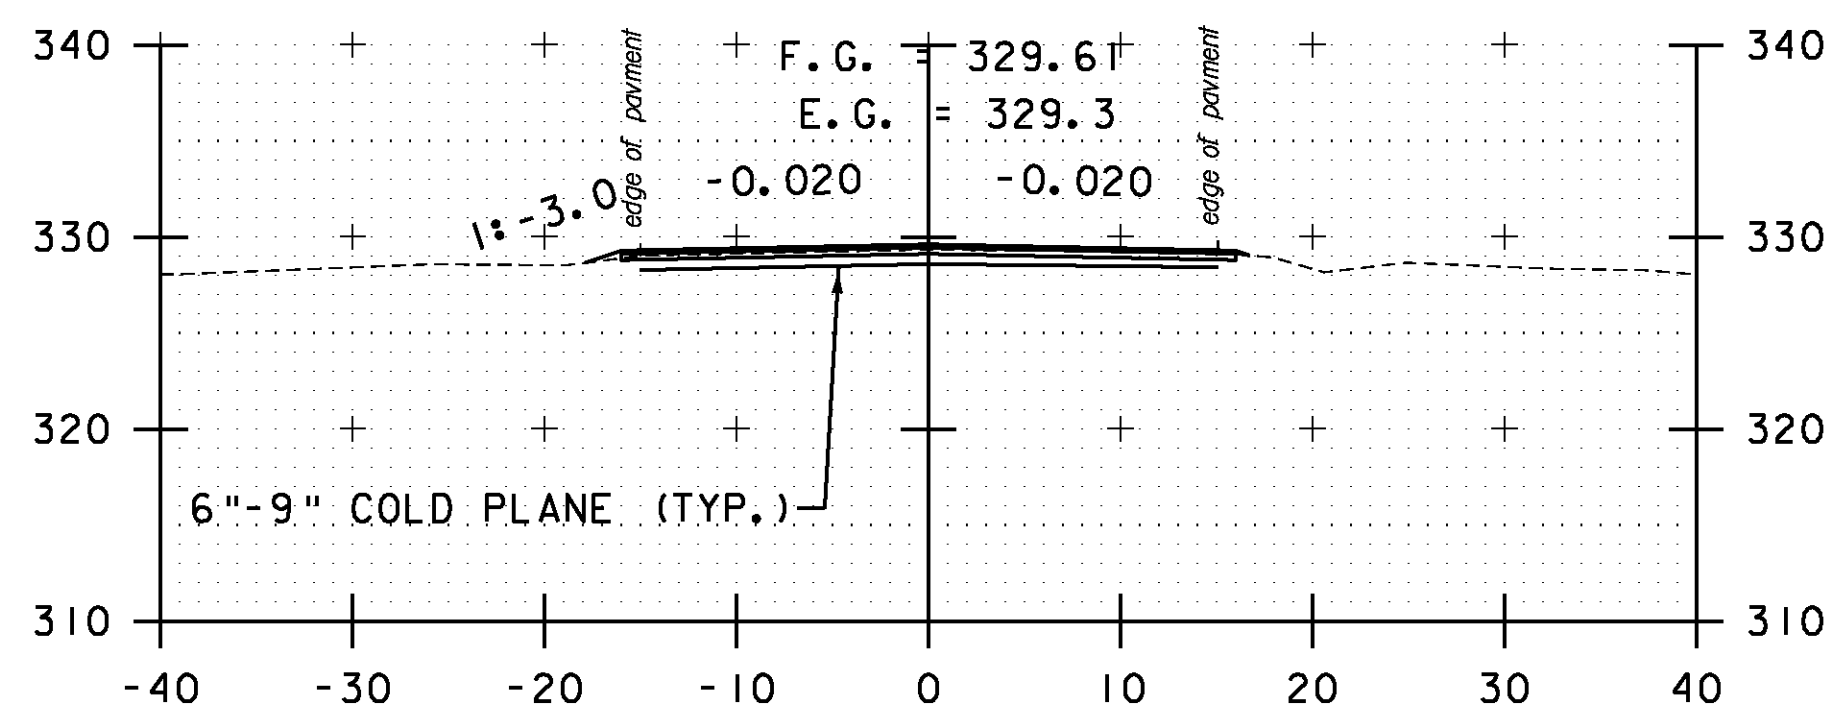


105+50

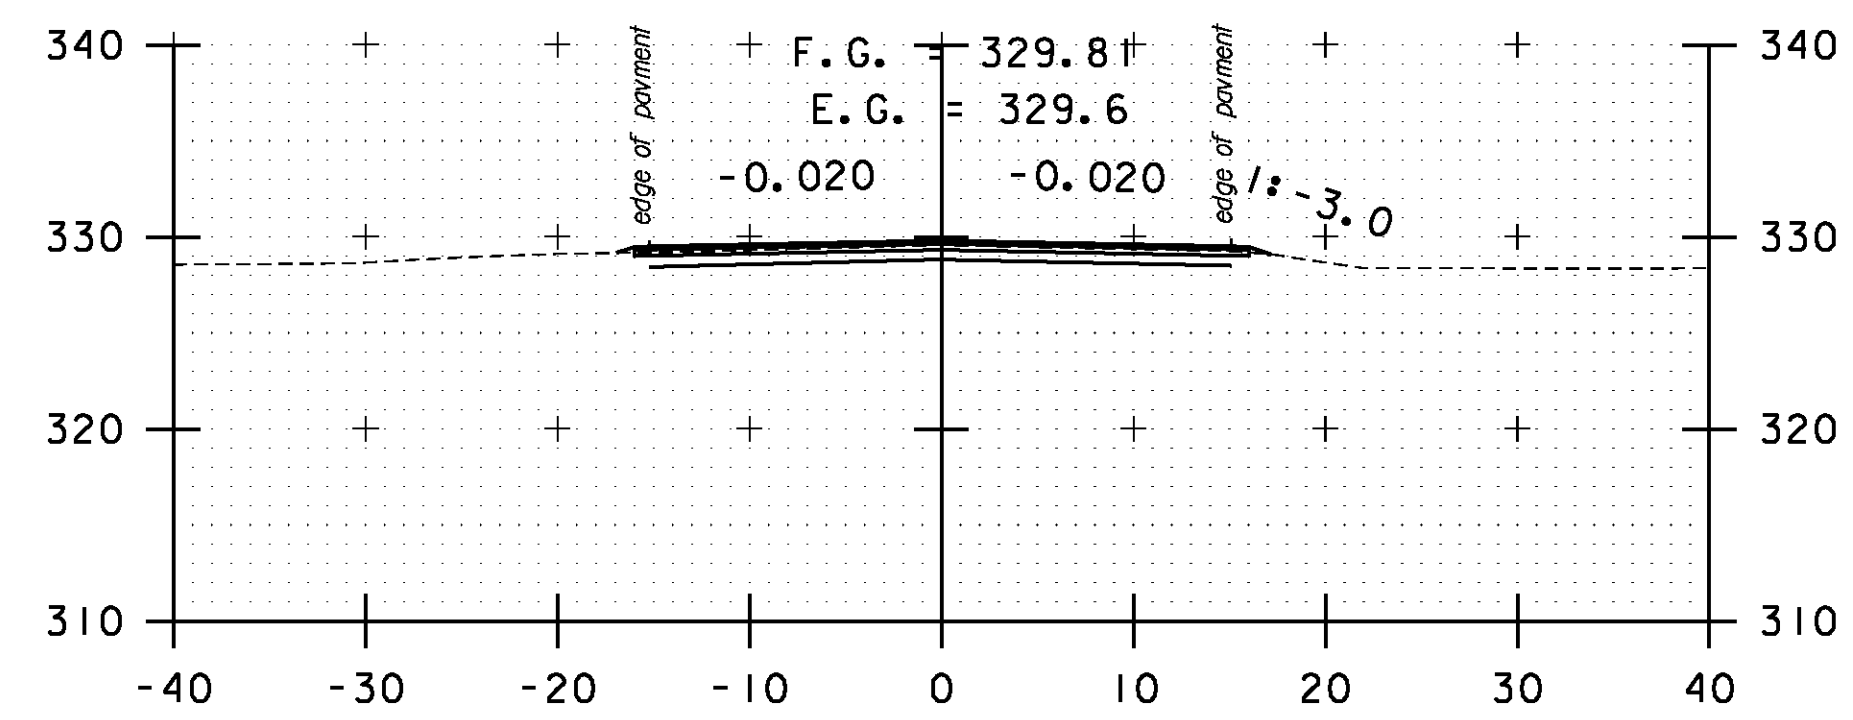


107+00

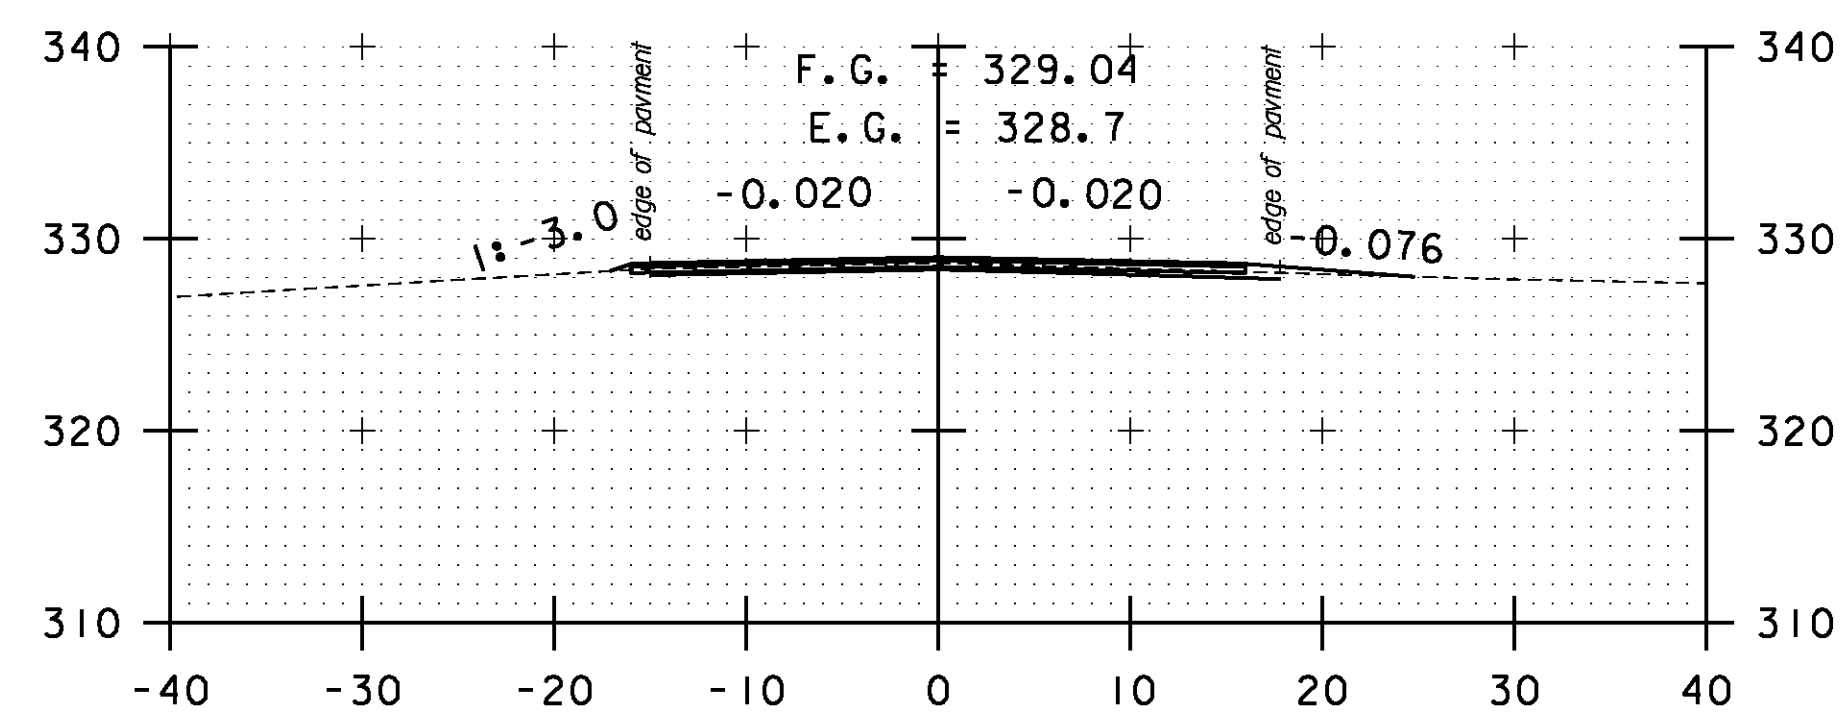


DRIVE RT
103+50

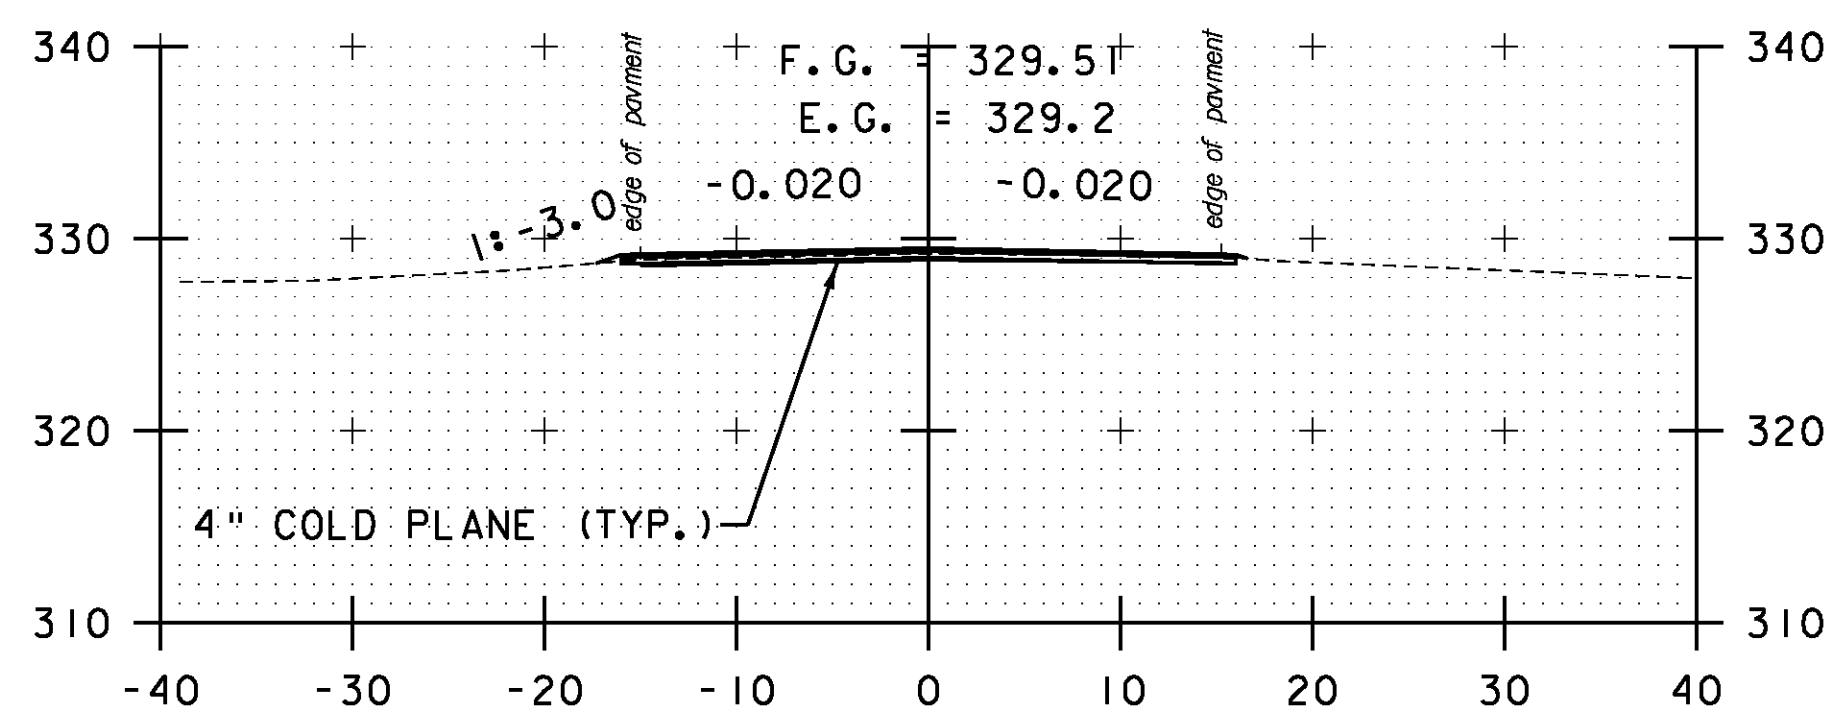


105+00

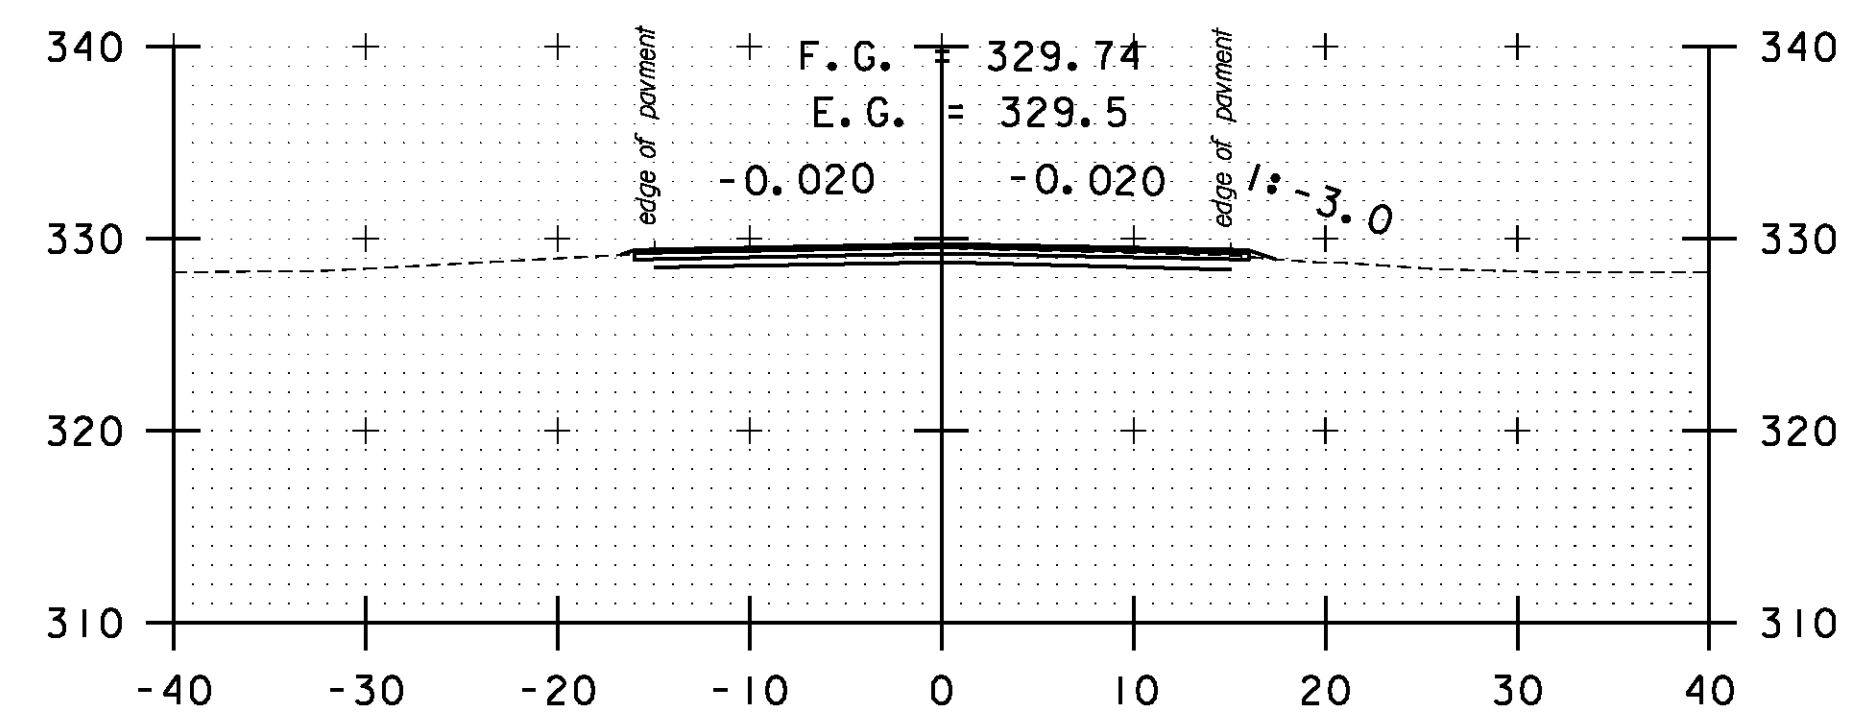


106+50

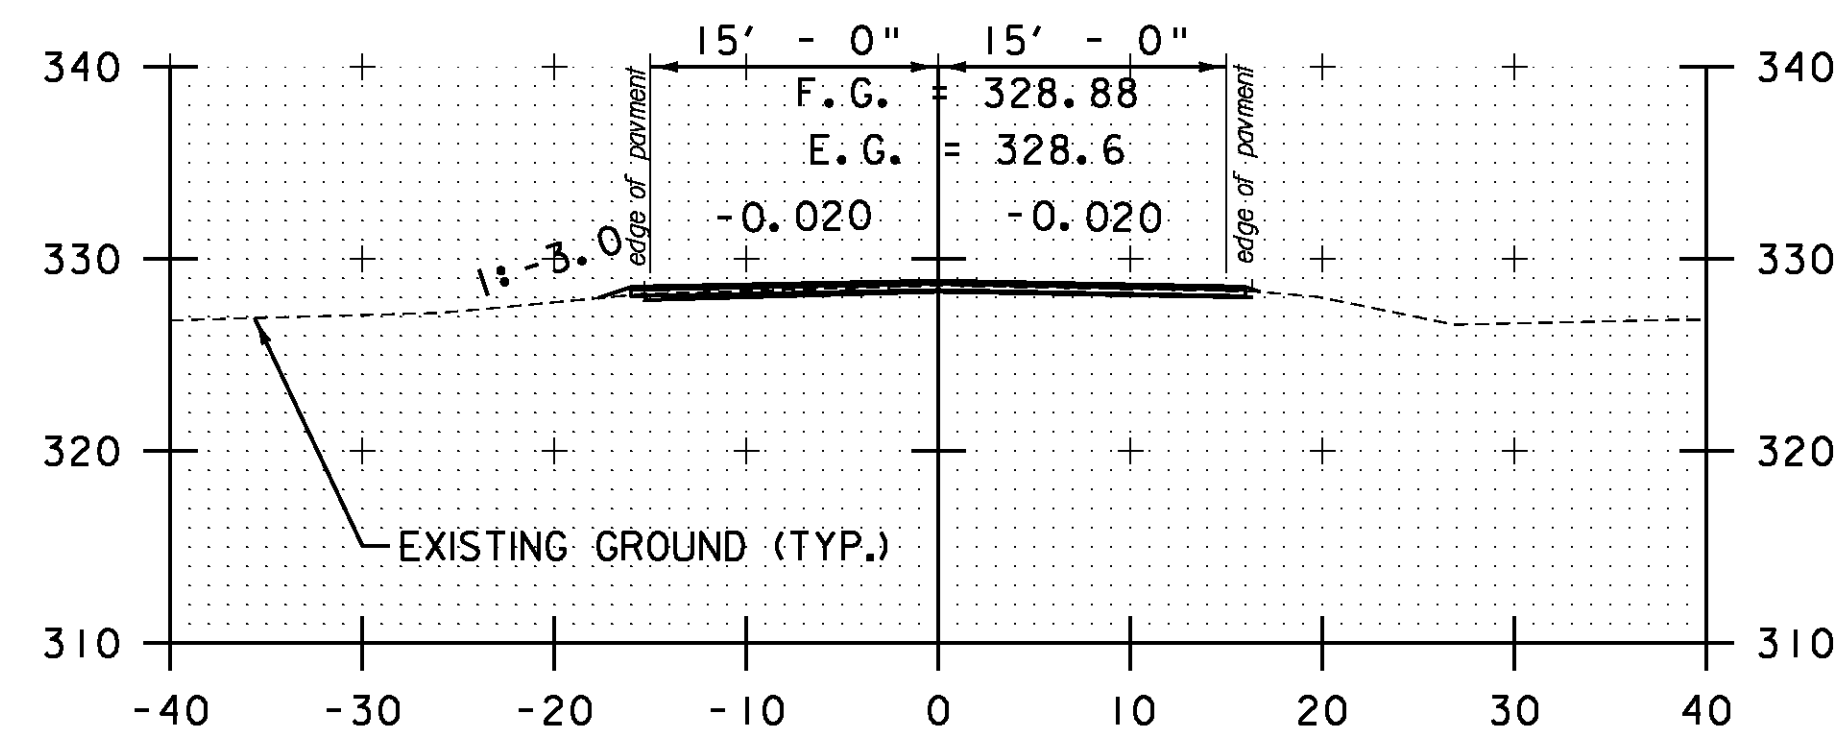

103+00

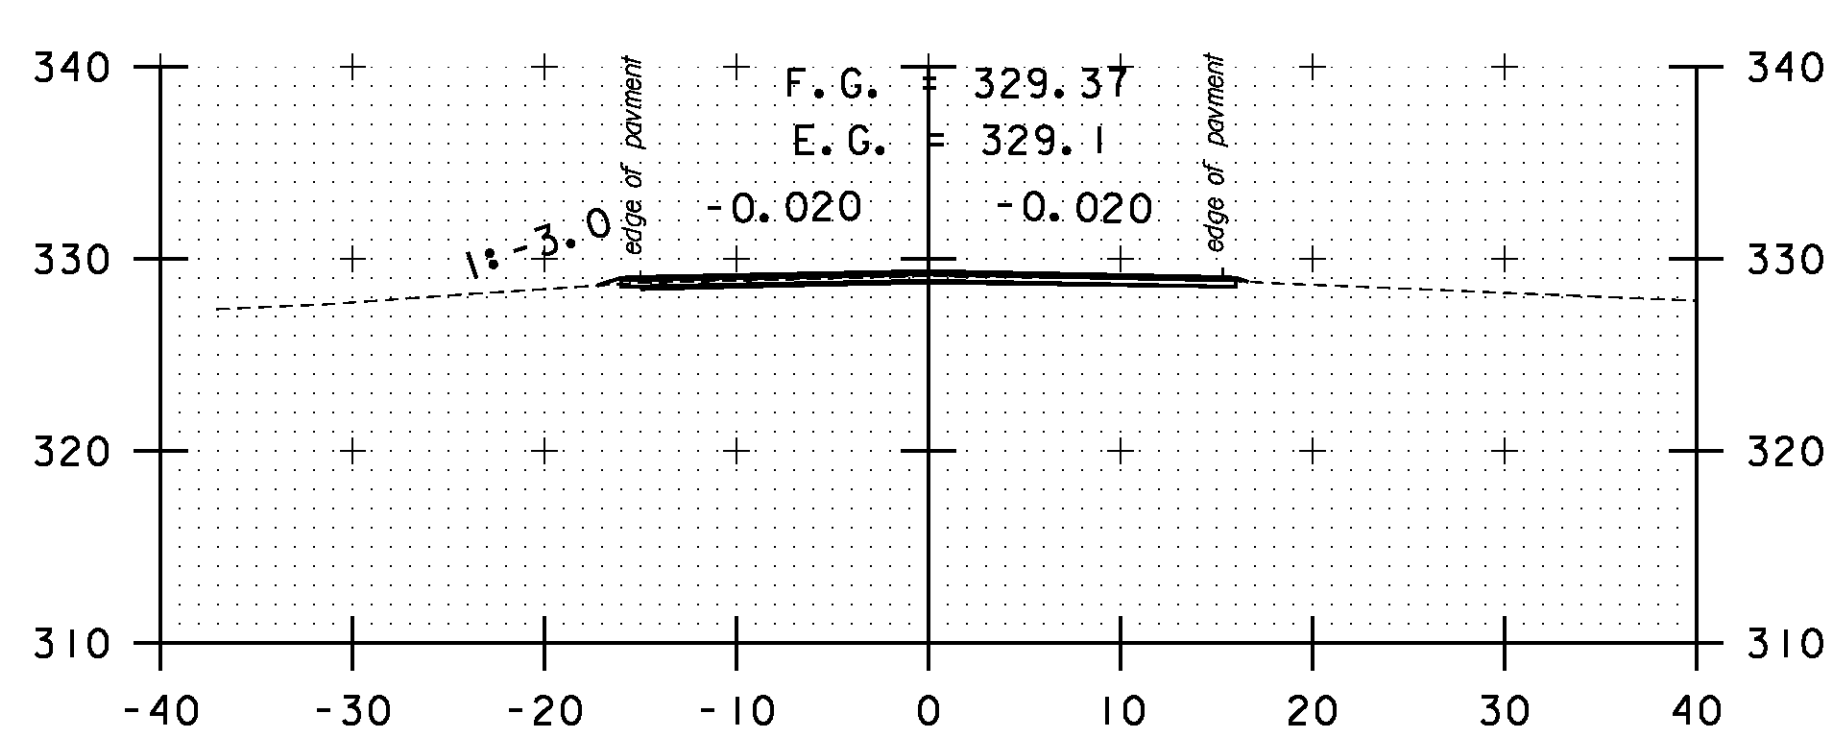


104+50

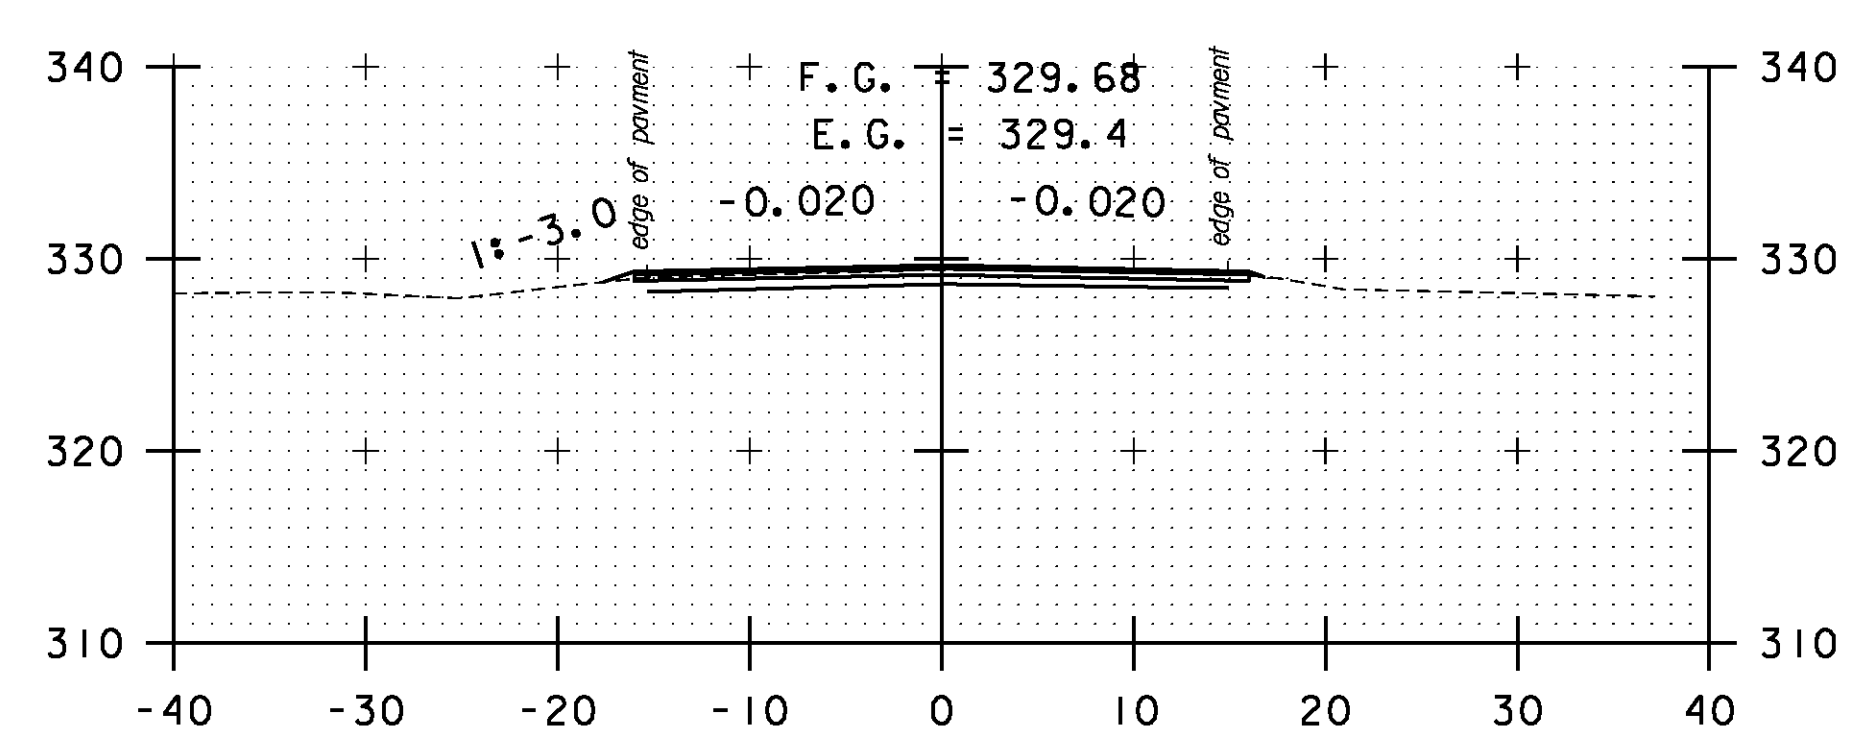

106+00

STA. 103+00 TO STA. 107+00

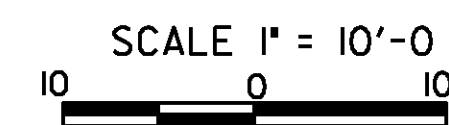

CROSS SECTION SHEET 2

PROJECT NAME: BOLTON-WATERBURY

PROJECT NUMBER: STP 2709(1)

FILE NAME: p07C172.dgn

PROJECT LEADER: CDL

DESIGNED BY: BMB

PLOT FILE: p07C172.128.1

PLOT DATE: 4/16/2013

DRAWN BY: BMB

CHECKED BY: CDL

SHEET 128 OF 217