




108+50

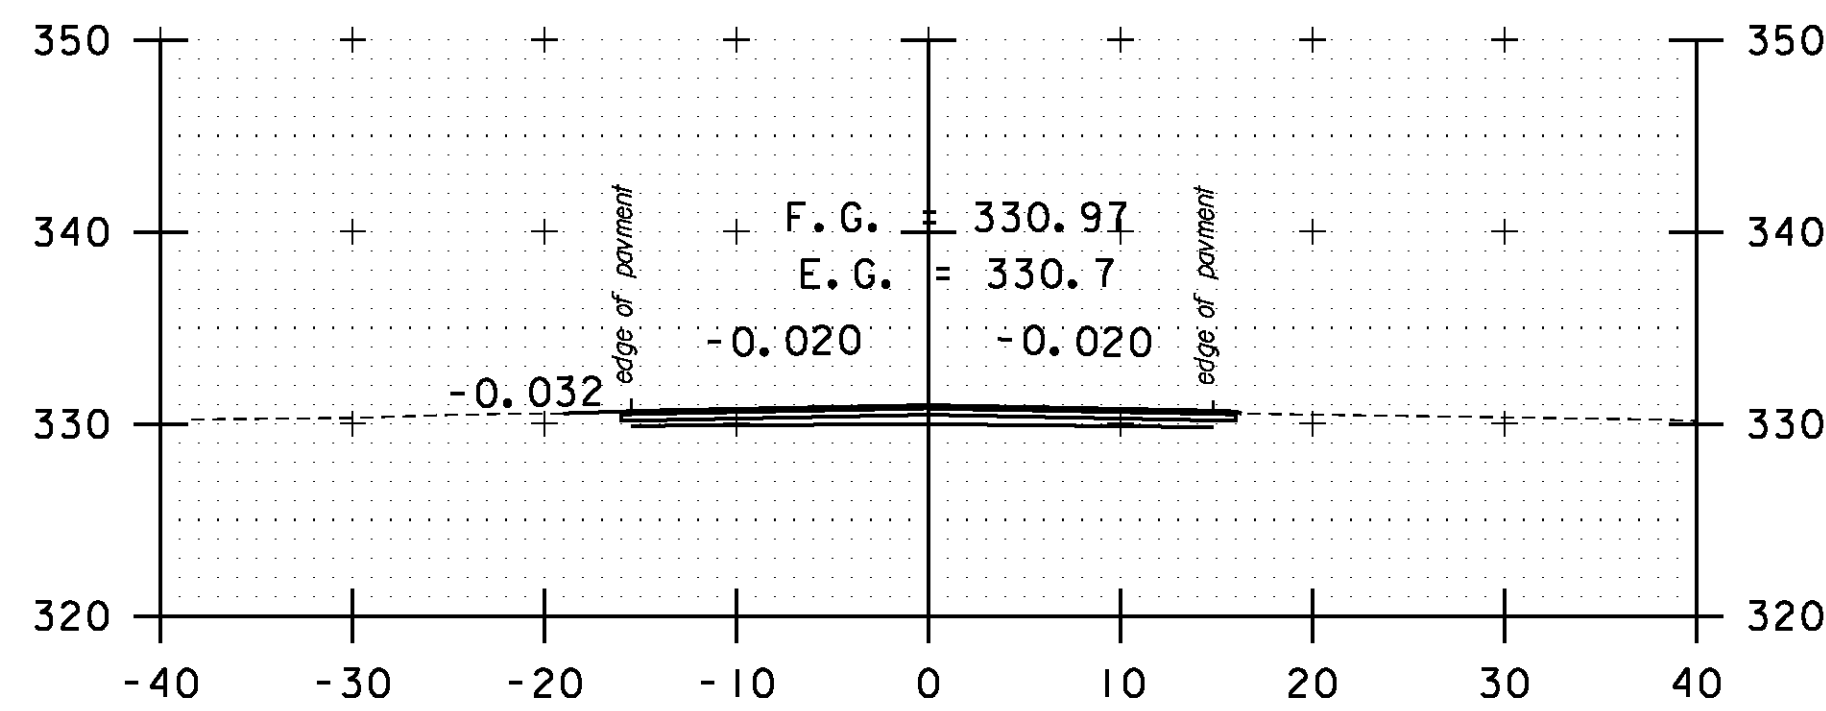


DRIVE LT
110+00

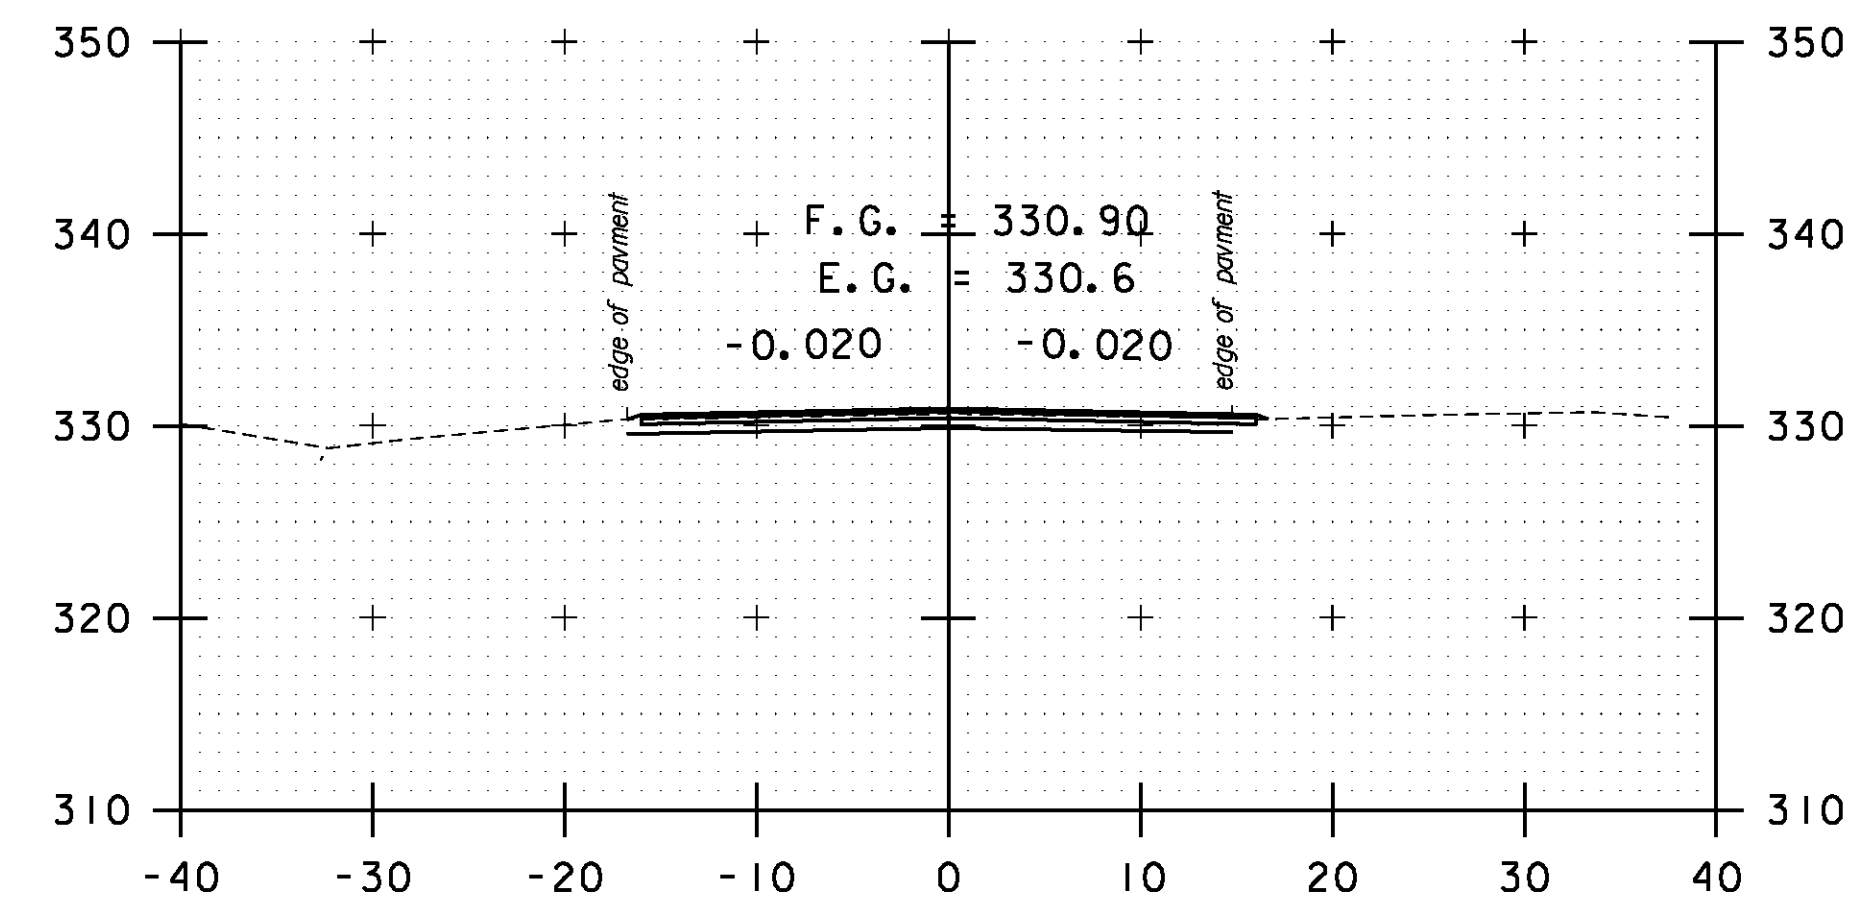


111+50

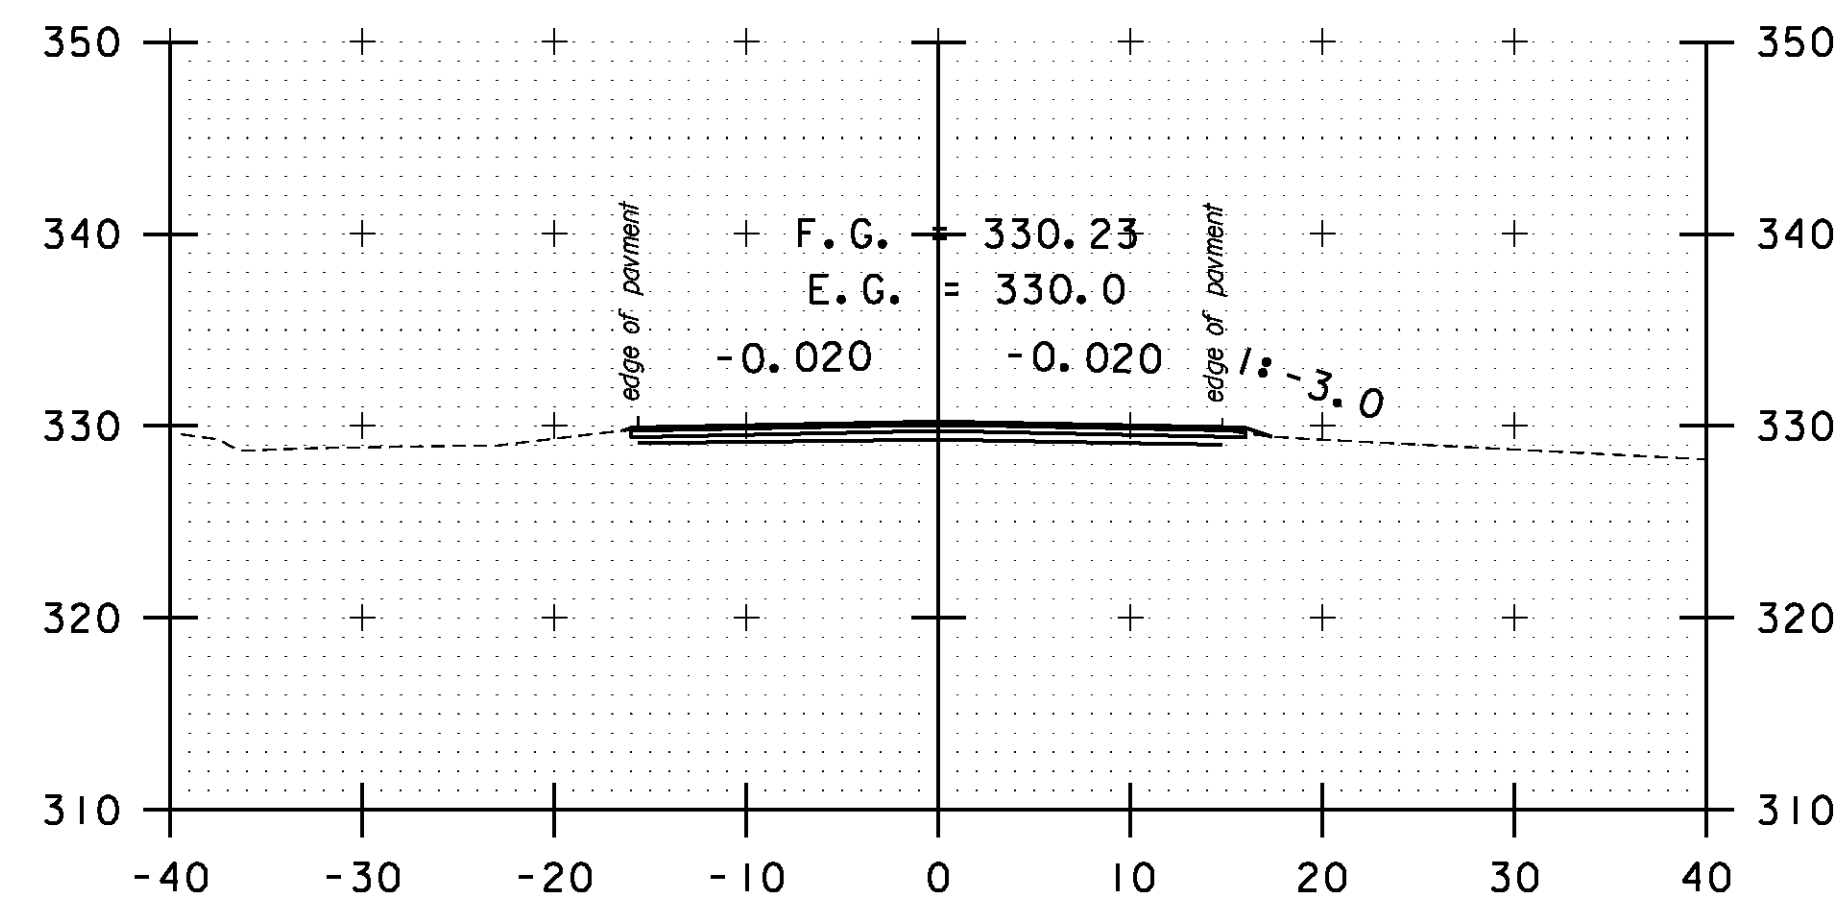


108+00

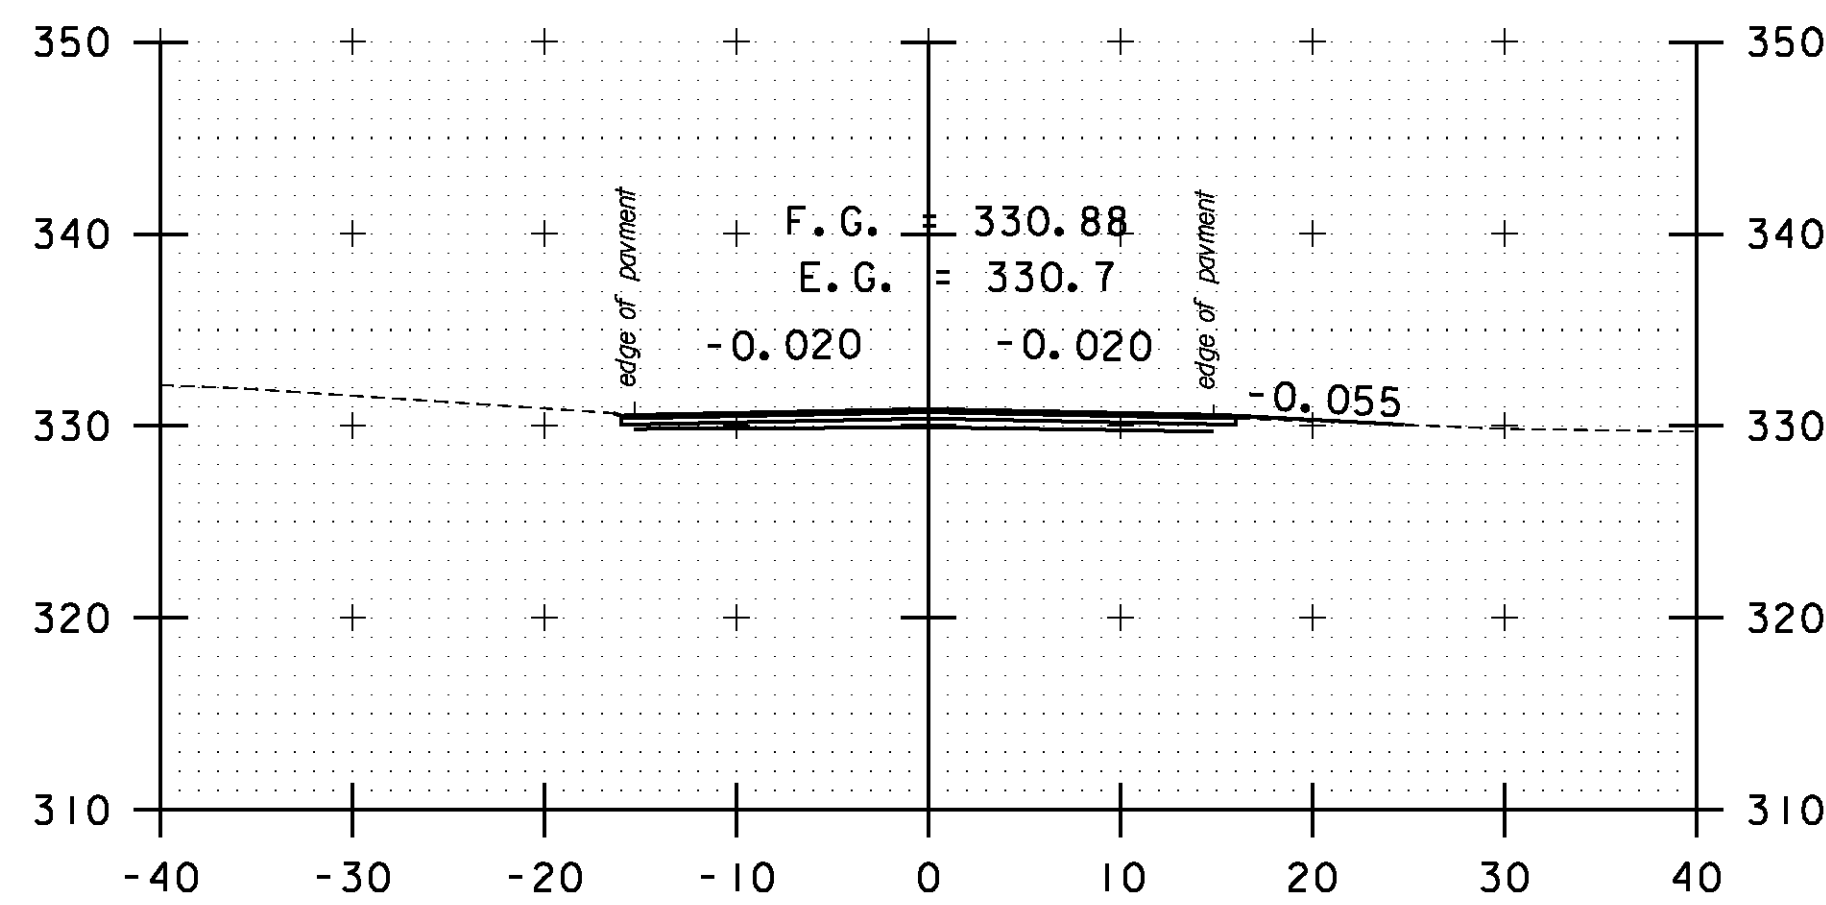


DRIVE RT
109+50

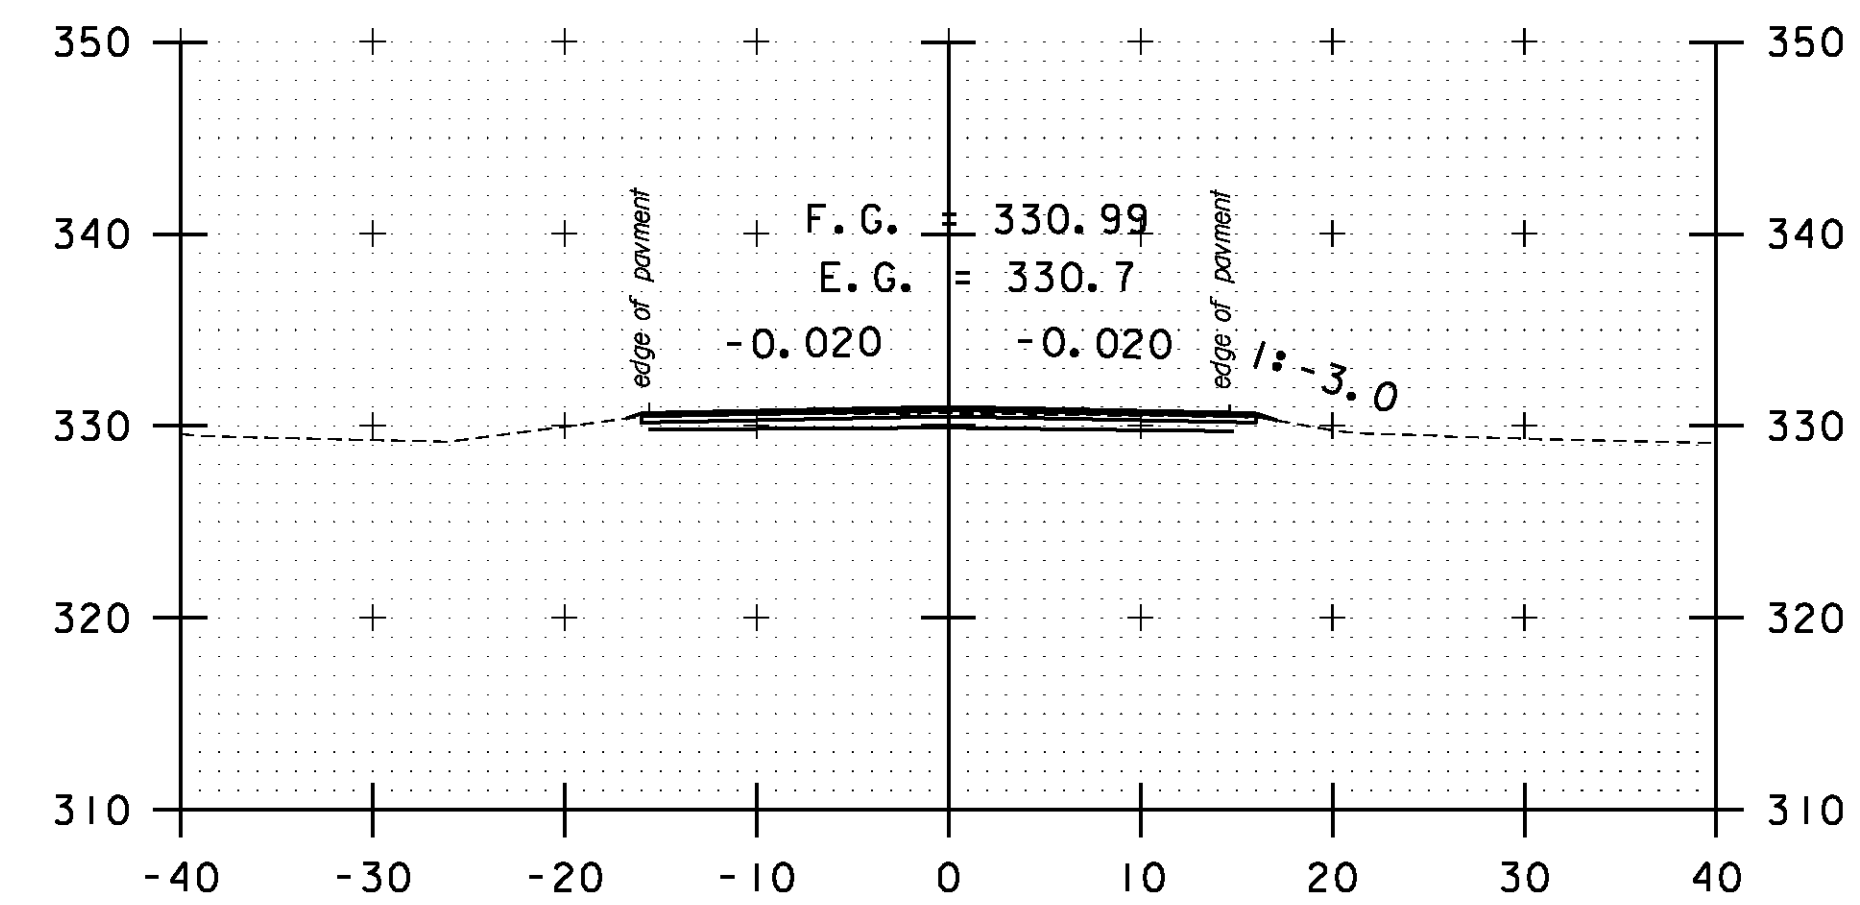


111+00

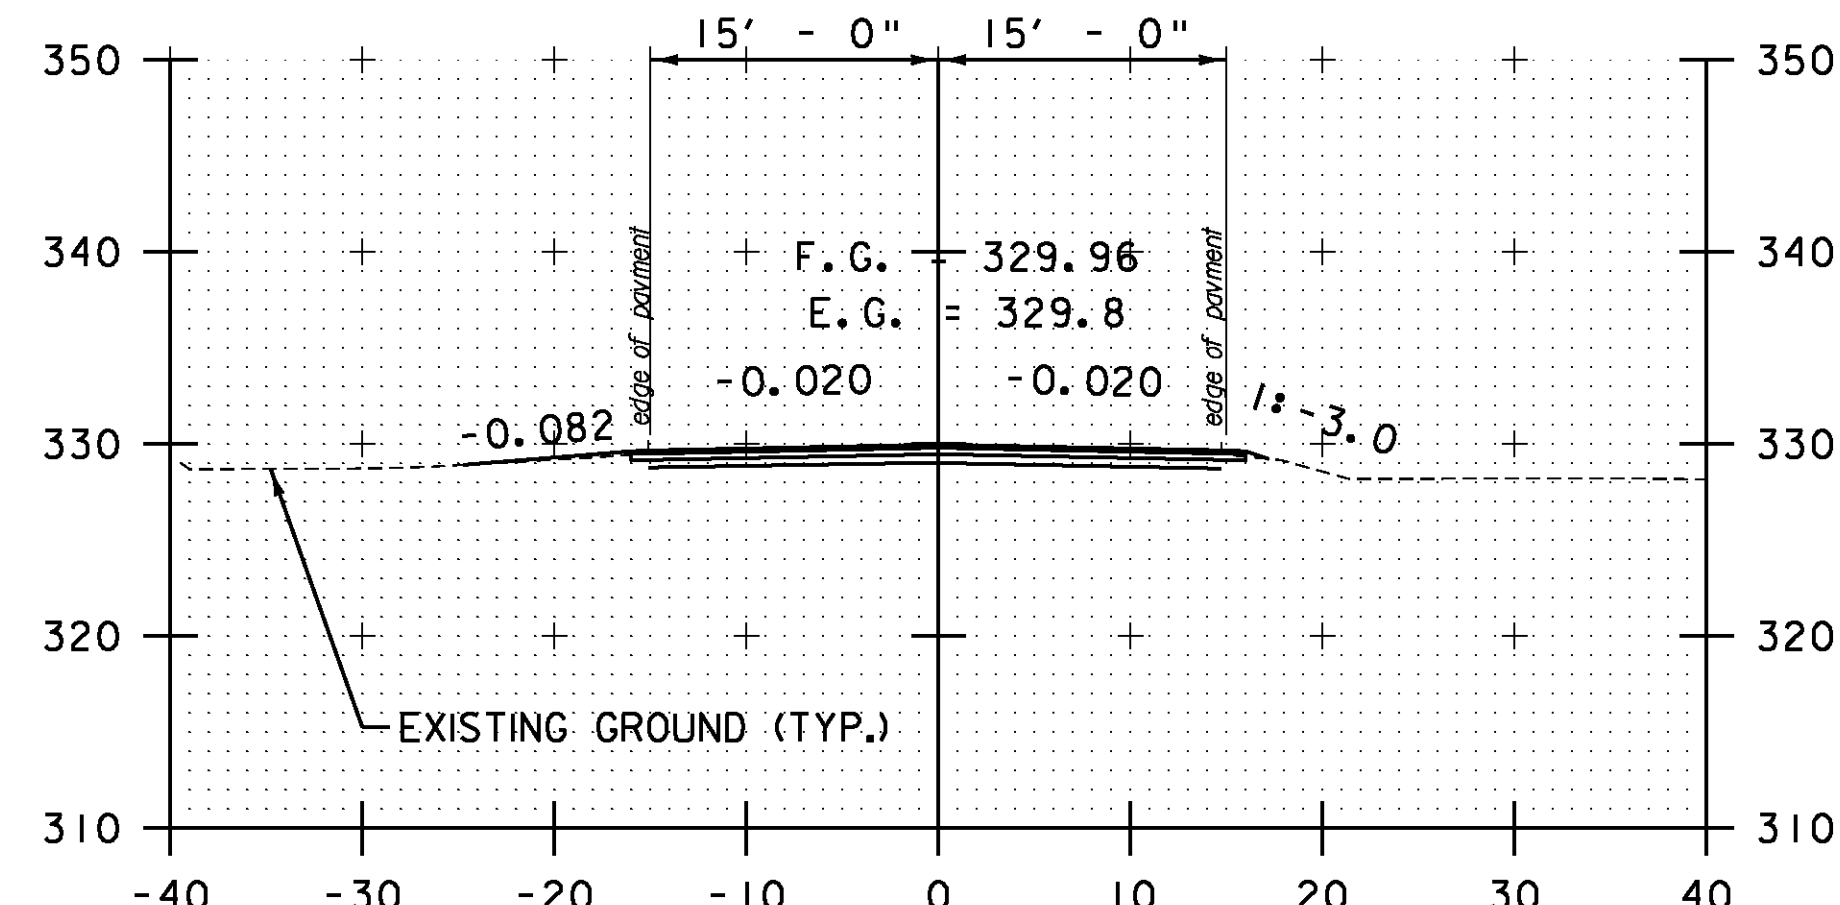

DRIVE LT
107+50

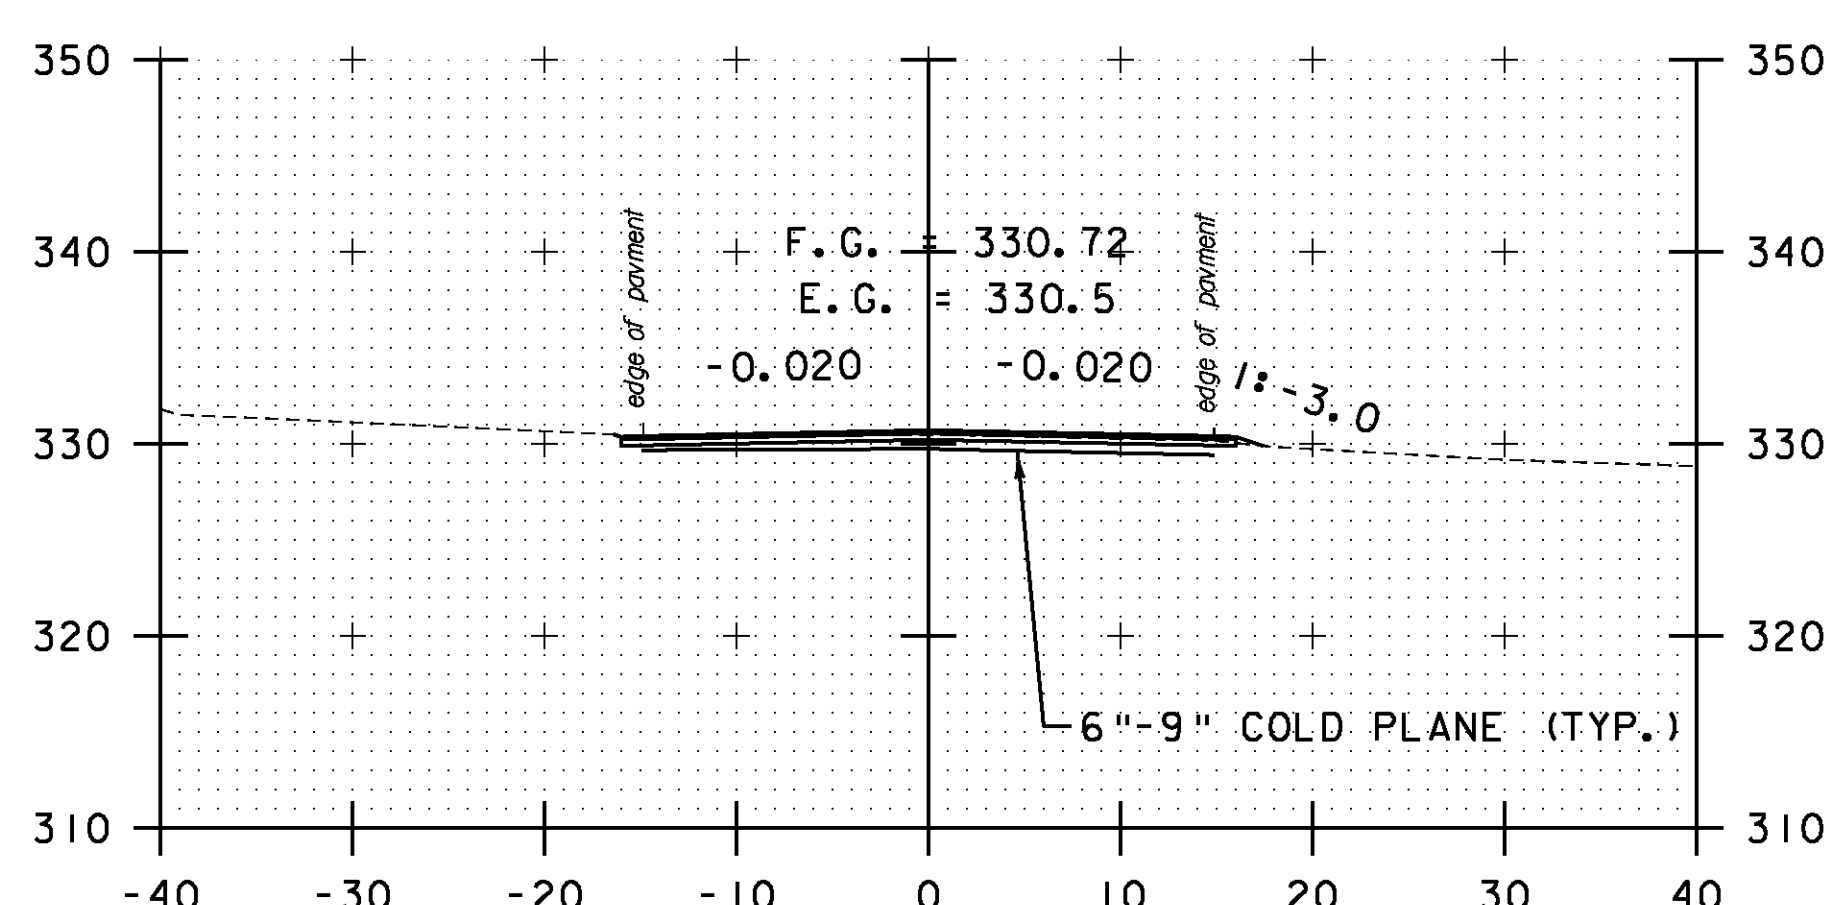

109+00

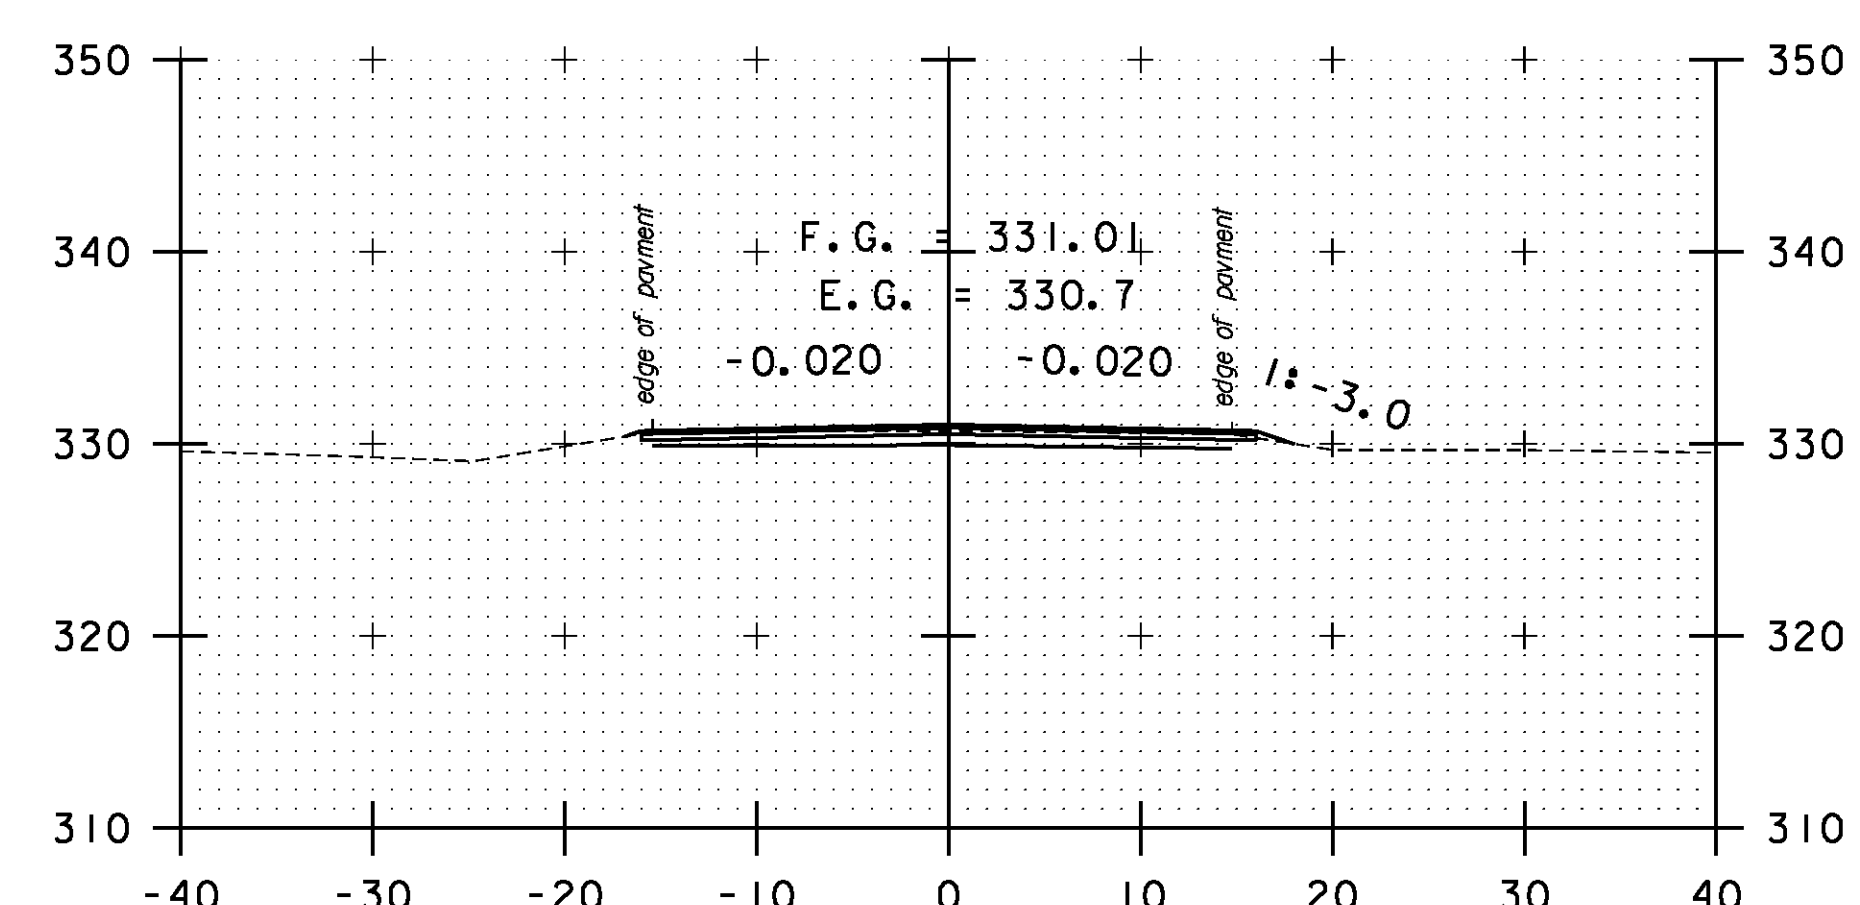

110+50

STA. 107+50 TO STA. 111+50

SCALE 1" = 10'-0"
0 10

CROSS SECTION SHEET 3

PROJECT NAME: BOLTON-WATERBURY

PROJECT NUMBER: STP 2709(1)

FILE NAME: p07C172.dgn

PROJECT LEADER: CDL

DESIGNED BY: BMB

PLOT FILE: p07C172.129.1

PLOT DATE: 4/16/2013

DRAWN BY: BMB

CHECKED BY: CDL

SHEET 129 OF 217