




DRIVE RT
113+00

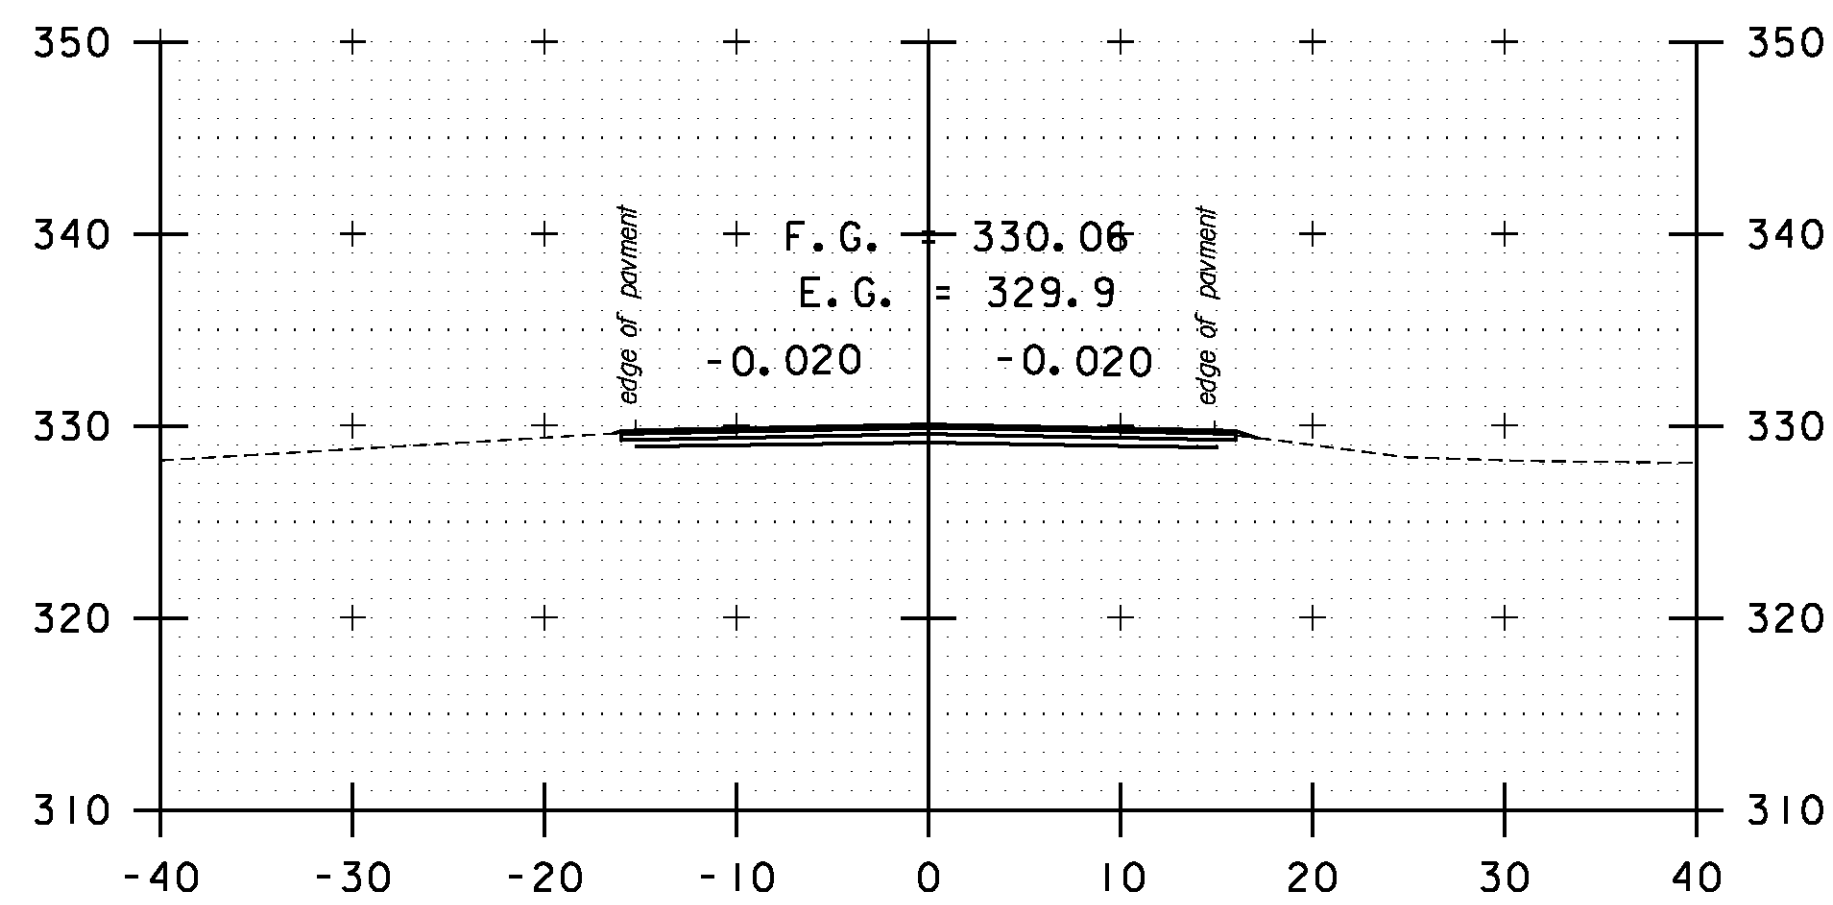


114+50

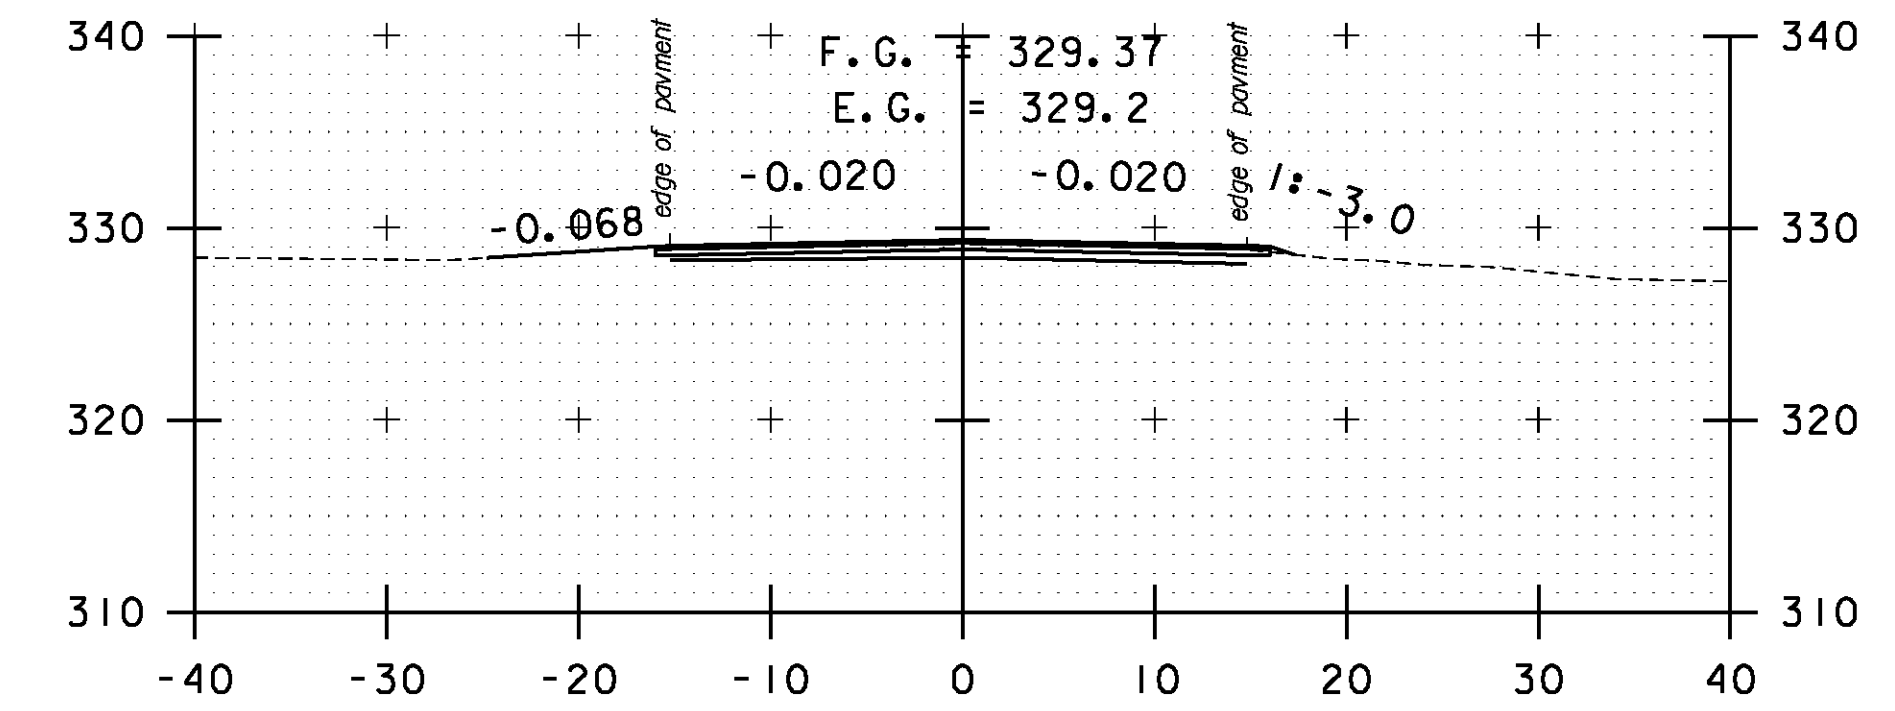


DRIVE LT
116+00

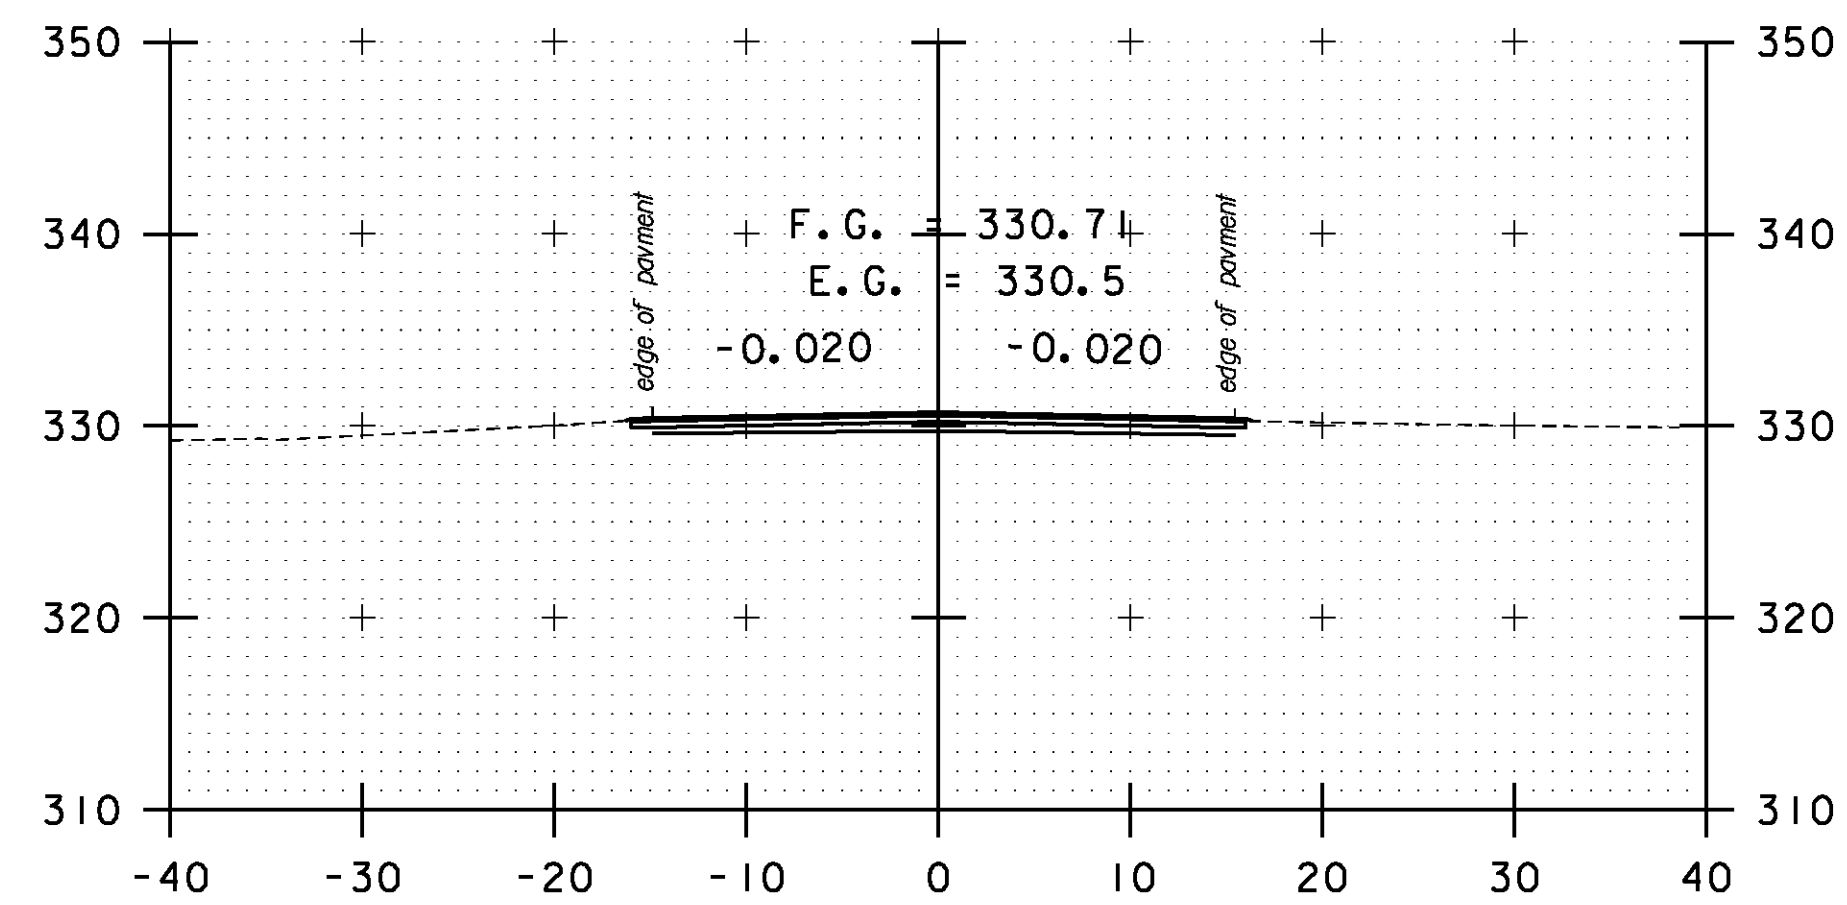


112+50

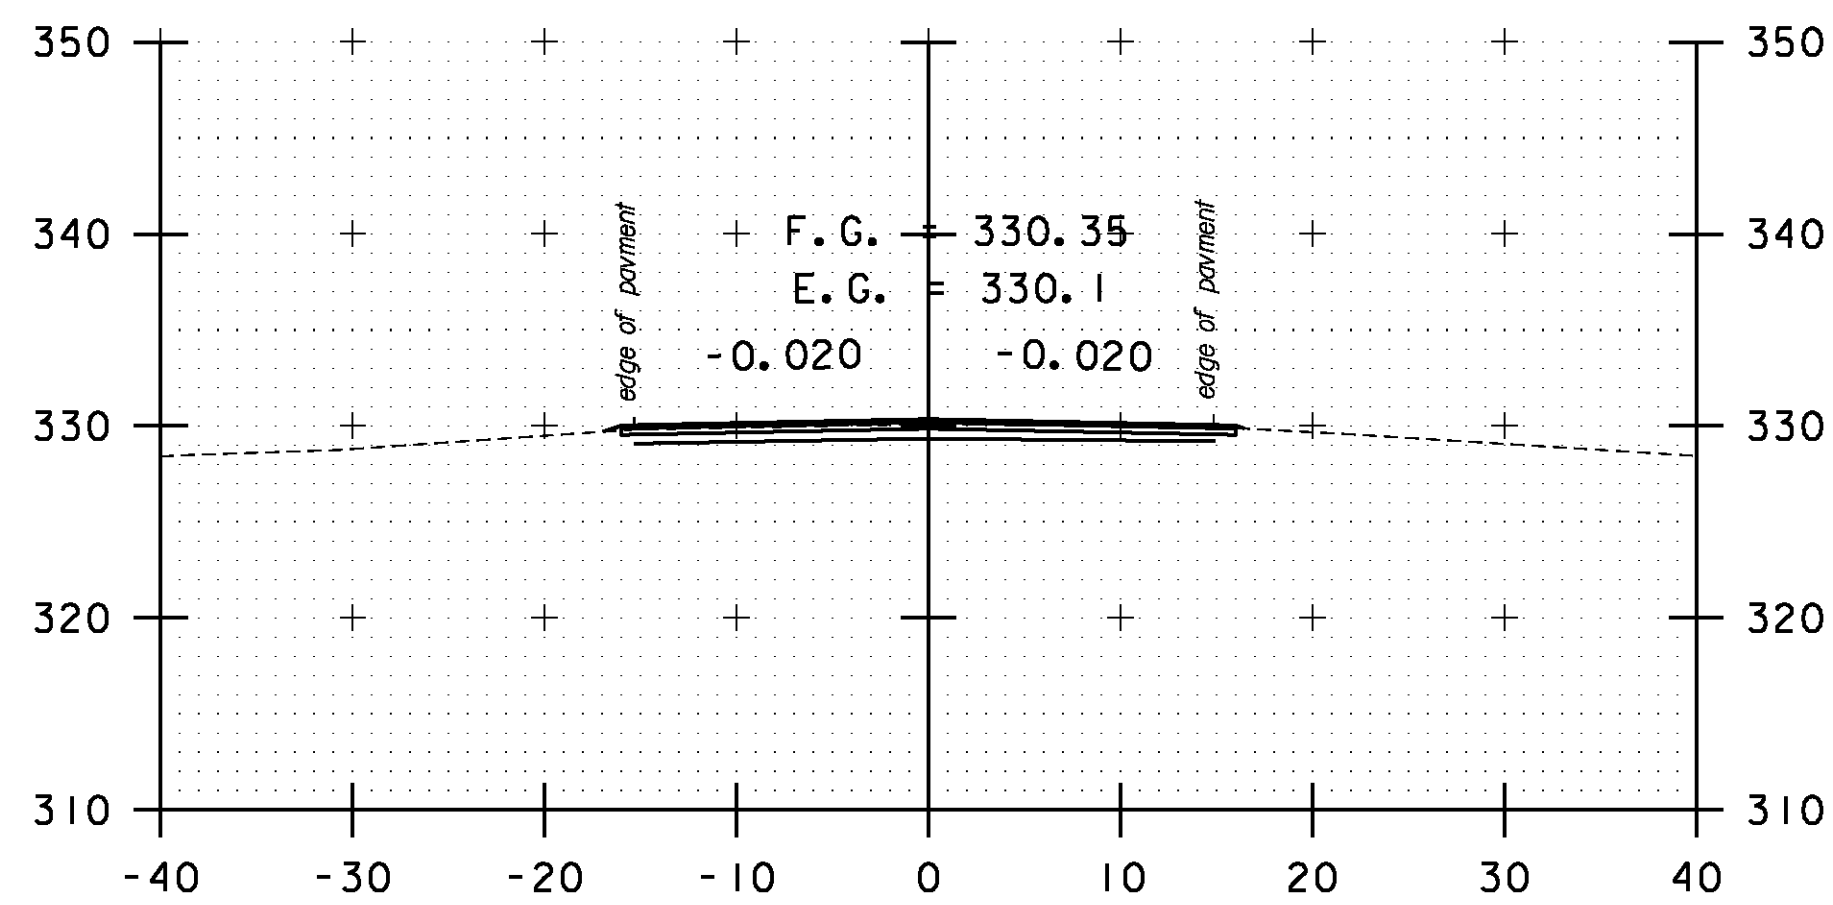


114+00

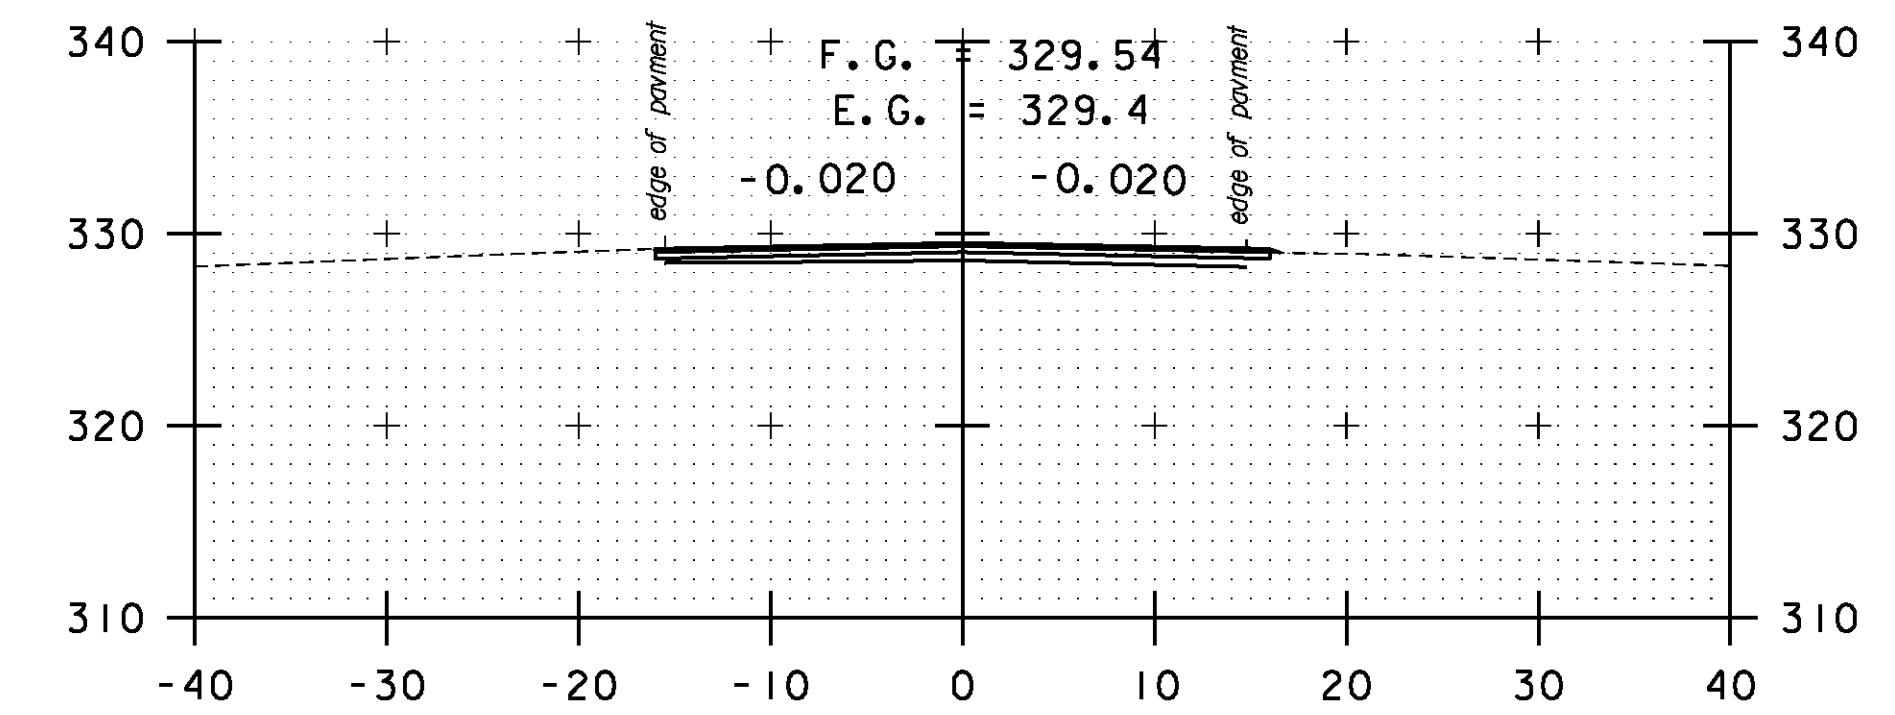


115+50

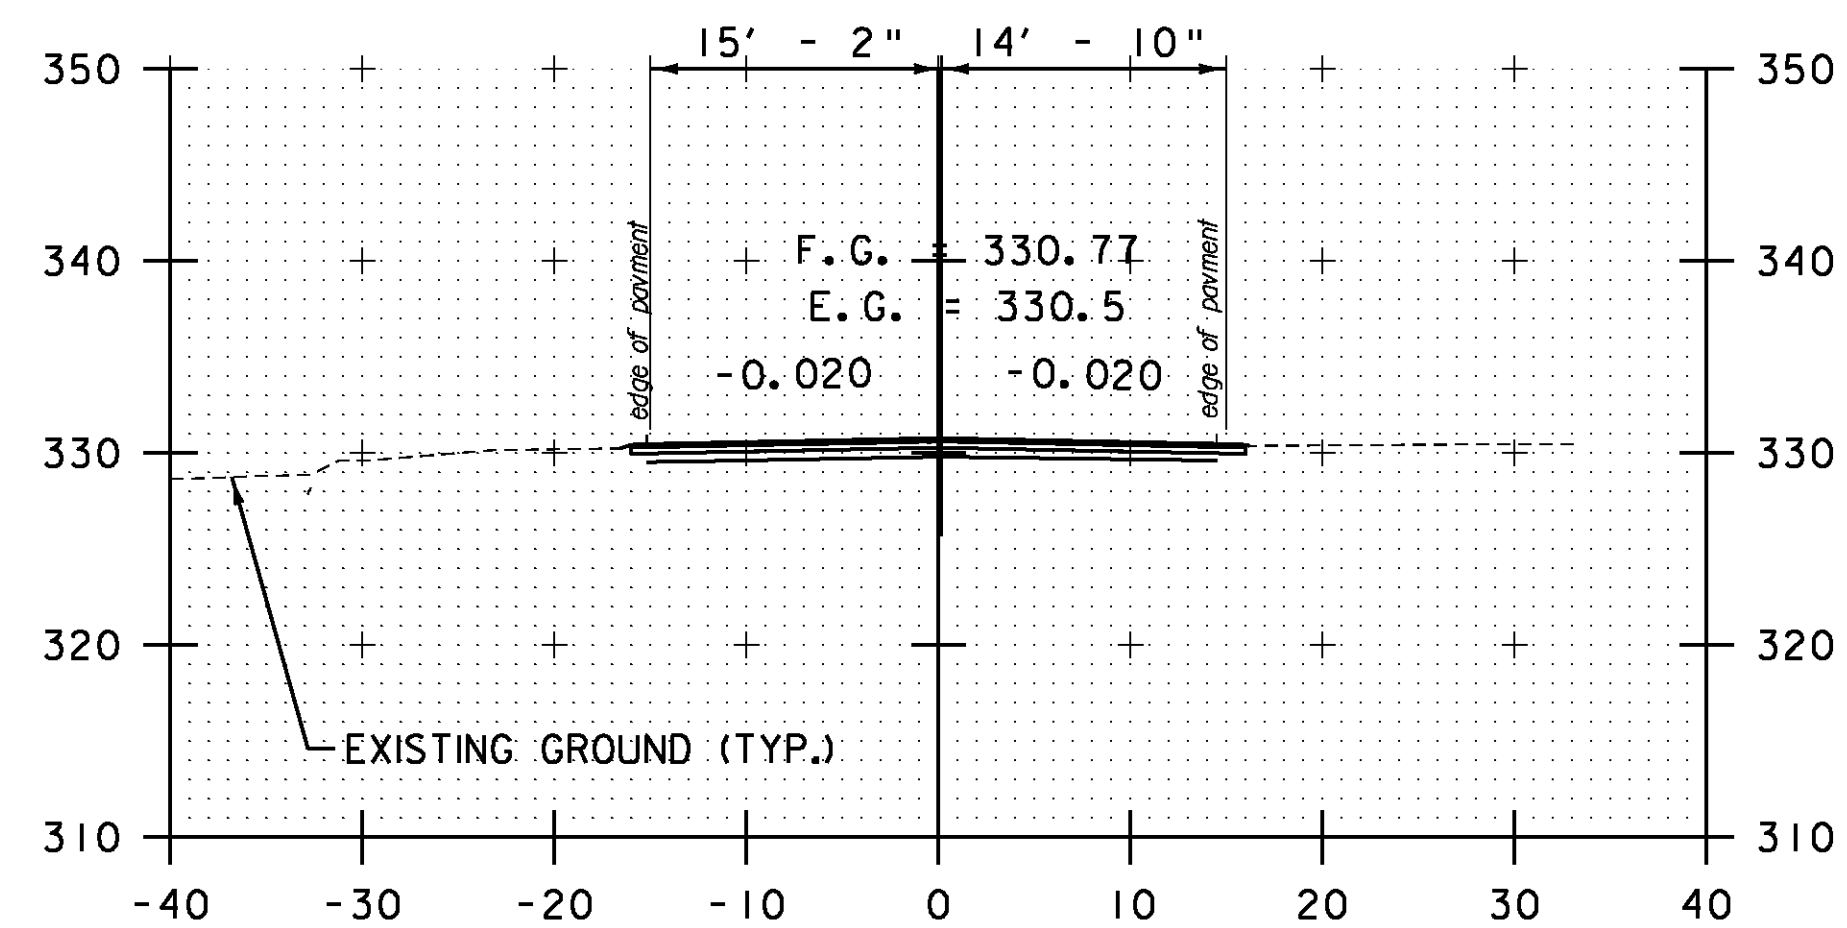

112+00

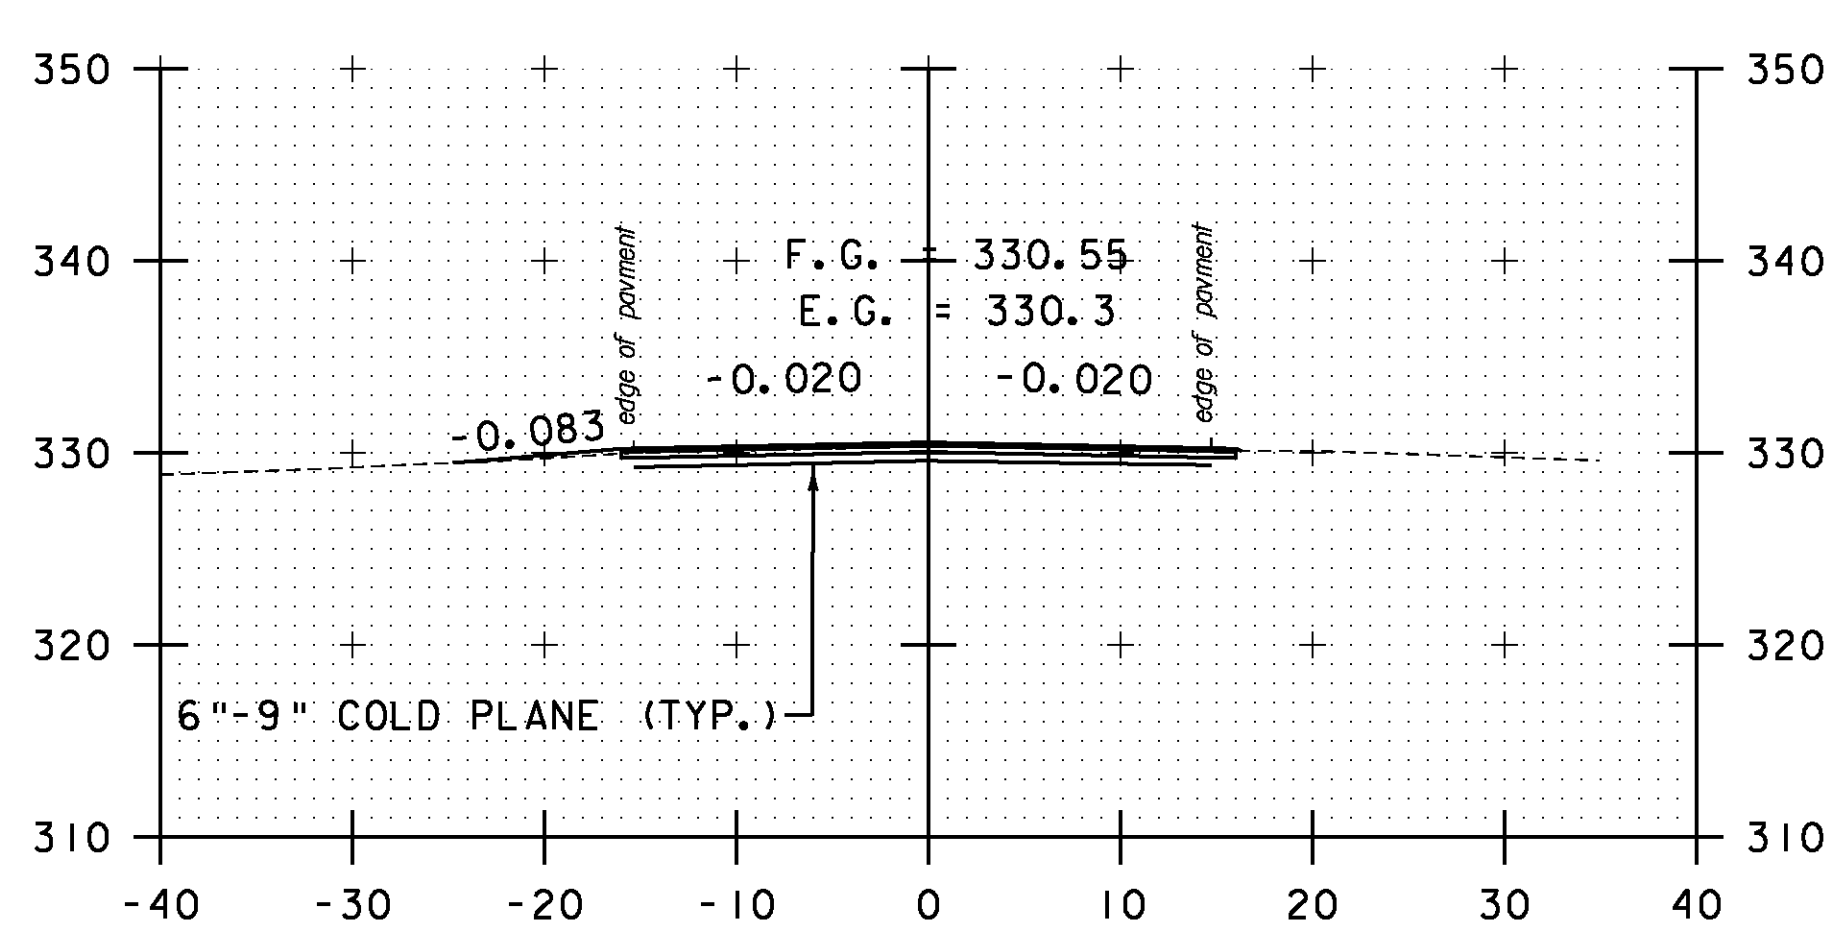

DRIVE LT
113+50

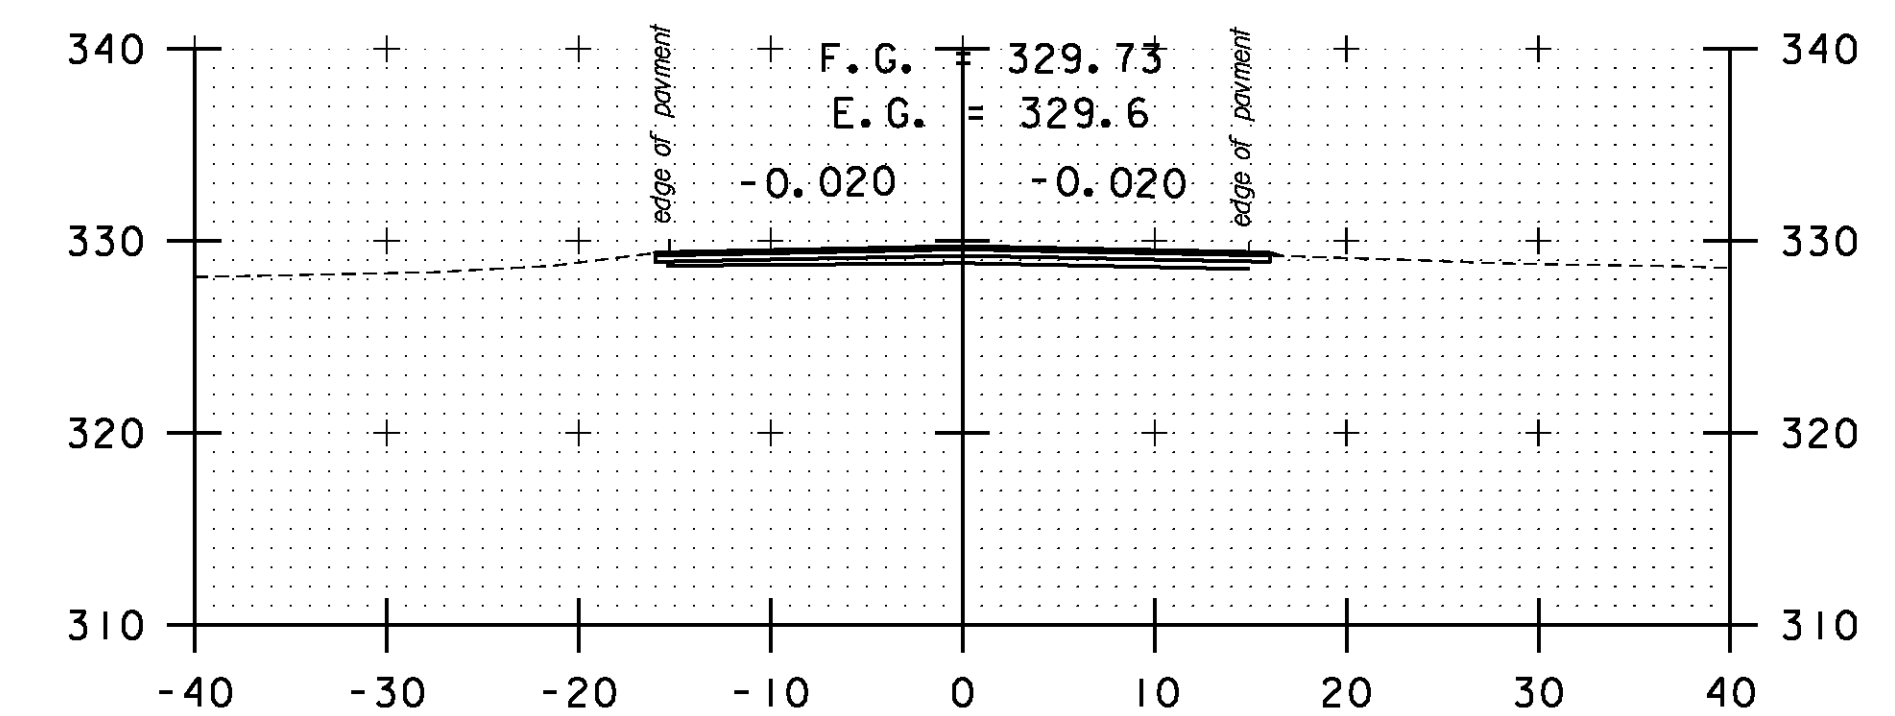

115+00

STA. 112+00 TO STA. 116+00

SCALE 1" = 10'-0"
10 0 10

CROSS SECTION SHEET 4

PROJECT NAME: BOLTON-WATERBURY

PROJECT NUMBER: STP 2709(1)

FILE NAME: p07C172.dgn

PROJECT LEADER: CDL

DESIGNED BY: BMB

PLOT FILE: p07C172_130.1

PLOT DATE: 4/16/2013

DRAWN BY: BMB

CHECKED BY: CDL

SHEET 130 OF 217