




117+50

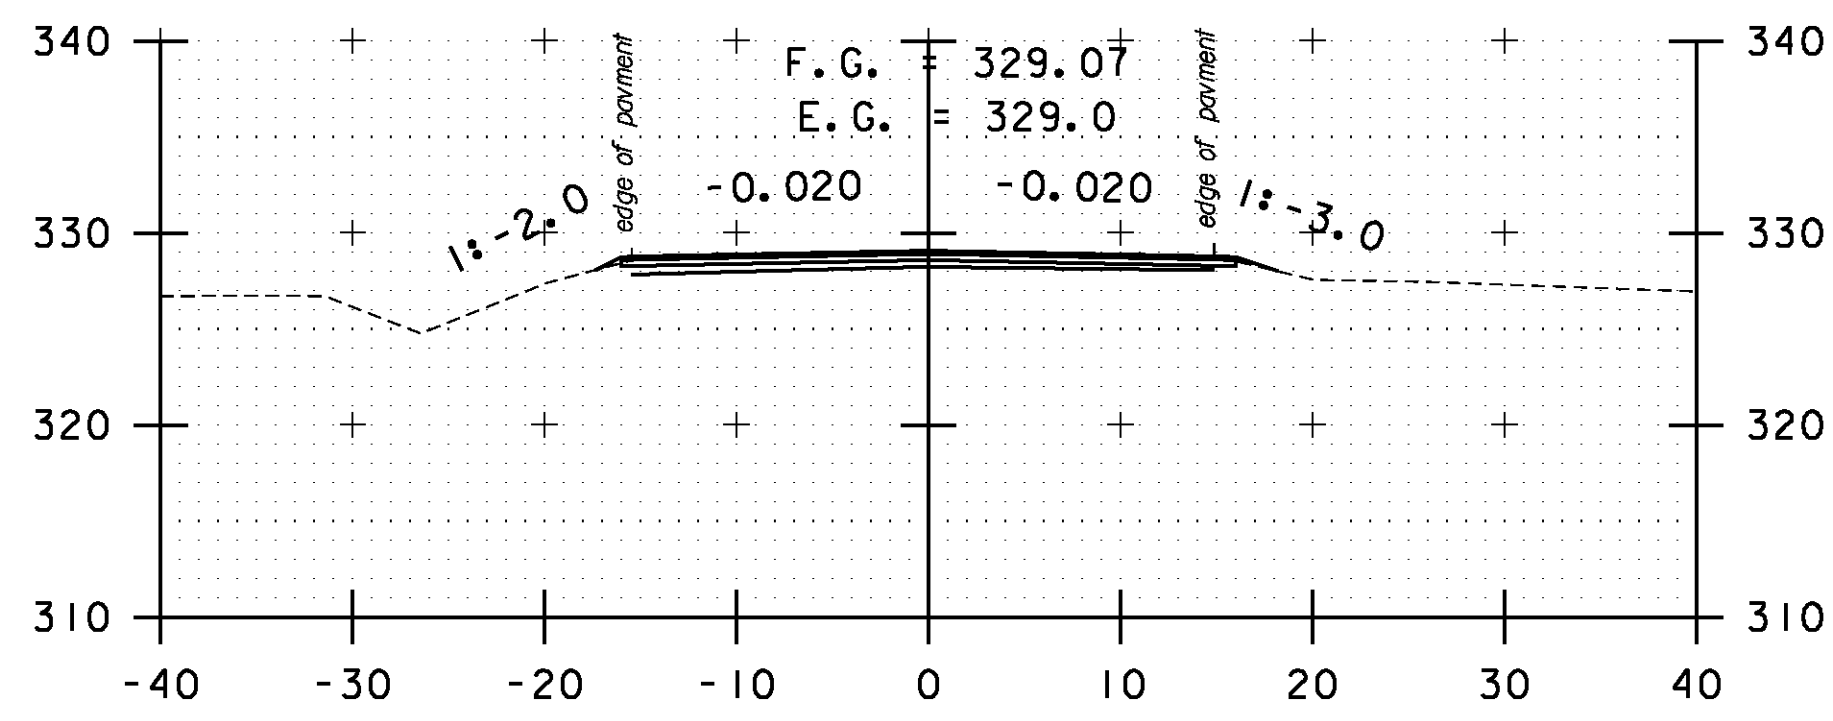


119+00

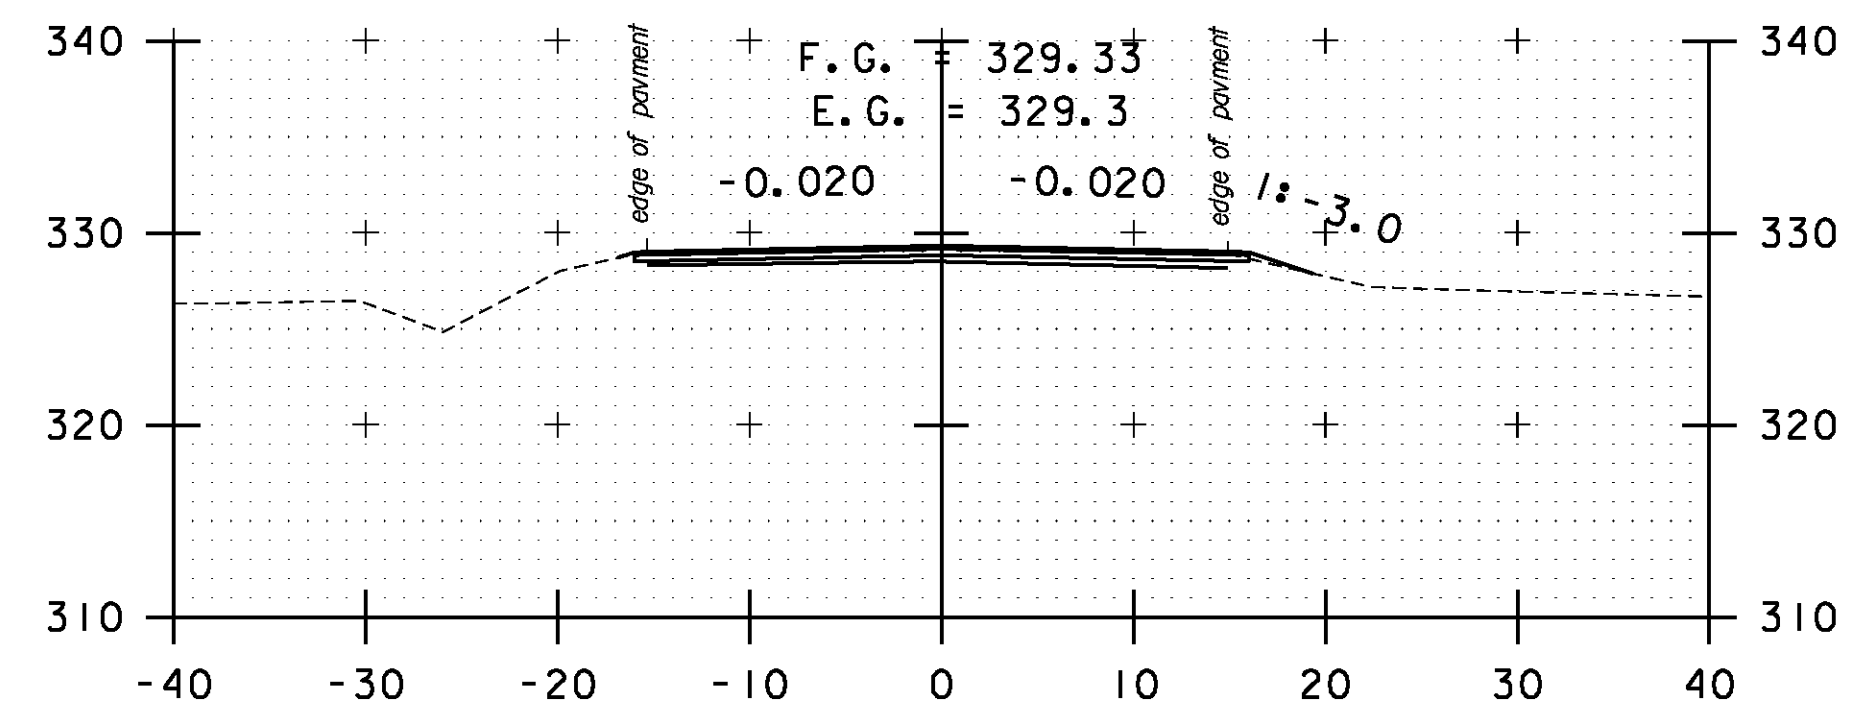


120+50

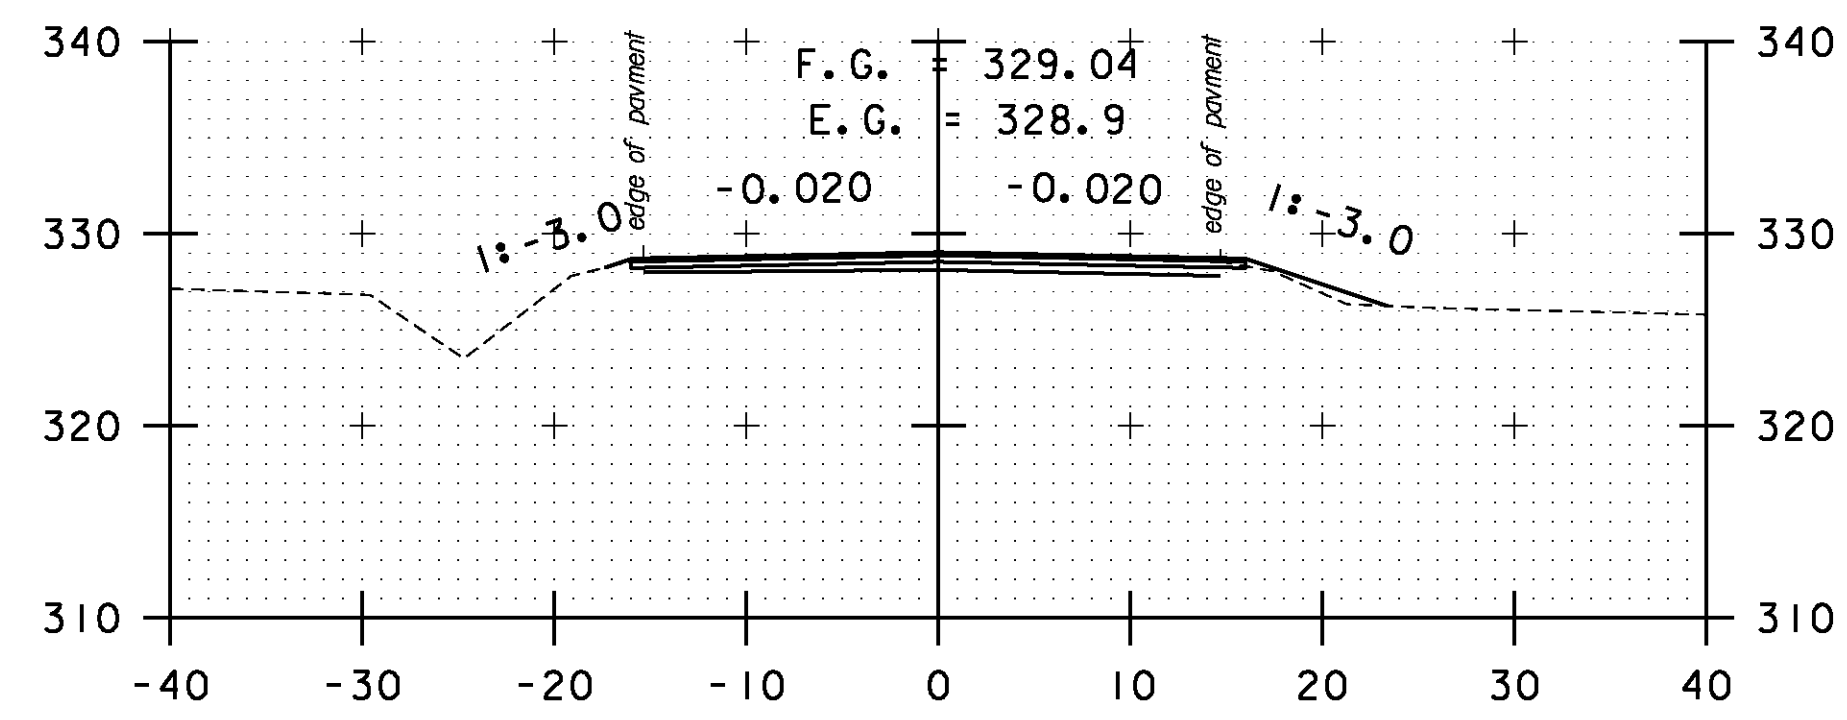


117+00

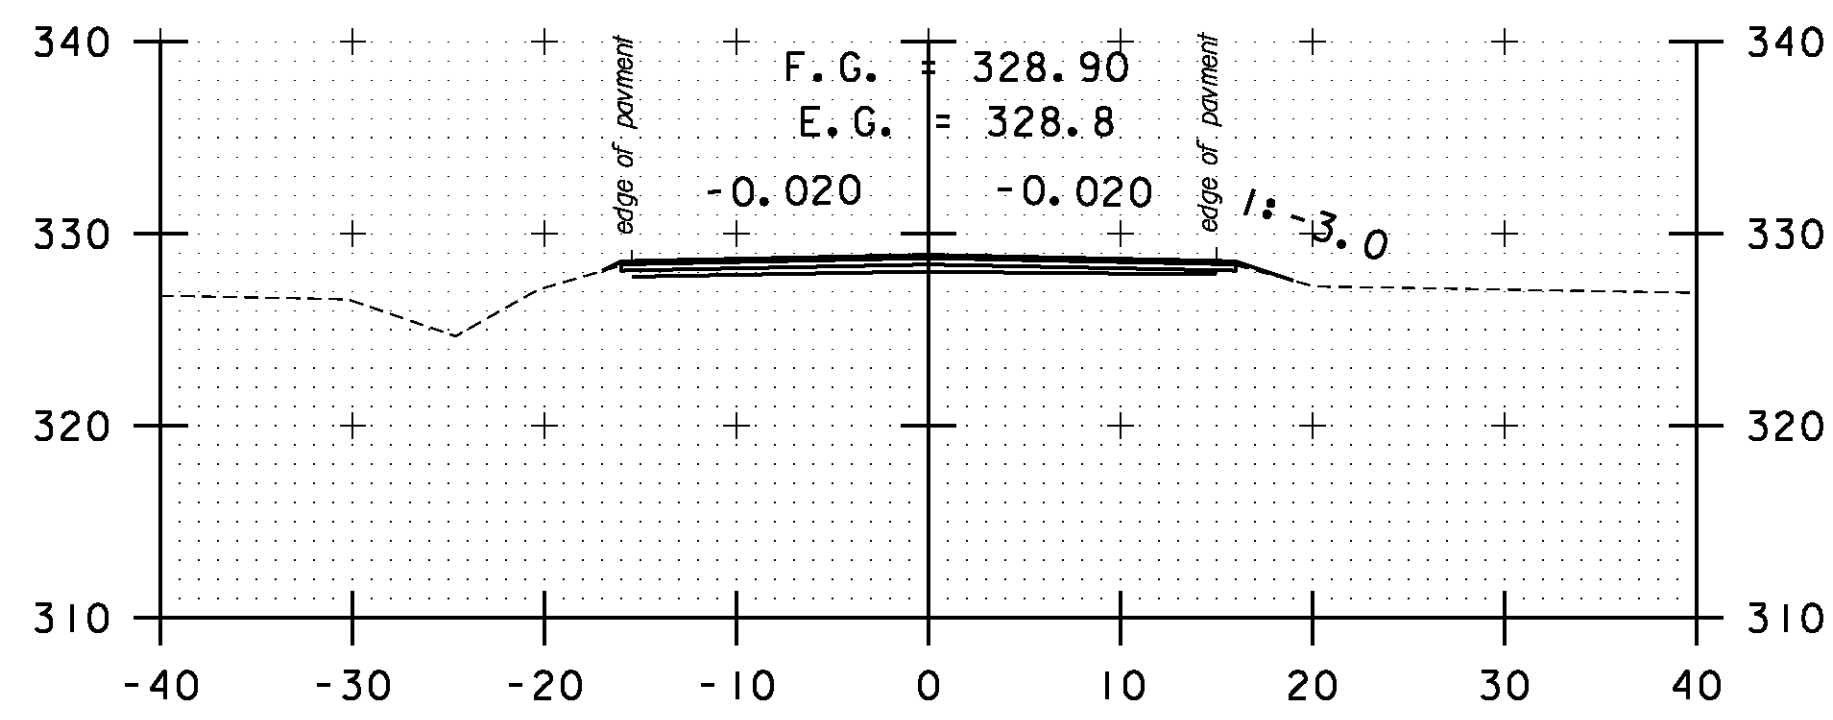


118+50

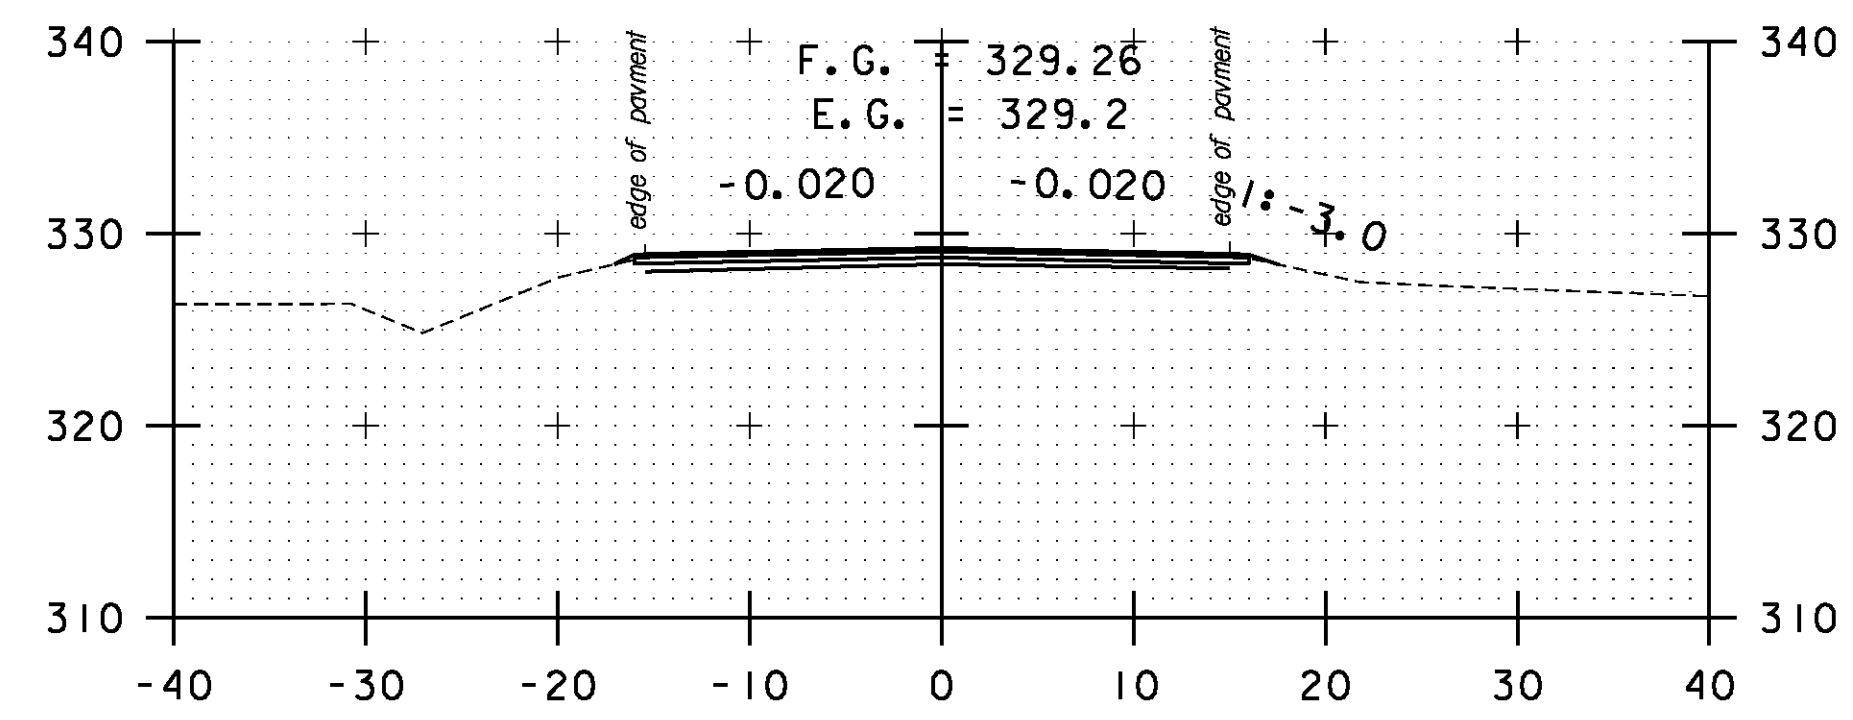


120+00

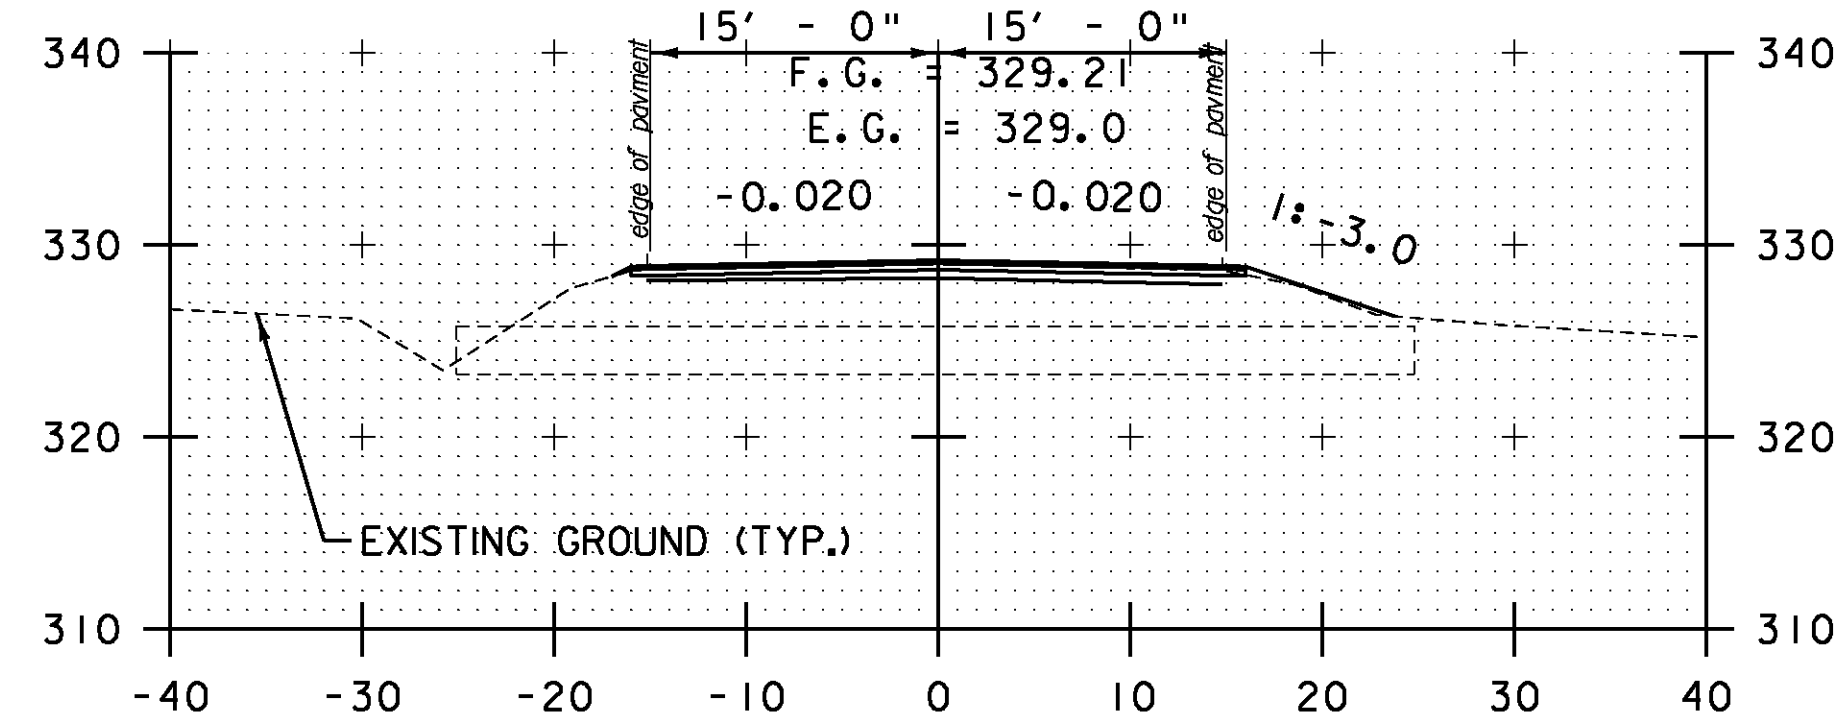

116+50

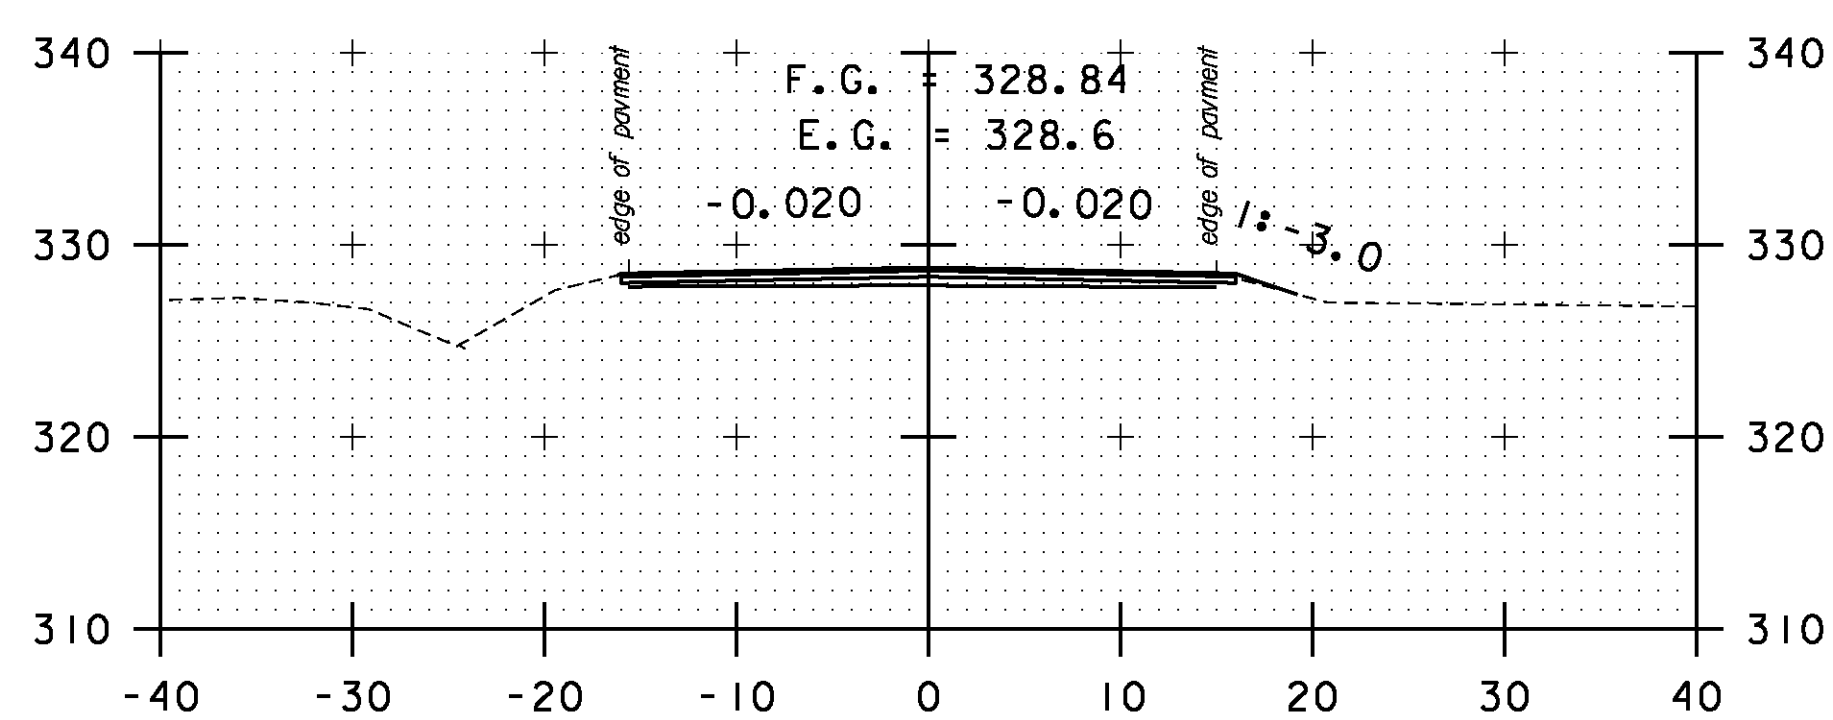

118+00

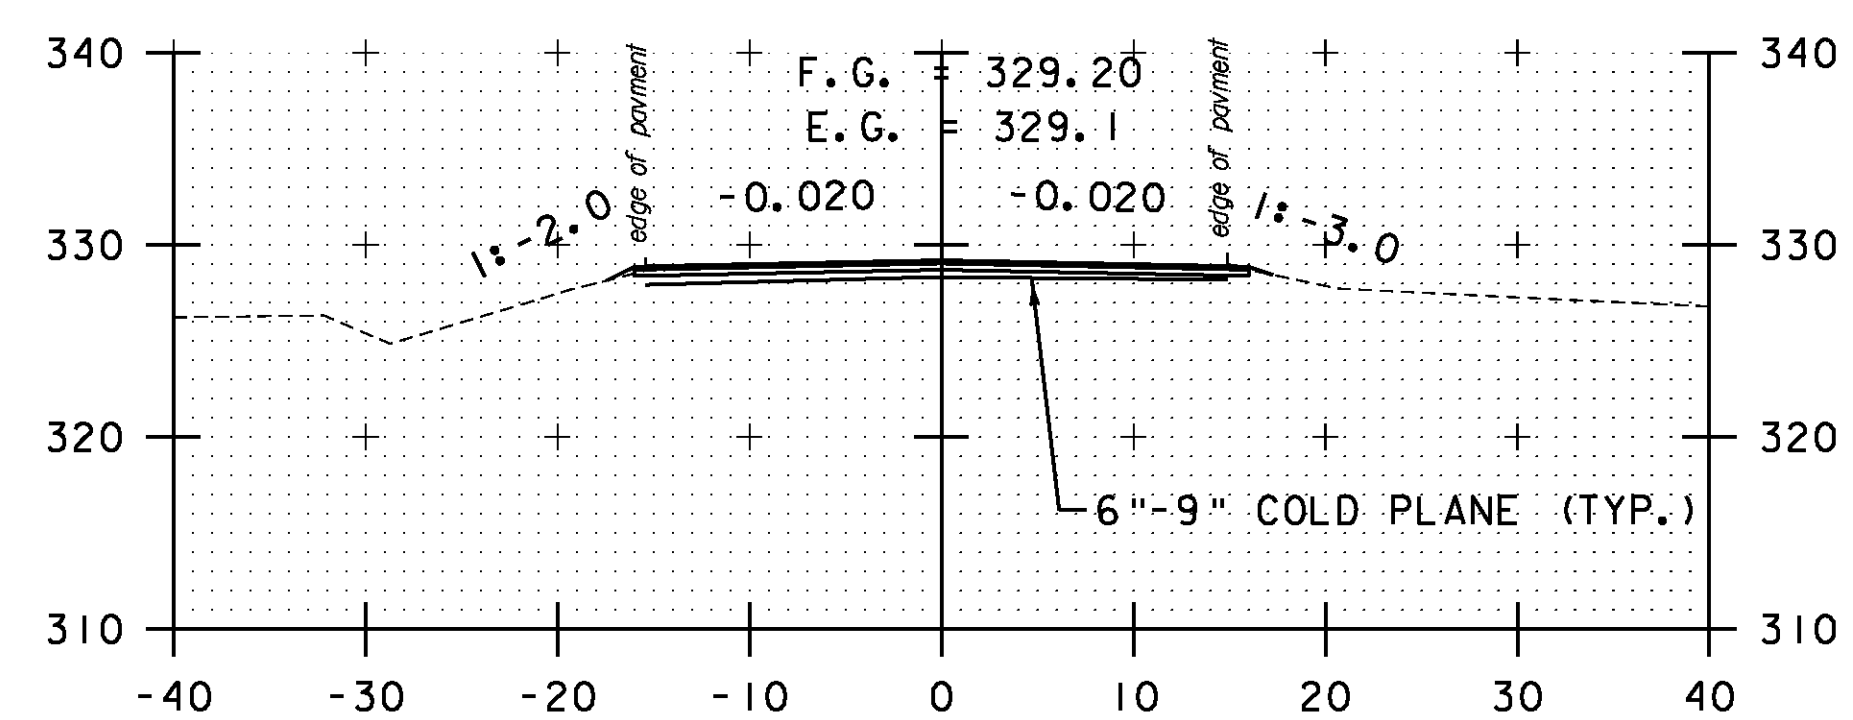

119+50

STA. 116+50 TO STA. 120+50

SCALE 1" = 10'-0"

**CROSS SECTION SHEET 5**

PROJECT NAME: BOLTON-WATERBURY

PROJECT NUMBER: STP 2709(1)

FILE NAME: p07C172.dgn

PROJECT LEADER: CDL

DESIGNED BY: BMB

PLOT FILE: p07C172\_131.r

PLOT DATE: 4/16/2013

DRAWN BY: BMB

CHECKED BY: CDL

SHEET 131 OF 217