




122+00

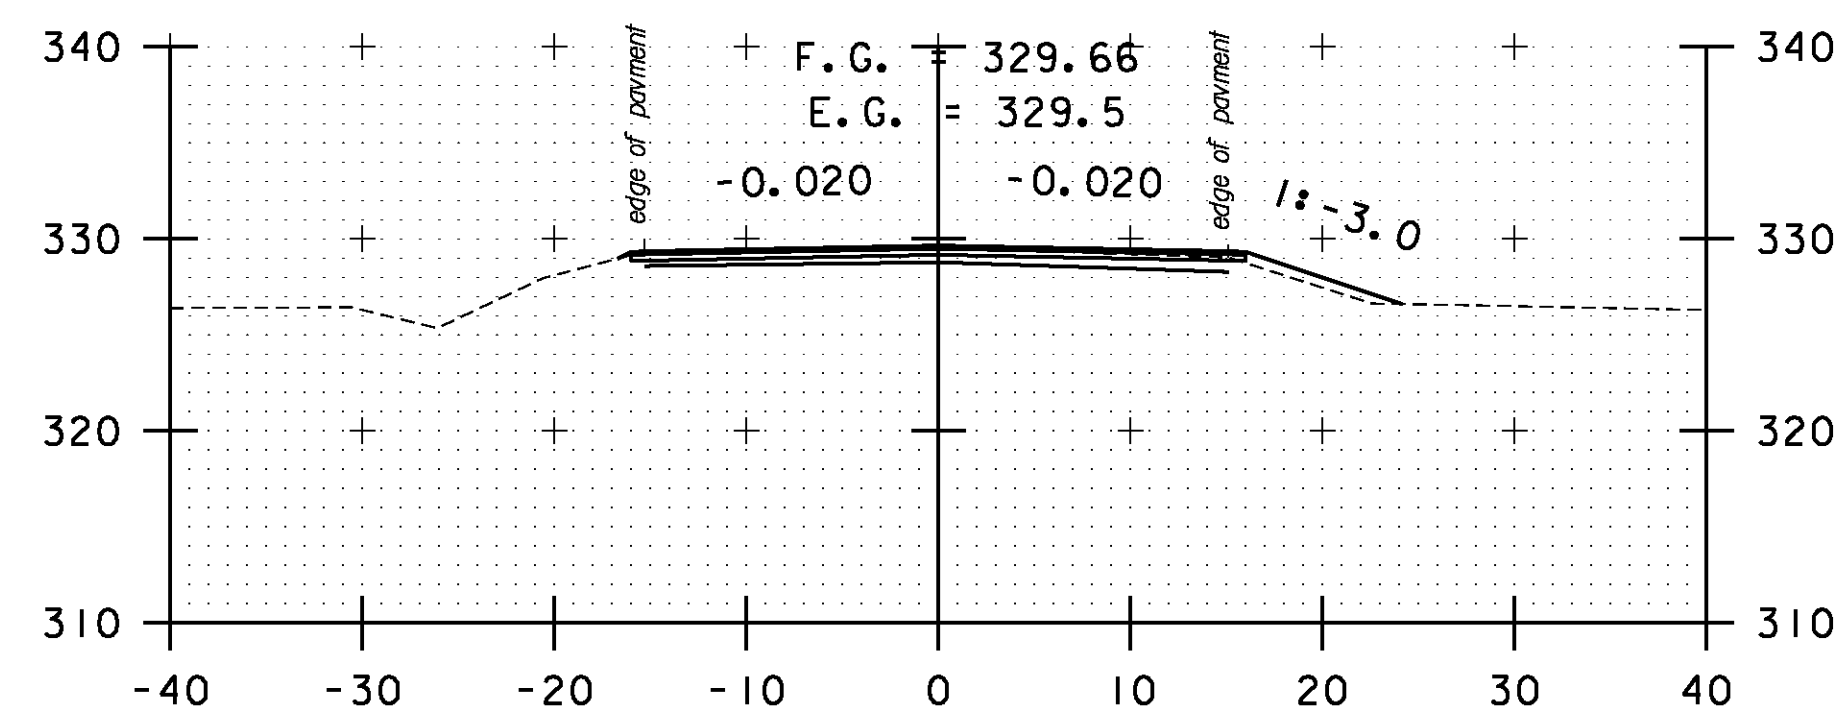


121+50

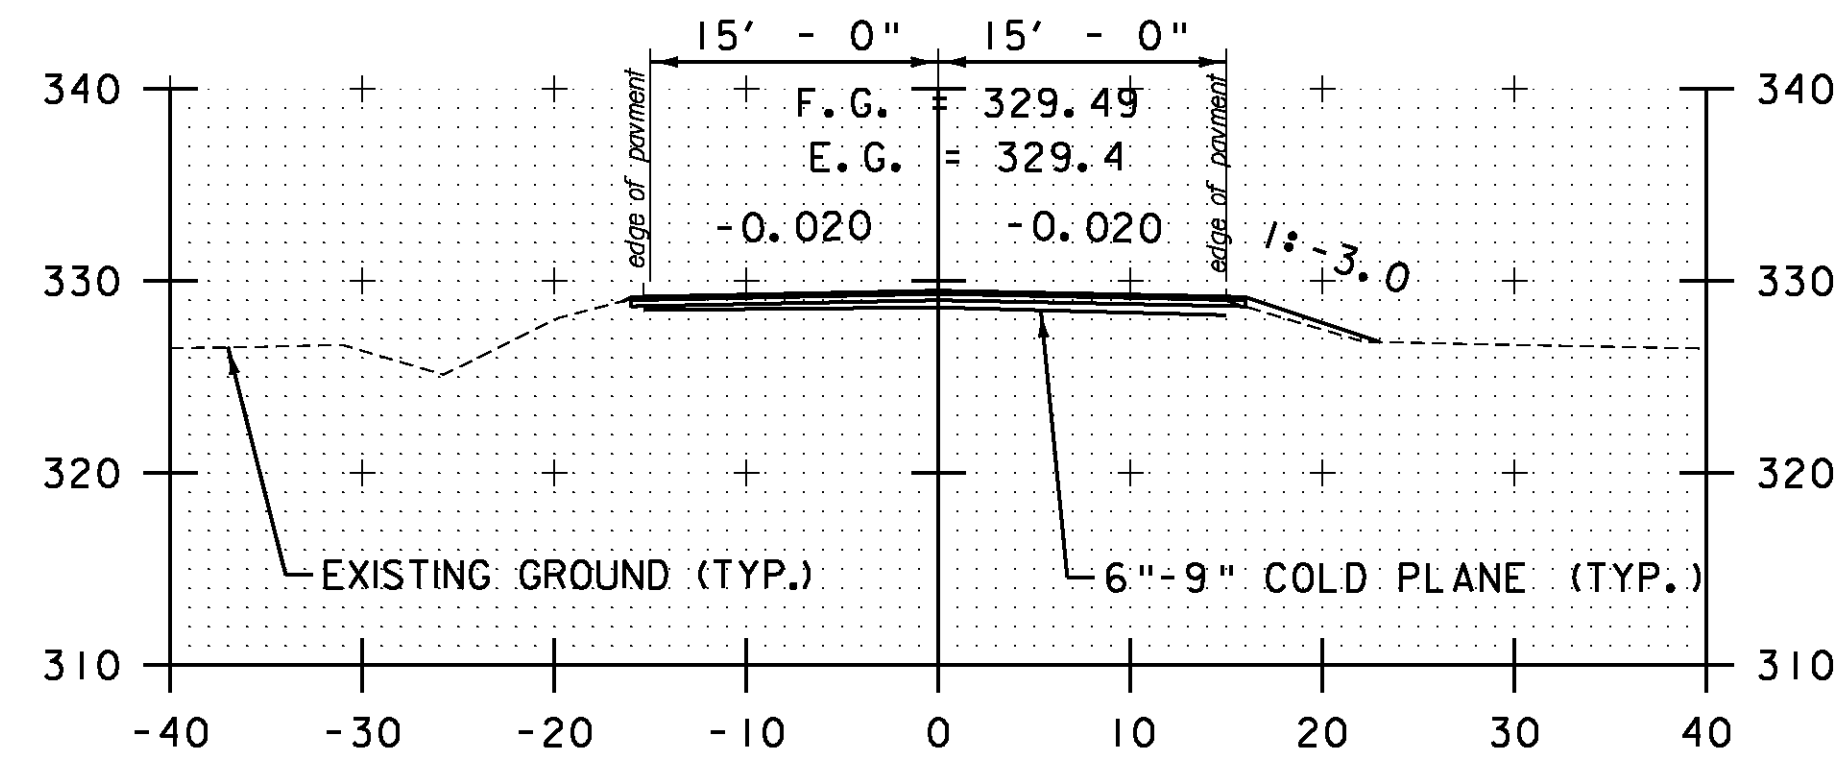


121+00

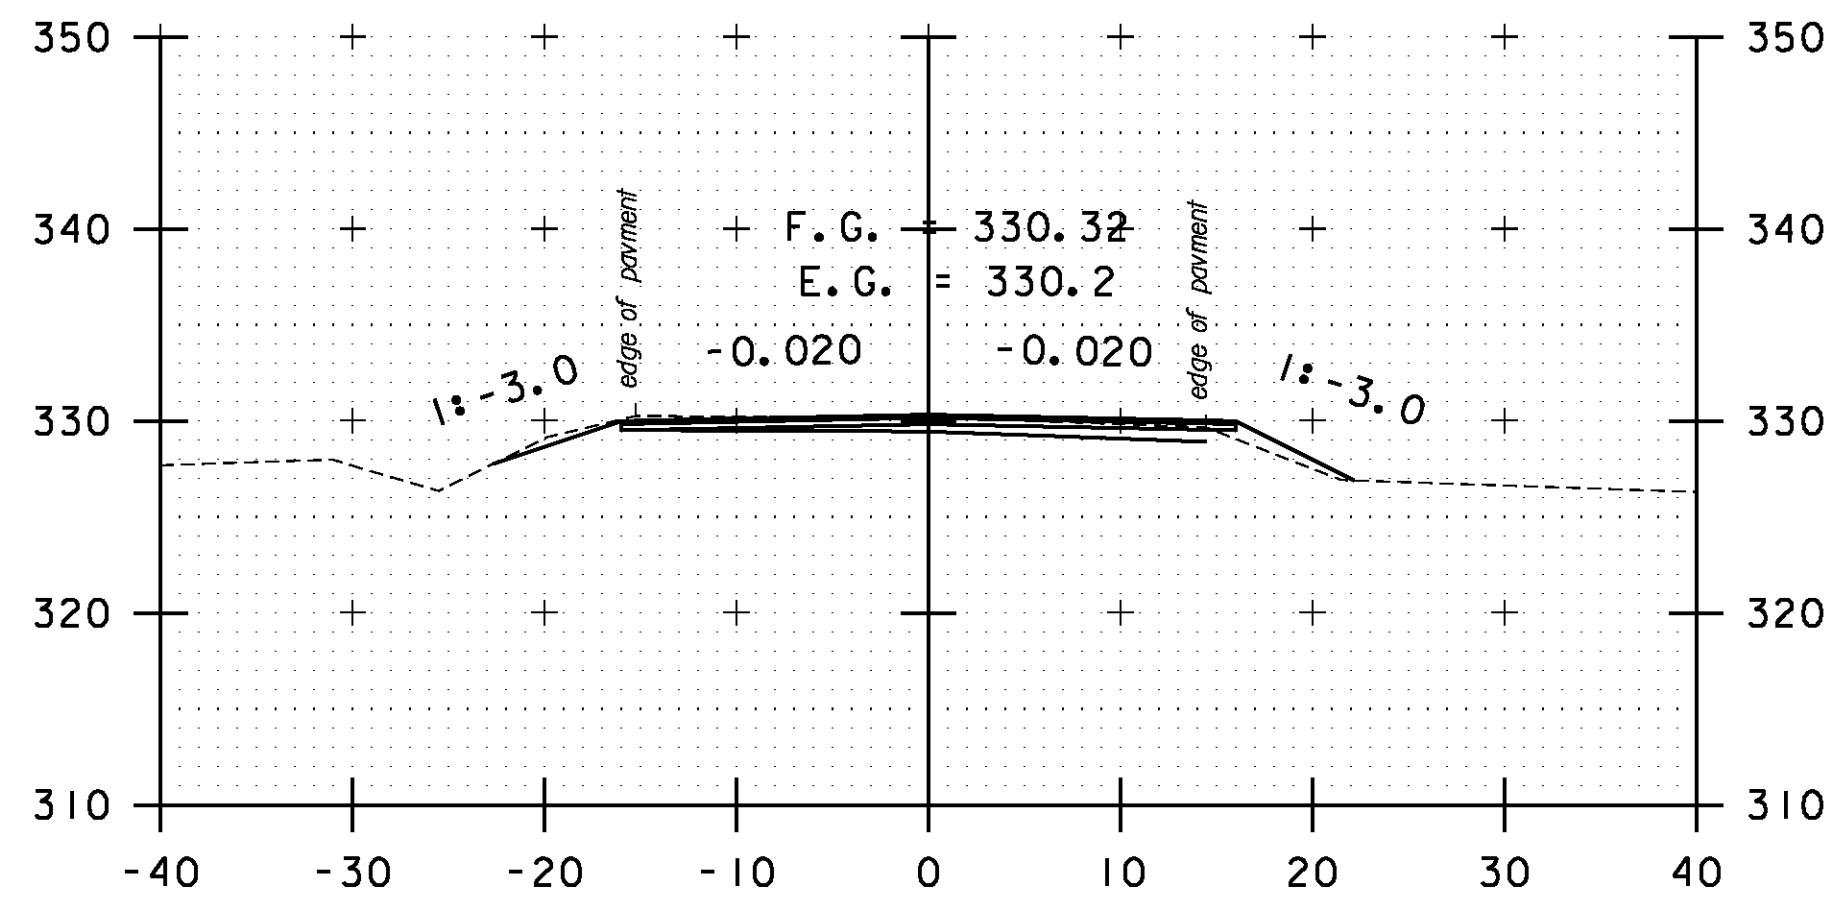


123+50

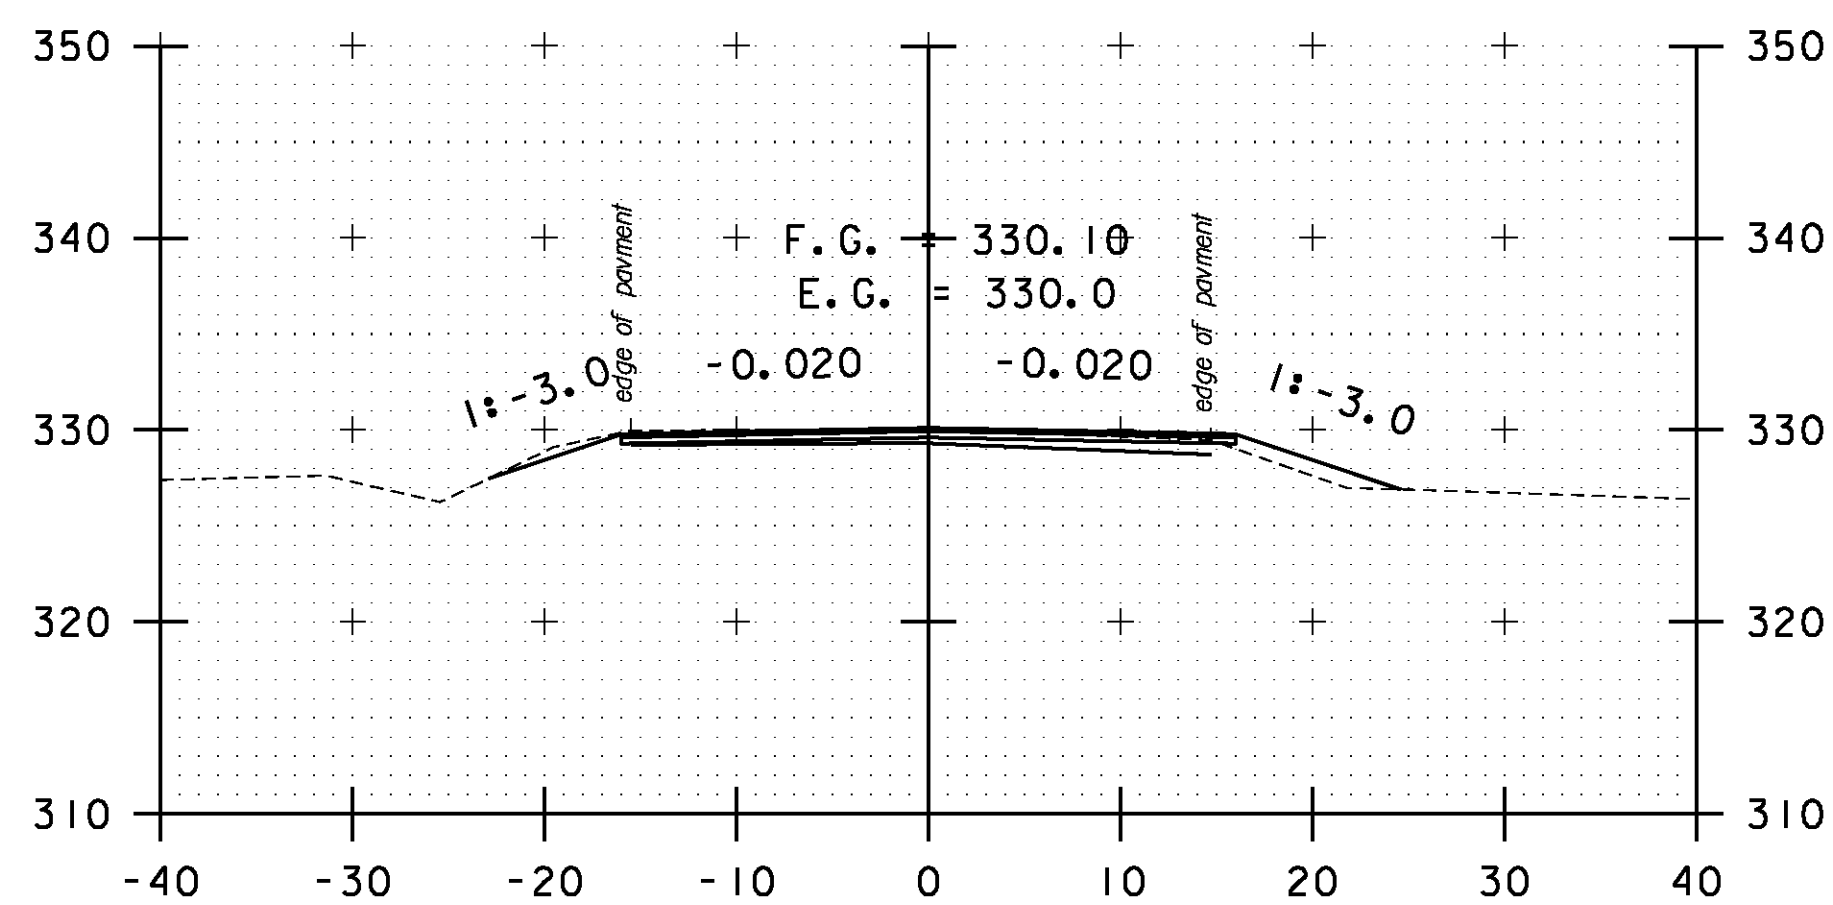


123+00

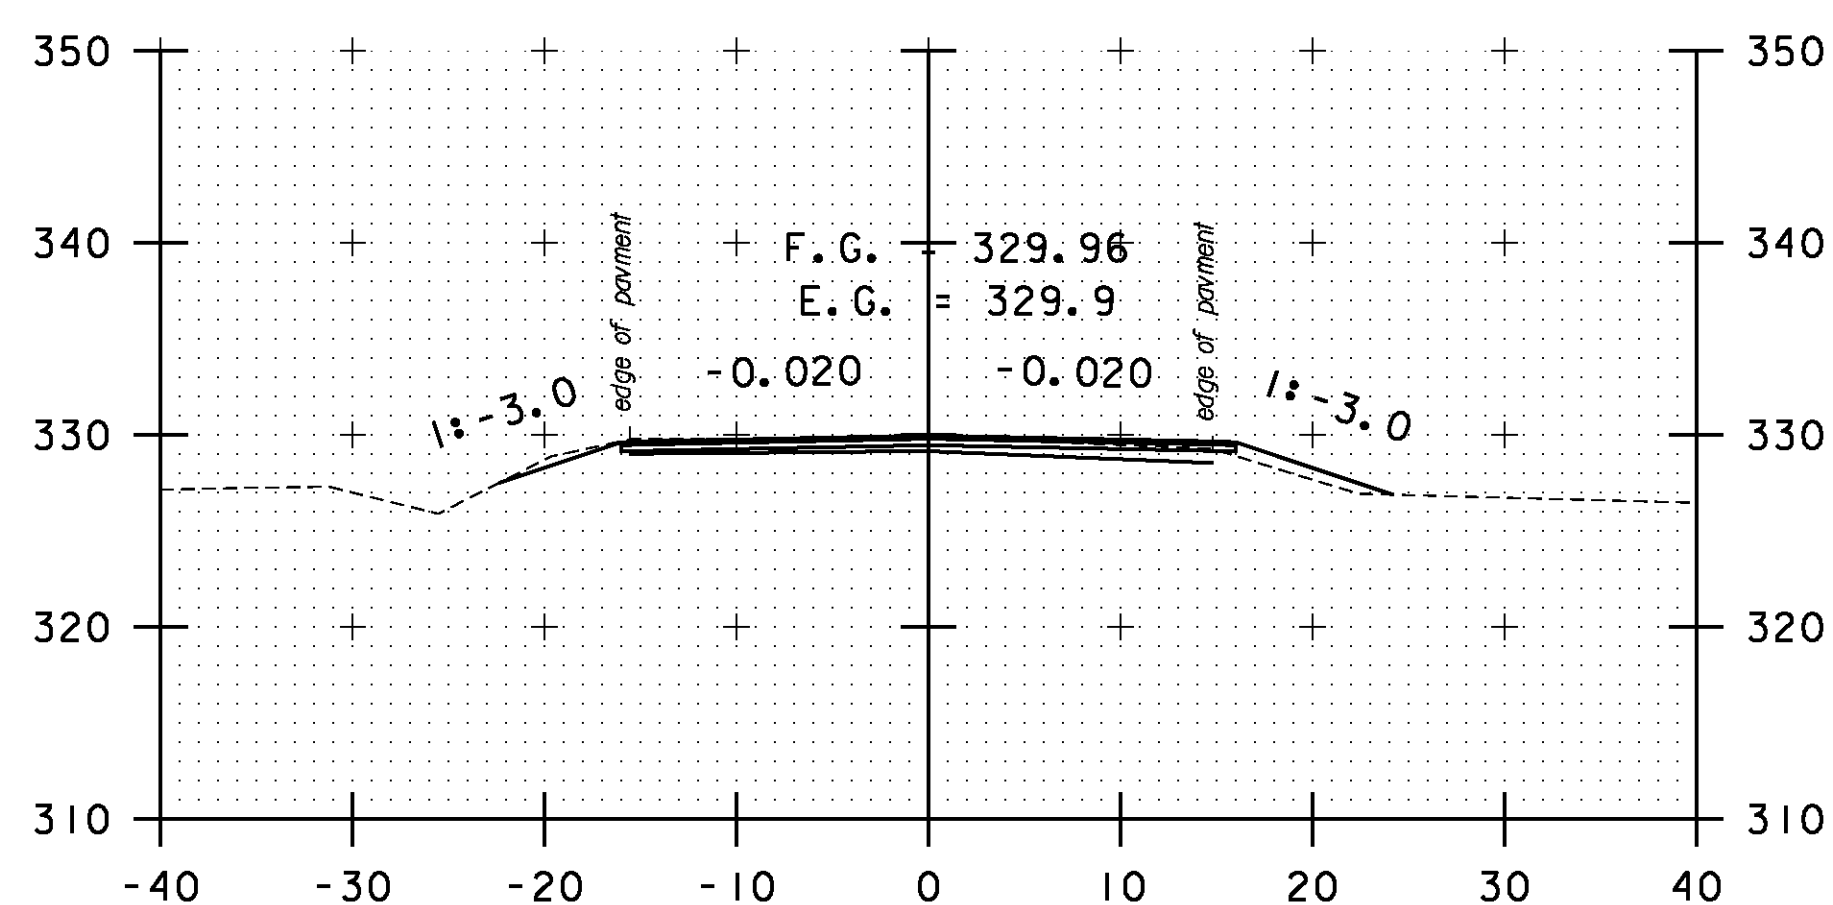


122+50

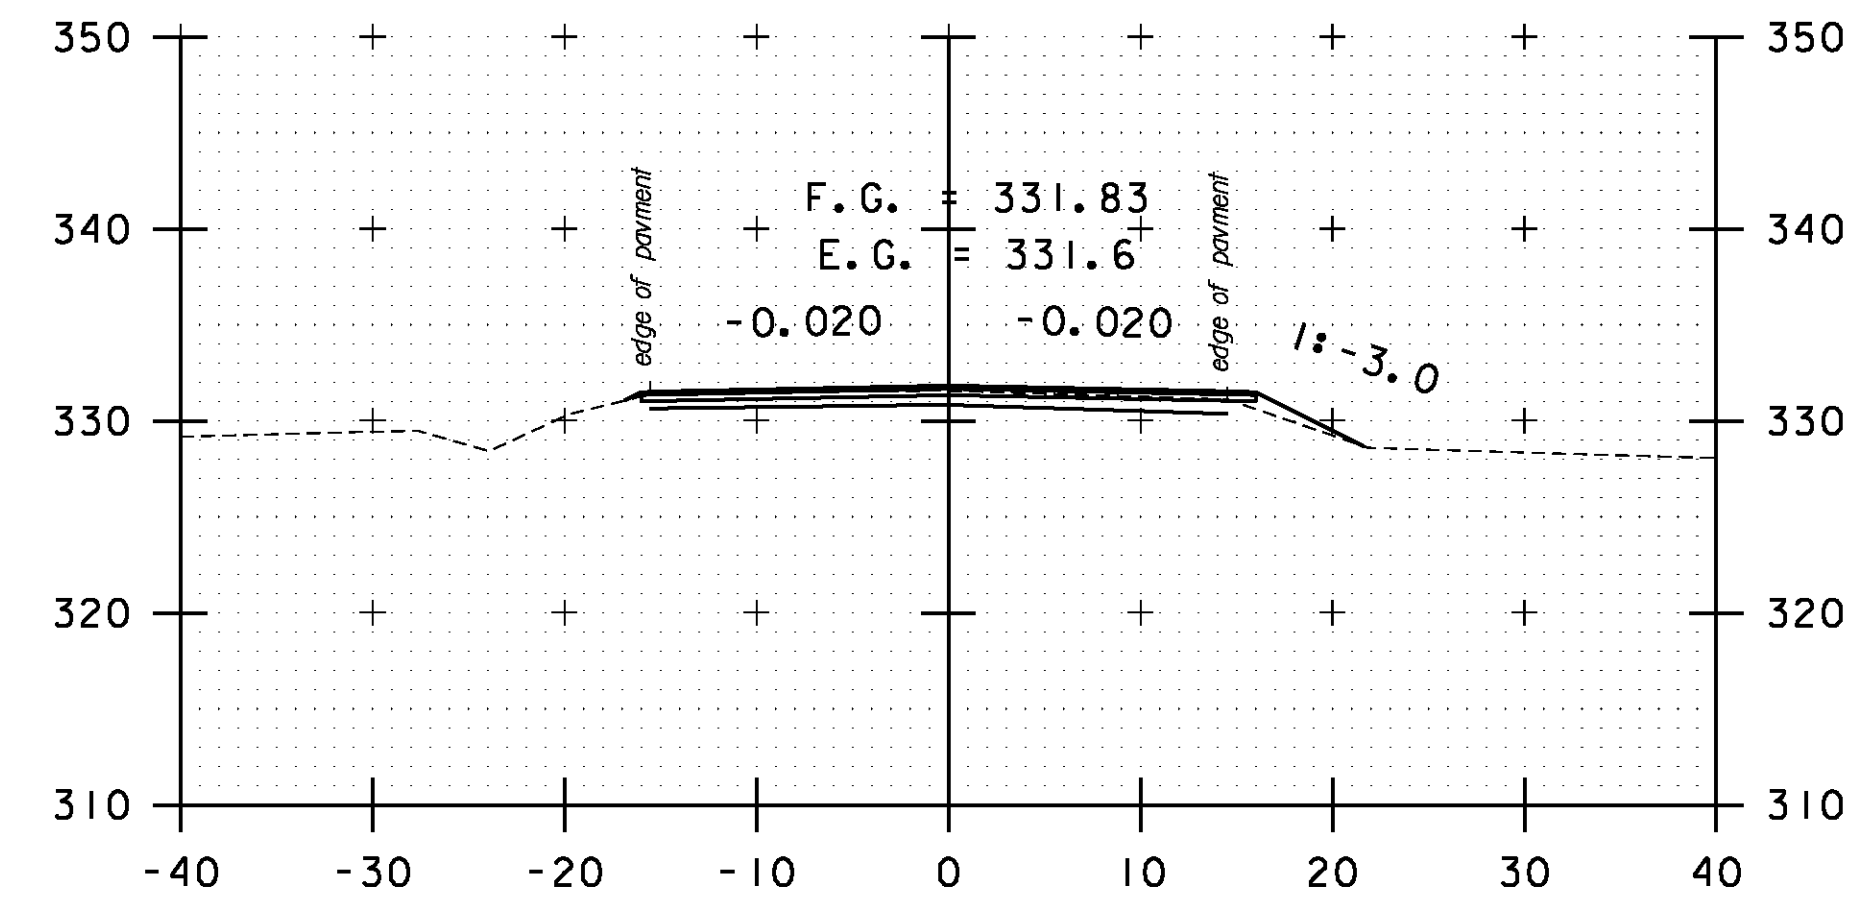

125+00

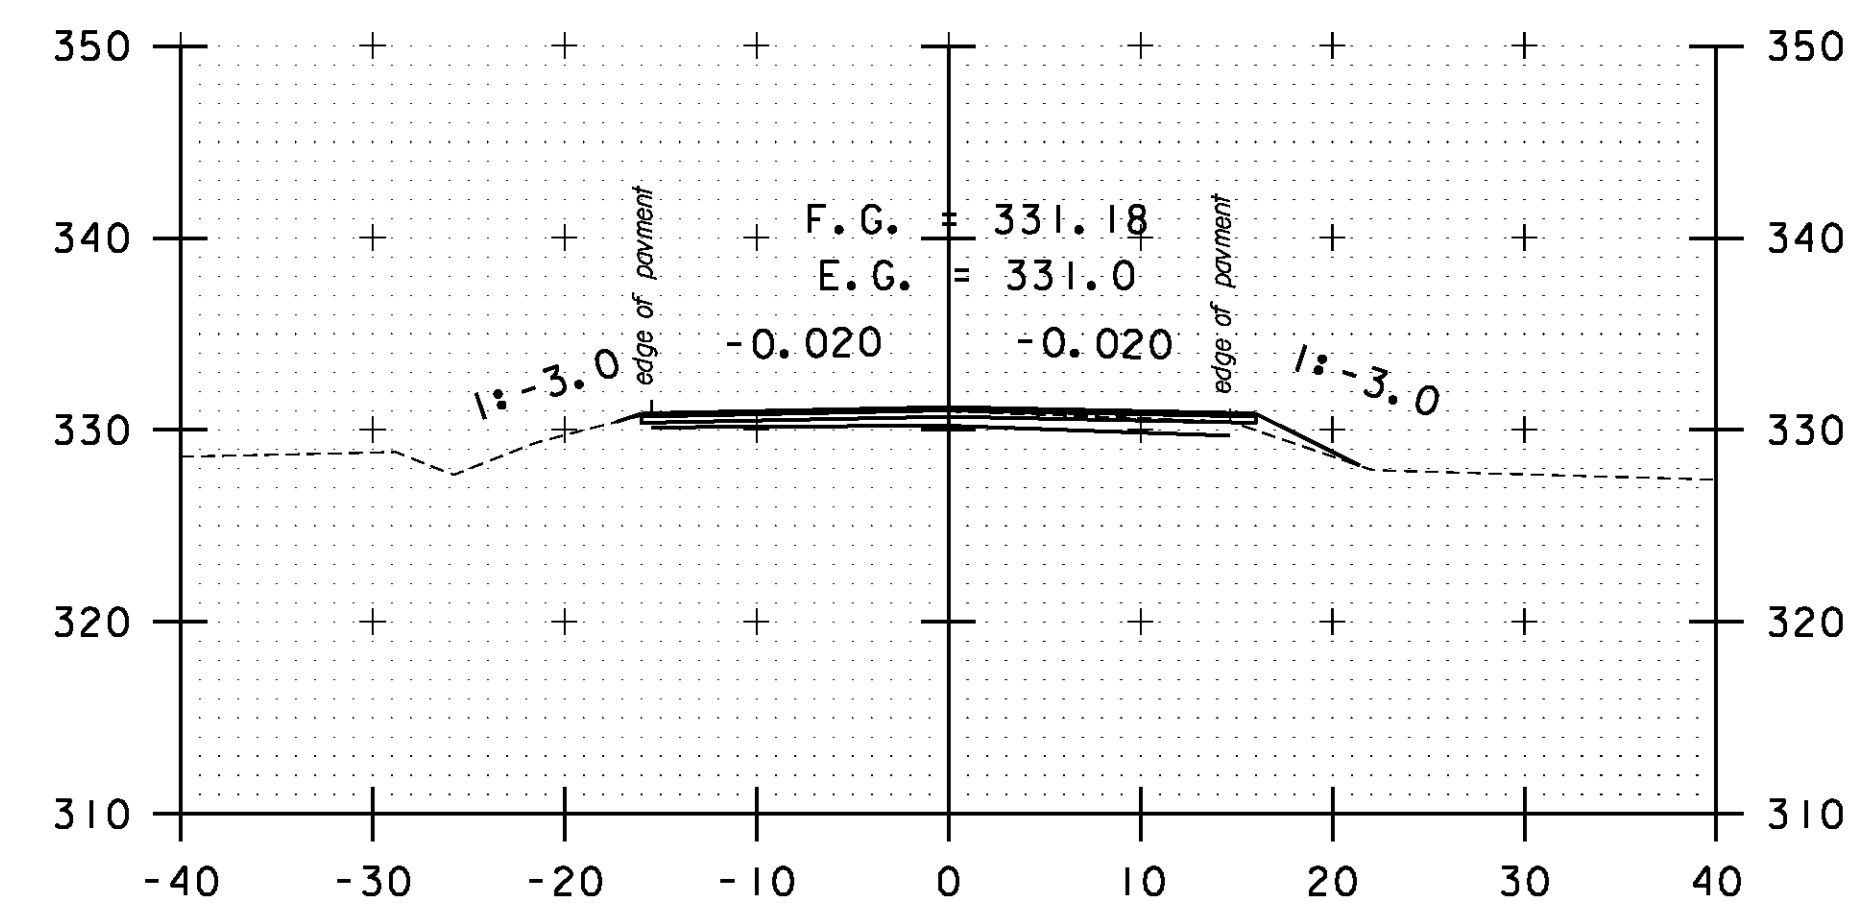

124+50

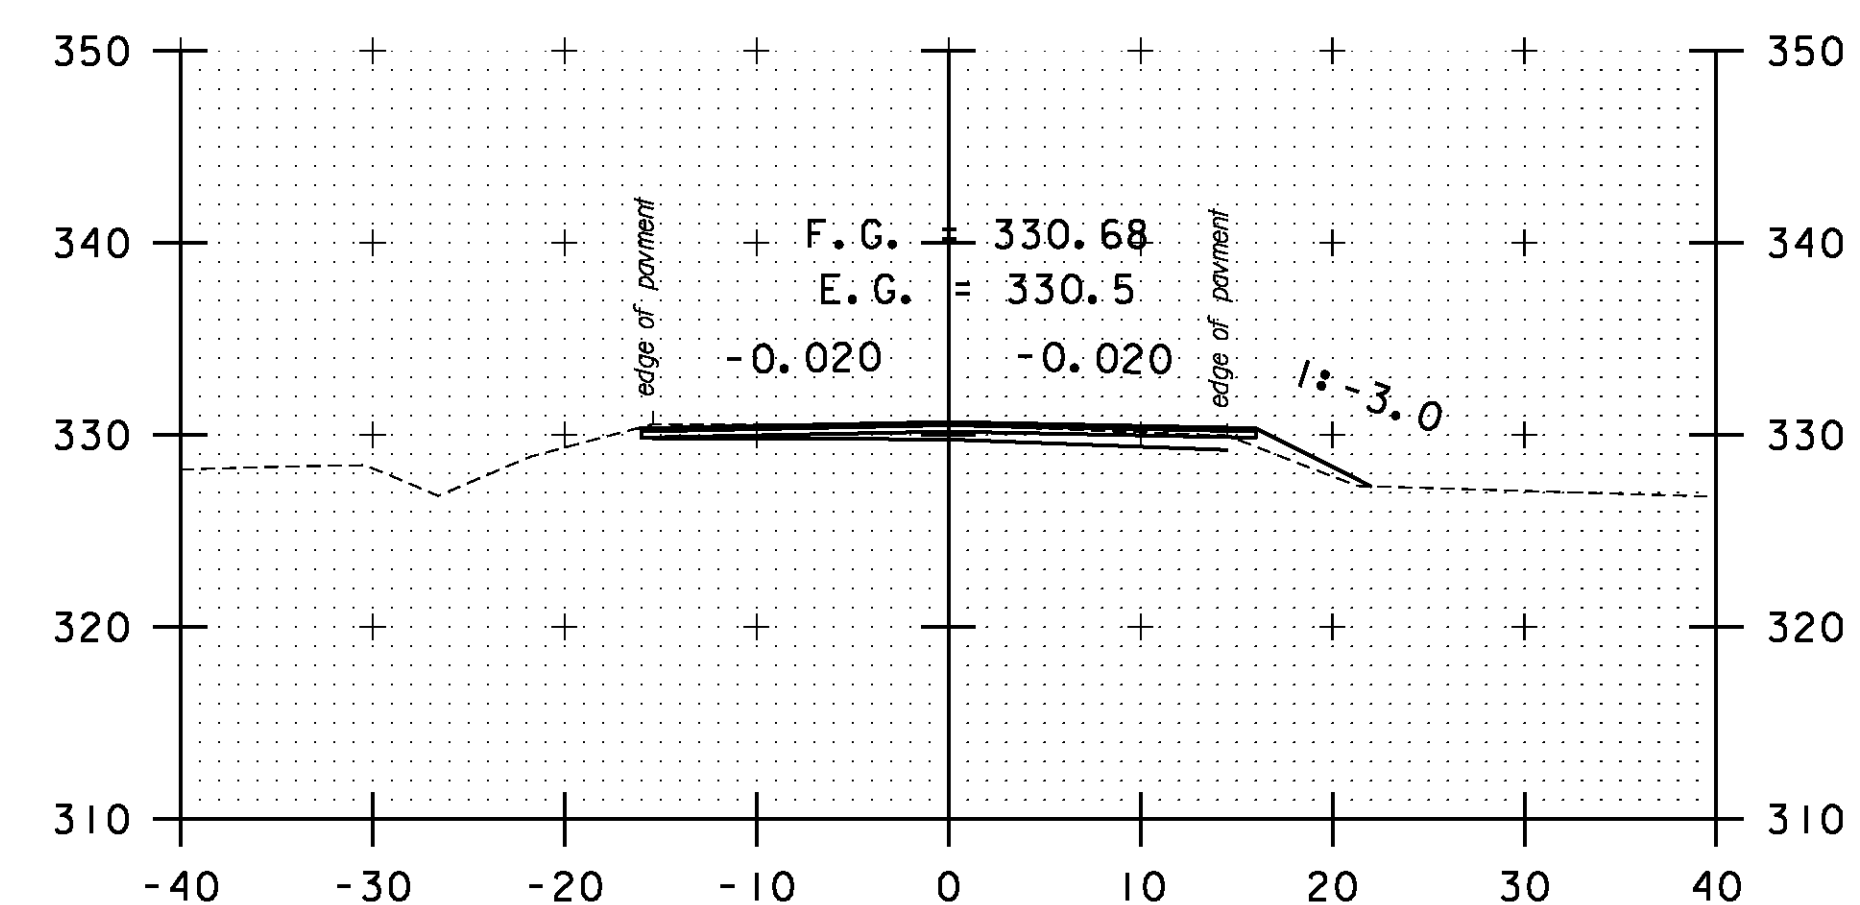

124+00

STA. 121+00 TO STA. 125+00



CROSS SECTION SHEET 6

PROJECT NAME: BOLTON-WATERBURY

PROJECT NUMBER: STP 2709(1)

FILE NAME: p07C172.dgn

PROJECT LEADER: CDL

DESIGNED BY: BMB

PLOT FILE: p07C172_132.1

PLOT DATE: 4/16/2013

DRAWN BY: BMB

CHECKED BY: CDL

SHEET 132 OF 217