




126+50

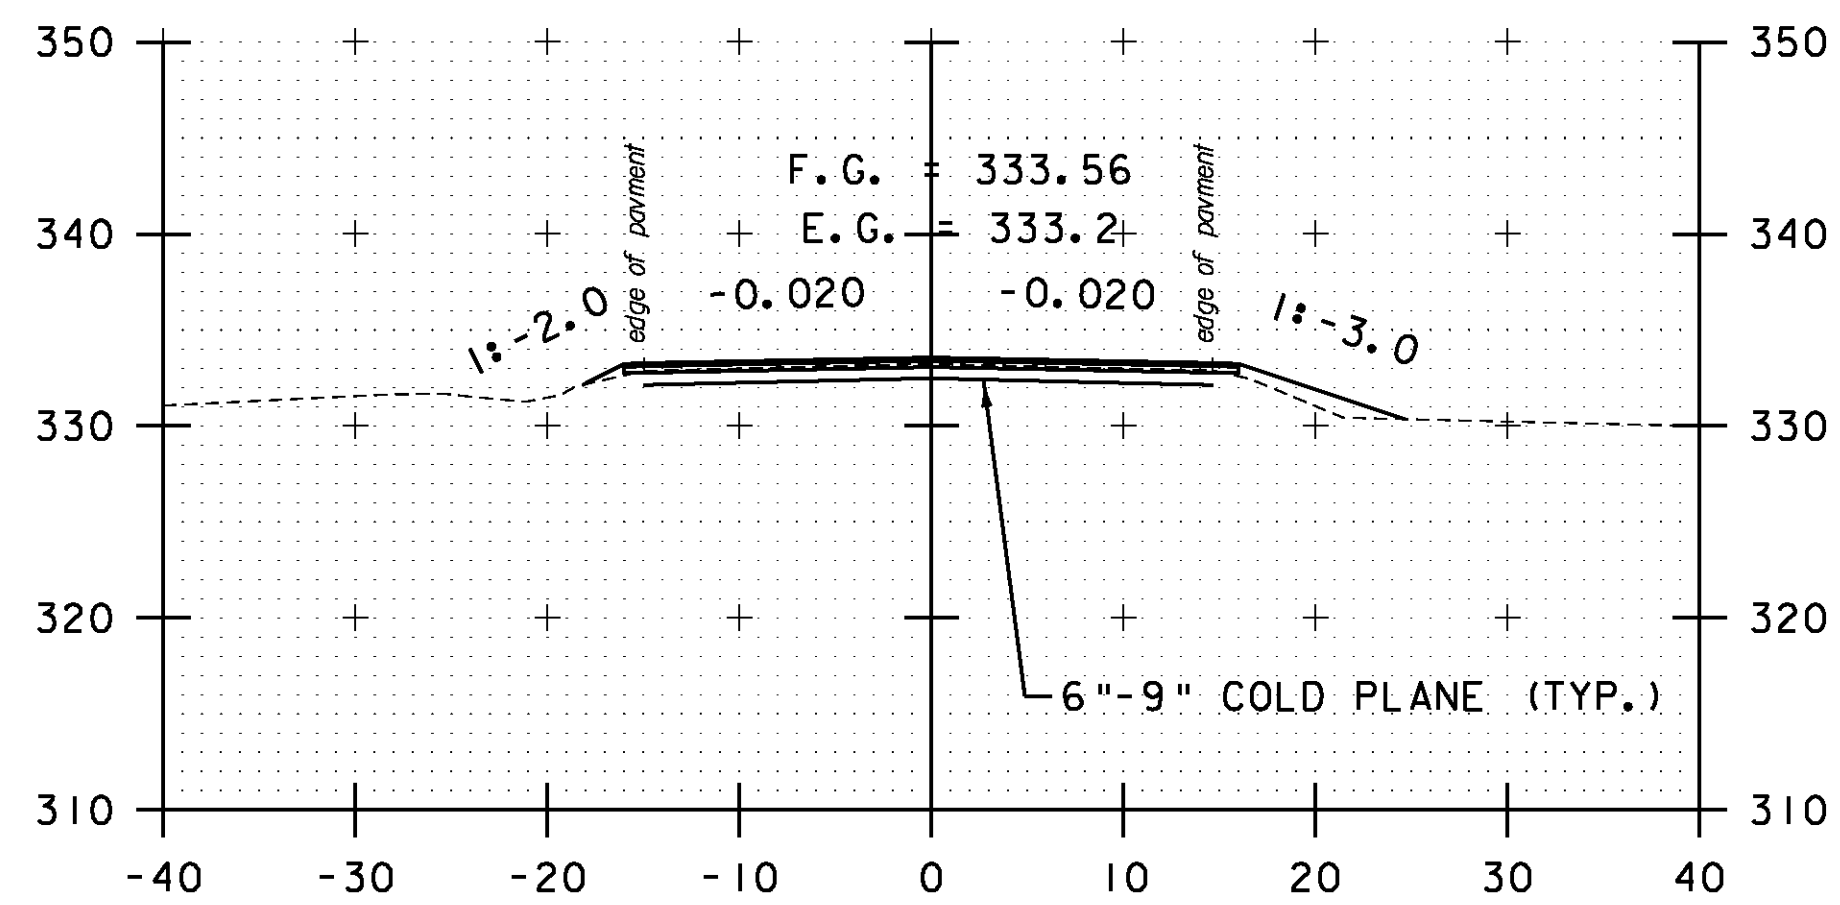


126+00

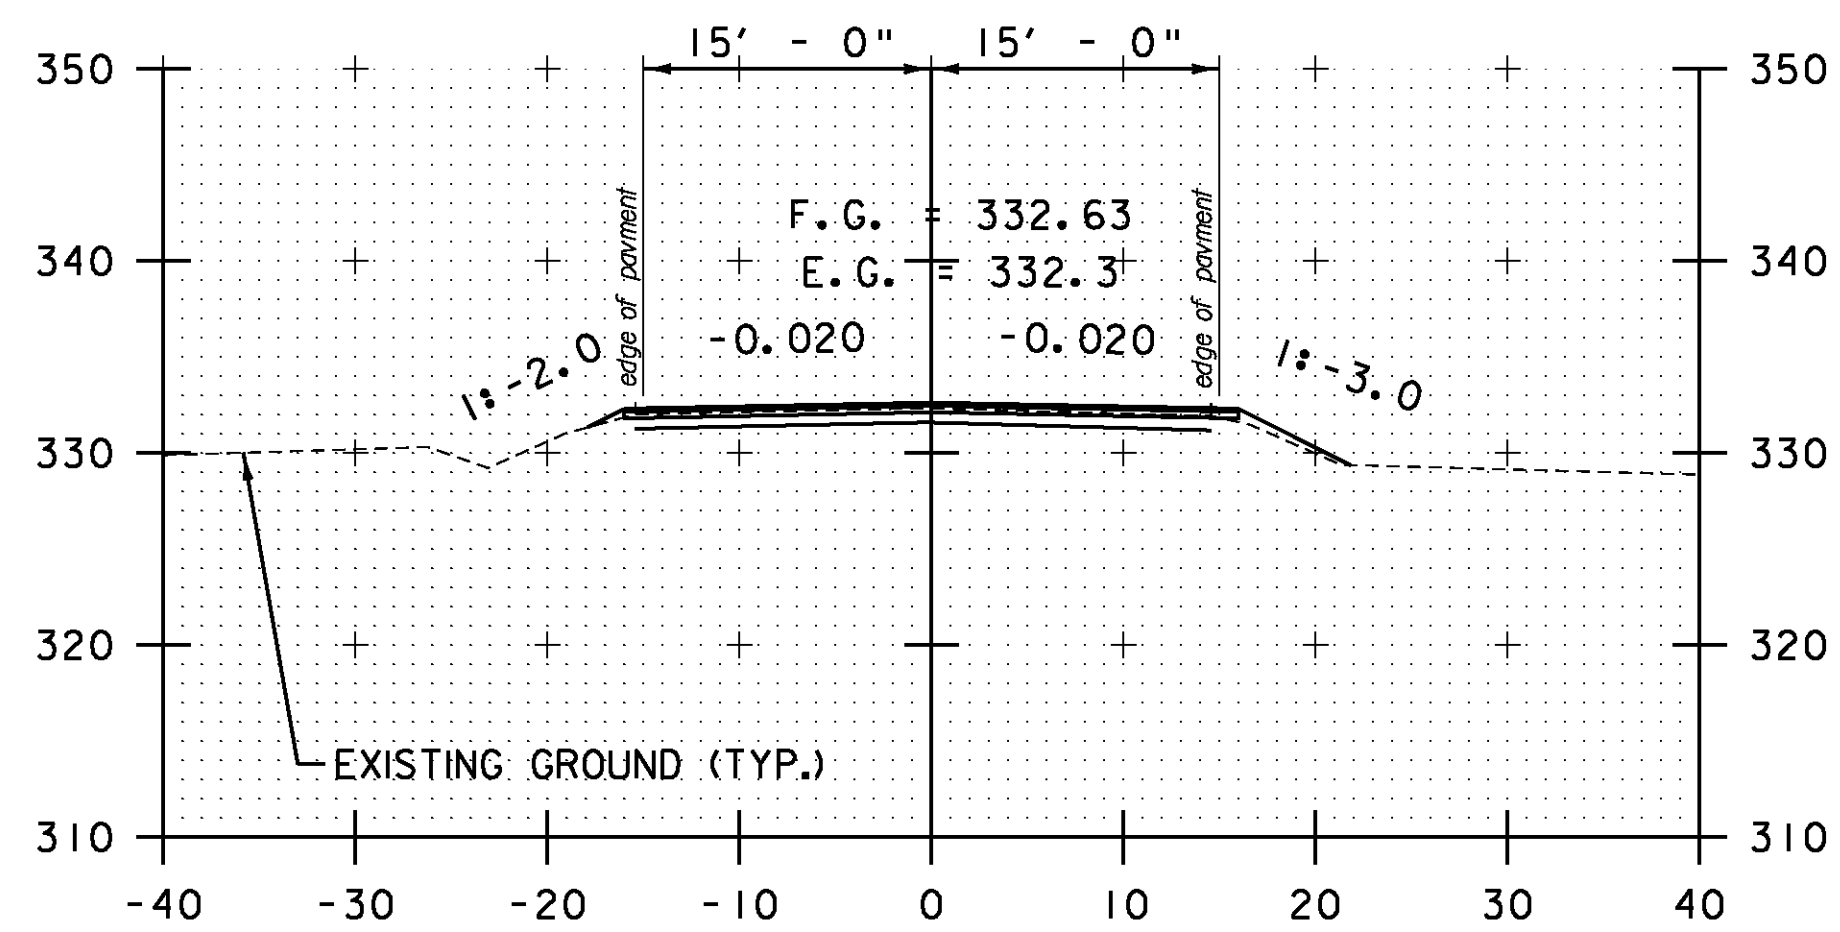


125+50

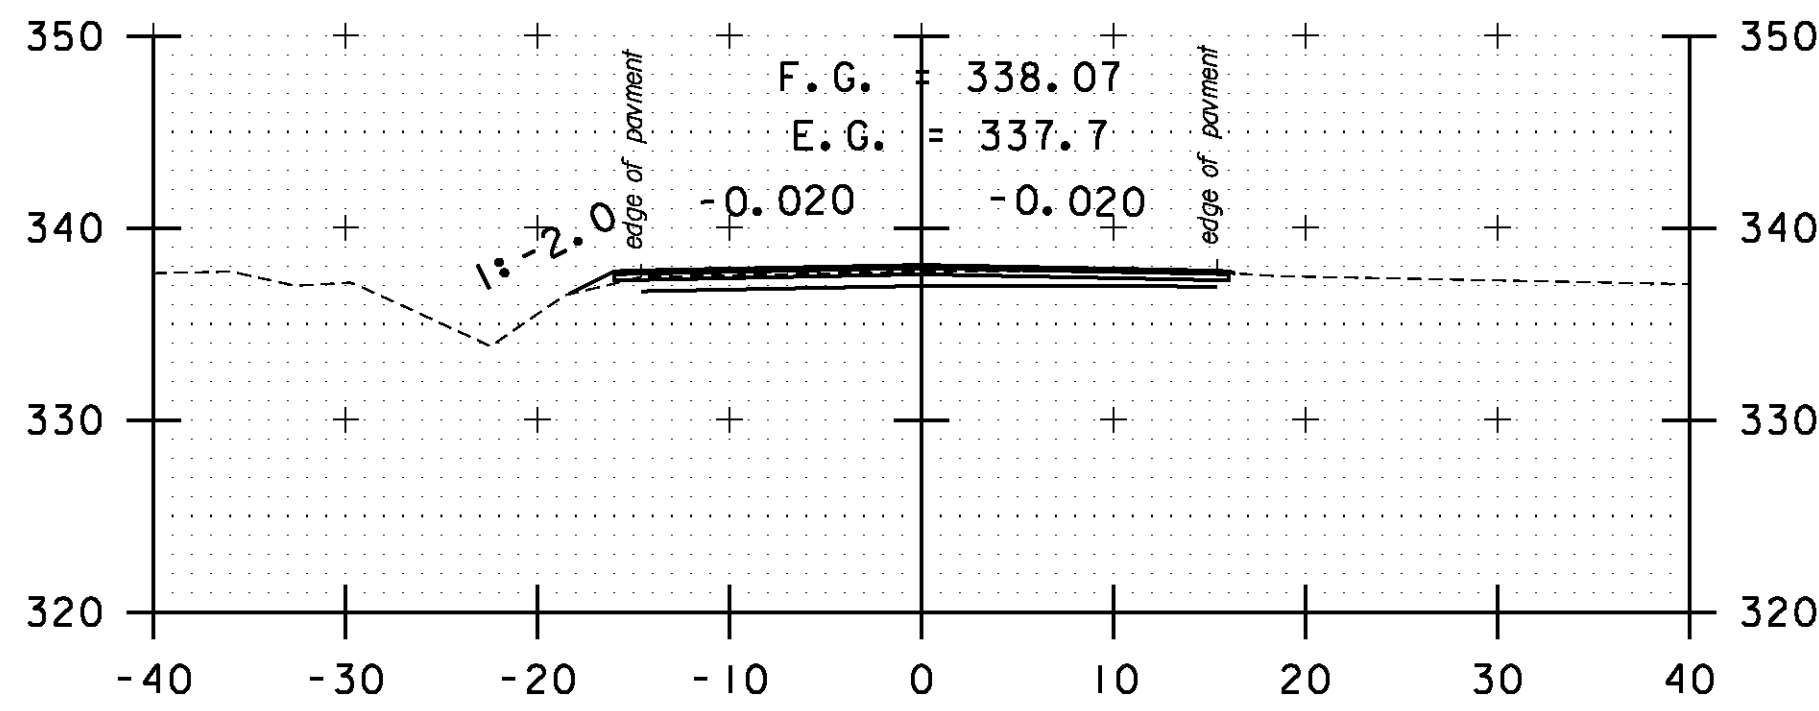


128+00

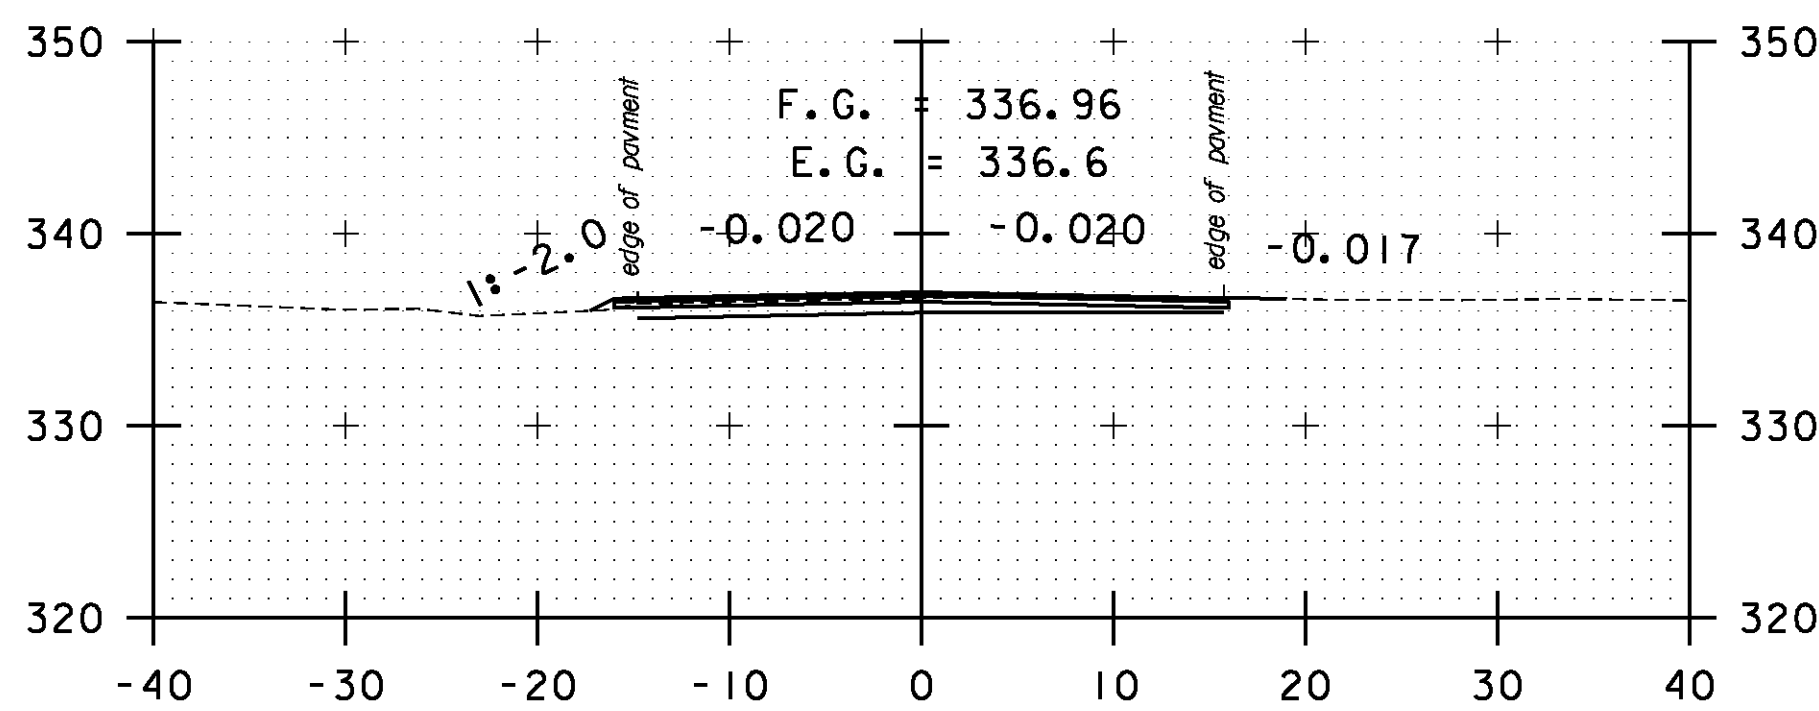


DRIVE RT
127+50

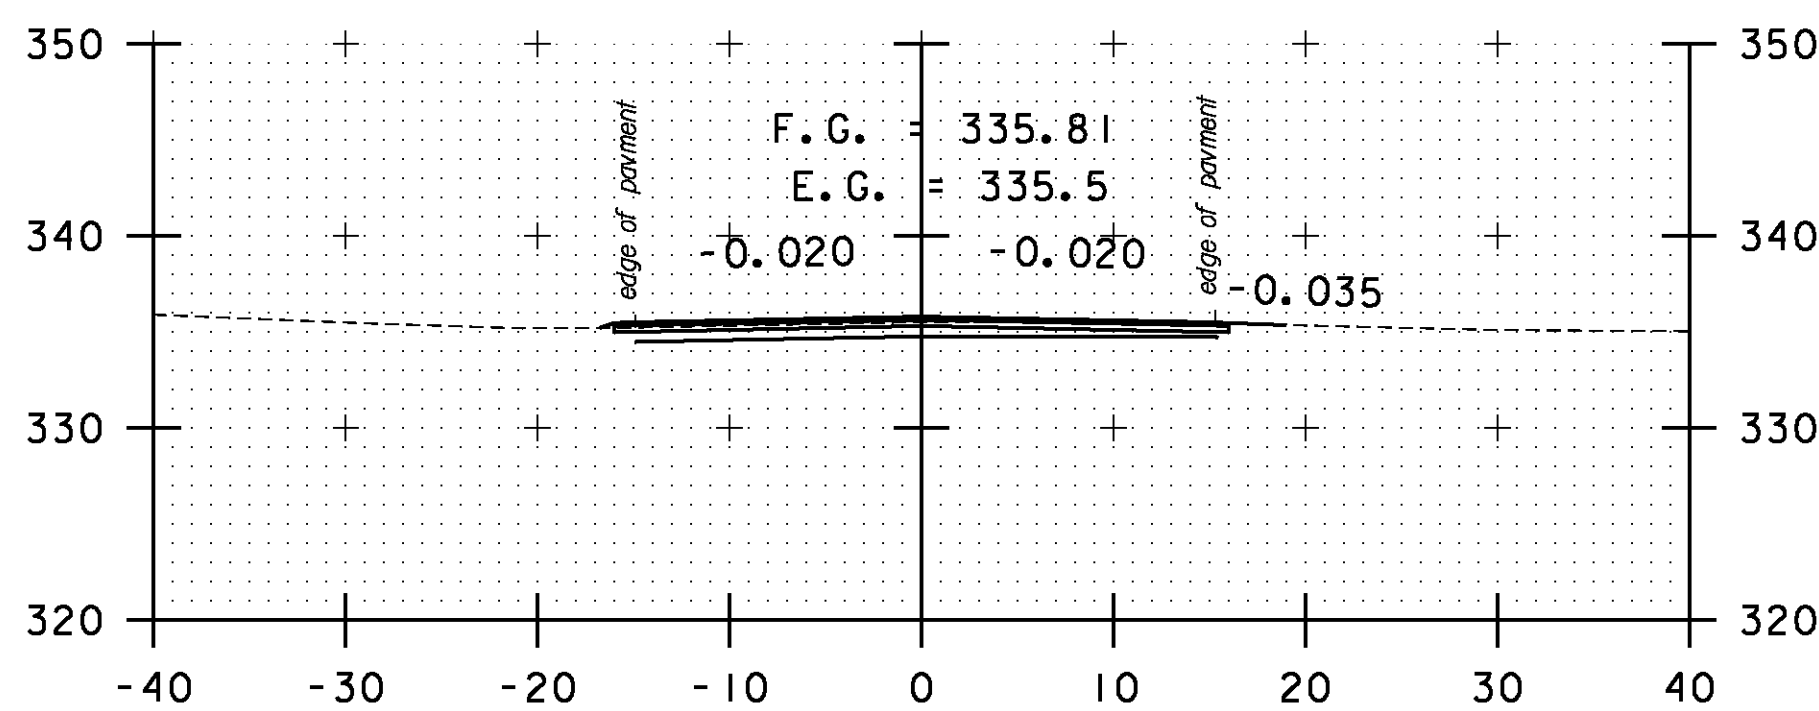


DRIVE RT
127+00

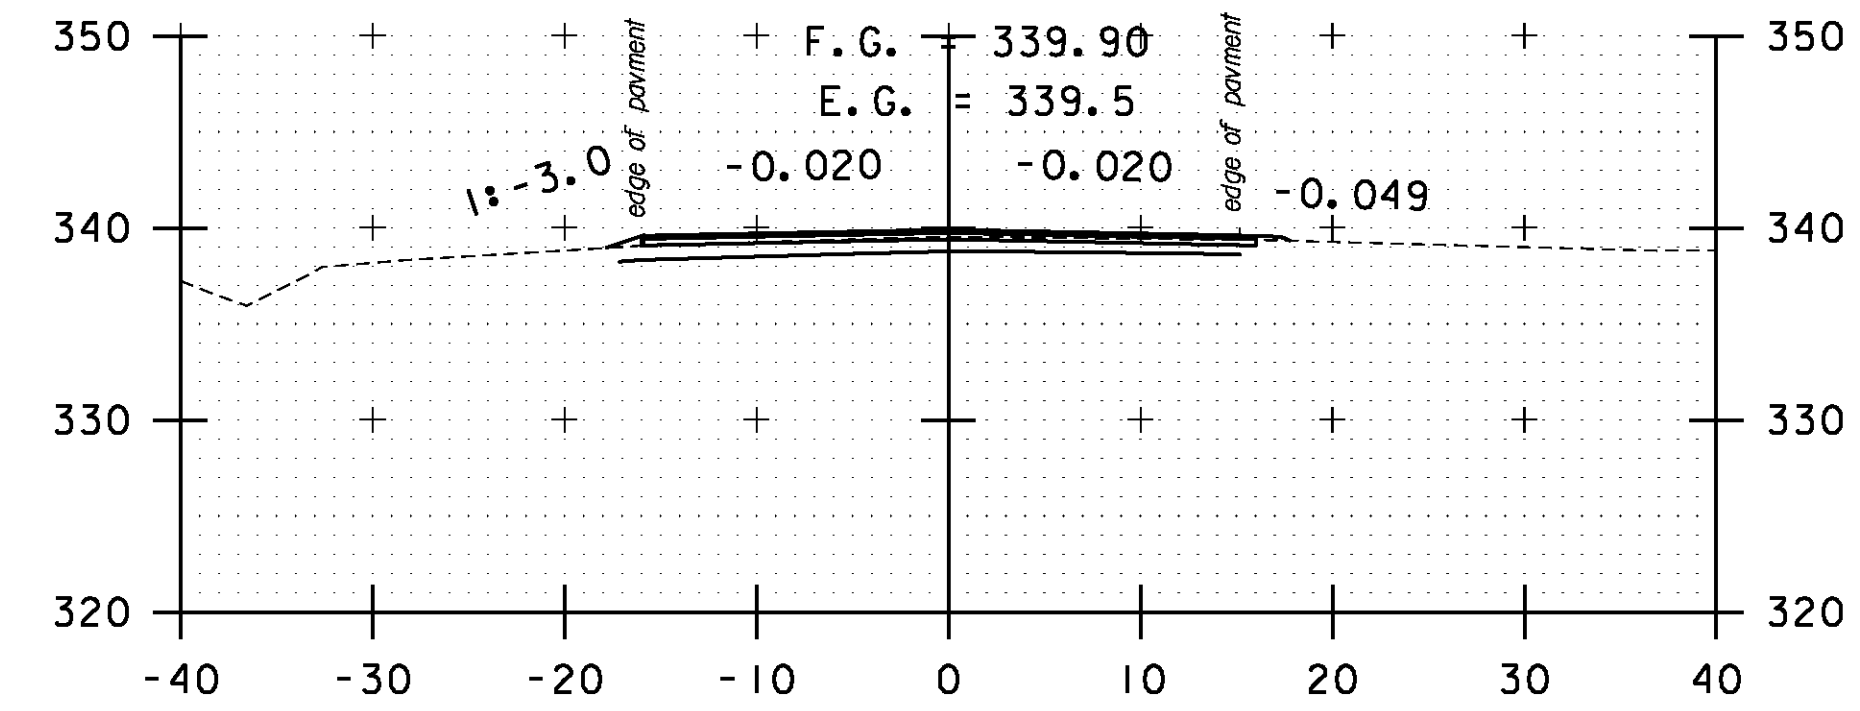

DRIVE LT / TH#11 RT
129+00

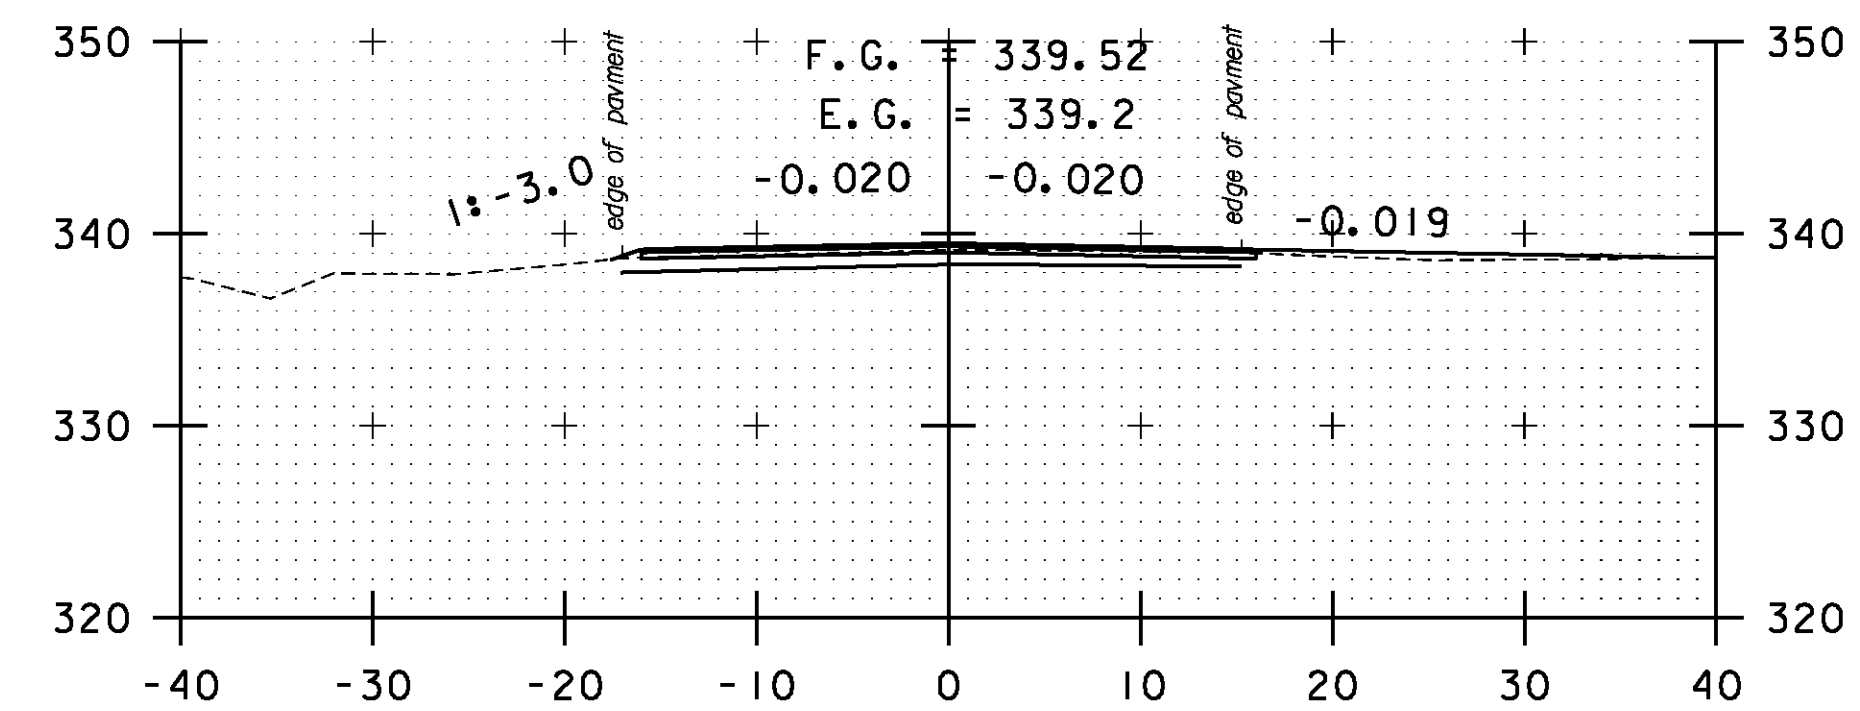


TH#11 RT
128+78

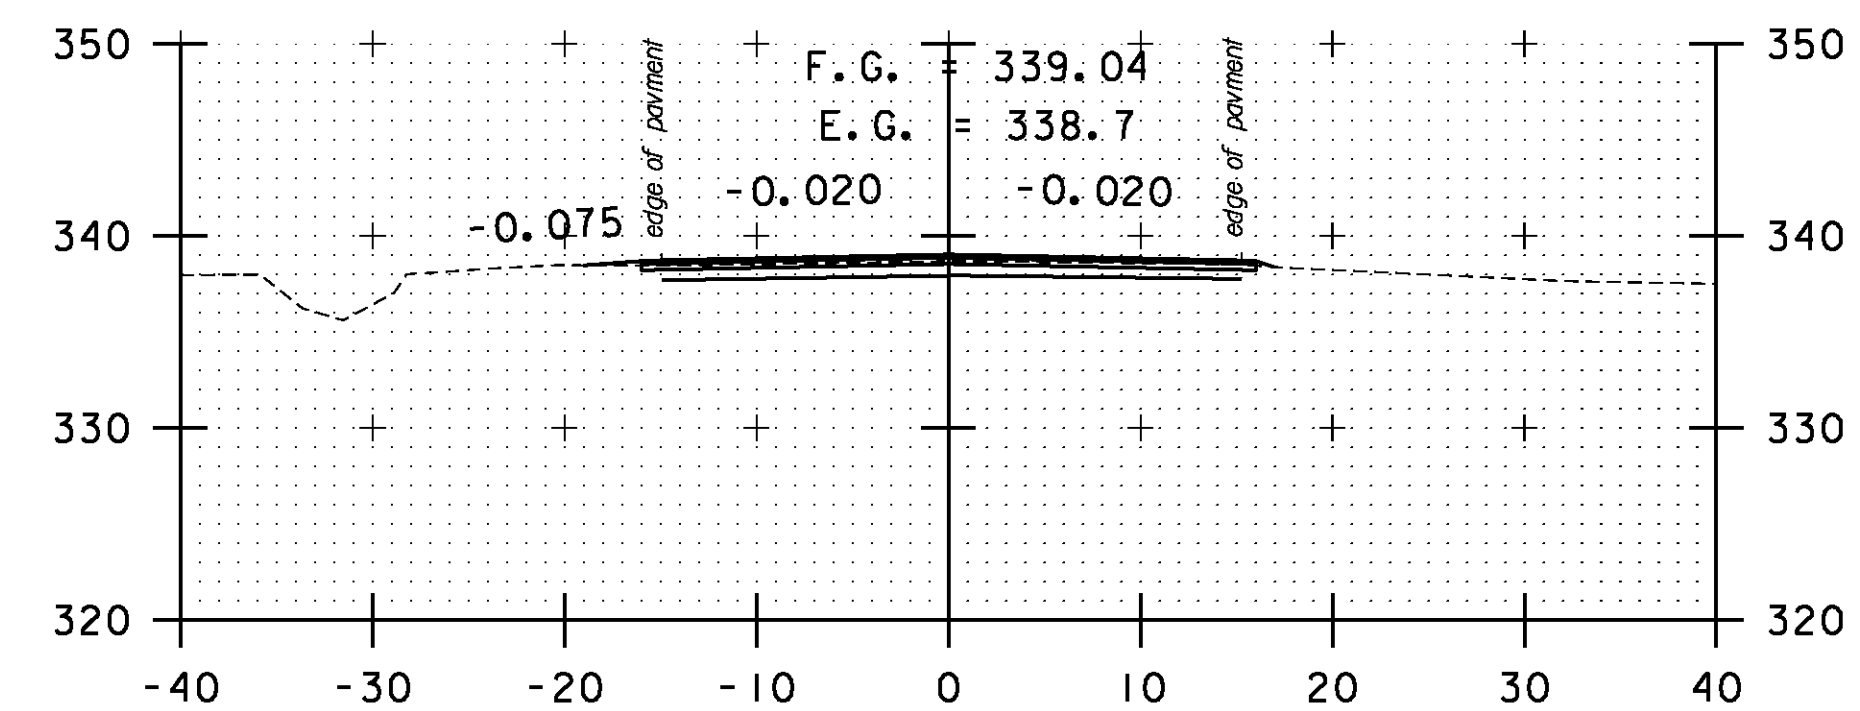

DRIVE LT
128+50

STA. 125+50 TO STA. 129+00

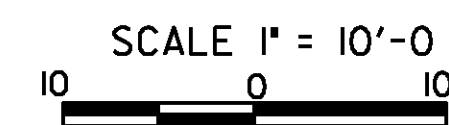

CROSS SECTION SHEET 7

PROJECT NAME: BOLTON-WATERBURY

PROJECT NUMBER: STP 2709(1)

FILE NAME: p07C172.dgn

PROJECT LEADER: CDL

DESIGNED BY: BMB

PLOT FILE: p07C172_133.1

PLOT DATE: 4/16/2013

DRAWN BY: BMB

CHECKED BY: CDL

SHEET 133 OF 217