




130+50

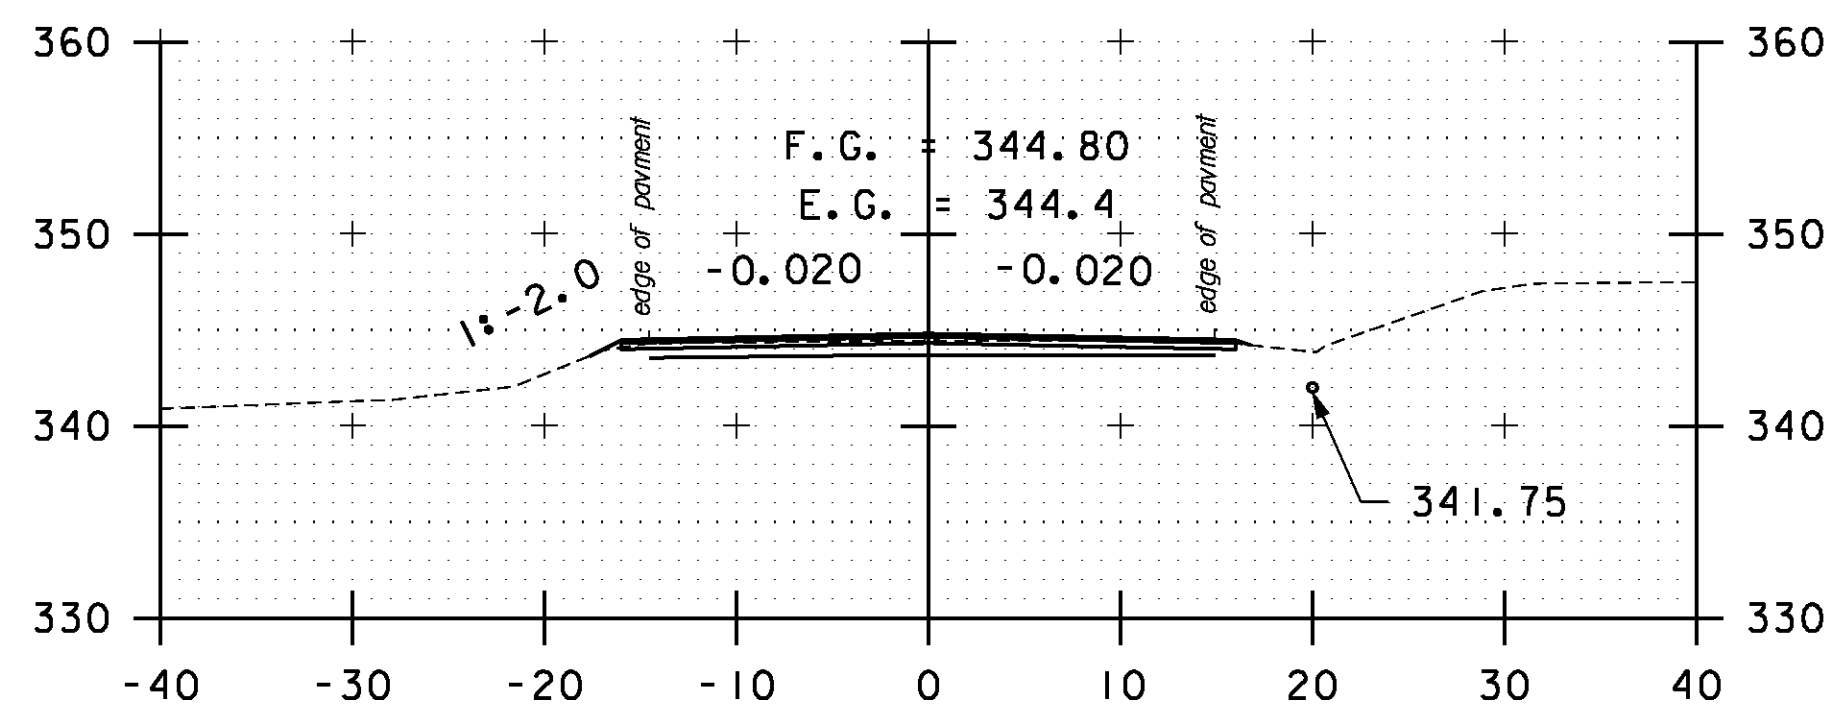


132+00

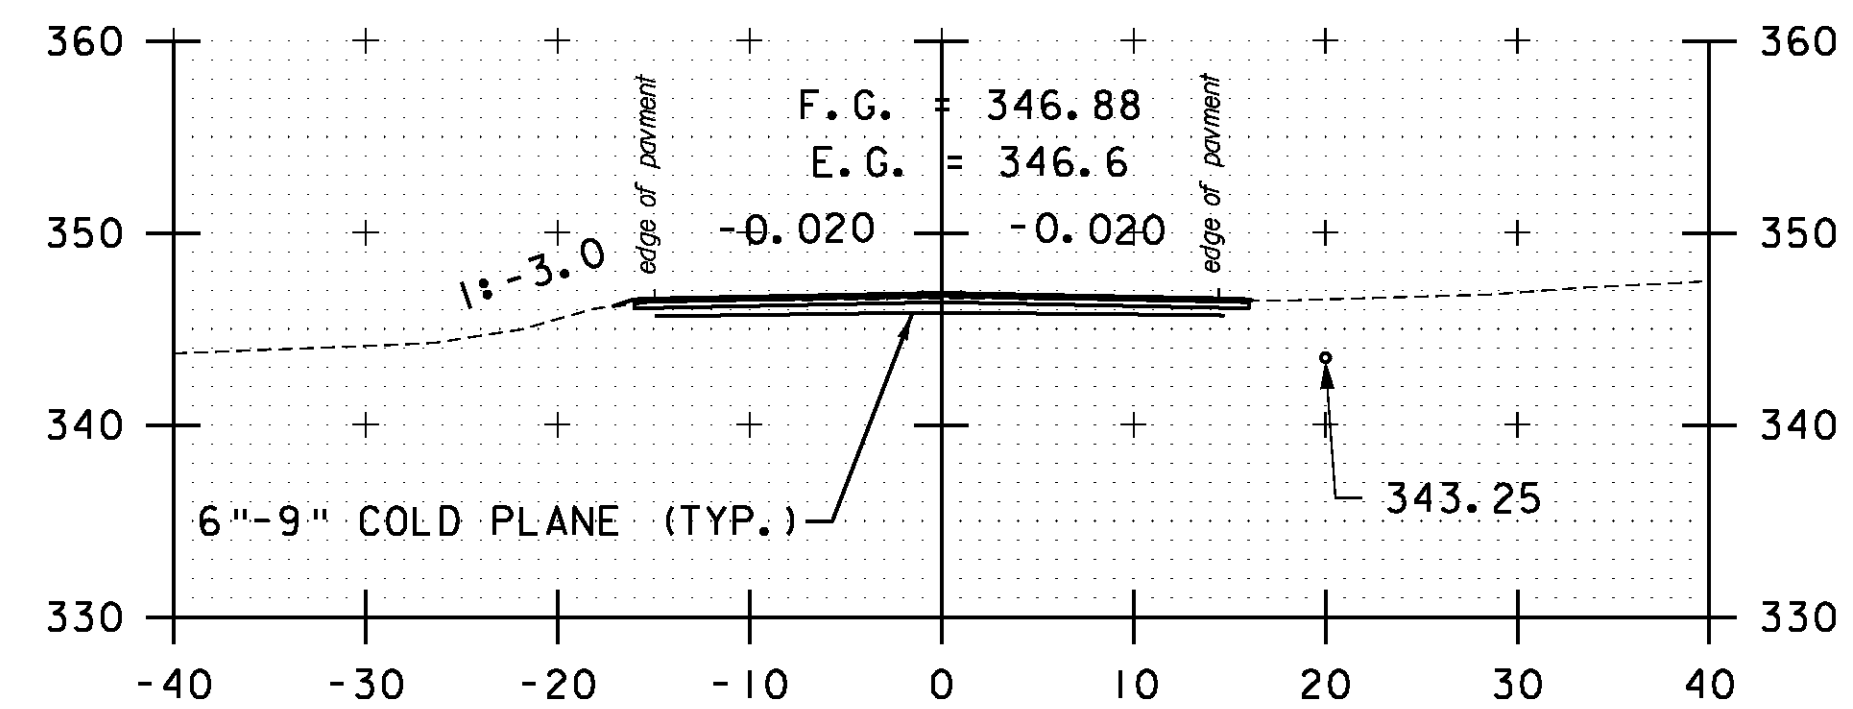


133+50

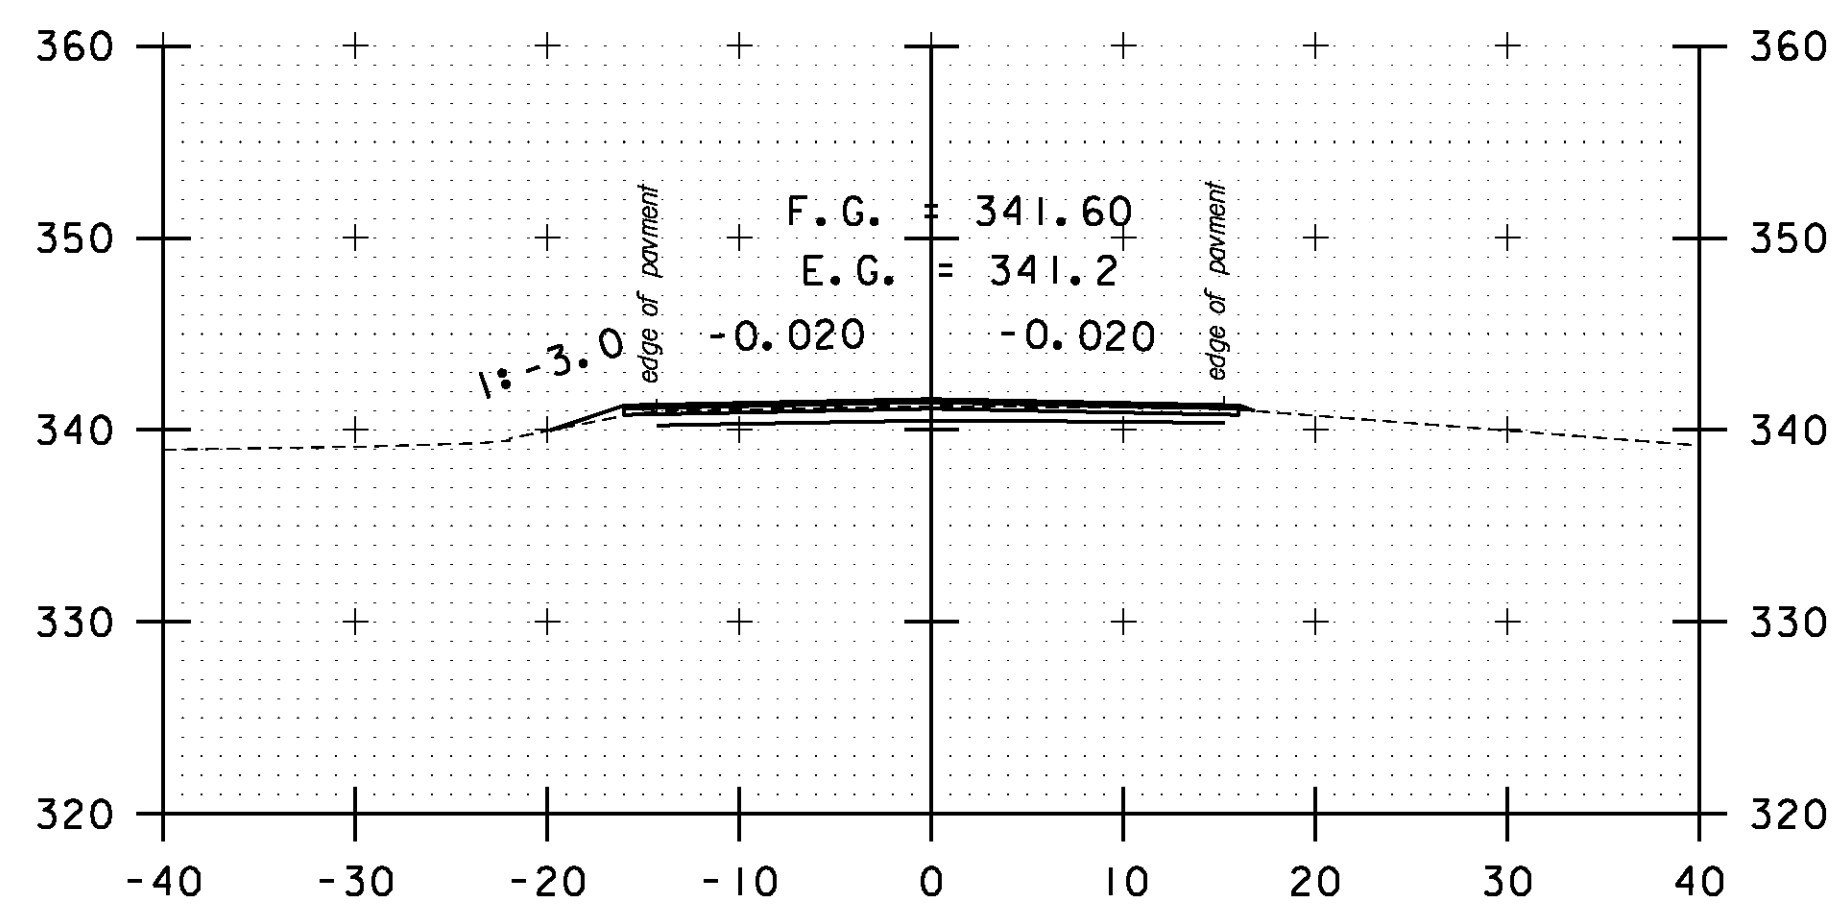


130+00

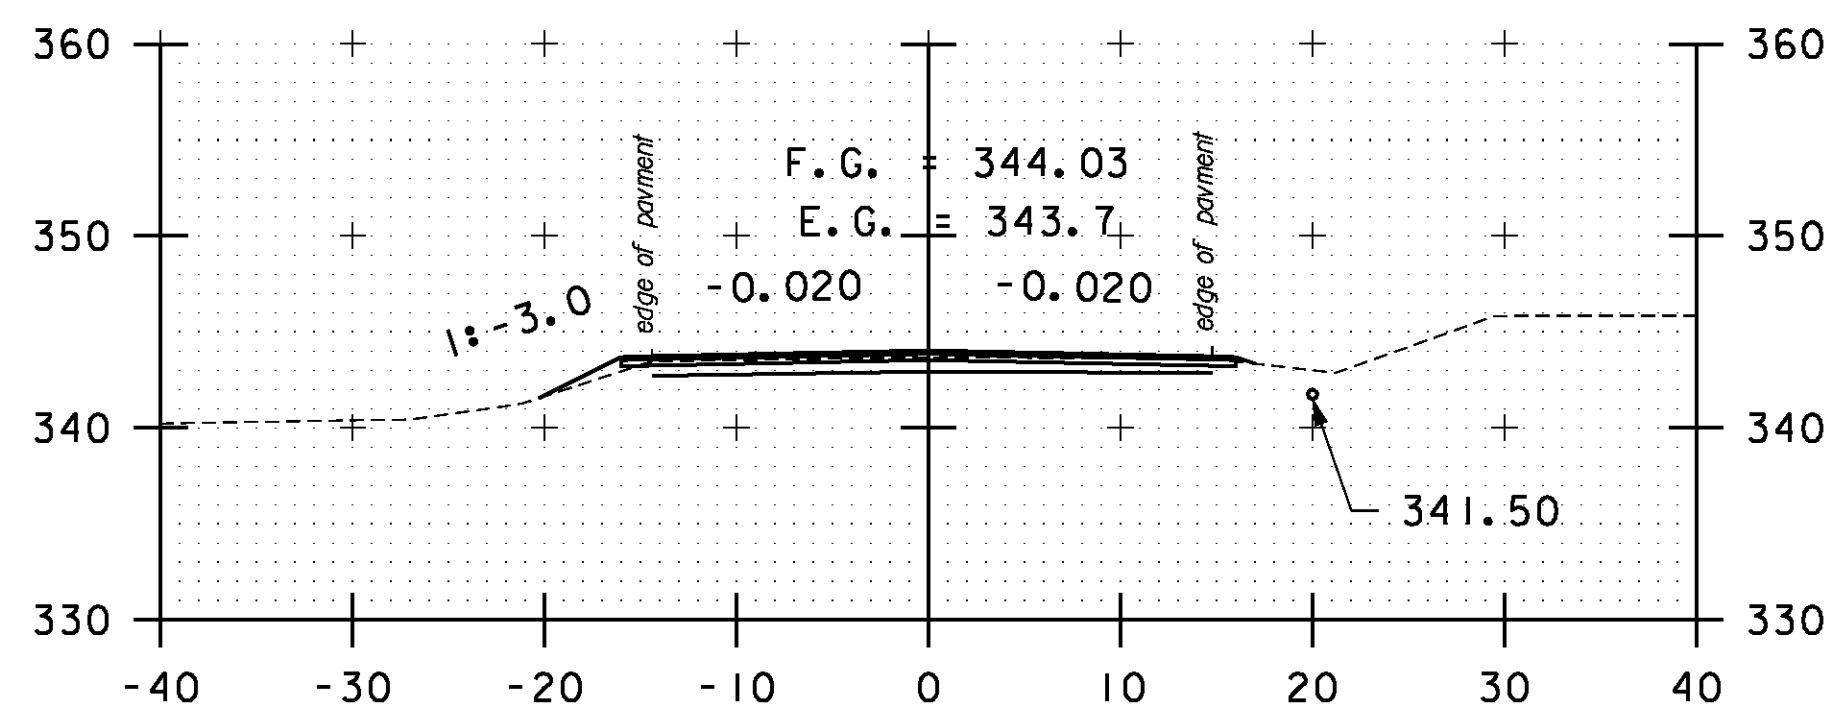


131+50

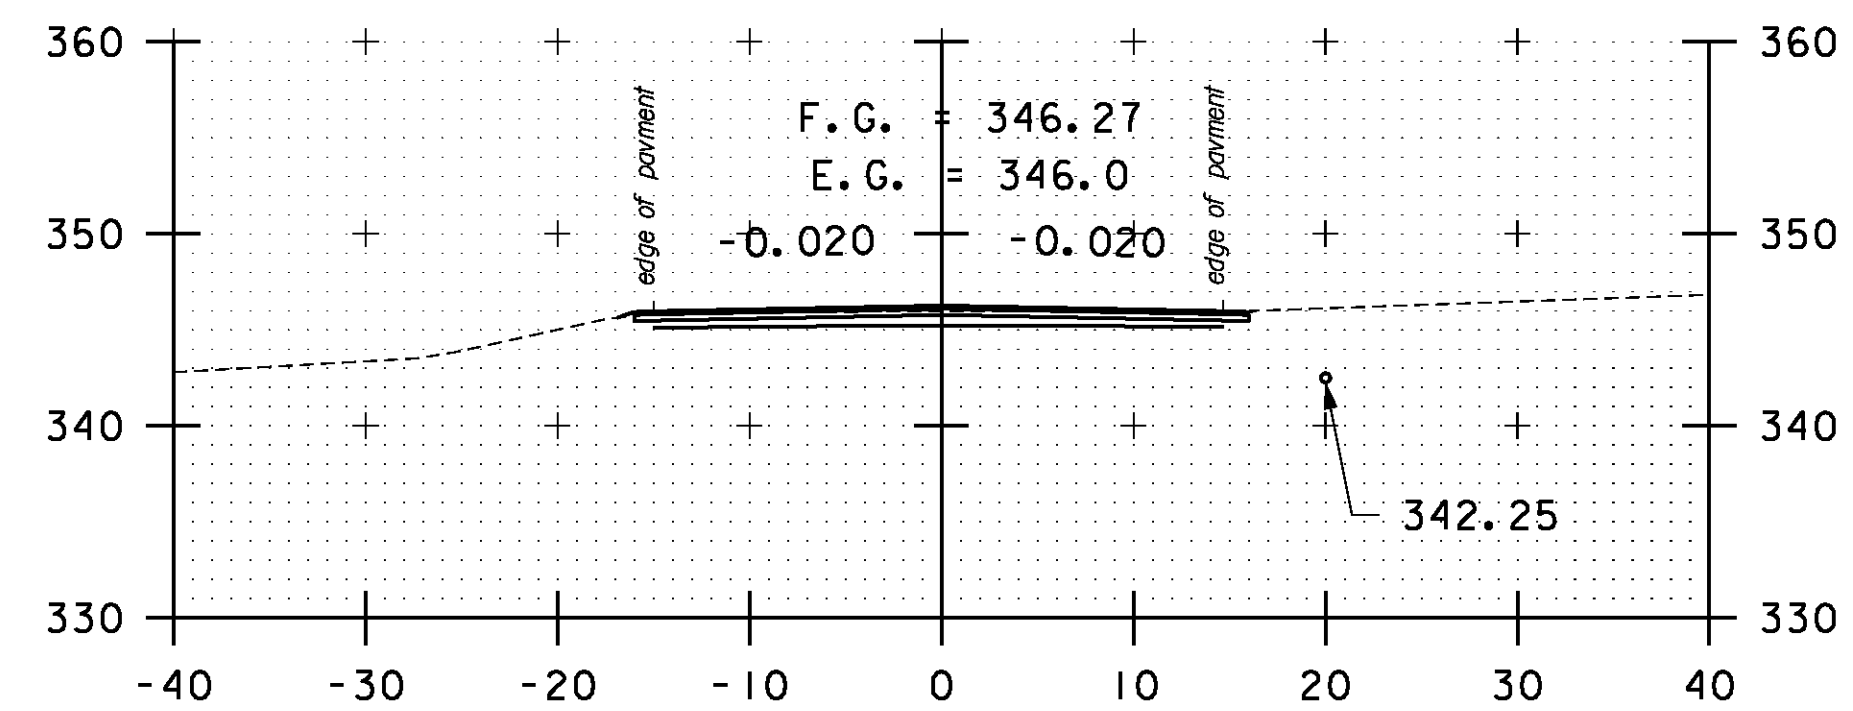


133+00

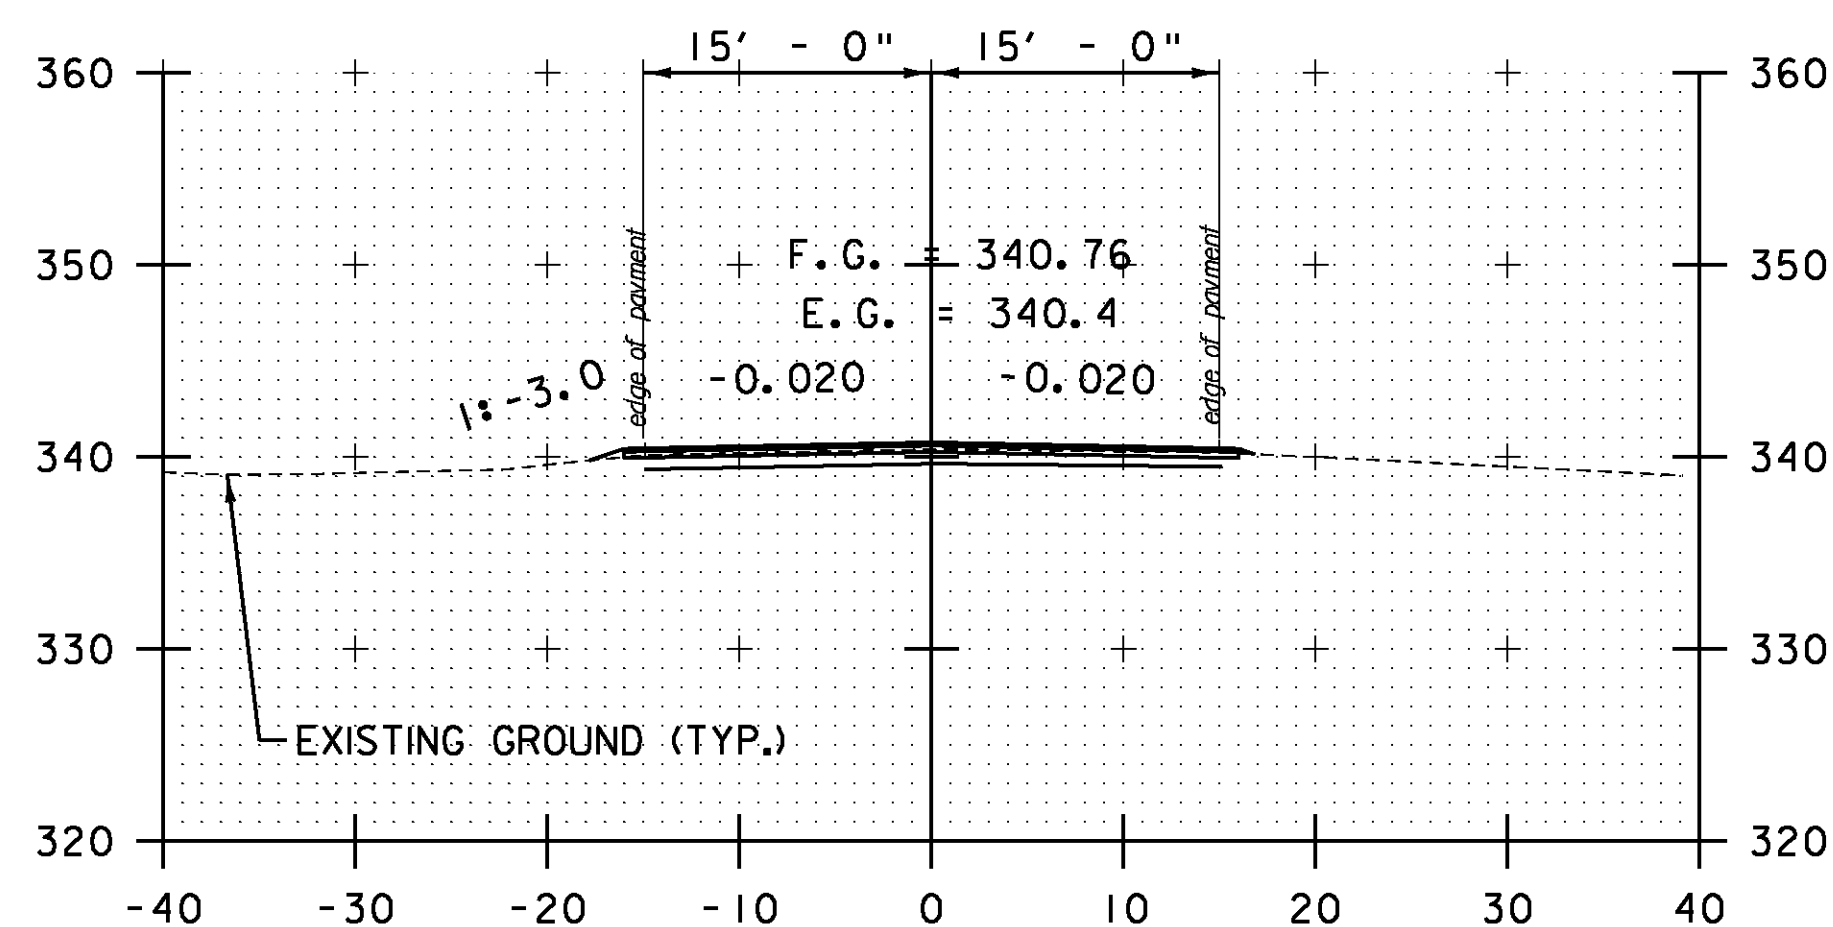

129+50

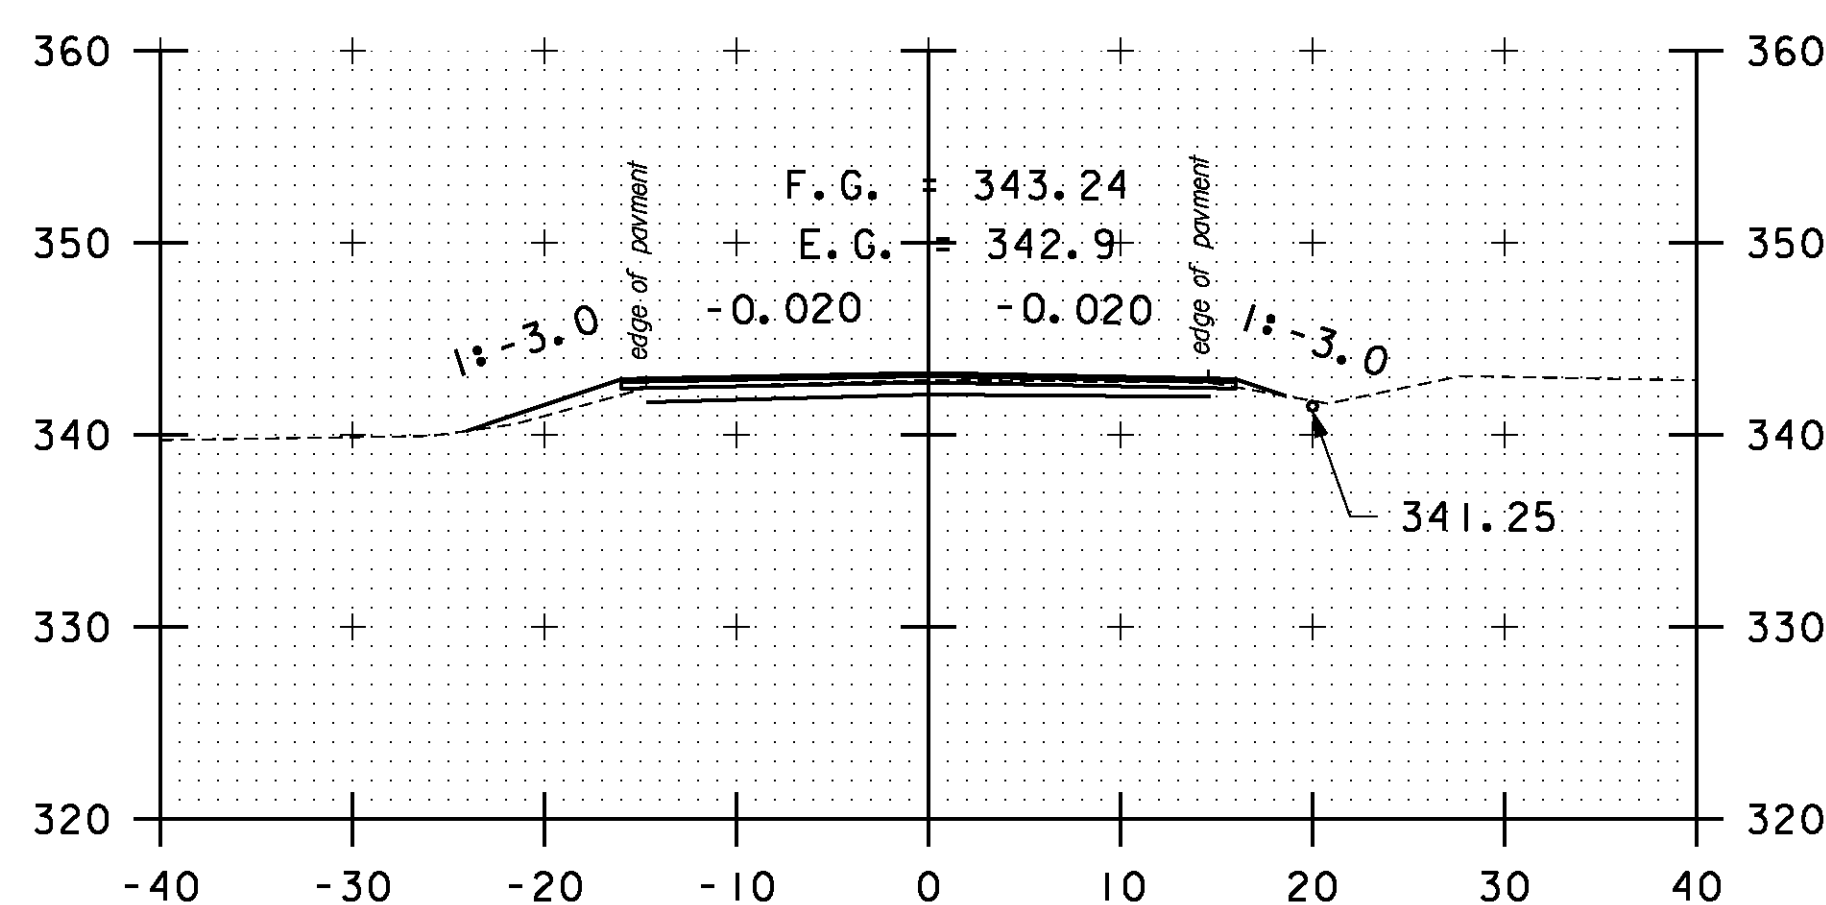


131+00

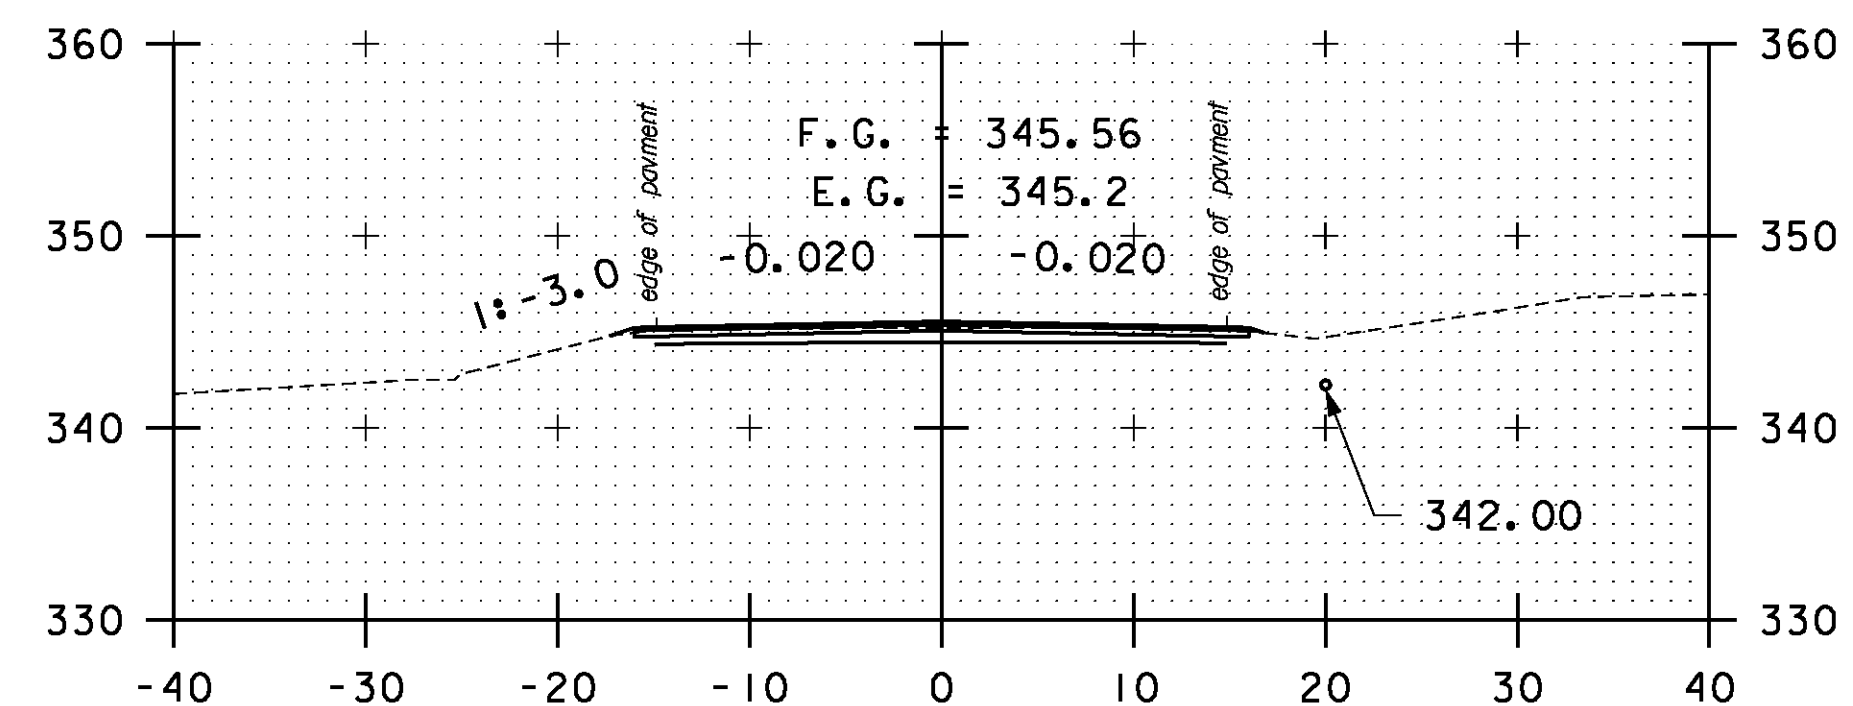

132+50

STA. 129+50 TO STA. 133+50

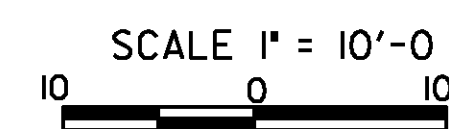

**CROSS SECTION SHEET 8**

PROJECT NAME: BOLTON-WATERBURY

PROJECT NUMBER: STP 2709(1)

FILE NAME: p07c172.dgn

PROJECT LEADER: CDL

DESIGNED BY: BMB

PLOT FILE: p07c172\_134.1

PLOT DATE: 4/16/2013

DRAWN BY: BMB

CHECKED BY: CDL

SHEET 134 OF 217