




DRIVE RT  
135+00

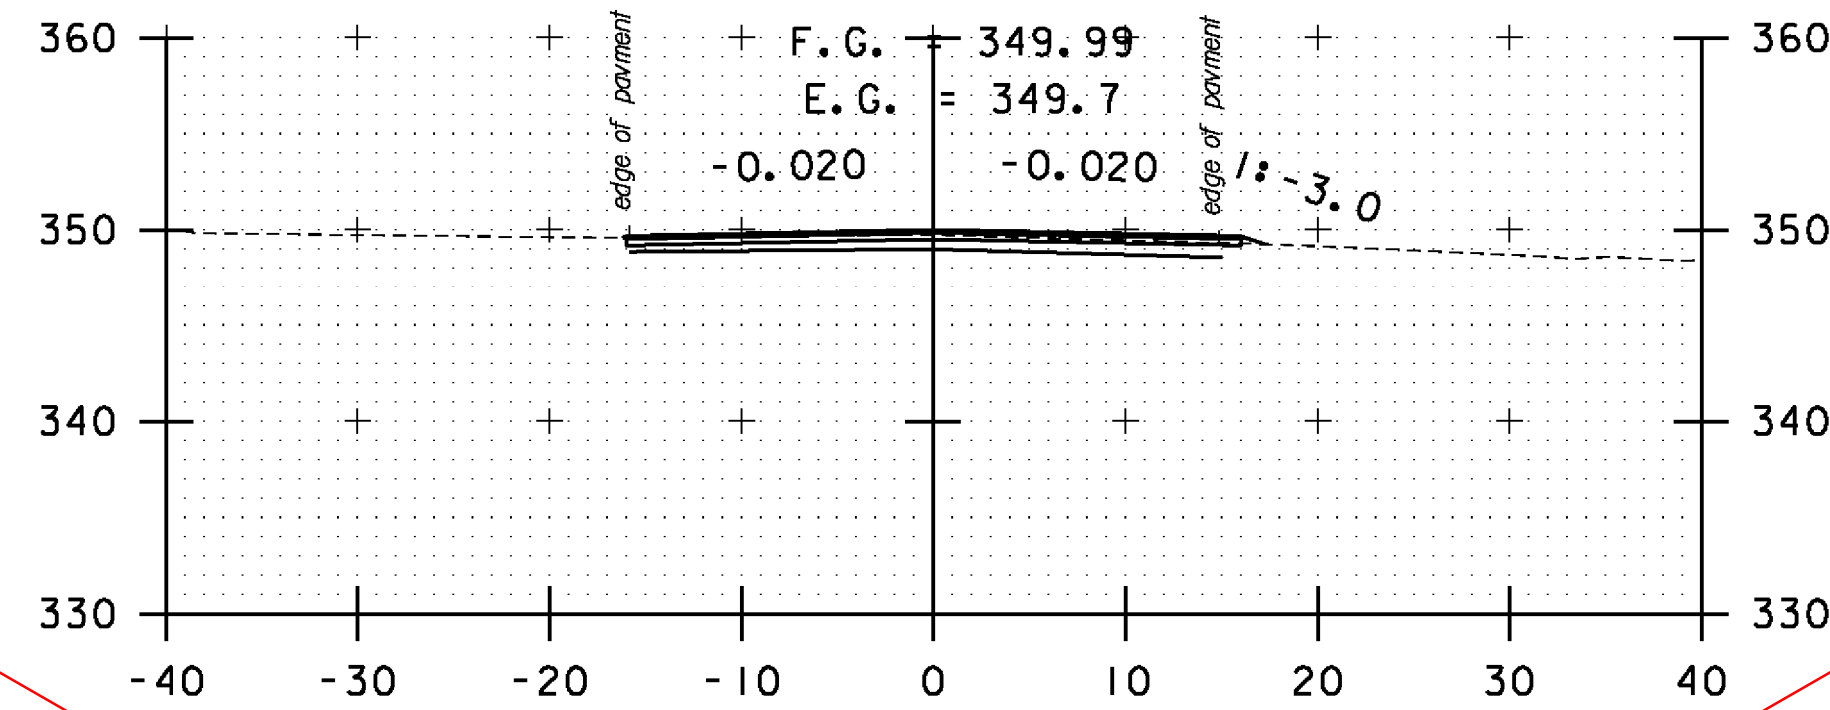


136+50

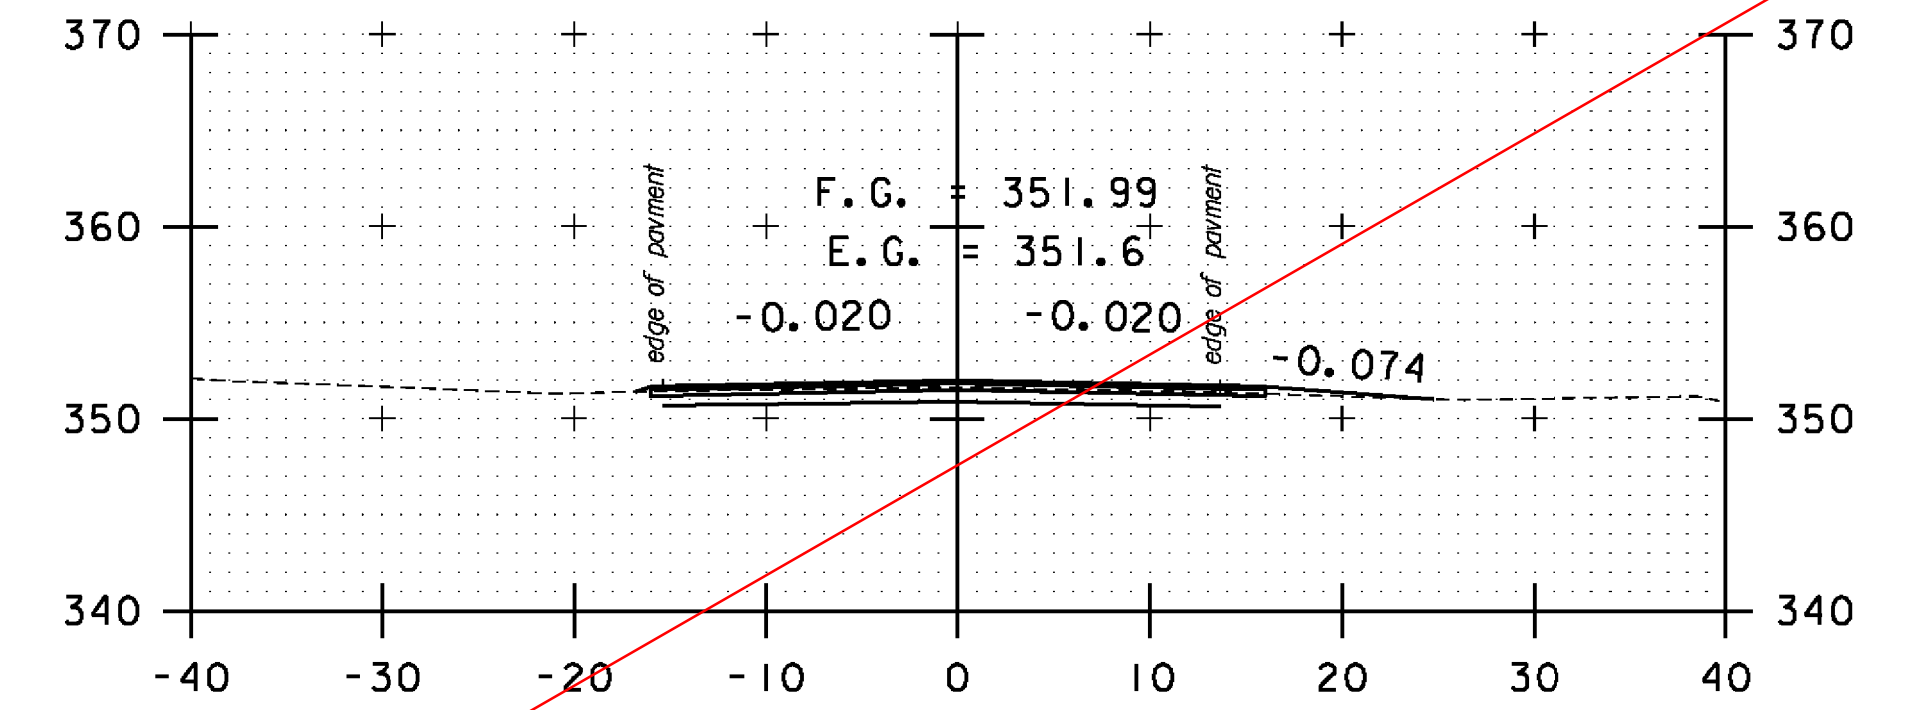


DRIVE RT  
137+50

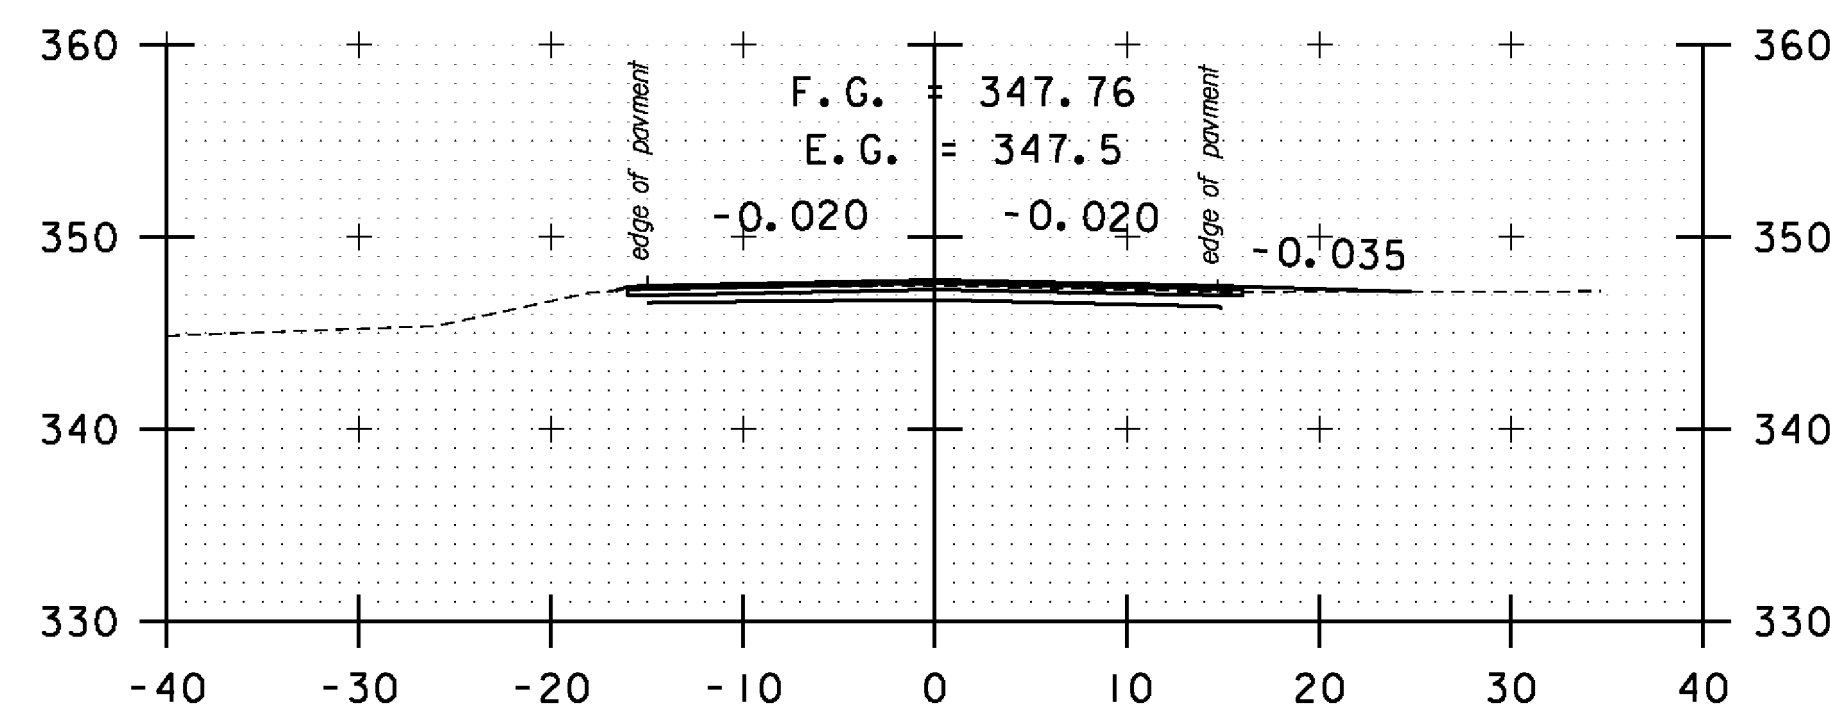


DRIVE RT  
134+50

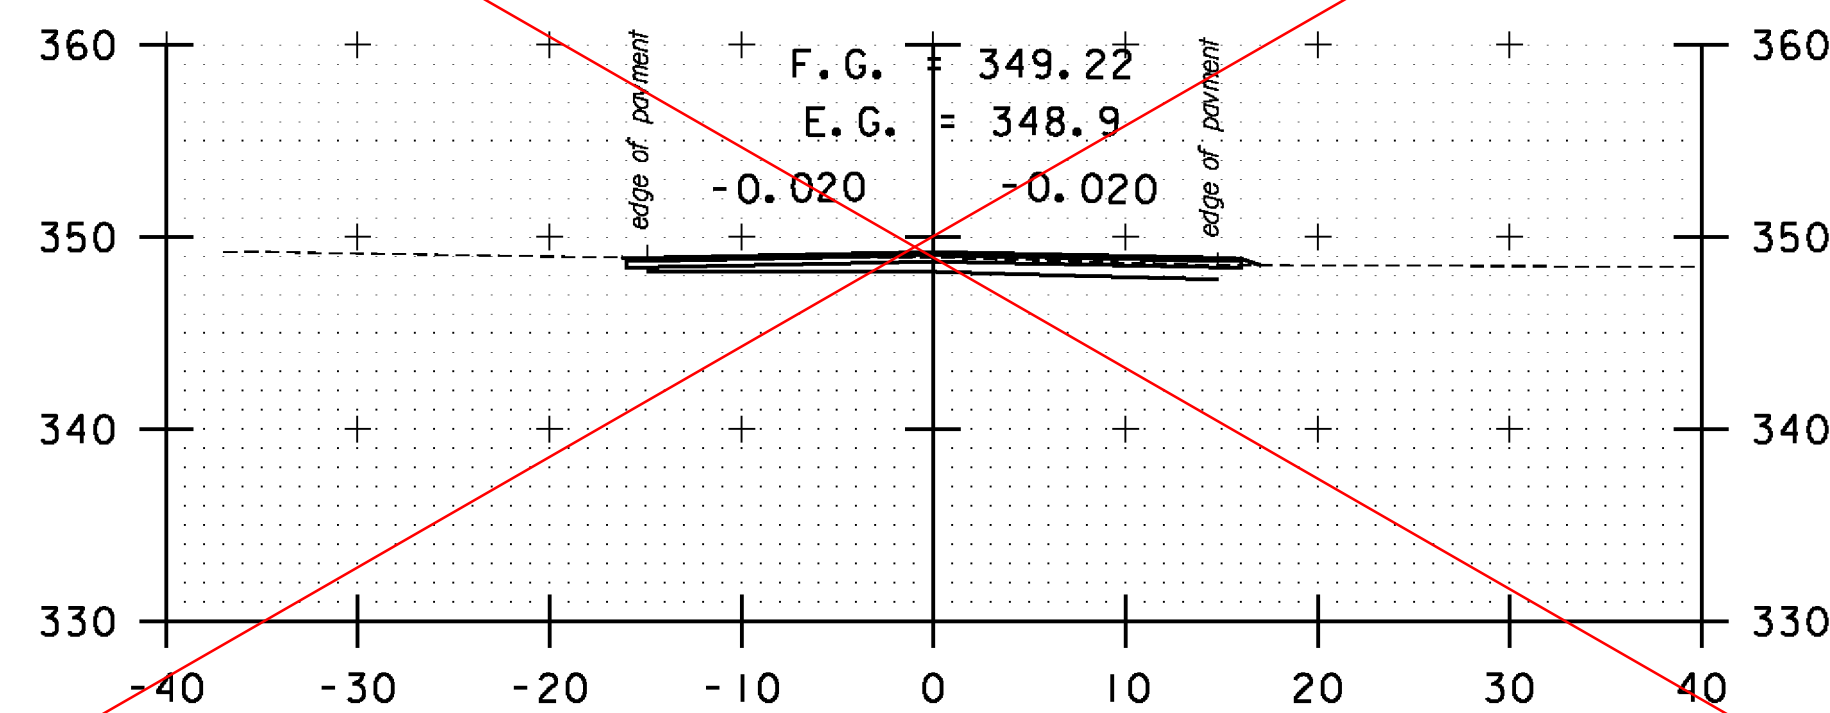


136+00

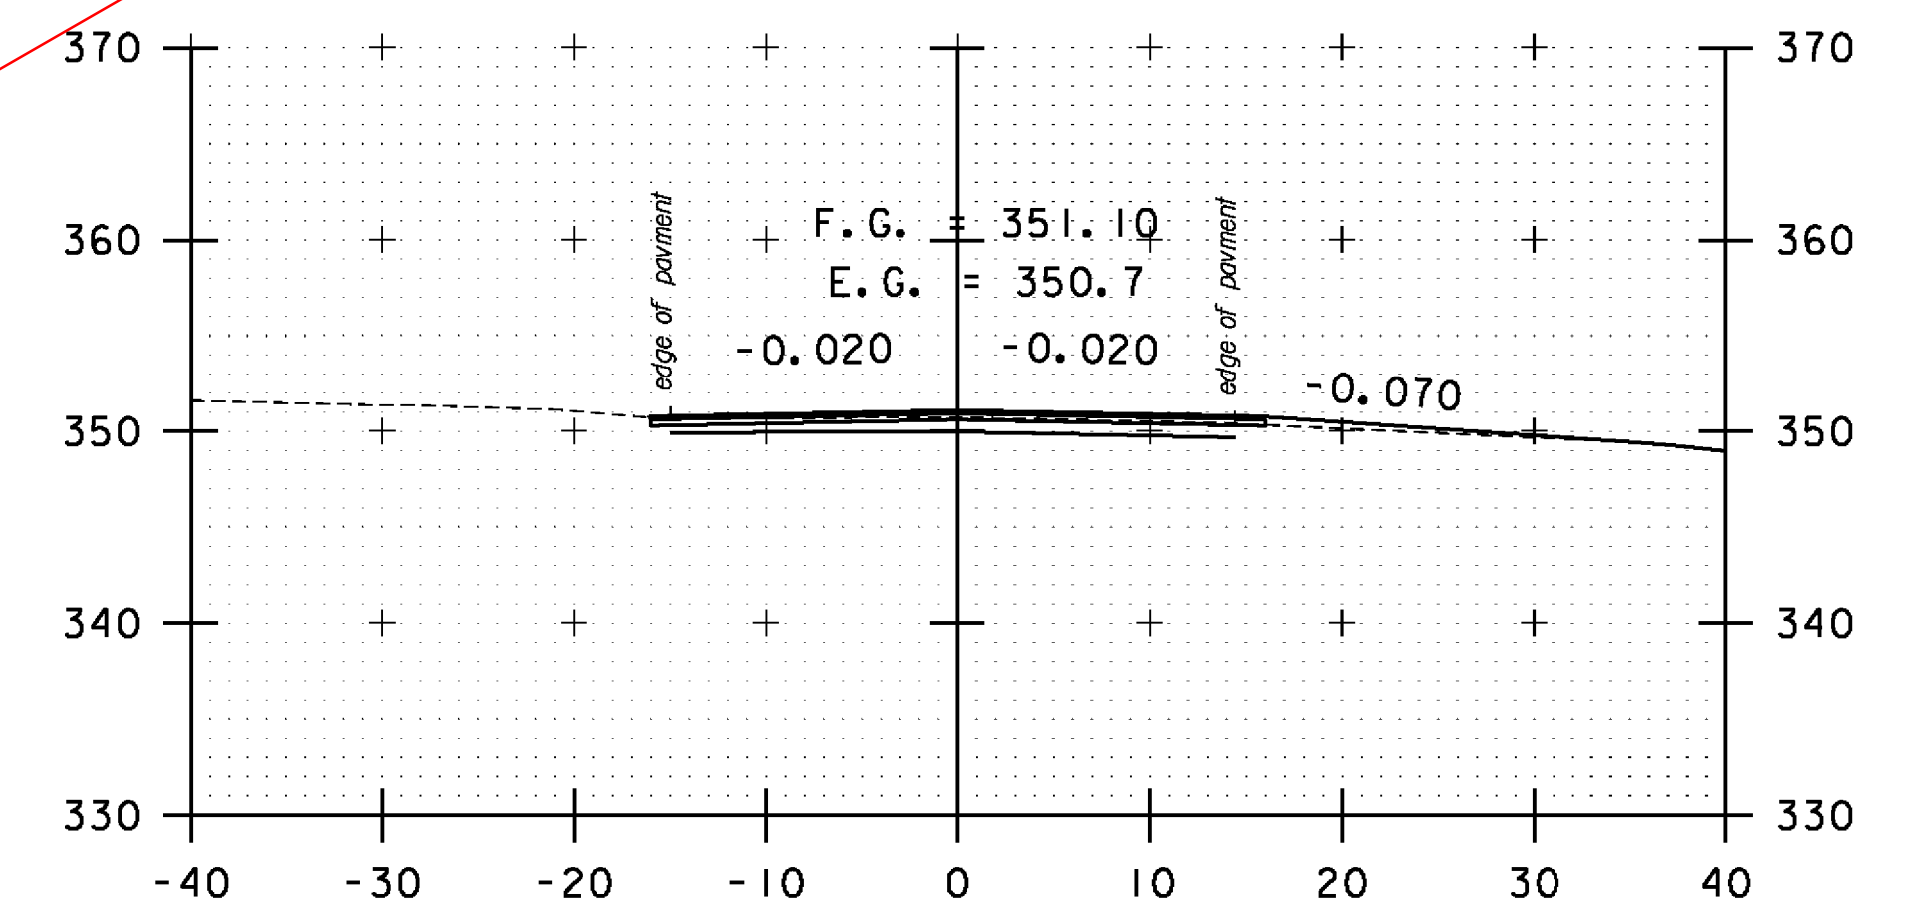


DRIVE LT / TH#18 RT  
137+09

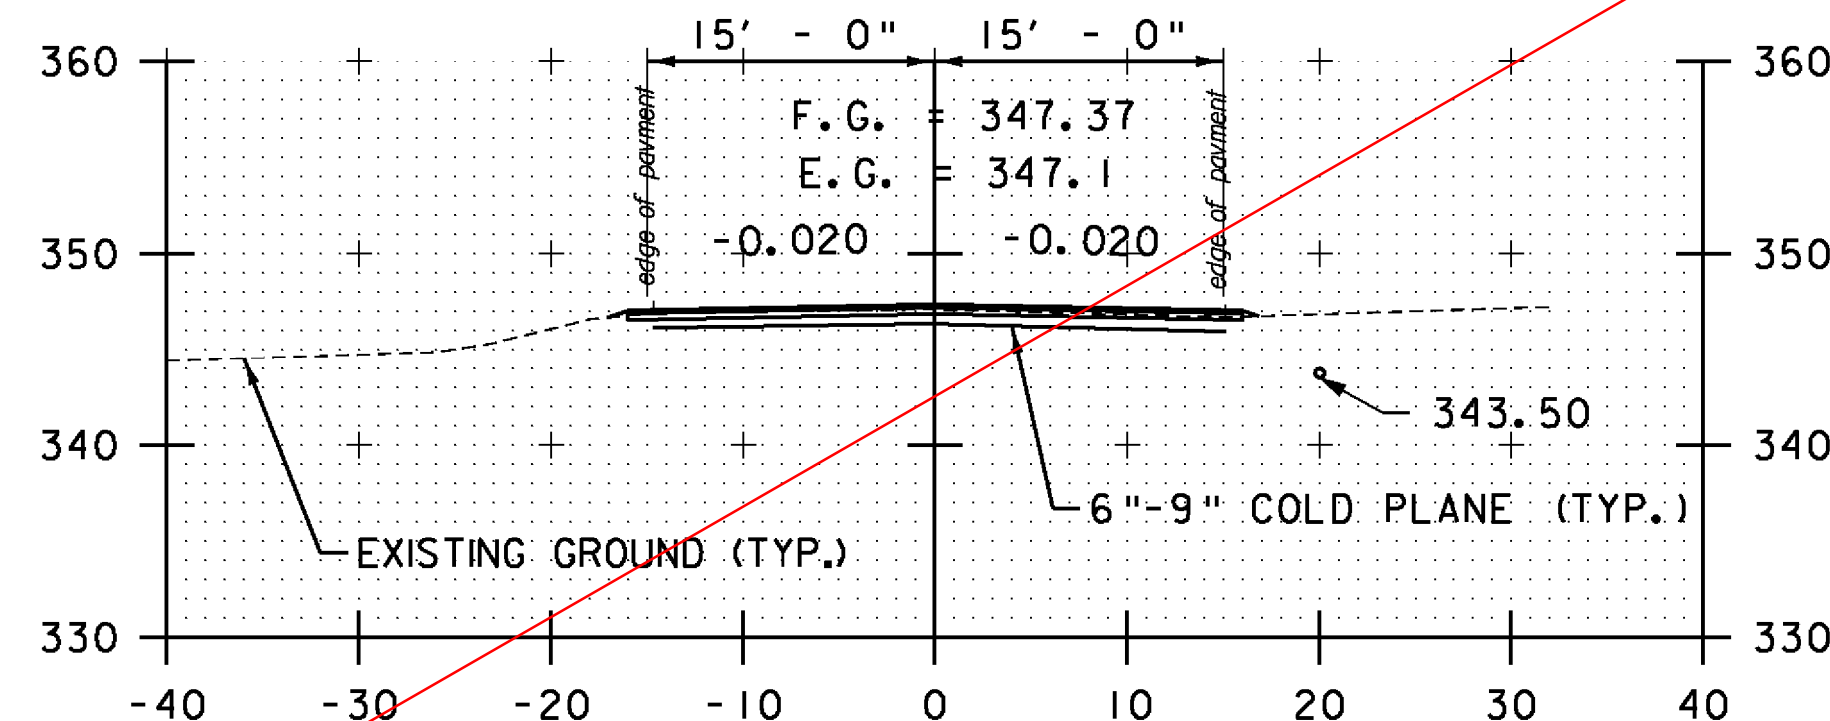

134+00

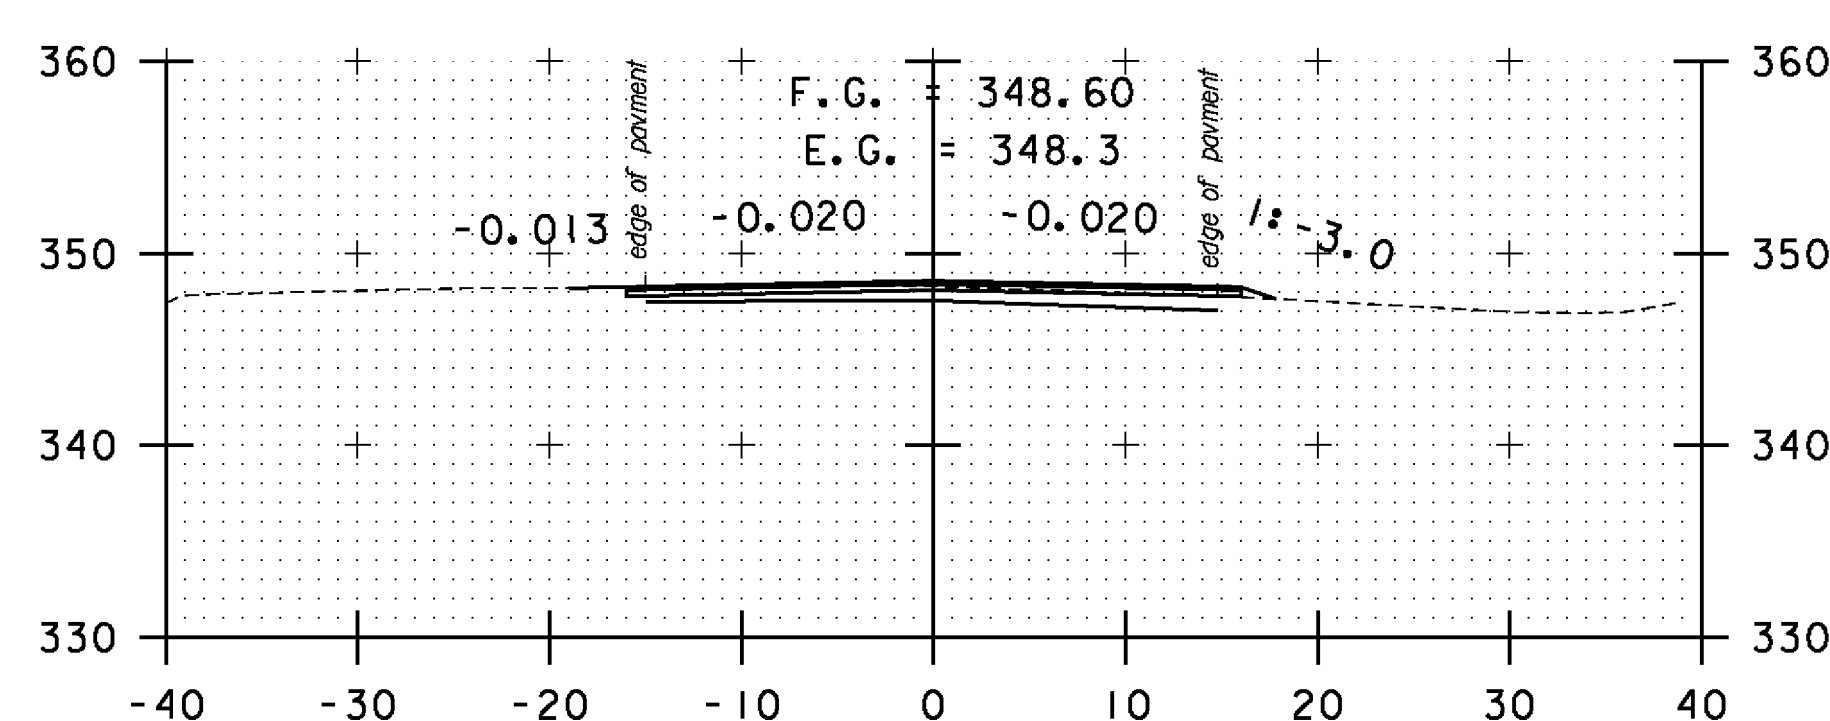

DRIVE LT  
135+50

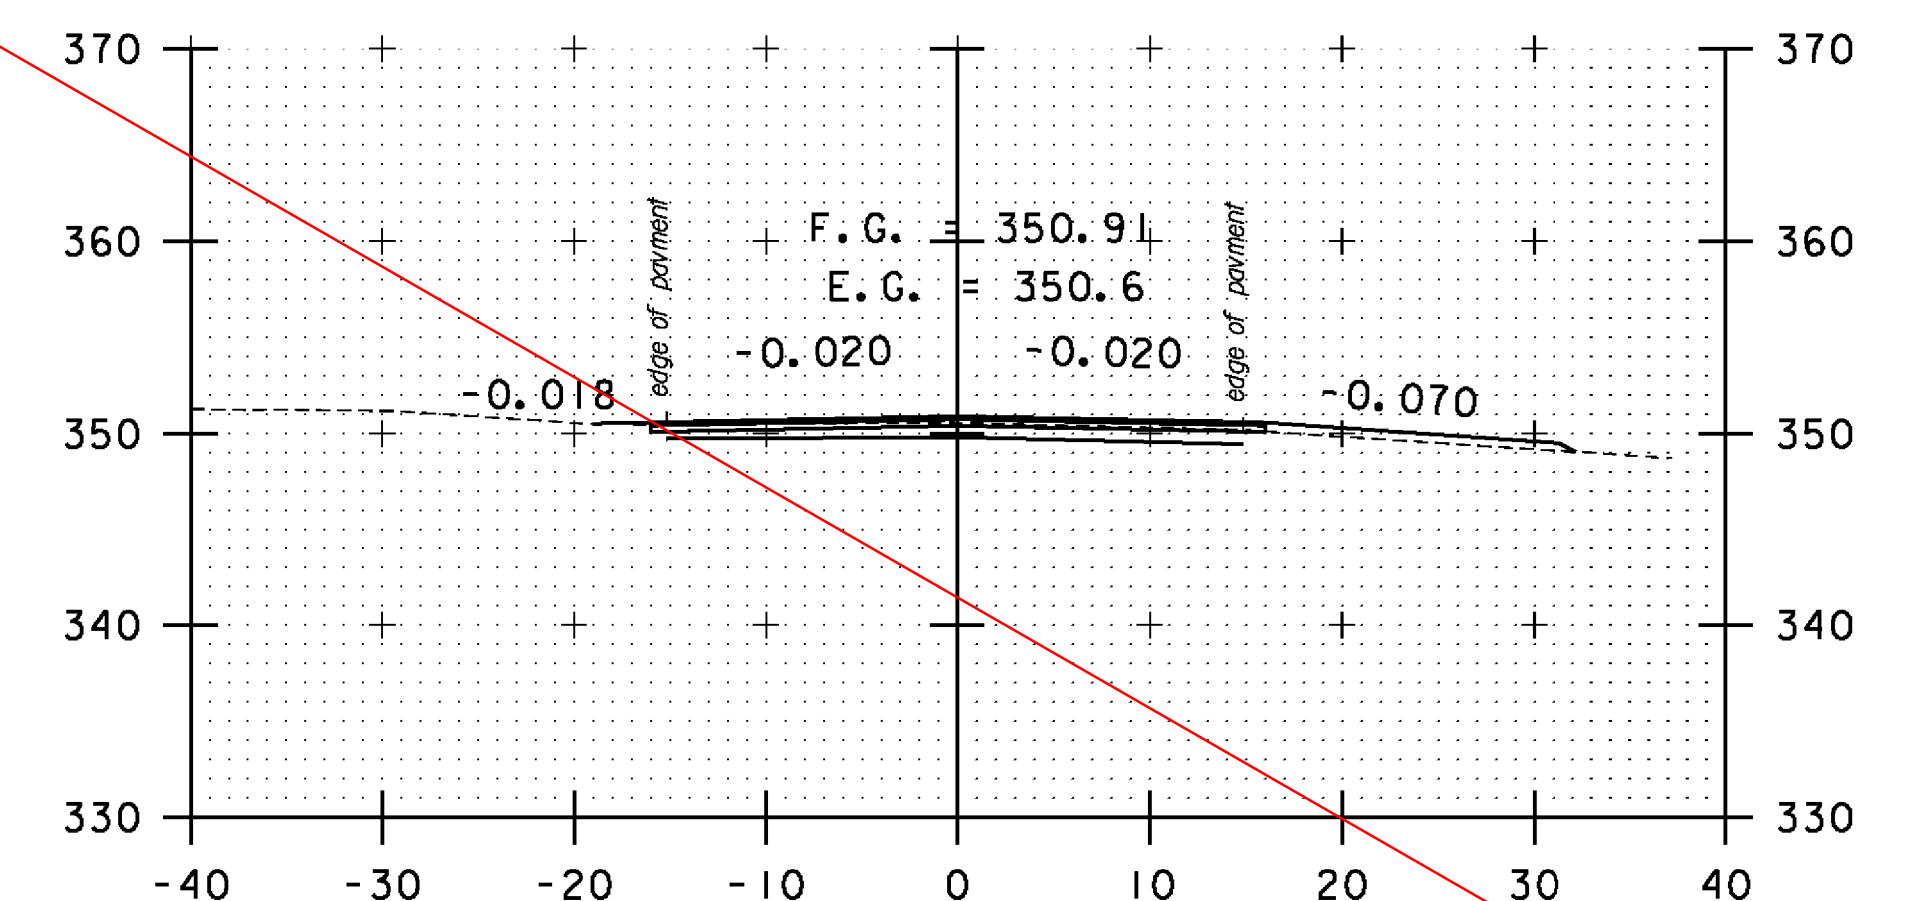

DRIVE LT / TH#18 RT  
137+00

SEE SHEETS 135R - 1138R  
FOR REVISED CROSS SECTIONS

STA. 134+00 TO STA. 137+50



**CROSS  
SECTION  
SHEET 9**

PROJECT NAME: BOLTON-WATERBURY	PLOT DATE: 4/16/2013
PROJECT NUMBER: STP 2709(1)	DRAWN BY: BMB
FILE NAME: p07C172.dgn	CHECKED BY: CDL
PROJECT LEADER: CDL	SHEET 135 OF 217
DESIGNED BY: BMB	
PLOT FILE: p07C172-135.1	