




DRIVE RT
135+00

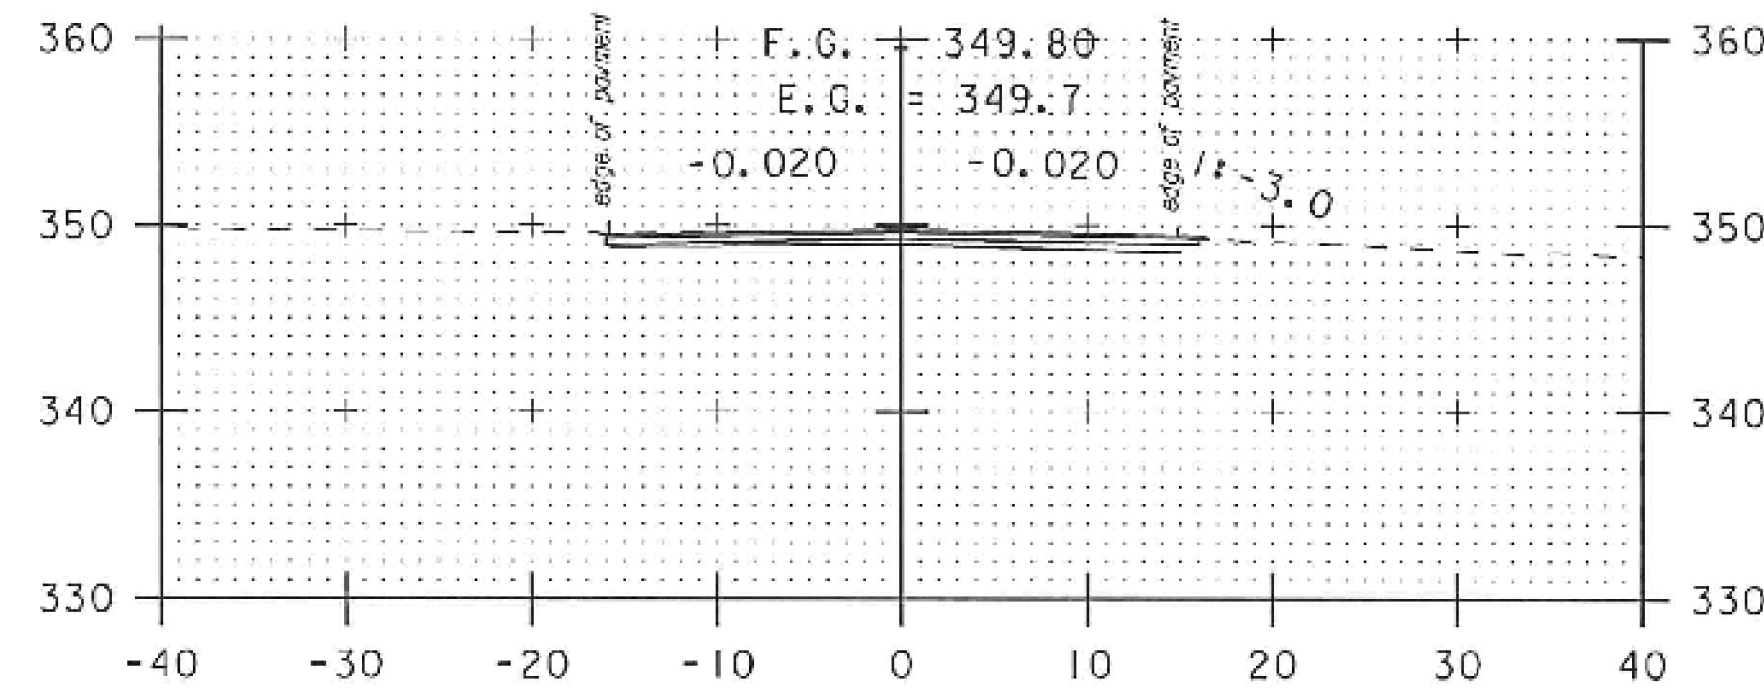


136+50

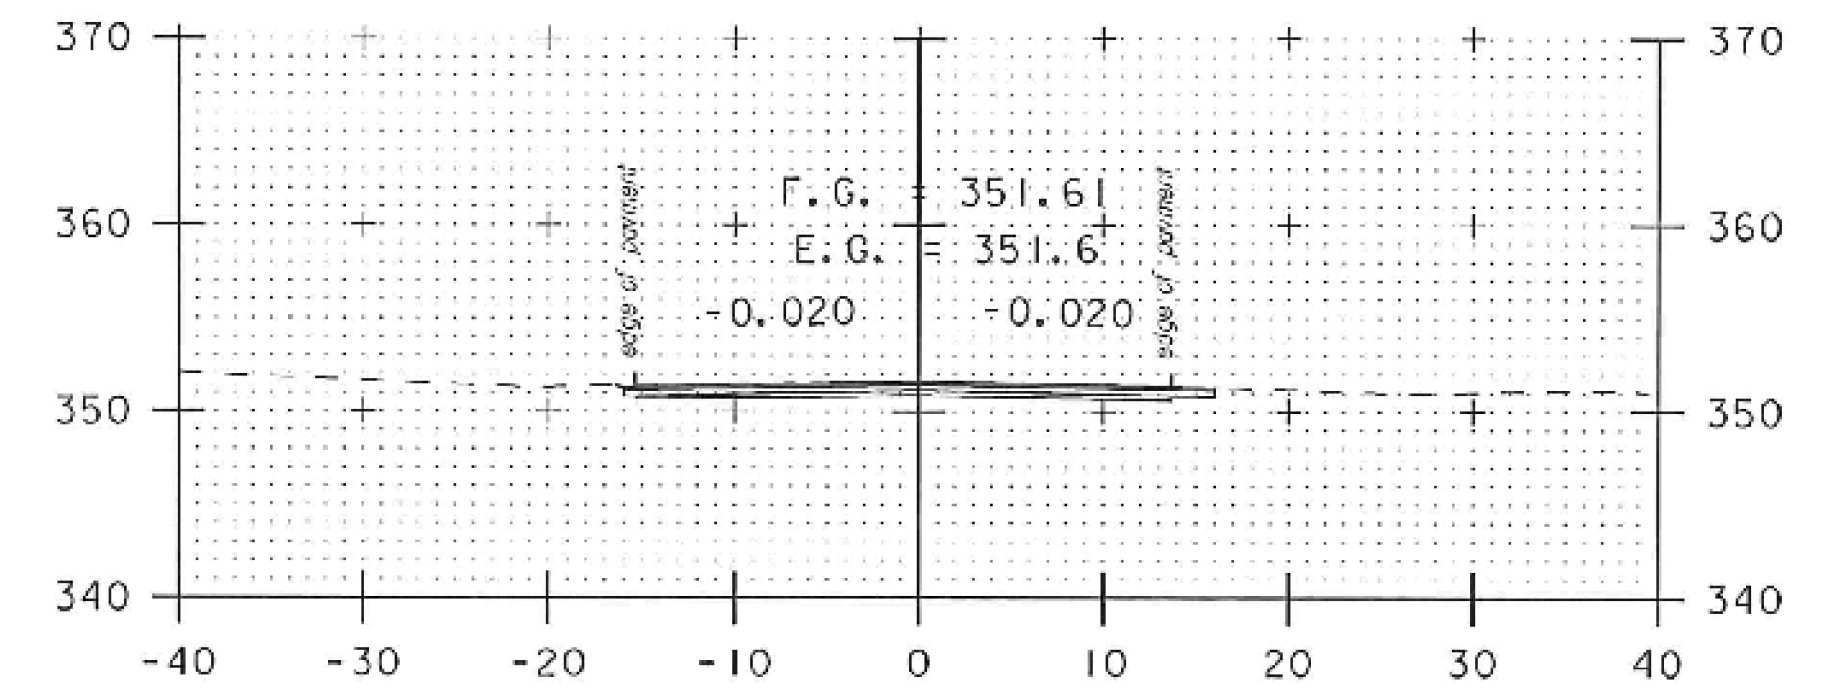


DRIVE RT
137+50

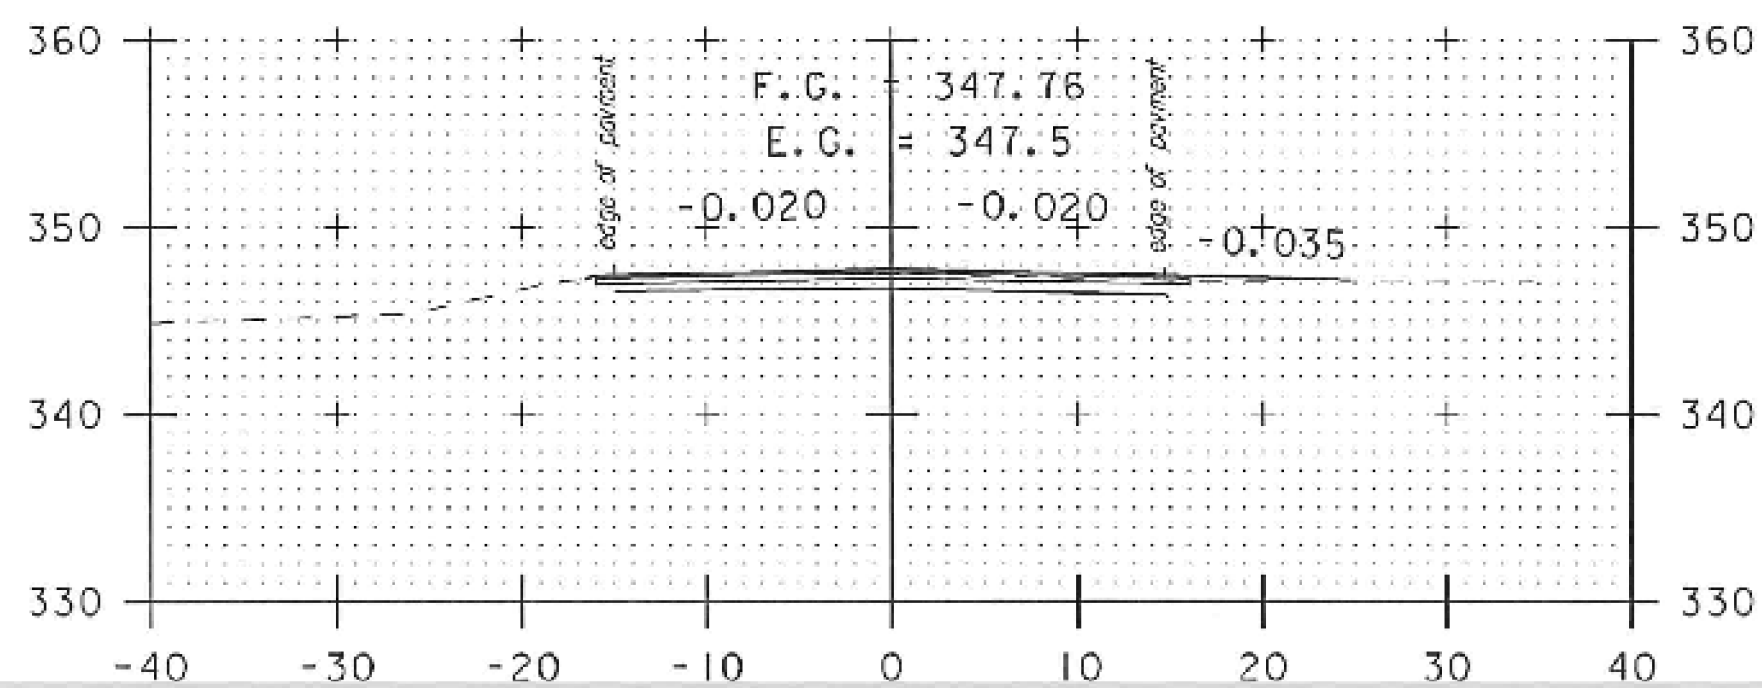


DRIVE RT
134+50

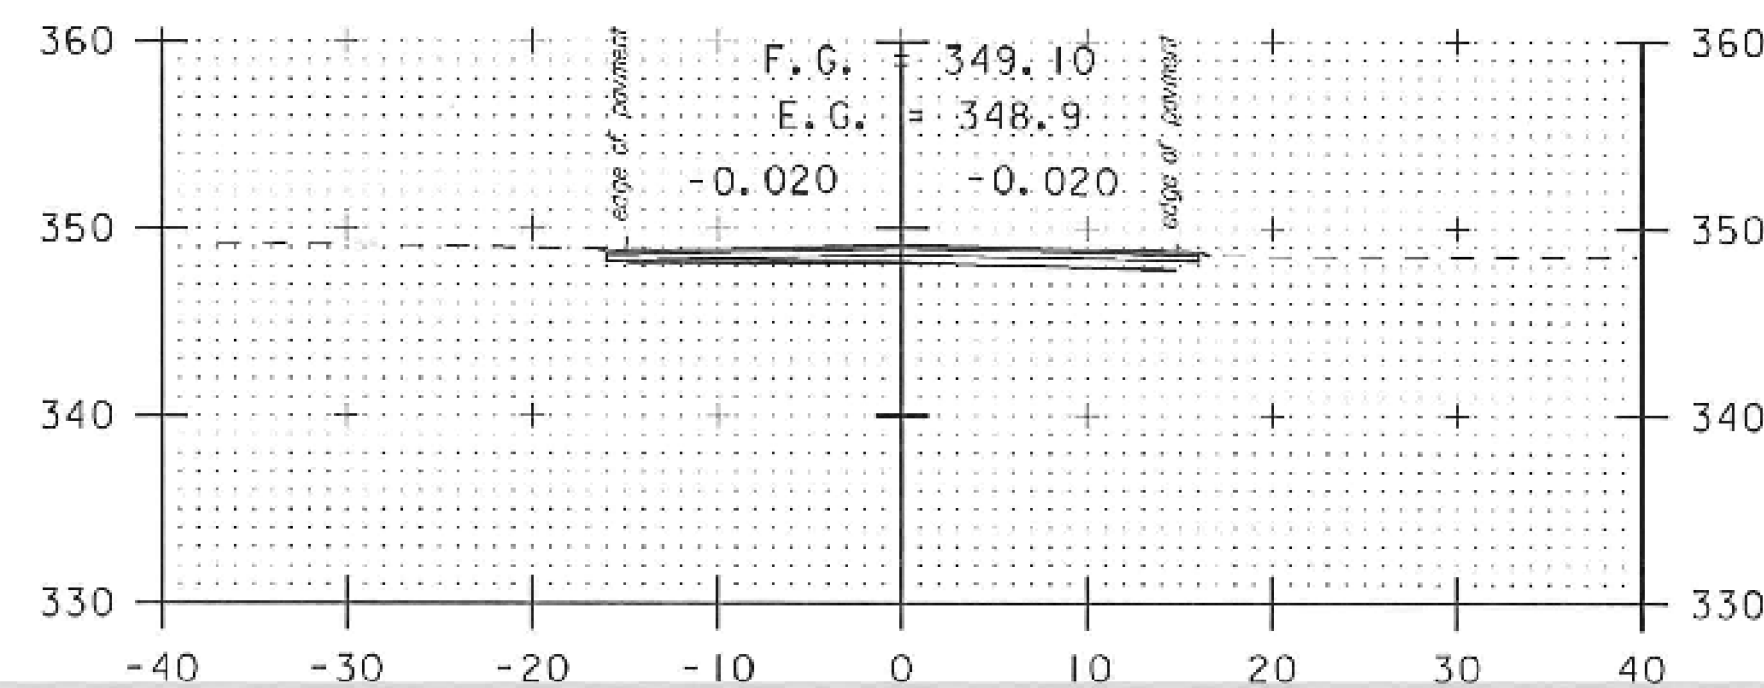


136+00

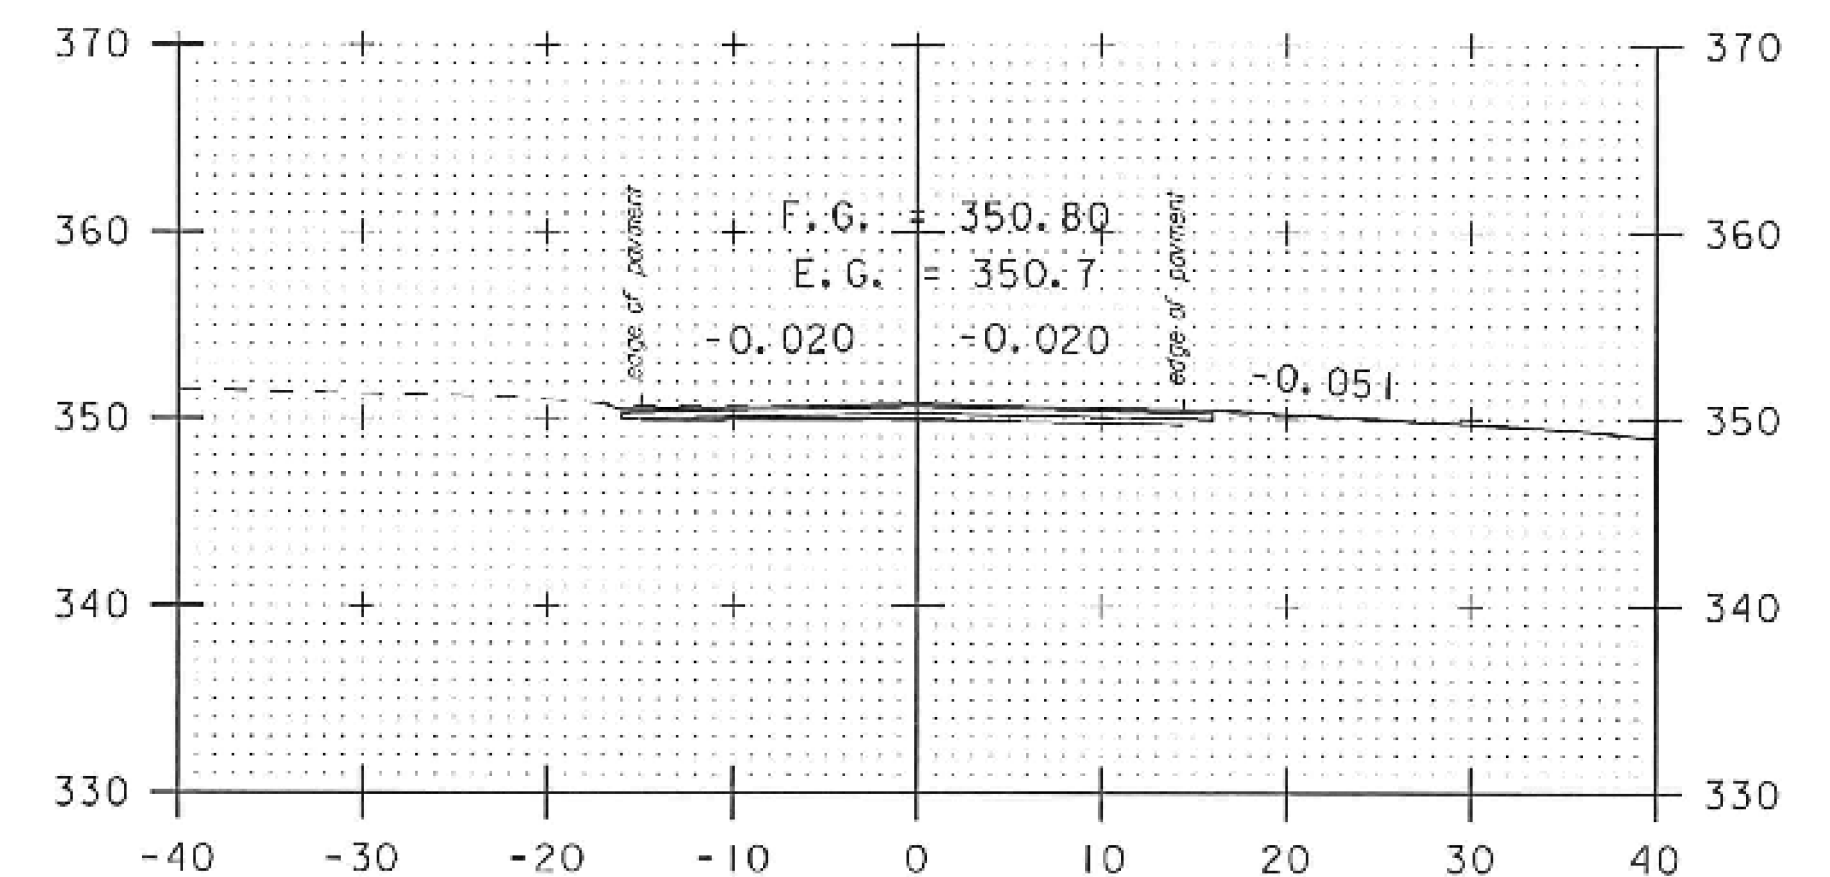


DRIVE LT / TH#18 RT
137+09

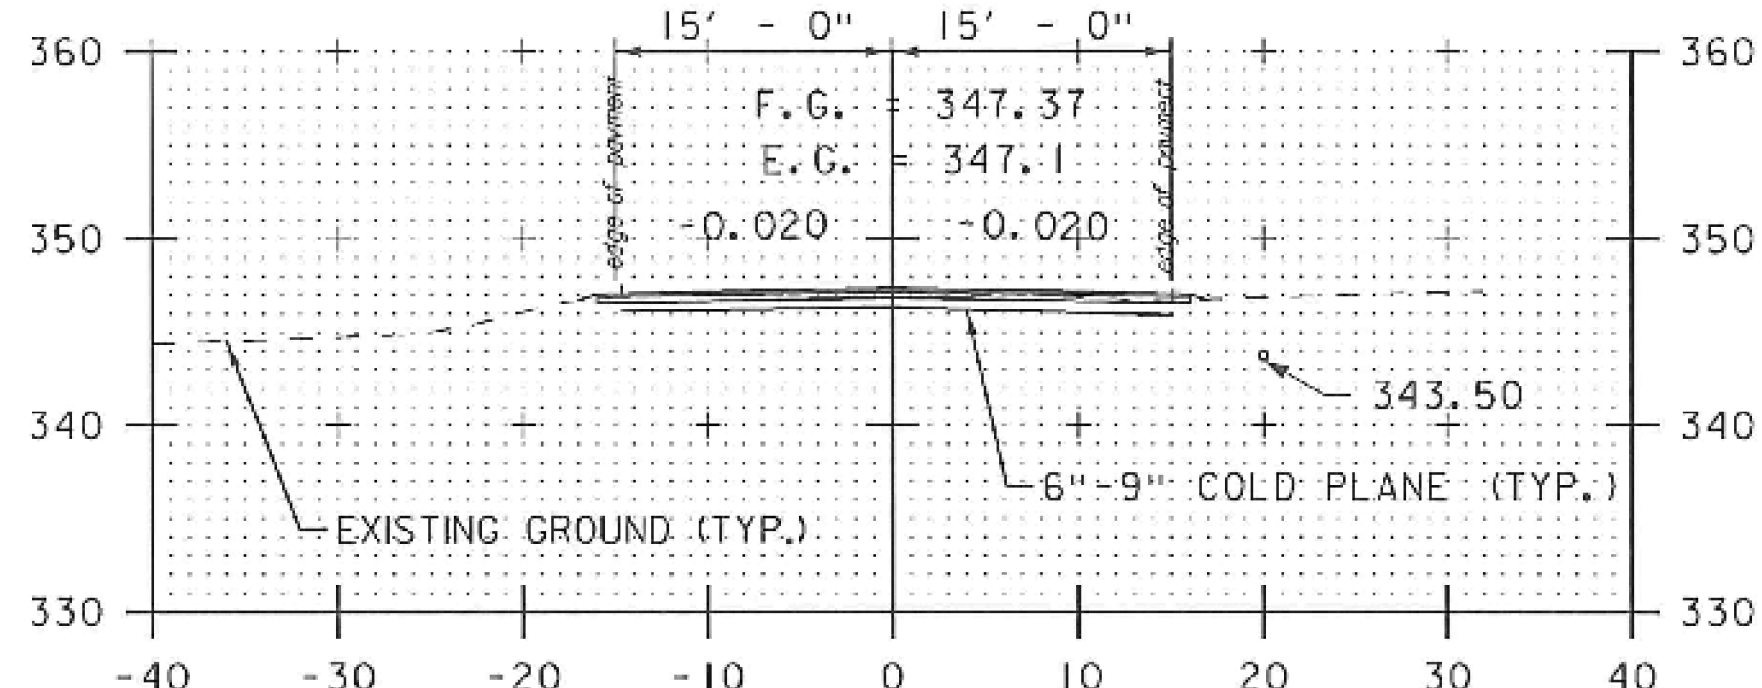

134+00

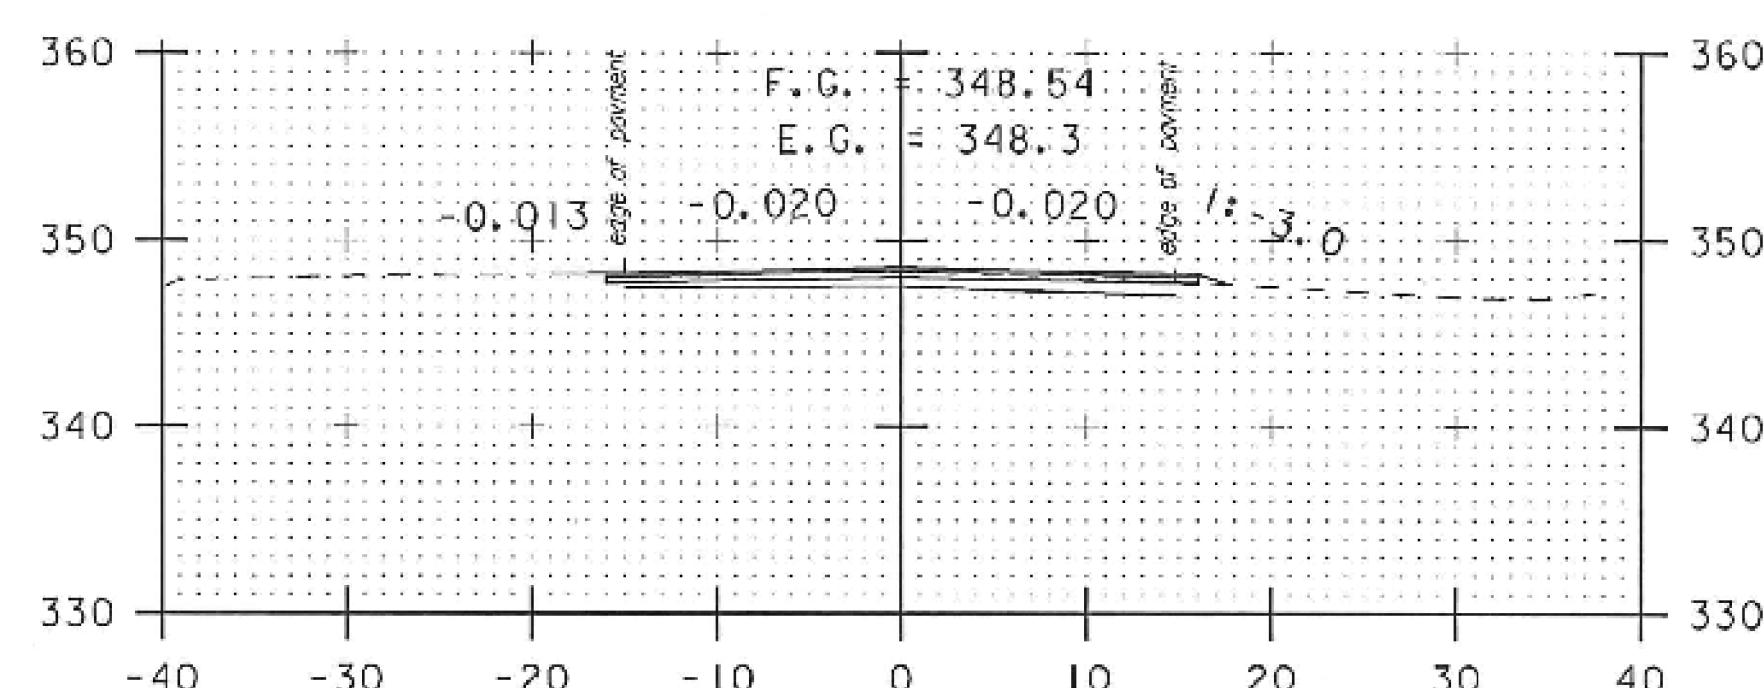

DRIVE LT
135+50

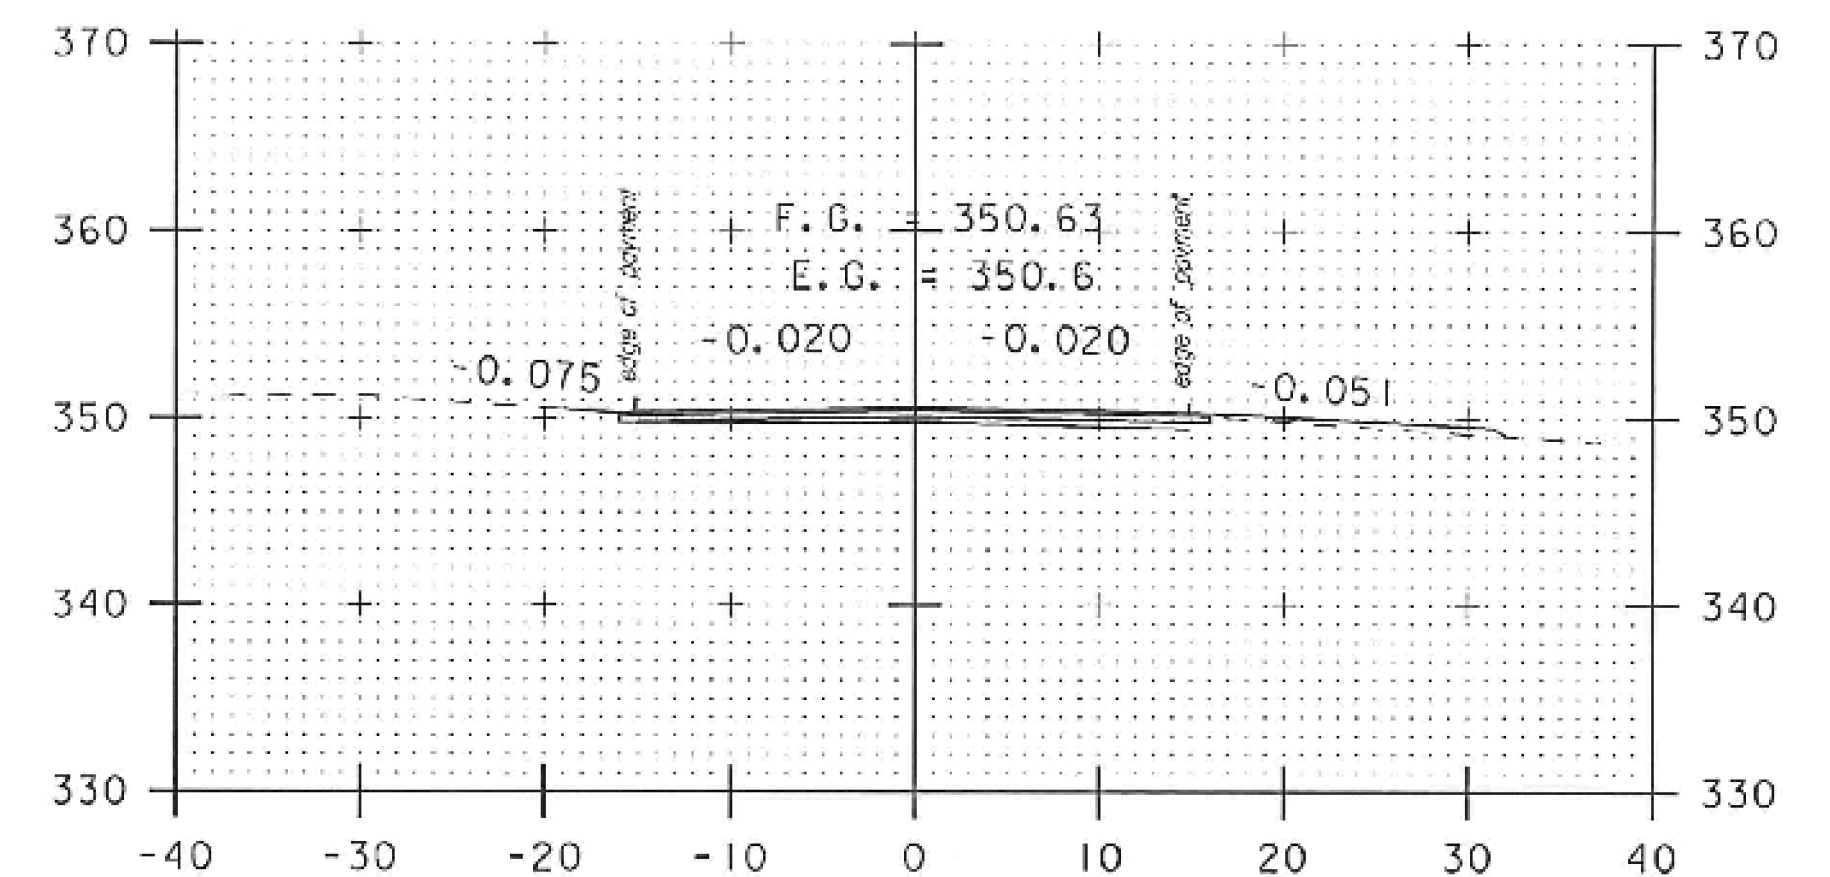

DRIVE LT / TH#18 RT
137+00

STA. 134+00 TO STA. 137+50

SCALE 1" = 10'-0"
10 0 10

CROSS SECTION SHEET 9

PROJECT NAME: BOLTON-WATERBURY
PROJECT NUMBER: STP 2709(I)

FILE NAME: x07CI72.dgn
PROJECT LEADER: CDL
DESIGNED BY: BMB
PLOT FILE: x07CI72.I35.I

PLOT DATE: 04/17/2013
DRAWN BY: BMB
CHECKED BY: CDL
SHEET 135R OF 217