




139+00

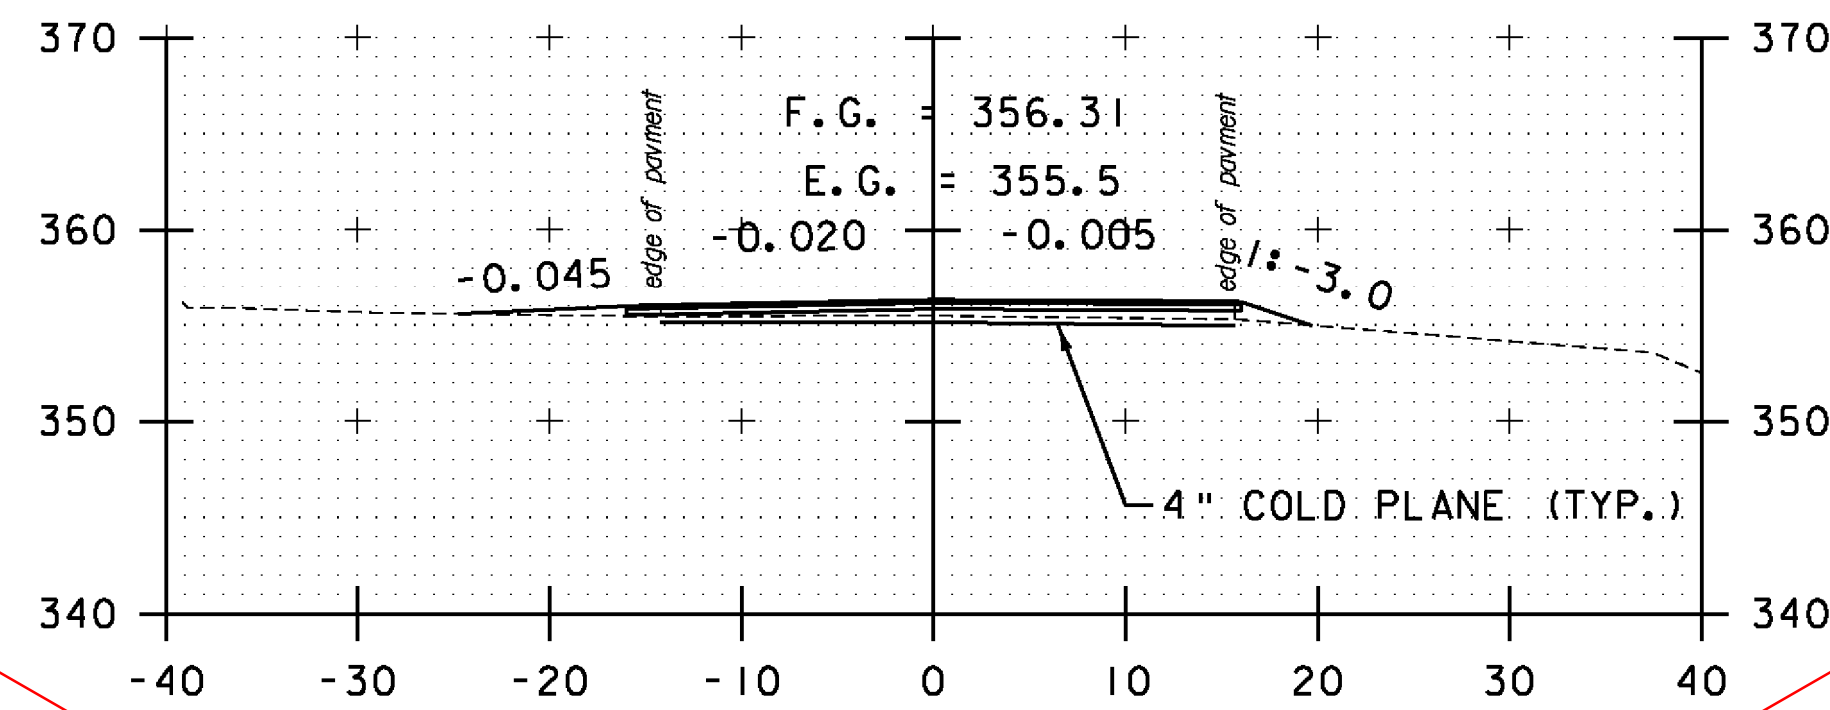


DRIVE LT  
140+50

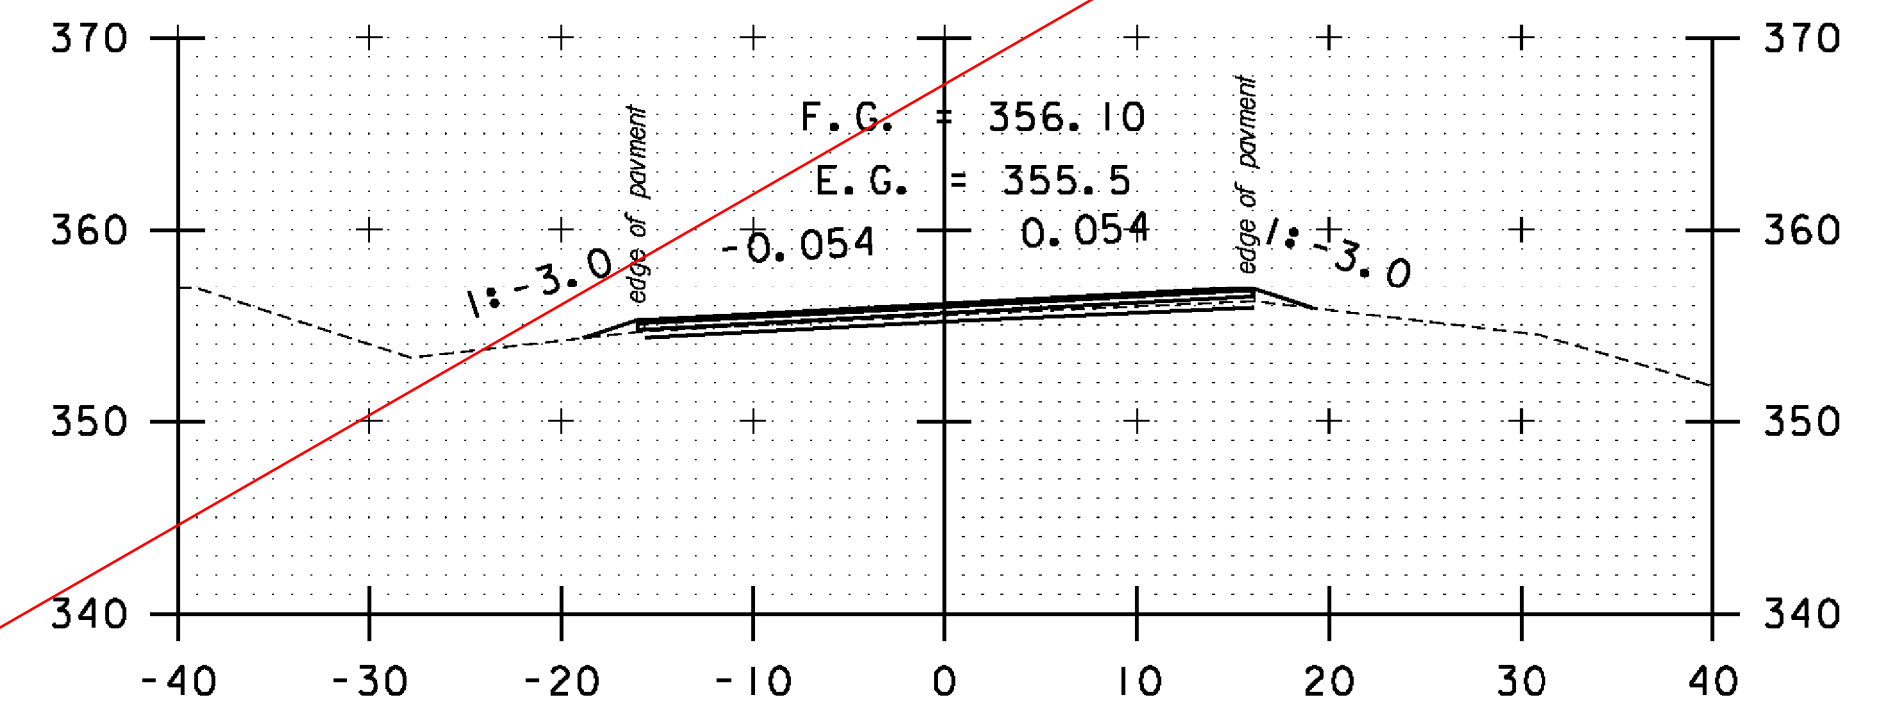


142+00

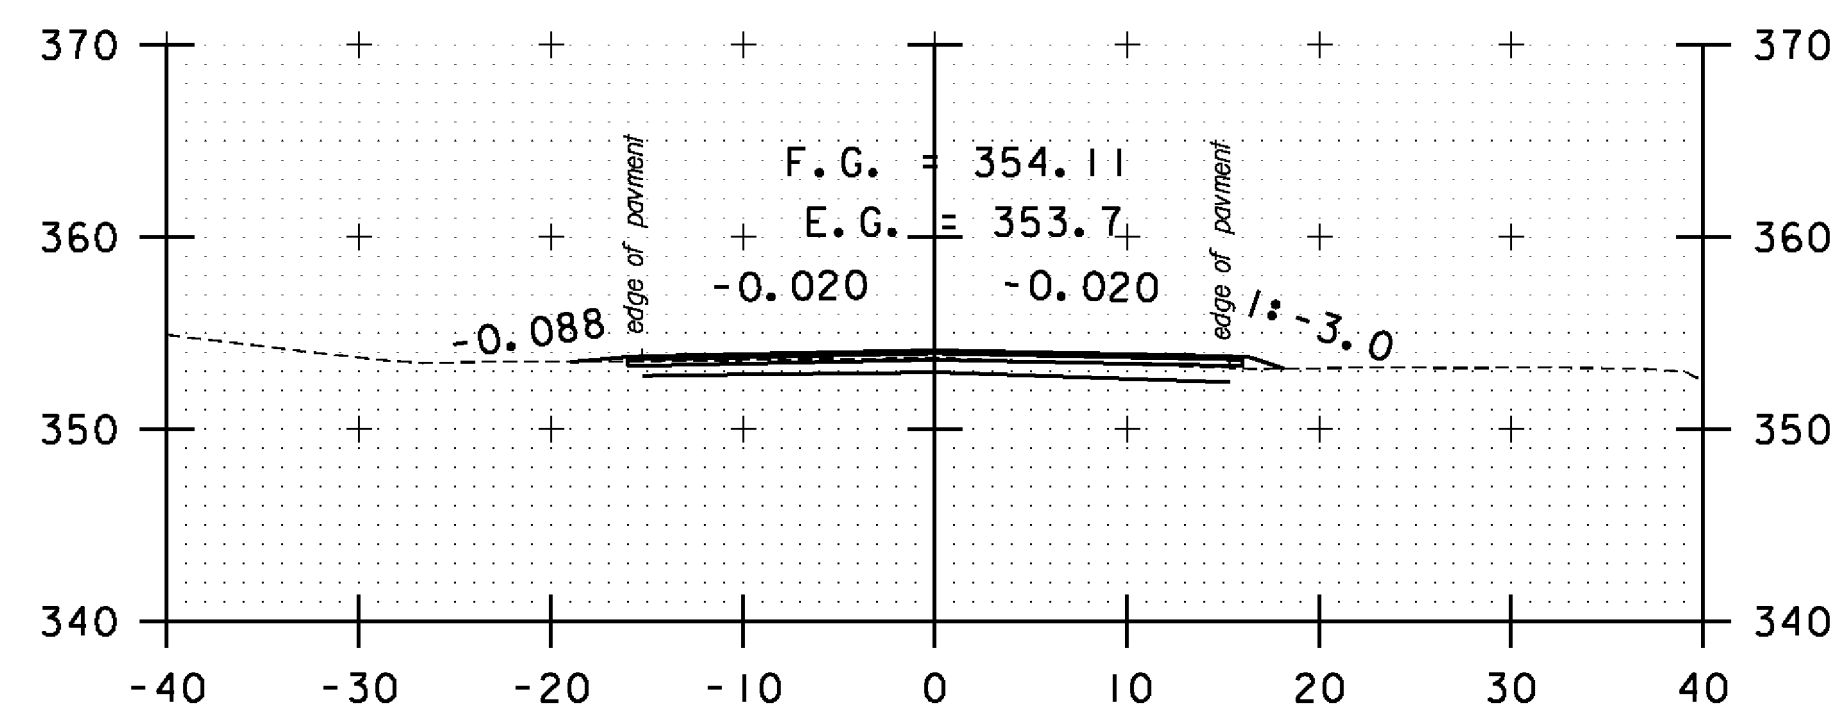


DRIVE LT / DRIVE RT  
138+50

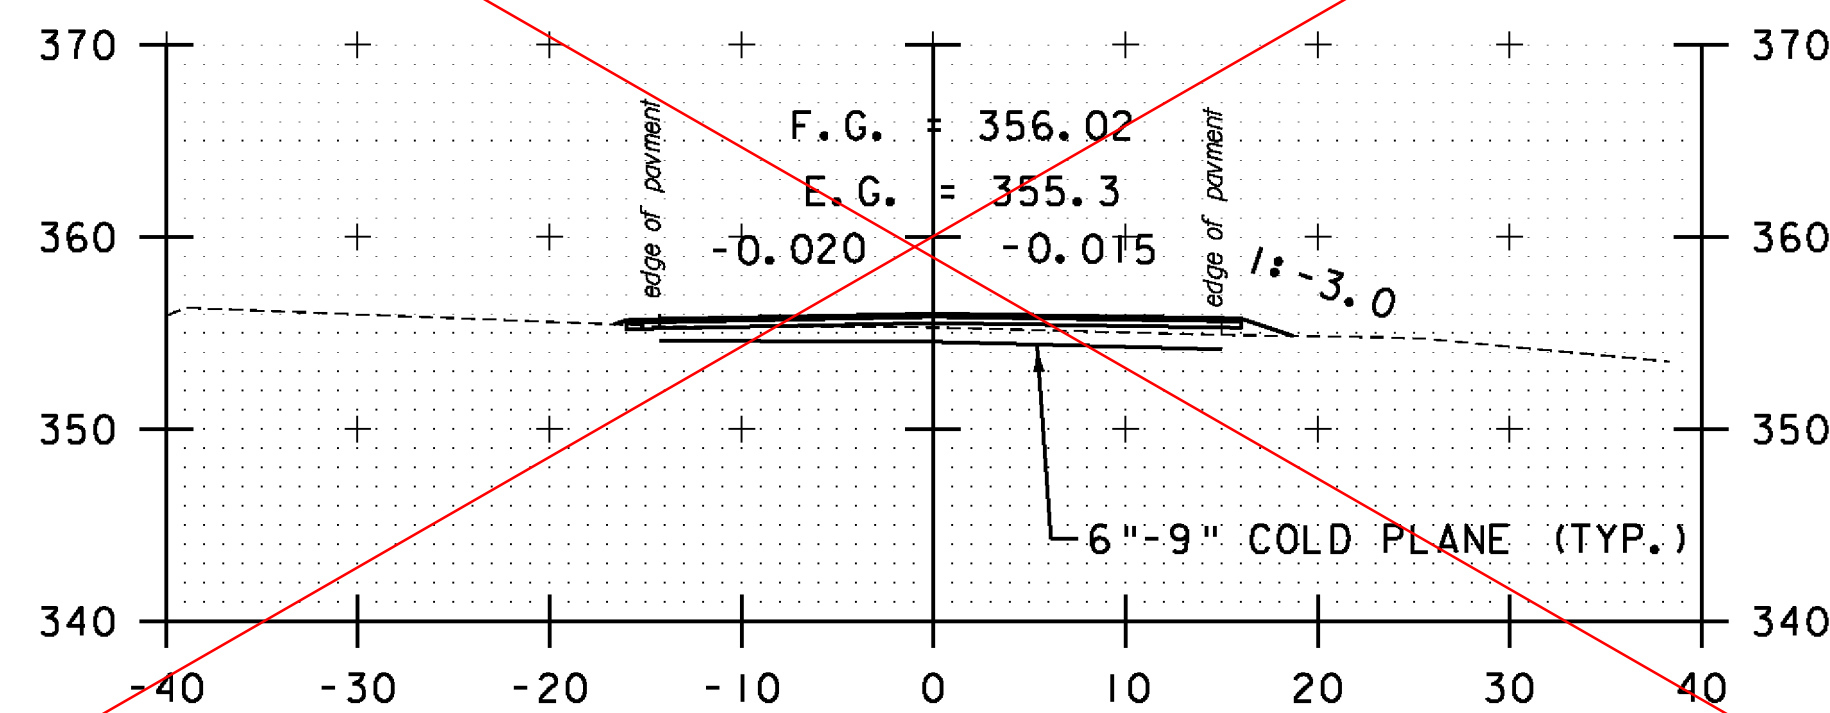


140+00

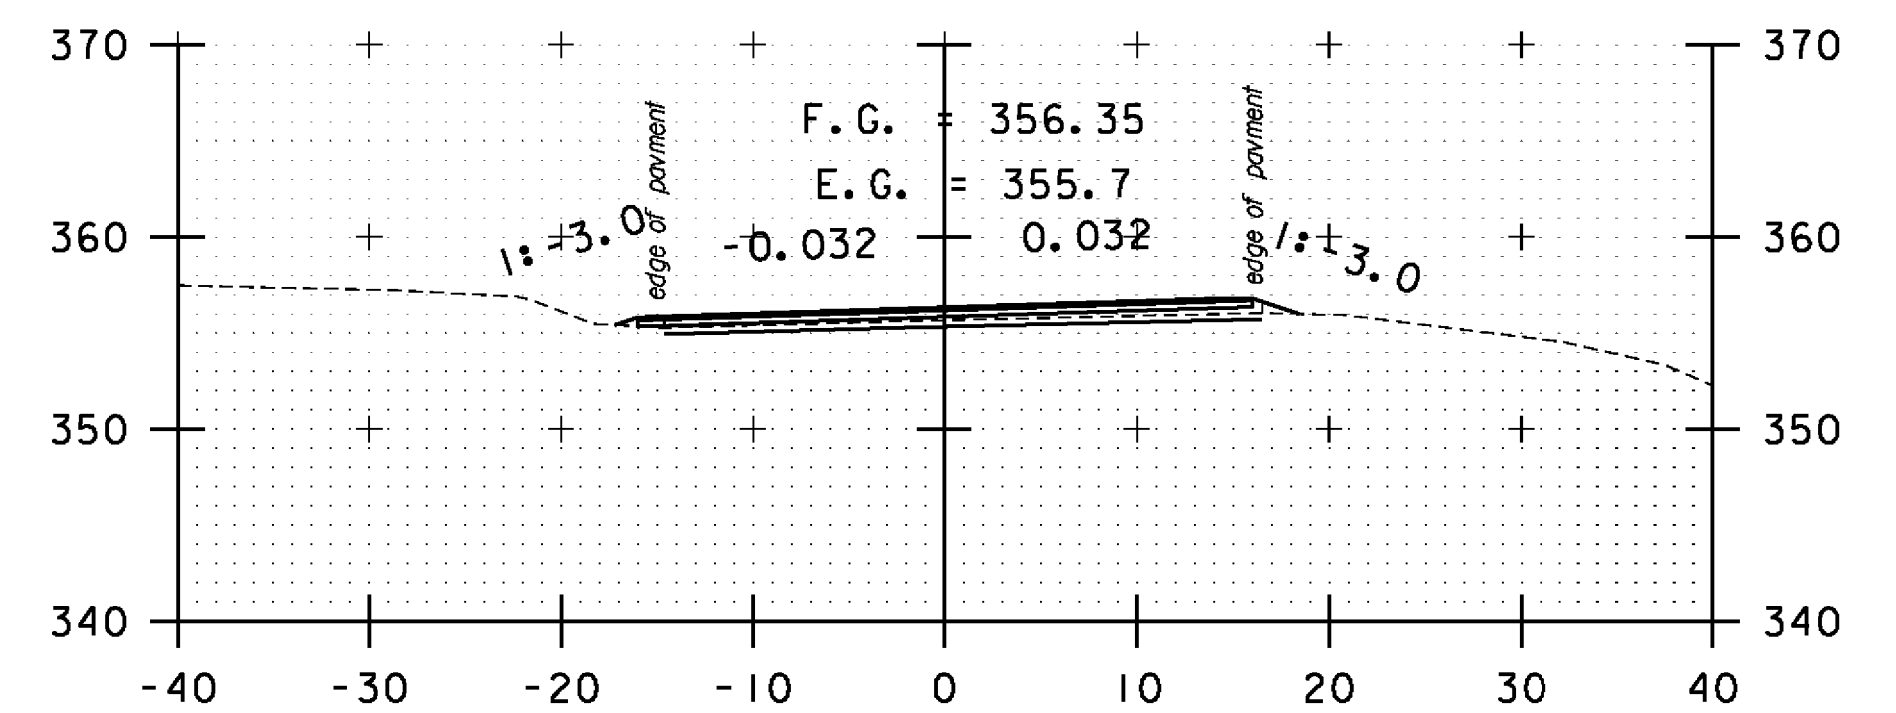


141+50

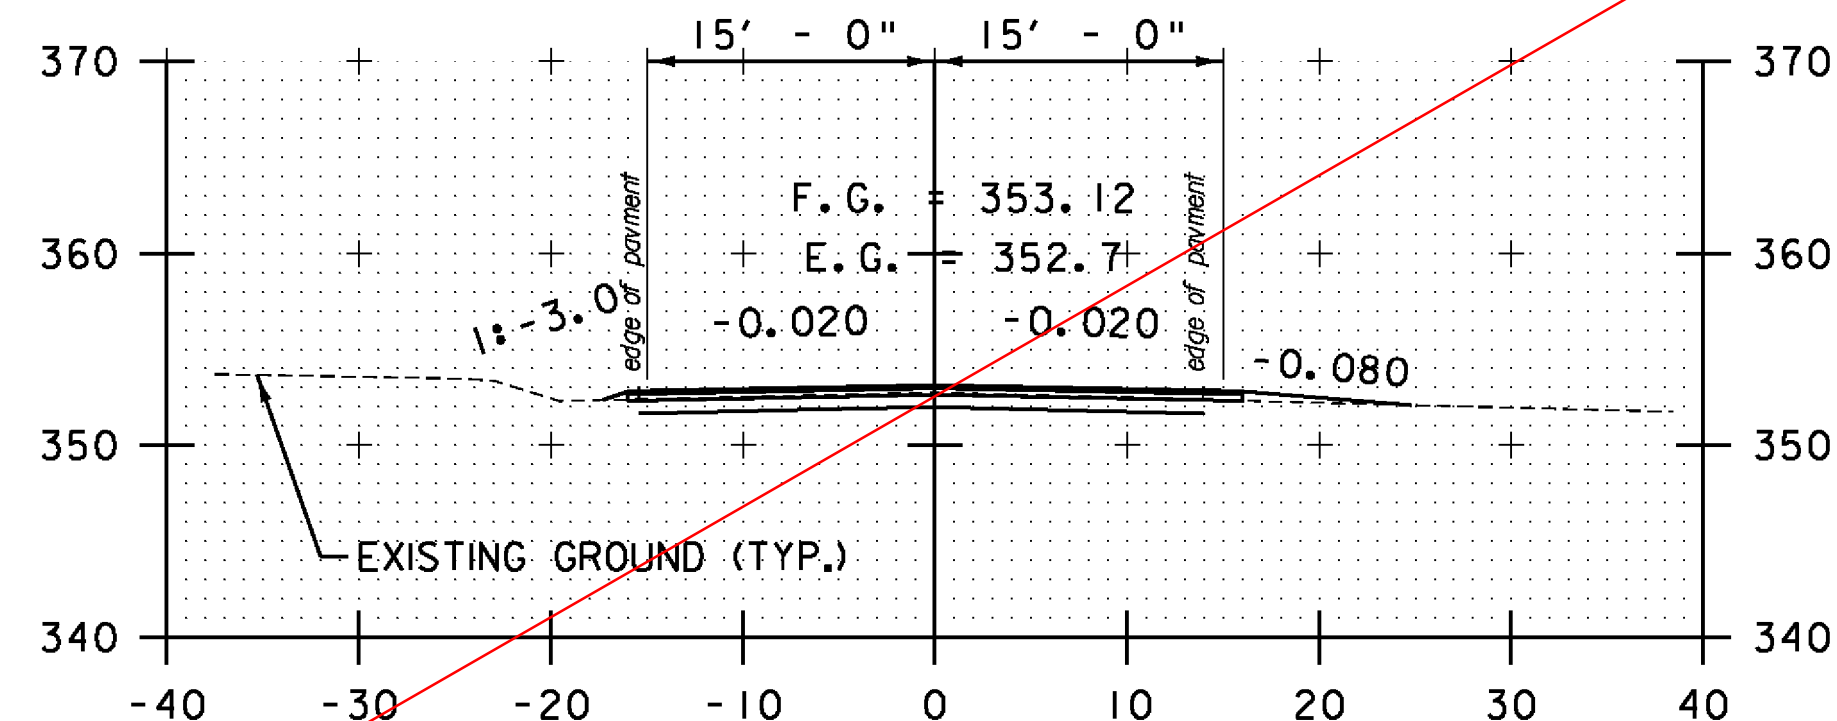

DRIVE RT  
138+00

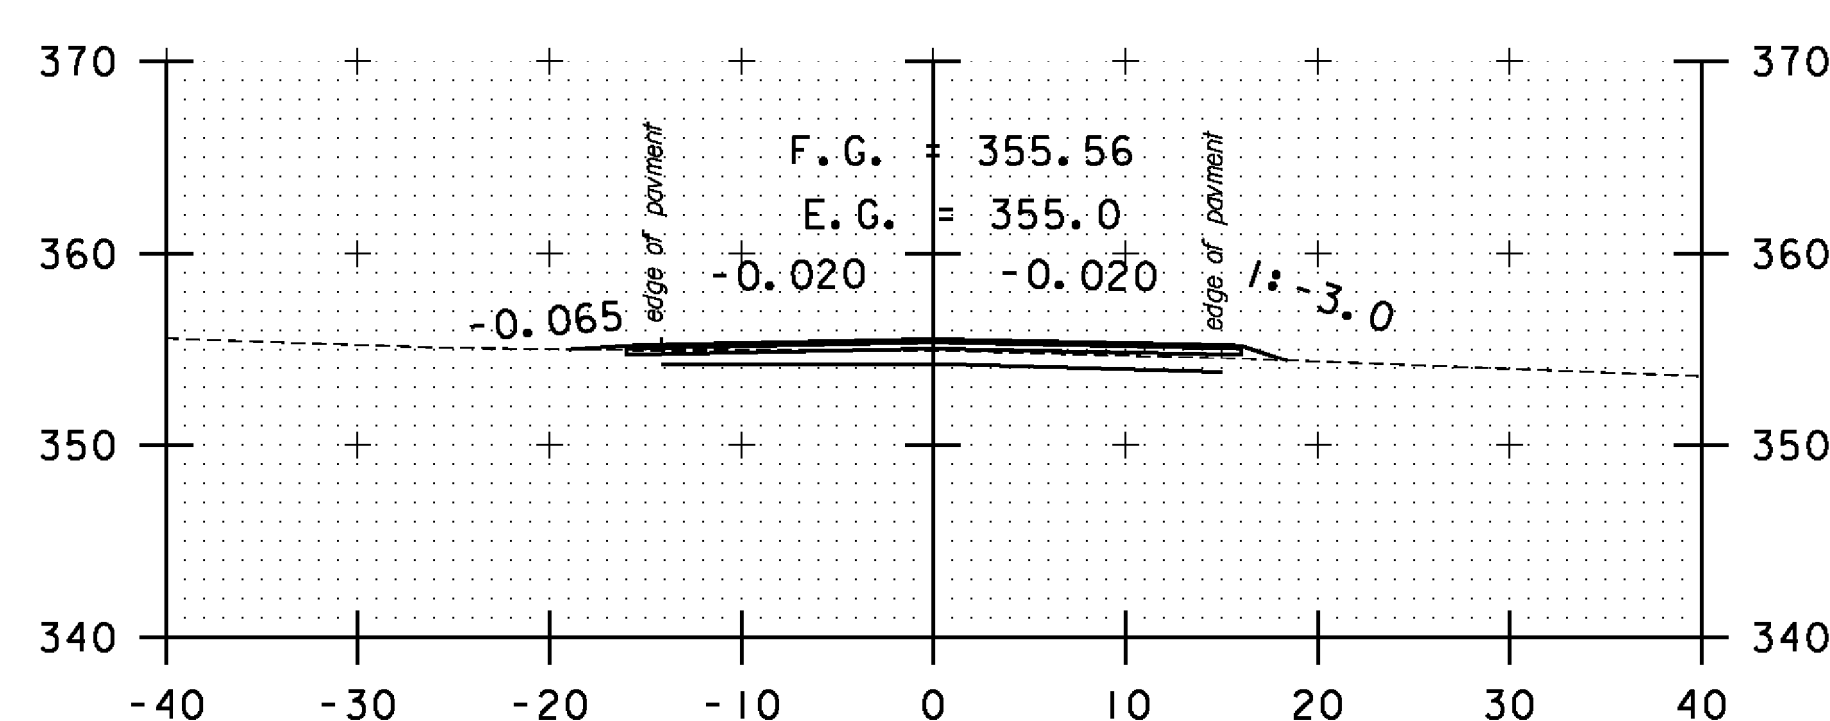

DRIVE LT  
139+50

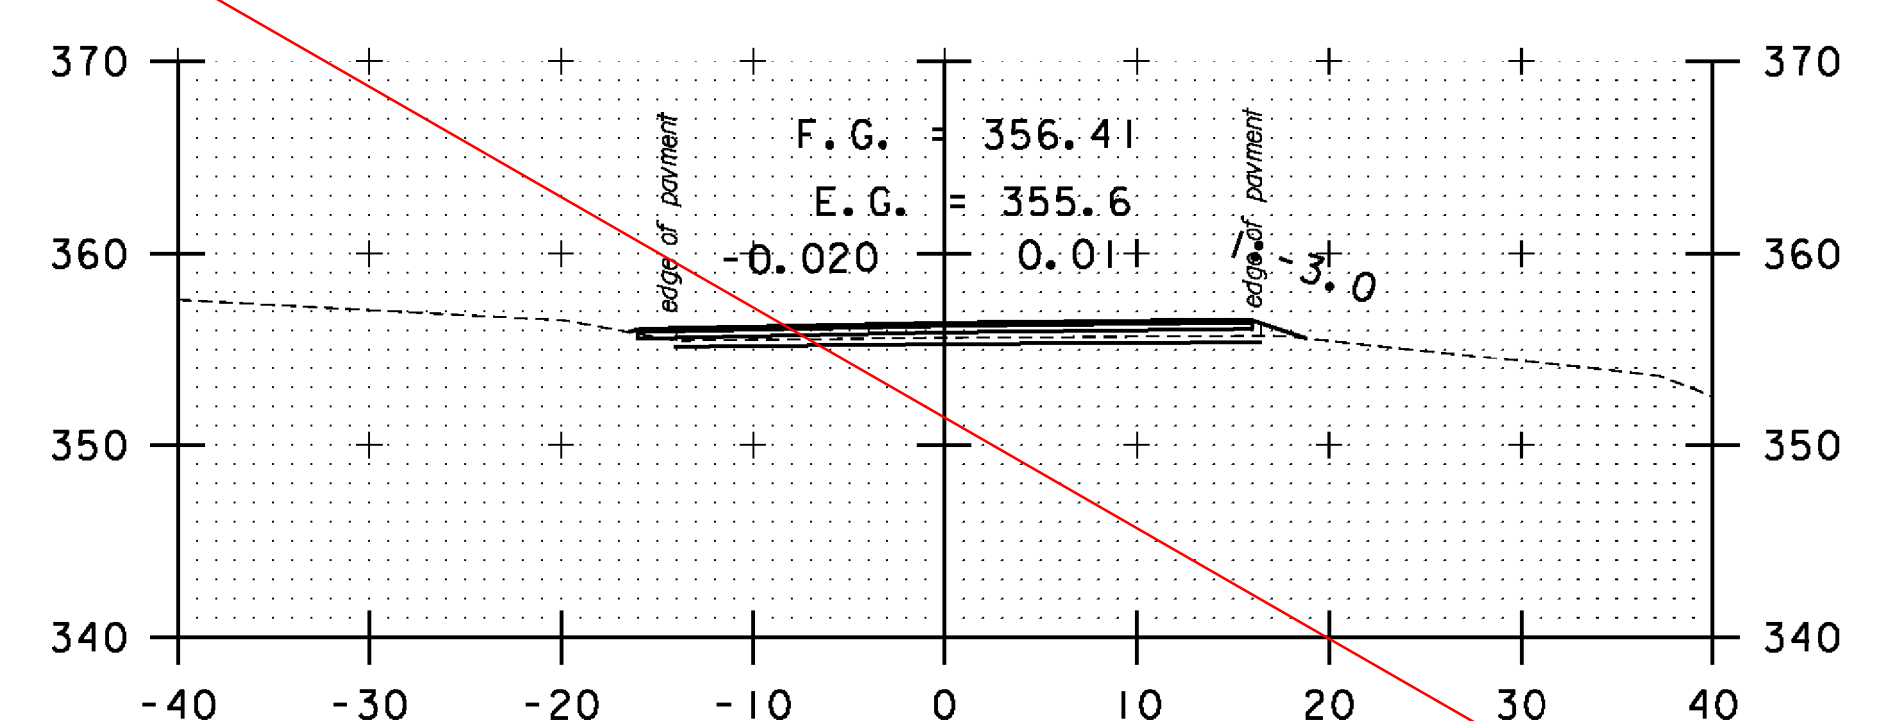

141+00

SEE SHEETS I35R - I138R  
FOR REVISED CROSS SECTIONS

STA. 138+00 TO STA. 142+00



**CROSS SECTION SHEET 10**

PROJECT NAME: BOLTON-WATERBURY	PLOT DATE: 4/16/2013
PROJECT NUMBER: STP 2709(I)	DRAWN BY: BMB
FILE NAME: p07C172.dgn	CHECKED BY: CDL
PROJECT LEADER: CDL	SHEET 136 OF 217
DESIGNED BY: BMB	
PLOT FILE: p07C172-136.1	