


142+50

144+00

145+50

SEE SHEETS I35R - I138R
FOR REVISED CROSS SECTIONS

STA. 142+50 TO STA. 146+50

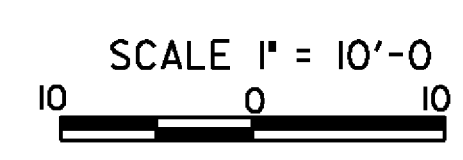

CROSS SECTION SHEET 11	PROJECT NAME: BOLTON-WATERBURY	PLOT DATE: 4/16/2013
	PROJECT NUMBER: STP 2709(I)	DRAWN BY: BMB
	FILE NAME: p07C172.dgn	CHECKED BY: CDL
	PROJECT LEADER: CDL	SHEET 137 OF 217