




143+50

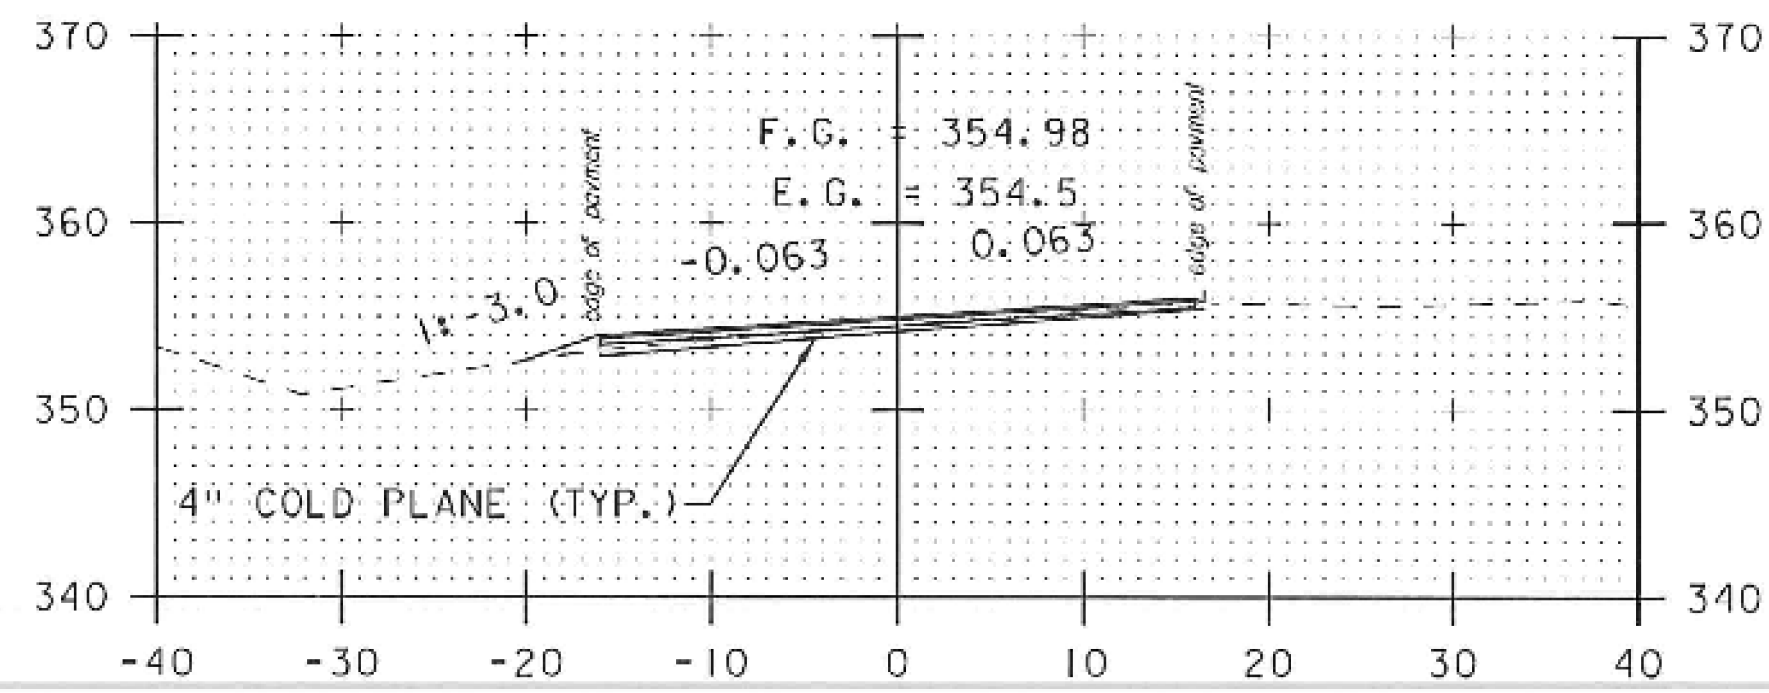


143+00

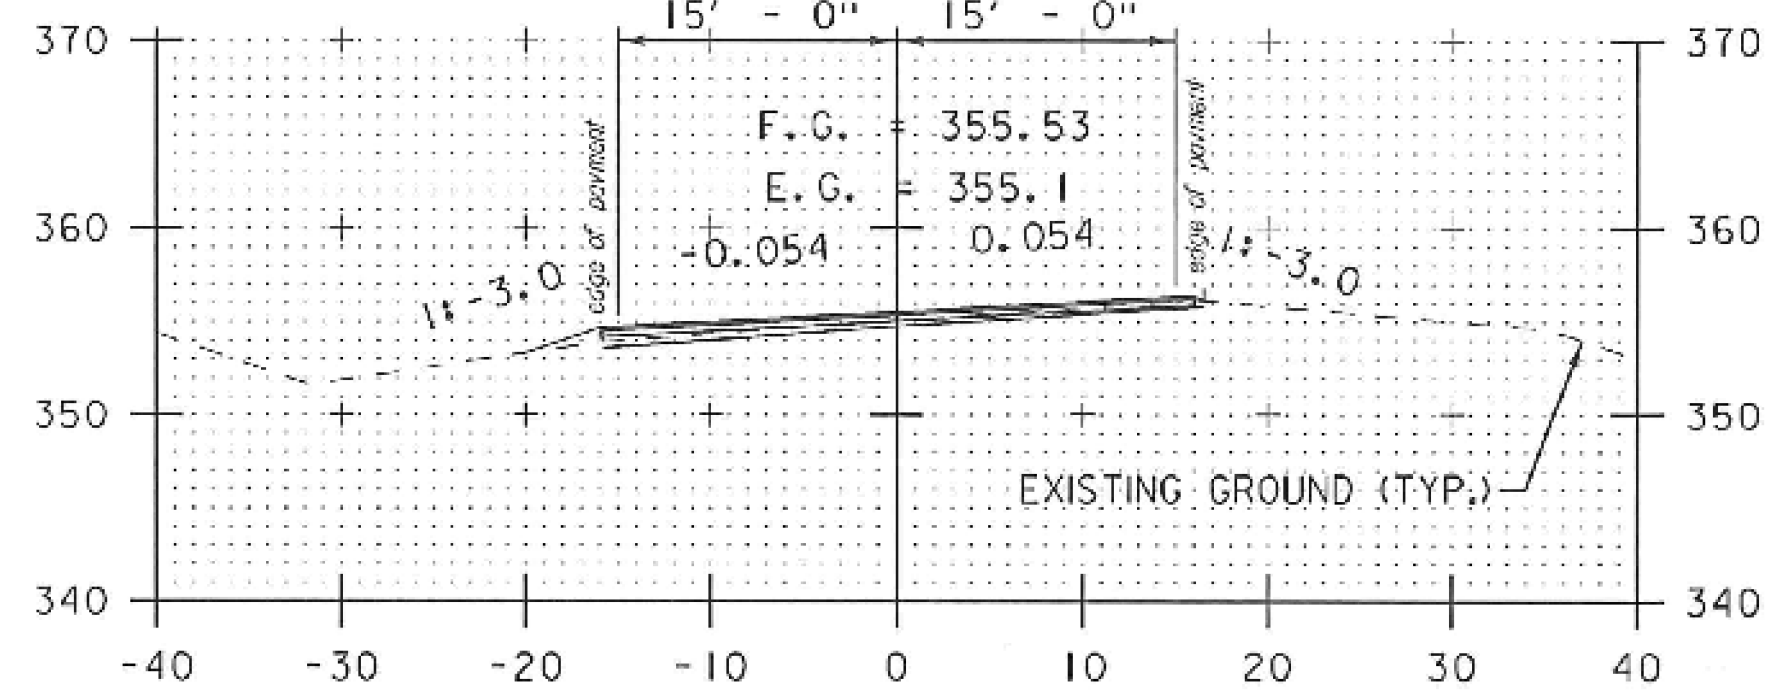


142+50

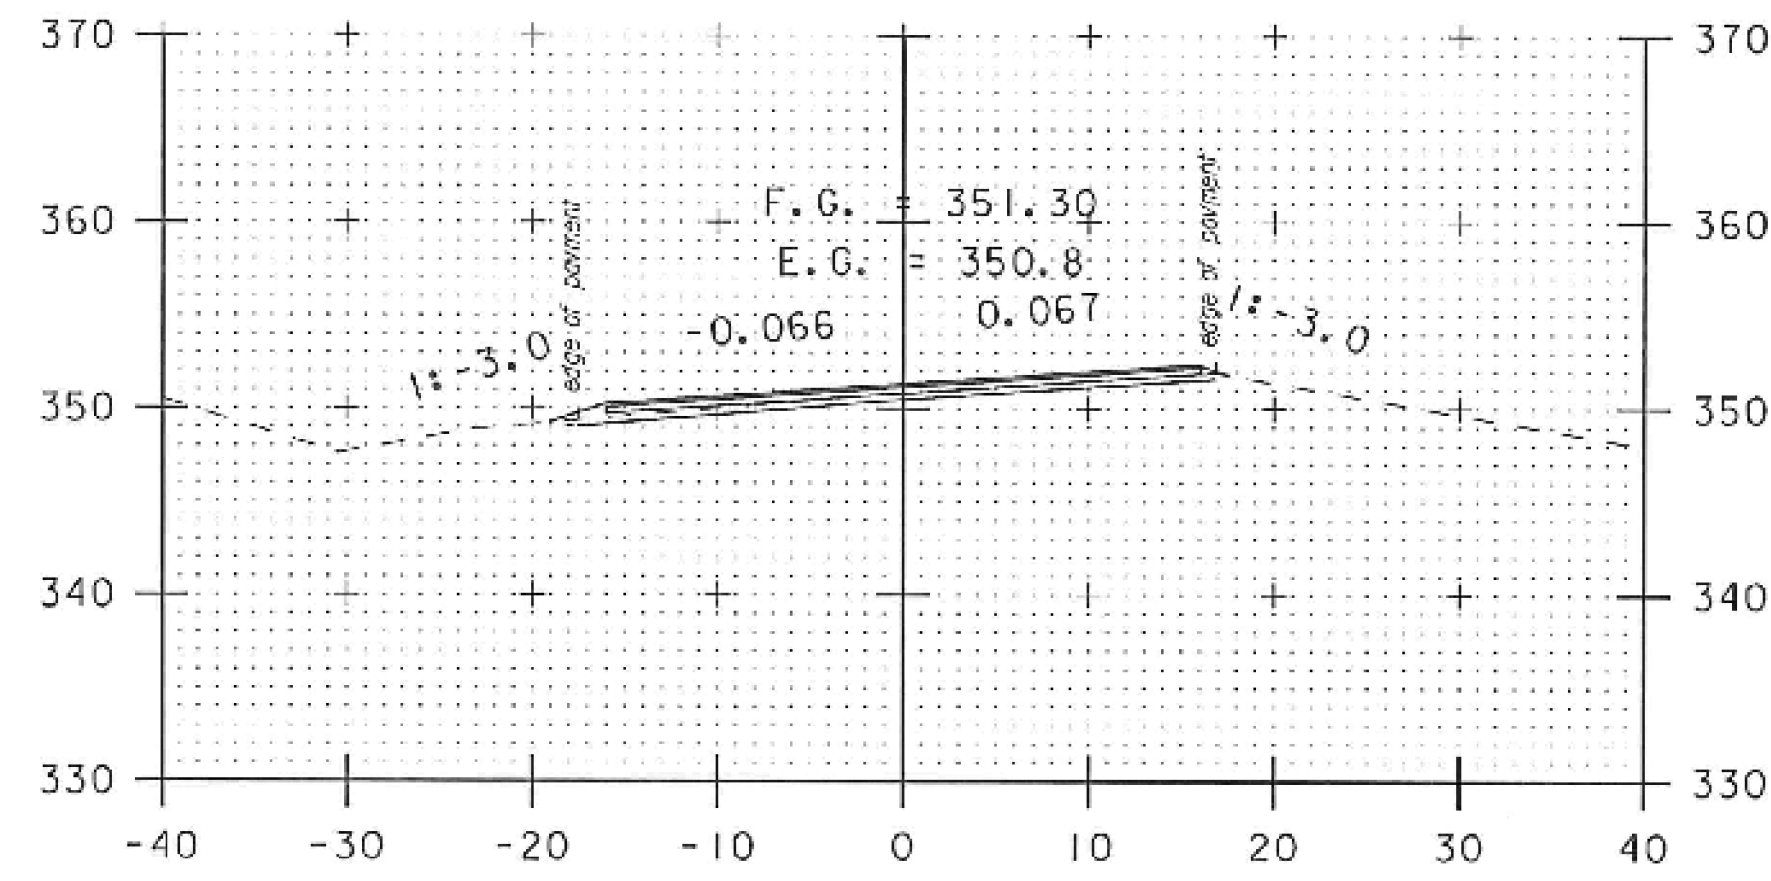


145+00

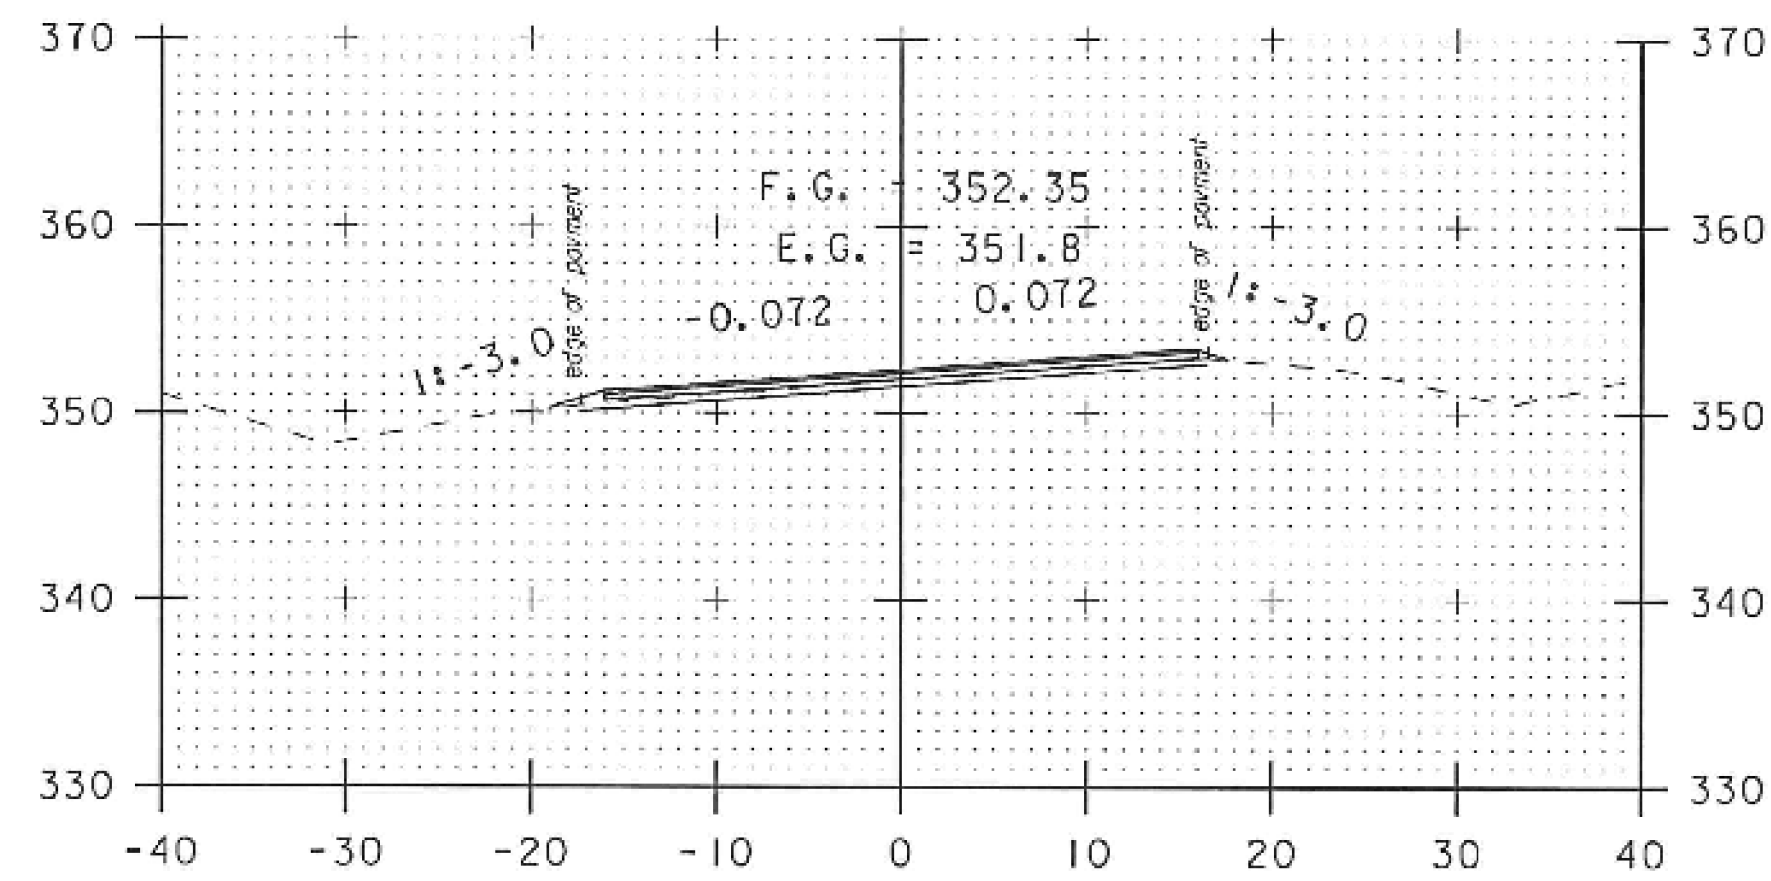


144+50

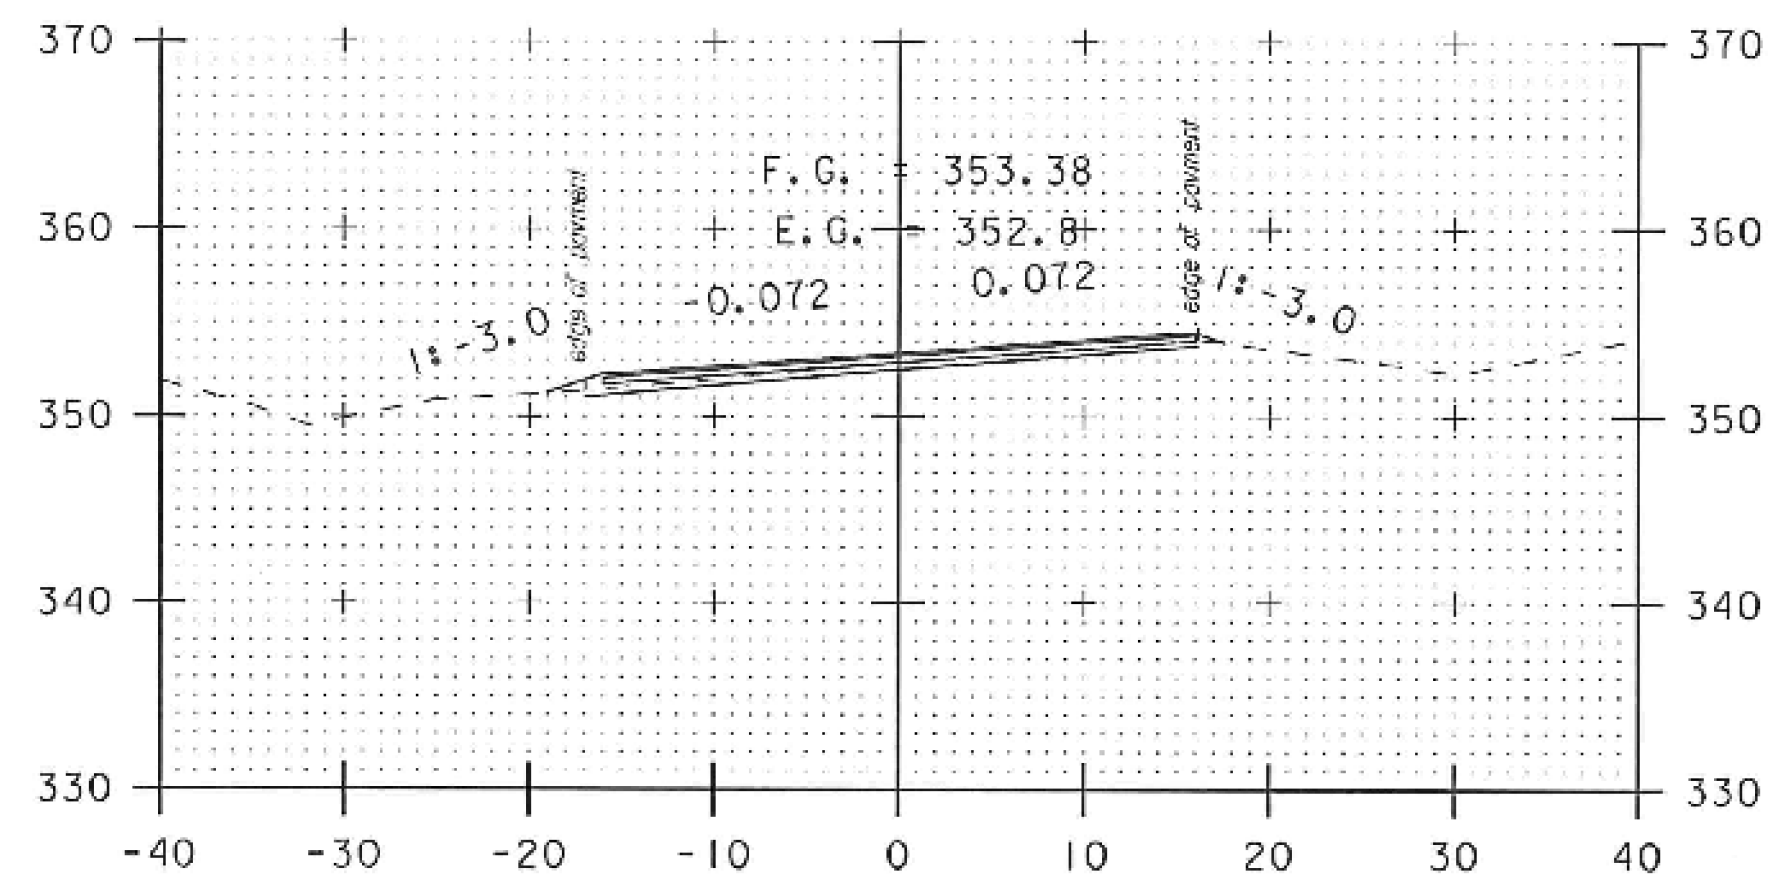


144+00

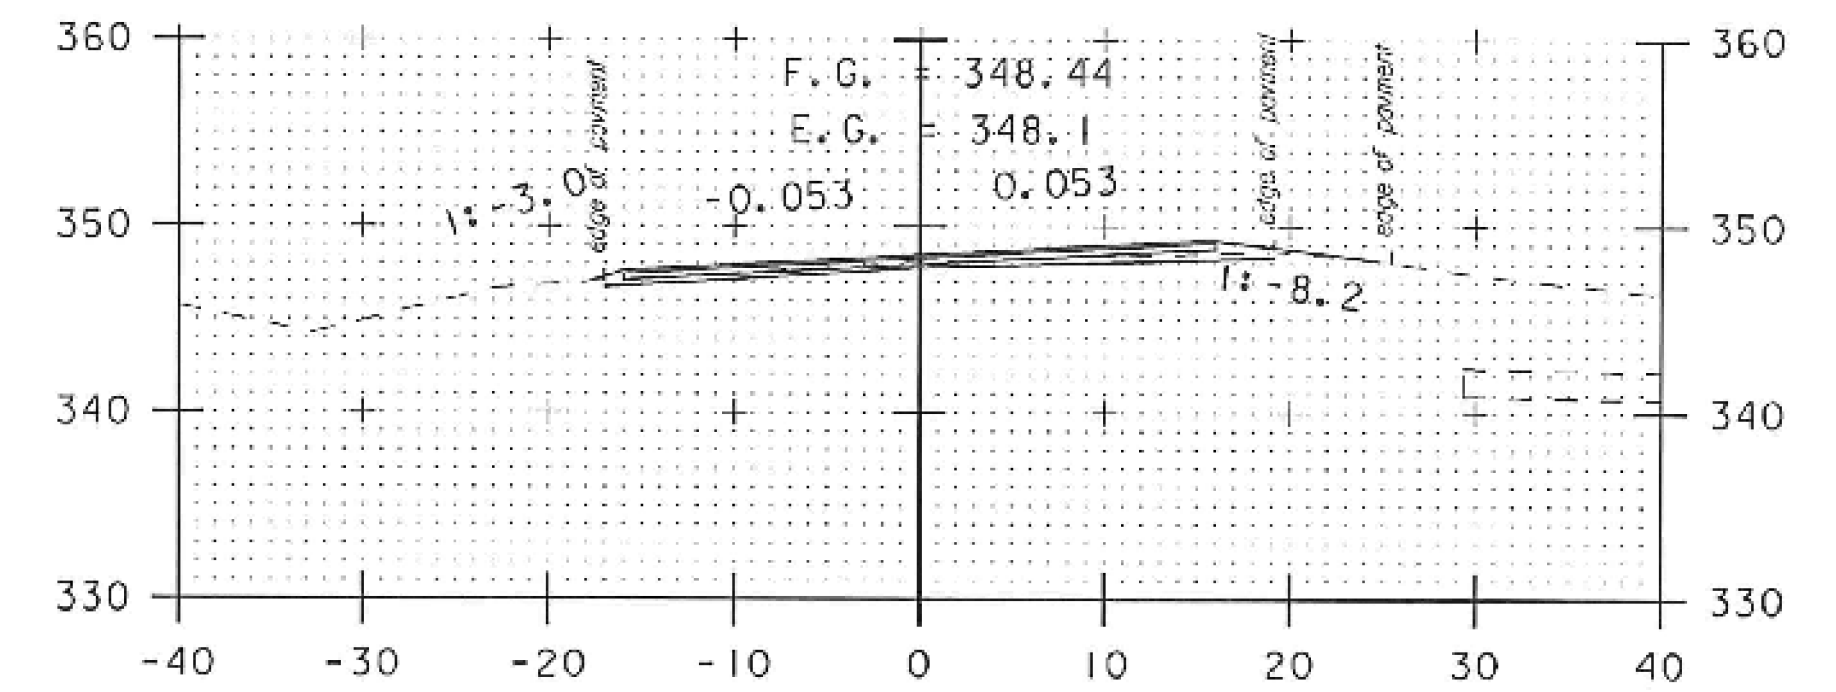

TH#15 RT
146+50

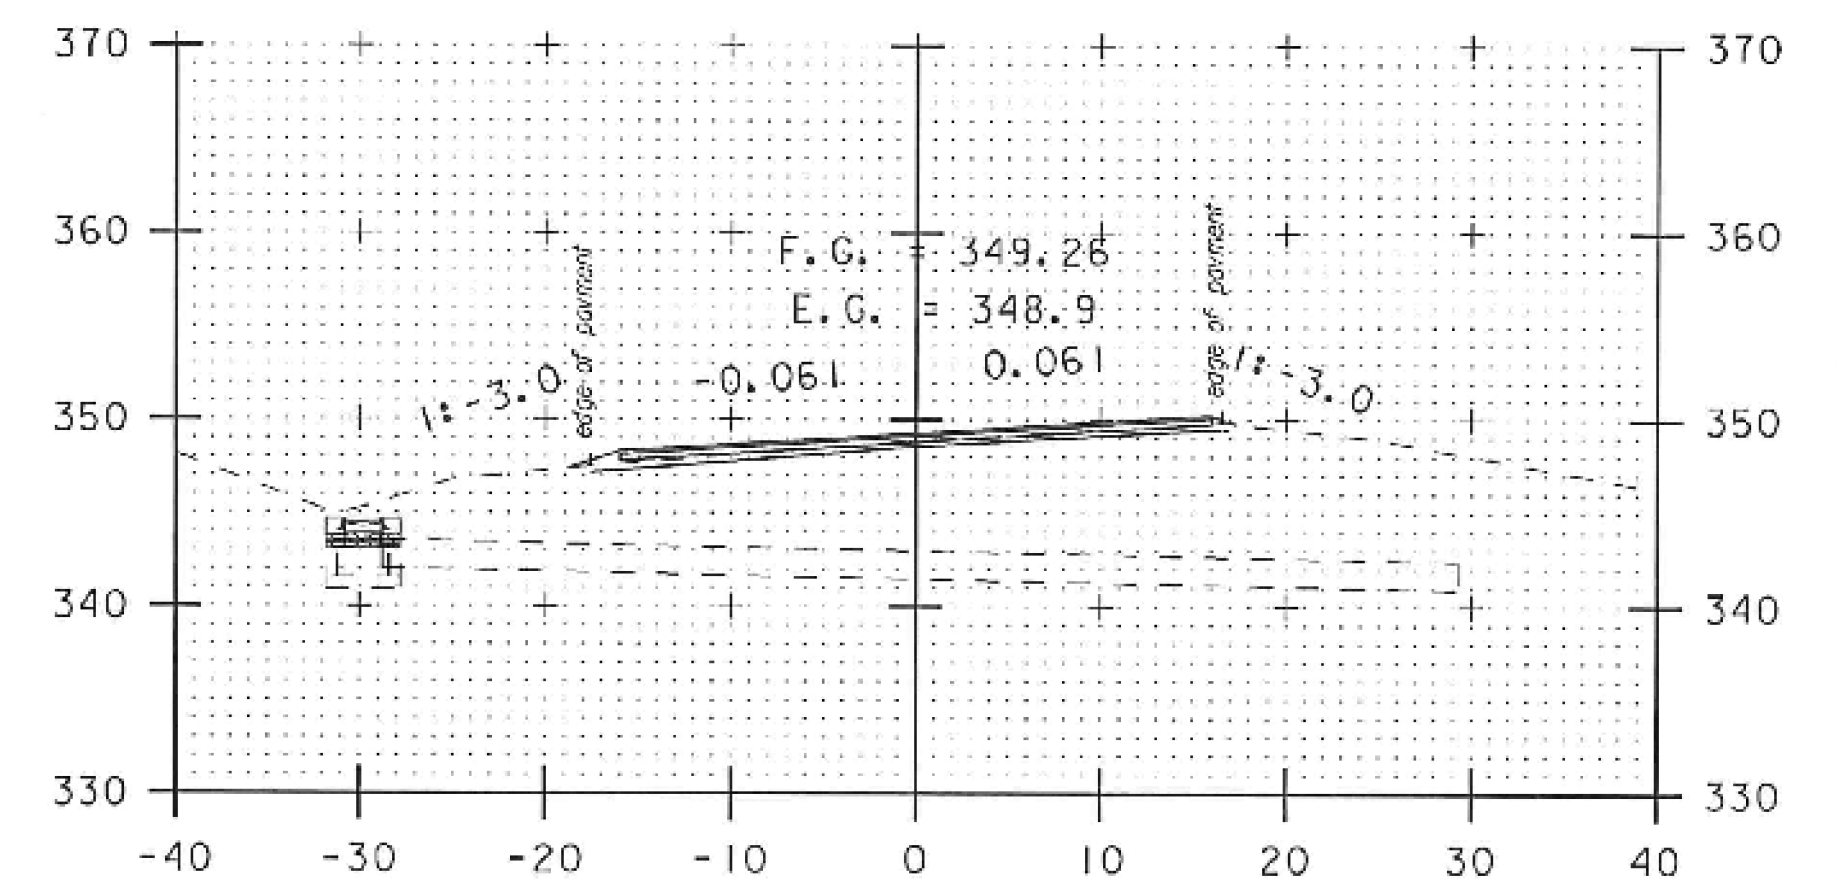

146+00

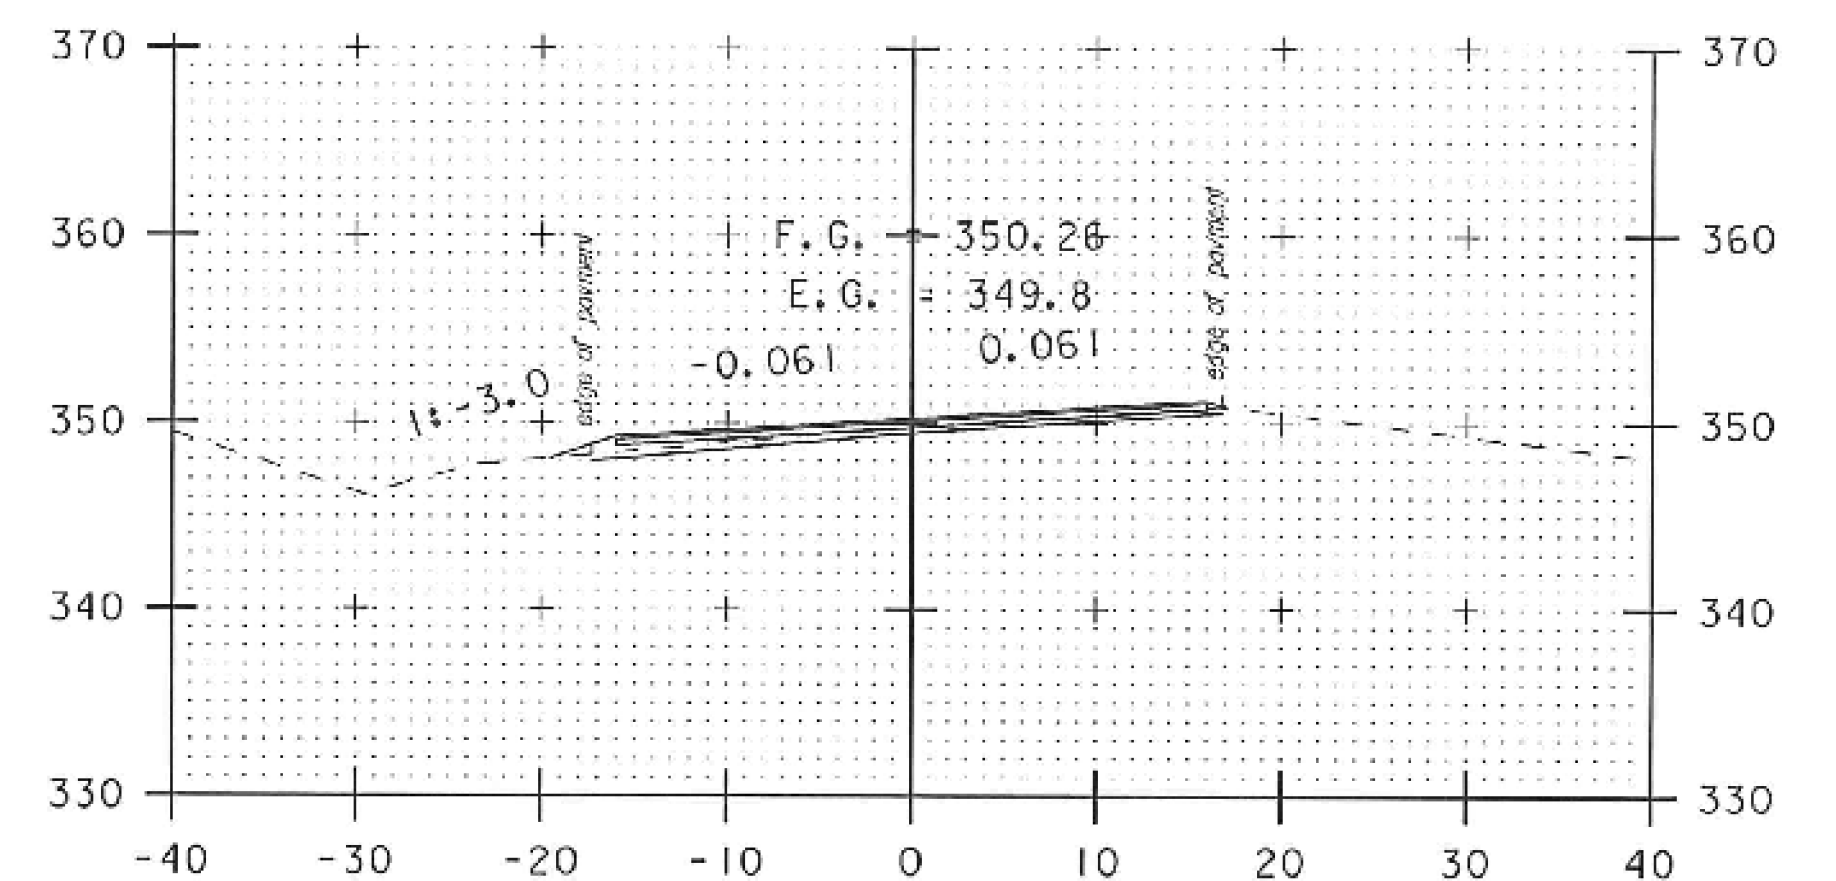

145+50

STA. 142+50 TO STA. 146+50



CROSS SECTION SHEET 11

PROJECT NAME: BOLTON-WATERBURY
PROJECT NUMBER: STP 2709(I)

FILE NAME: x07C172.dgn
PROJECT LEADER: CDL
DESIGNED BY: BMB
PLOT FILE: x07C172.137.1

PLOT DATE: 04/17/2013
DRAWN BY: BMB
CHECKED BY: CDL
SHEET 137R OF 217