




147+50

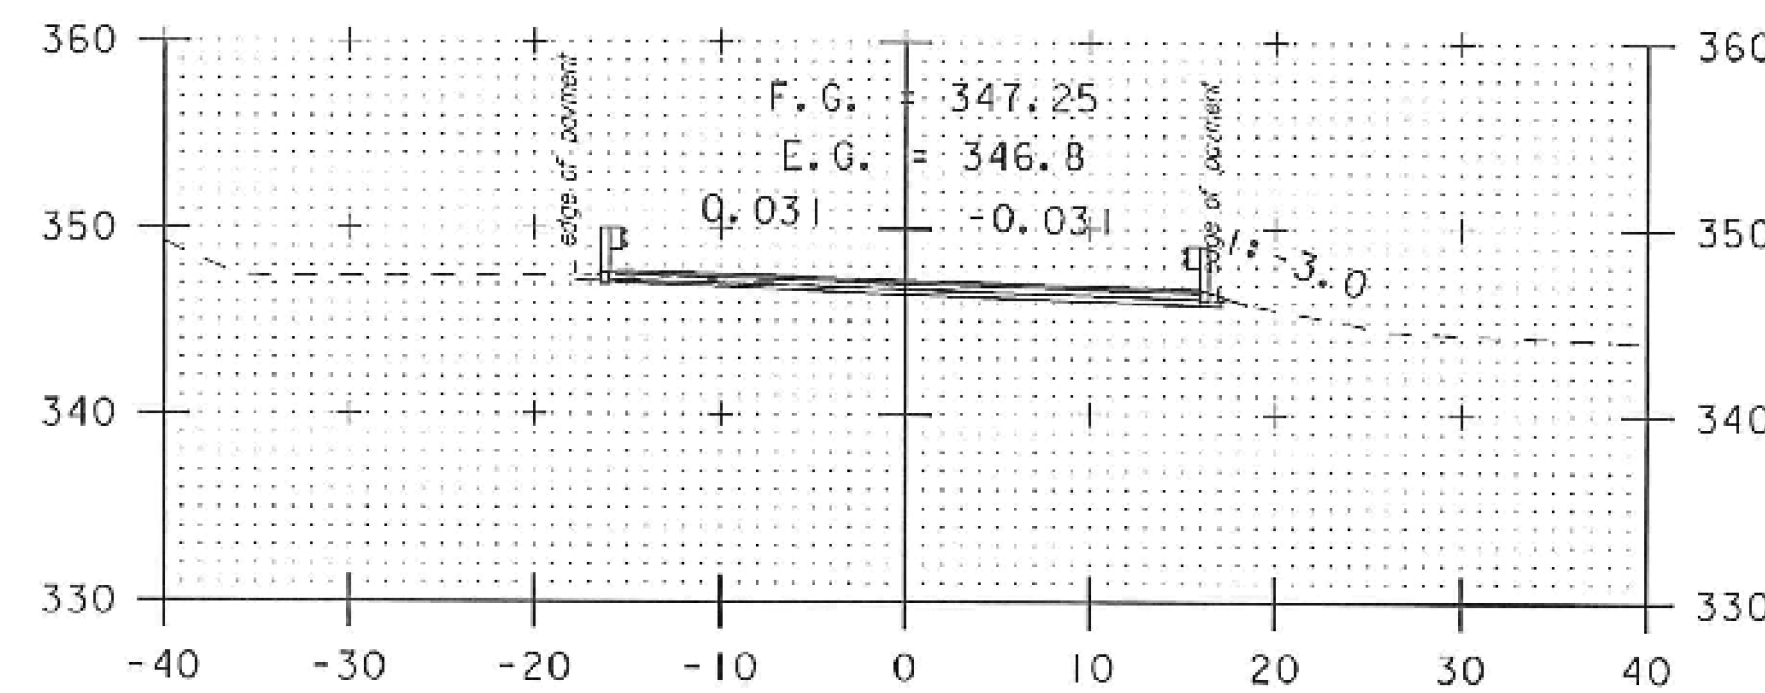


149+00

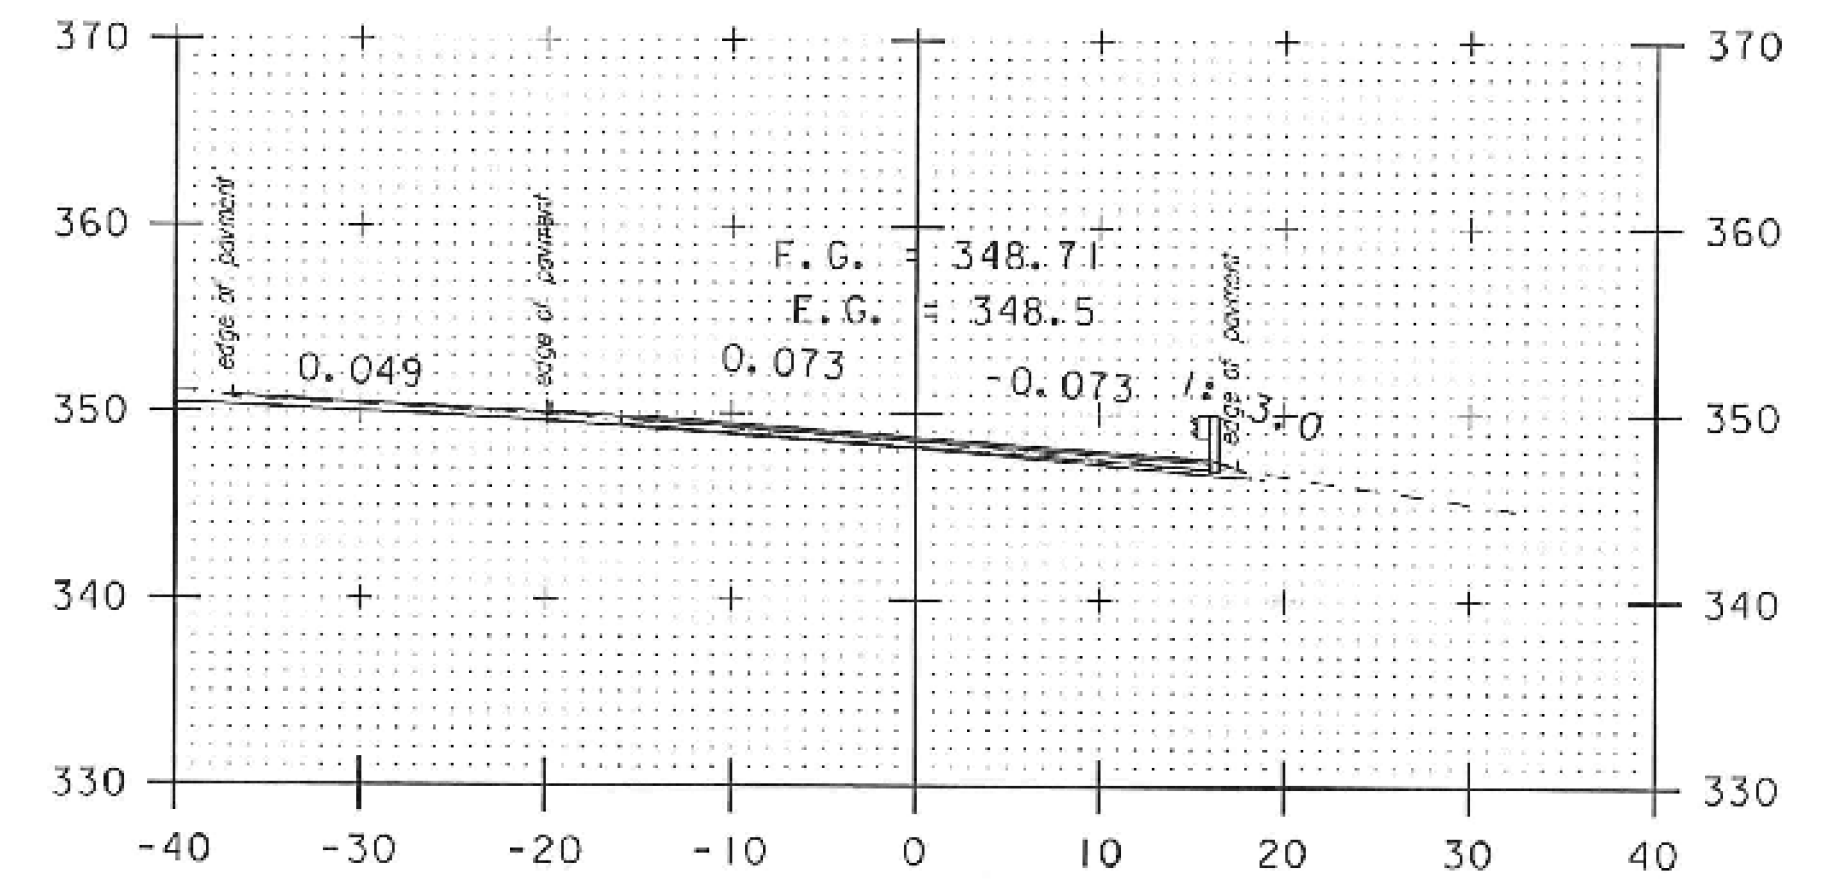


TH#3 LT
150+50

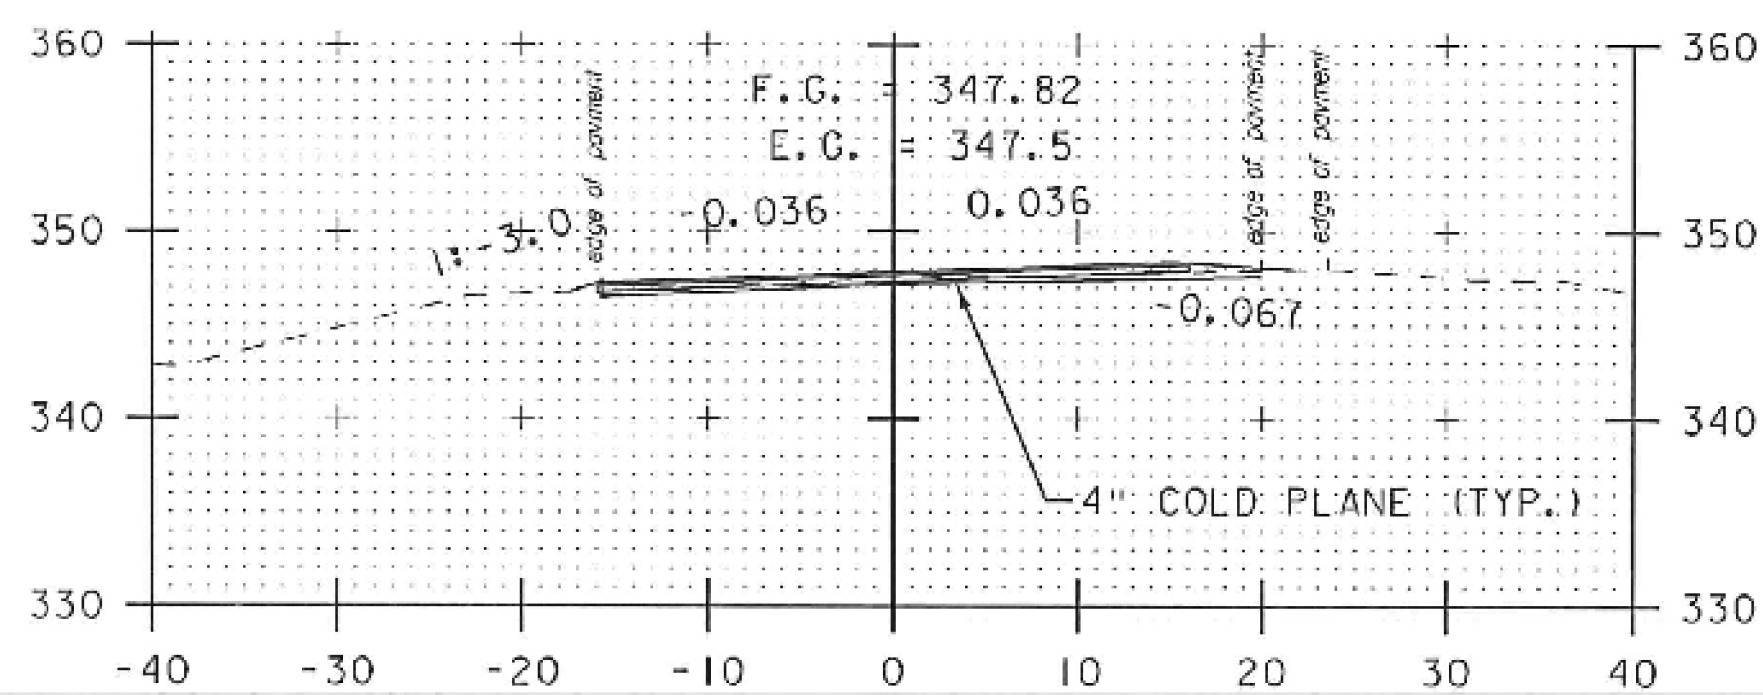


TH#15 RT
147+00

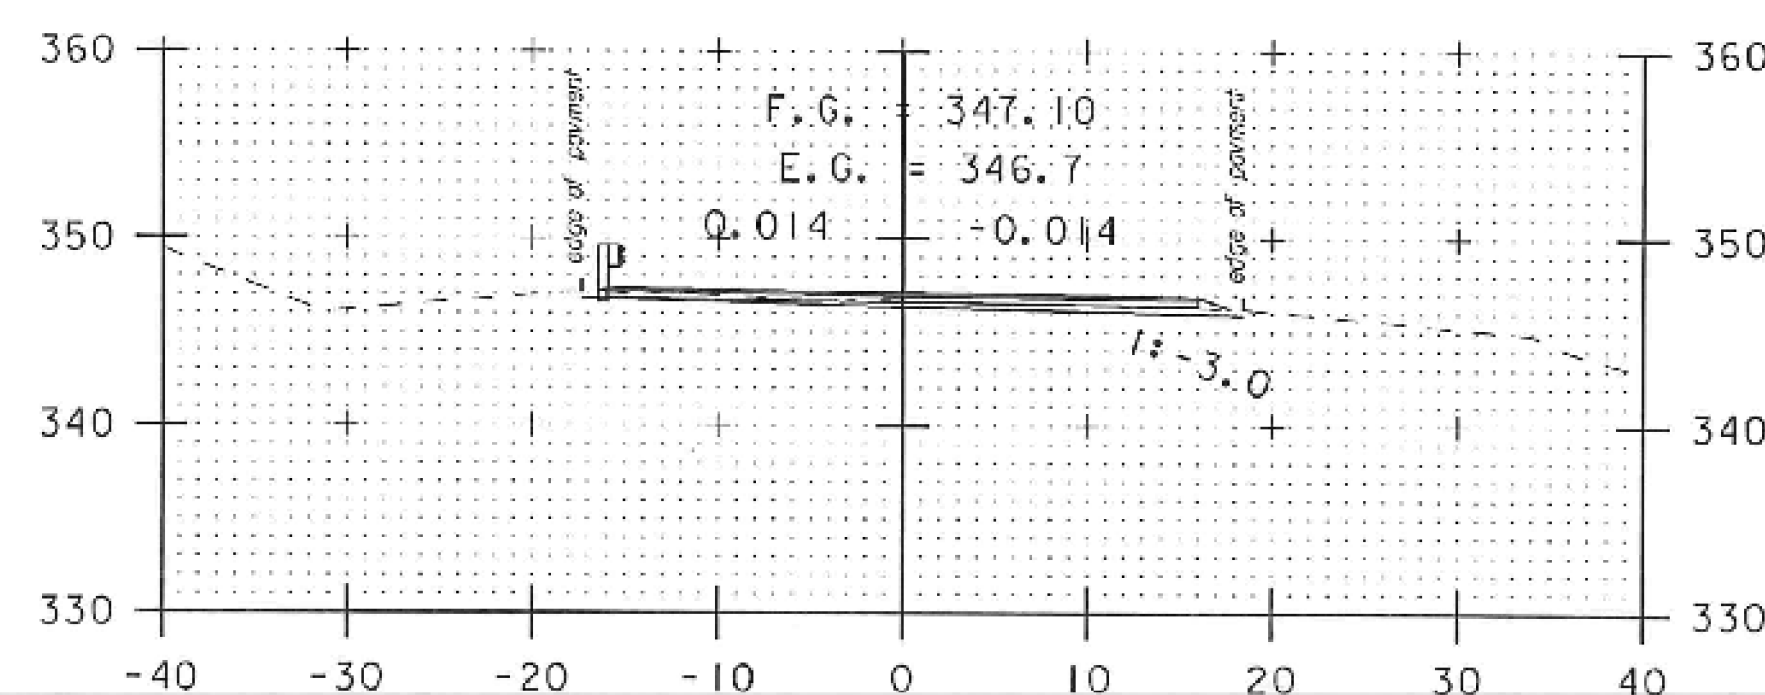


148+50

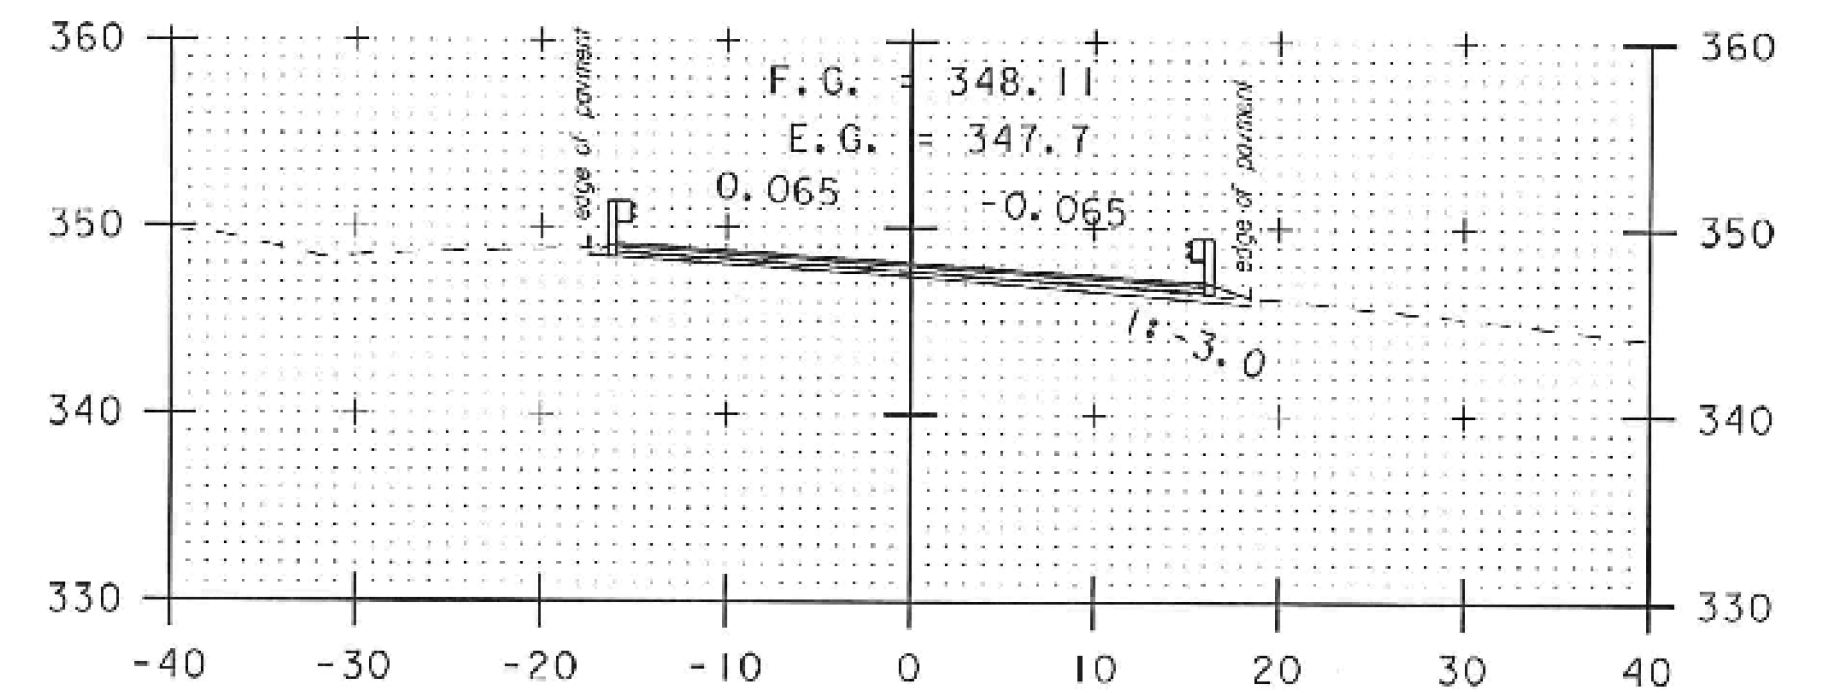


150+00

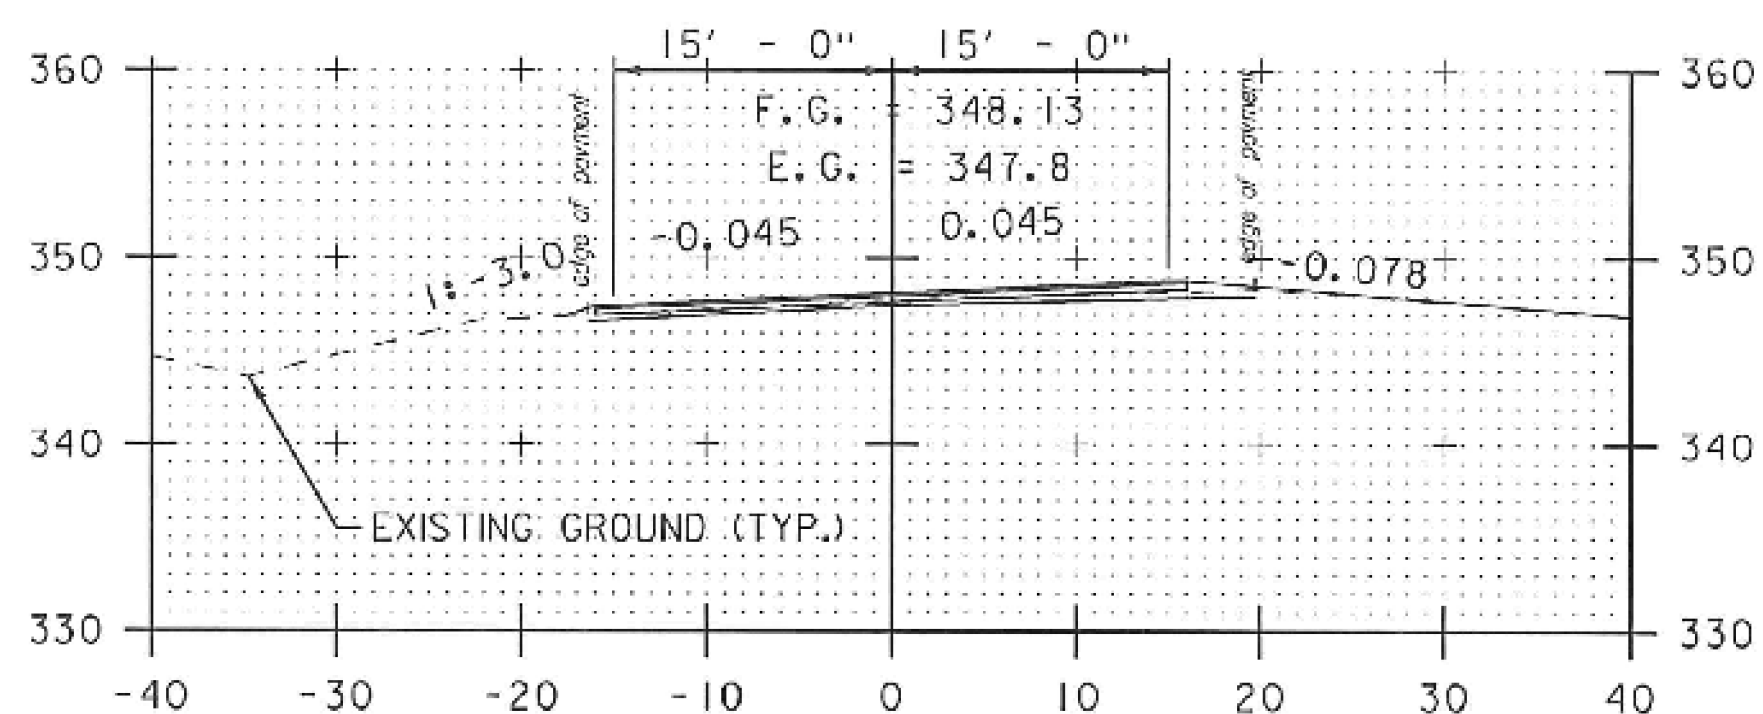

TH#15 RT
146+73

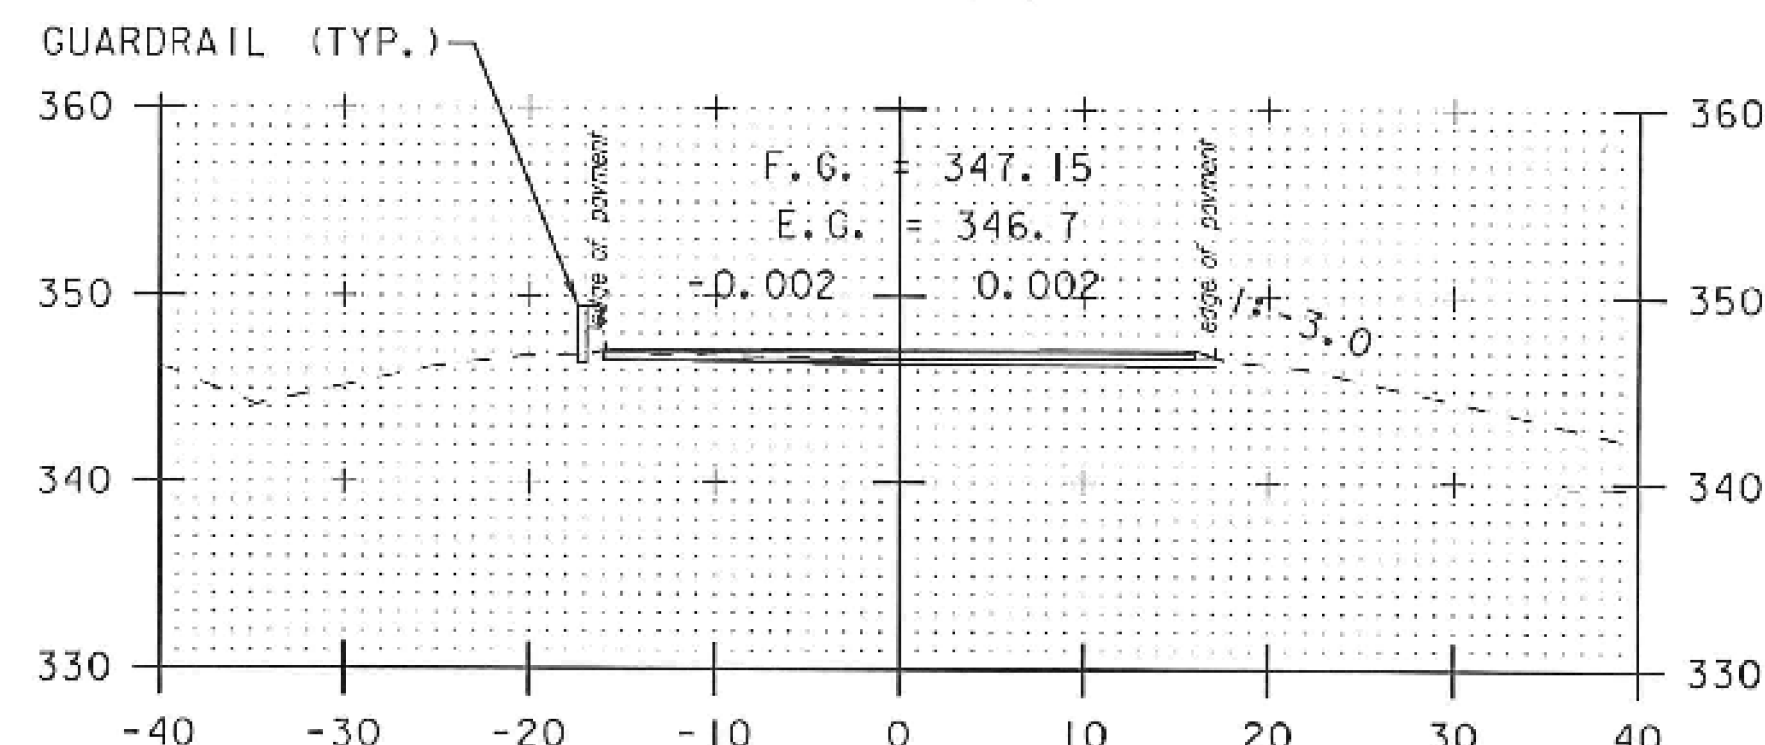

148+00

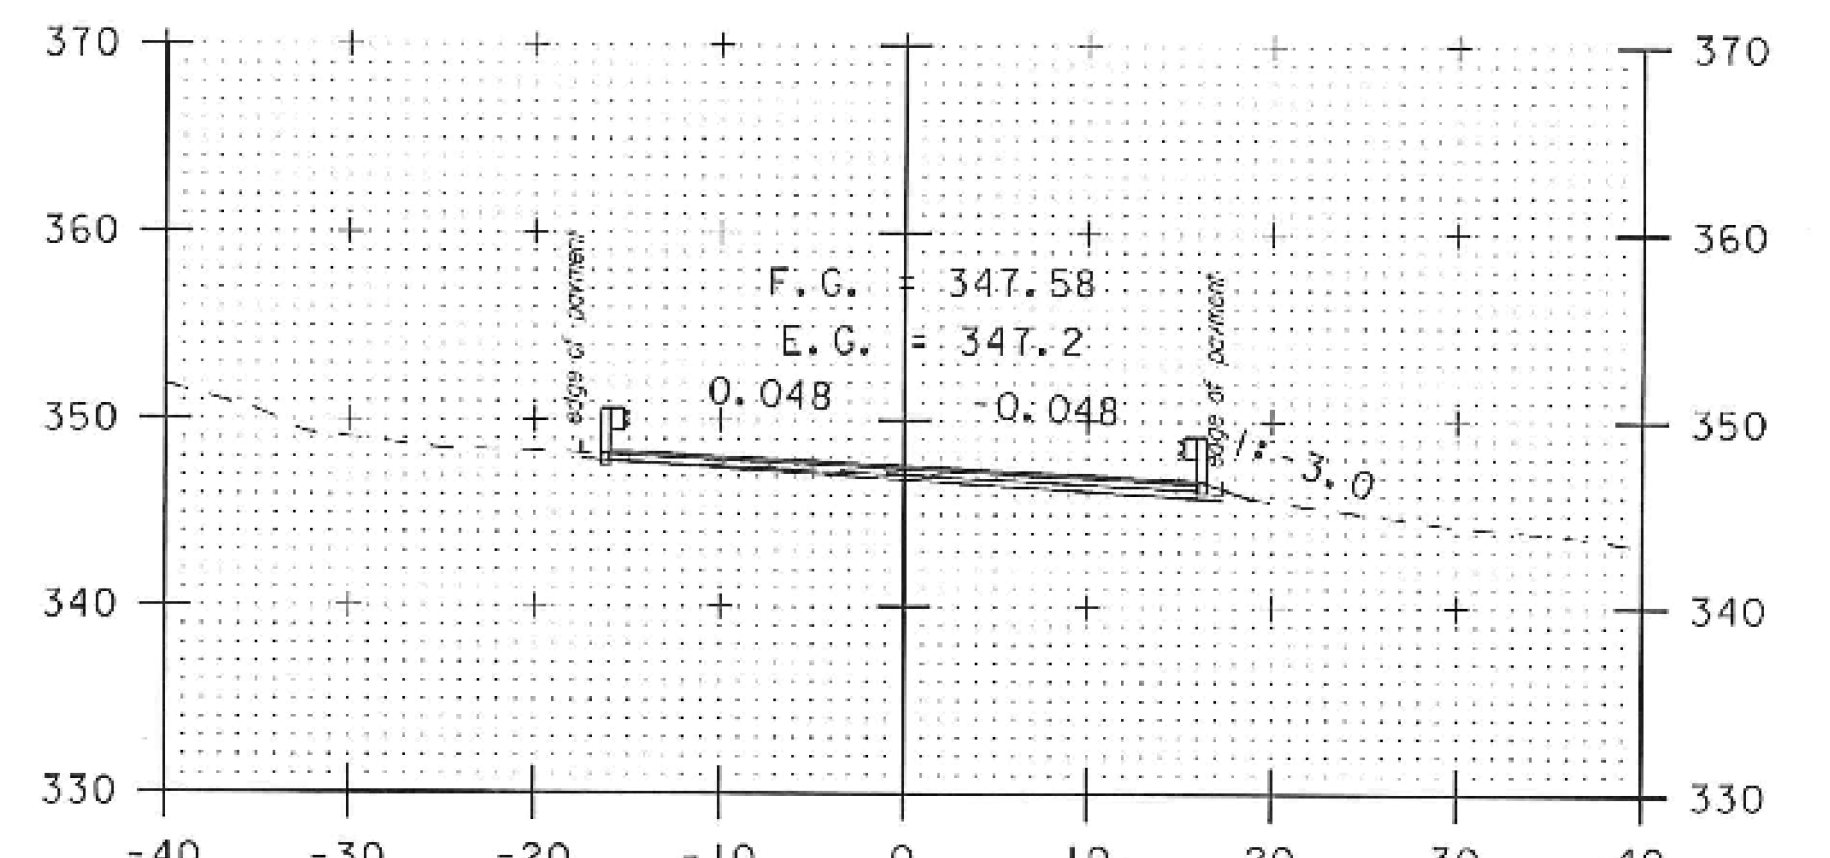

149+50

STA. 146+73 TO STA. 150+50

SCALE 1" = 10'-0"
10 0 10

CROSS SECTION SHEET 12

PROJECT NAME: BOLTON-WATERBURY
PROJECT NUMBER: STP 2709(I)

FILE NAME: x07C172.dgn
PROJECT LEADER: CDL
DESIGNED BY: BMB
PLOT FILE: x07C172_138.I

PLOT DATE: 04/17/2013
DRAWN BY: BMB
CHECKED BY: CDL
SHEET 138R OF 217