




TH#3 LT  
151+00

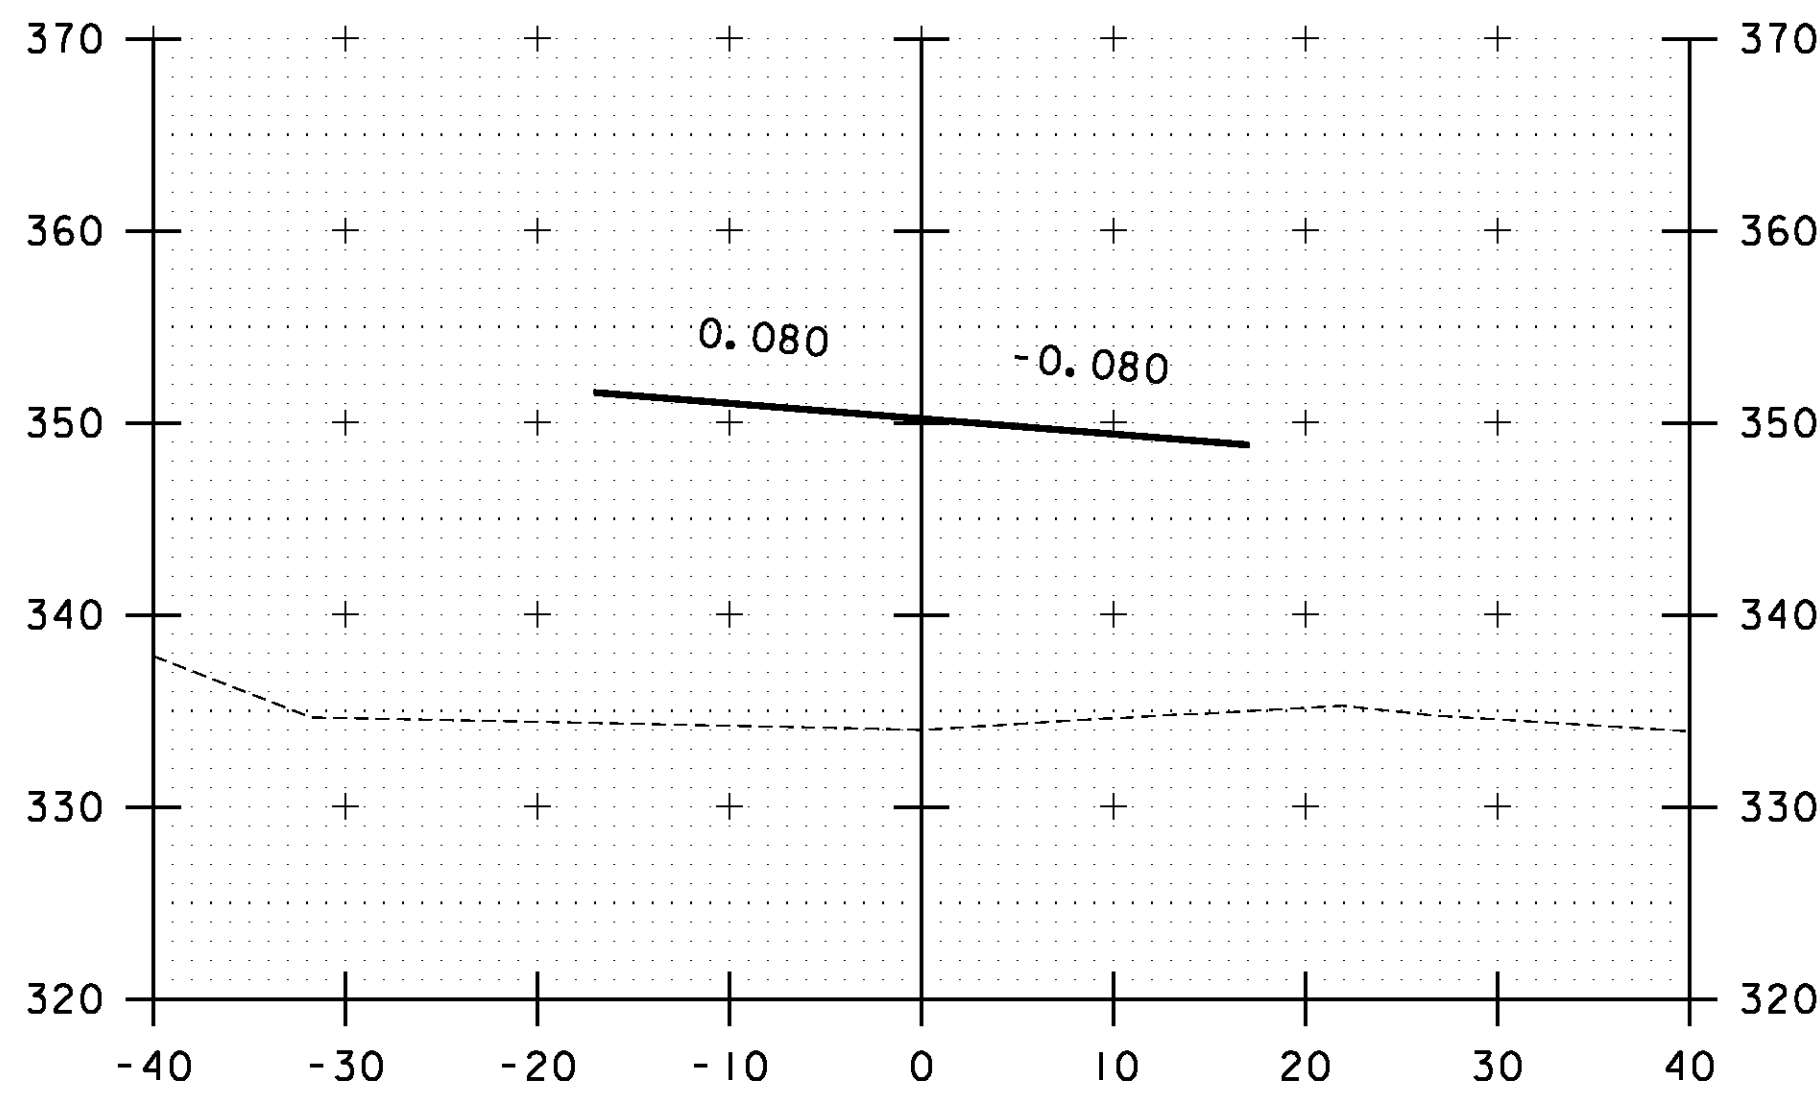


BRIDGE #37  
152+00

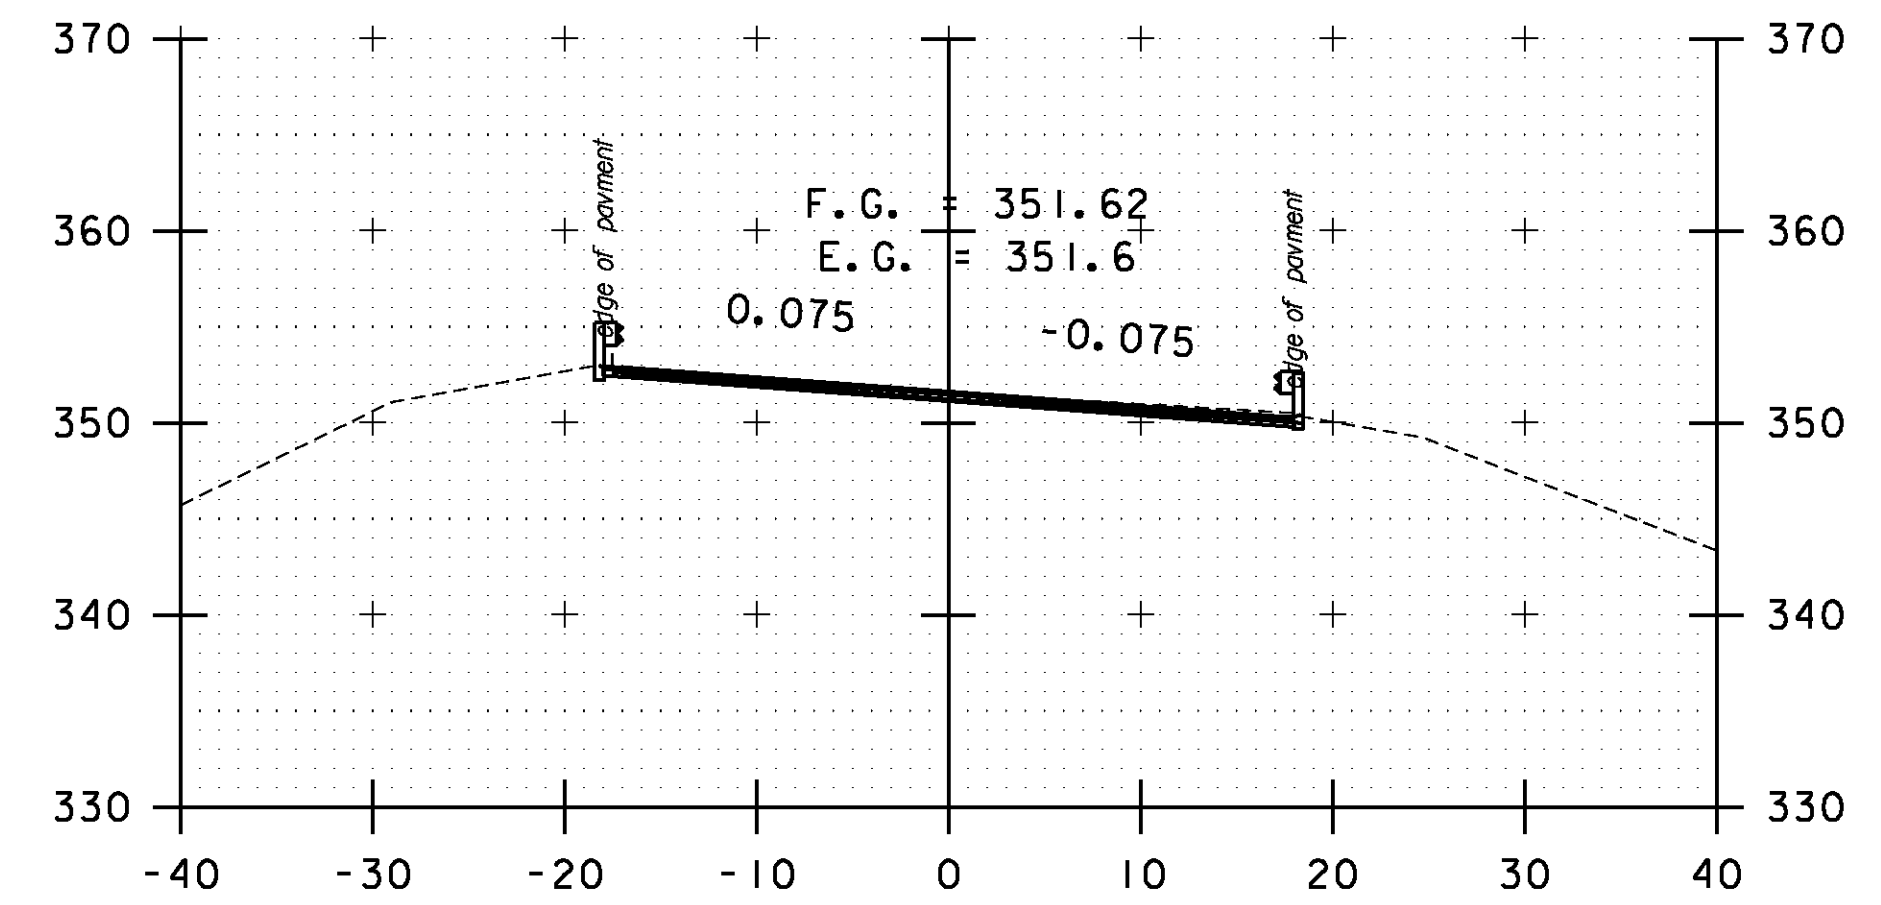


153+00

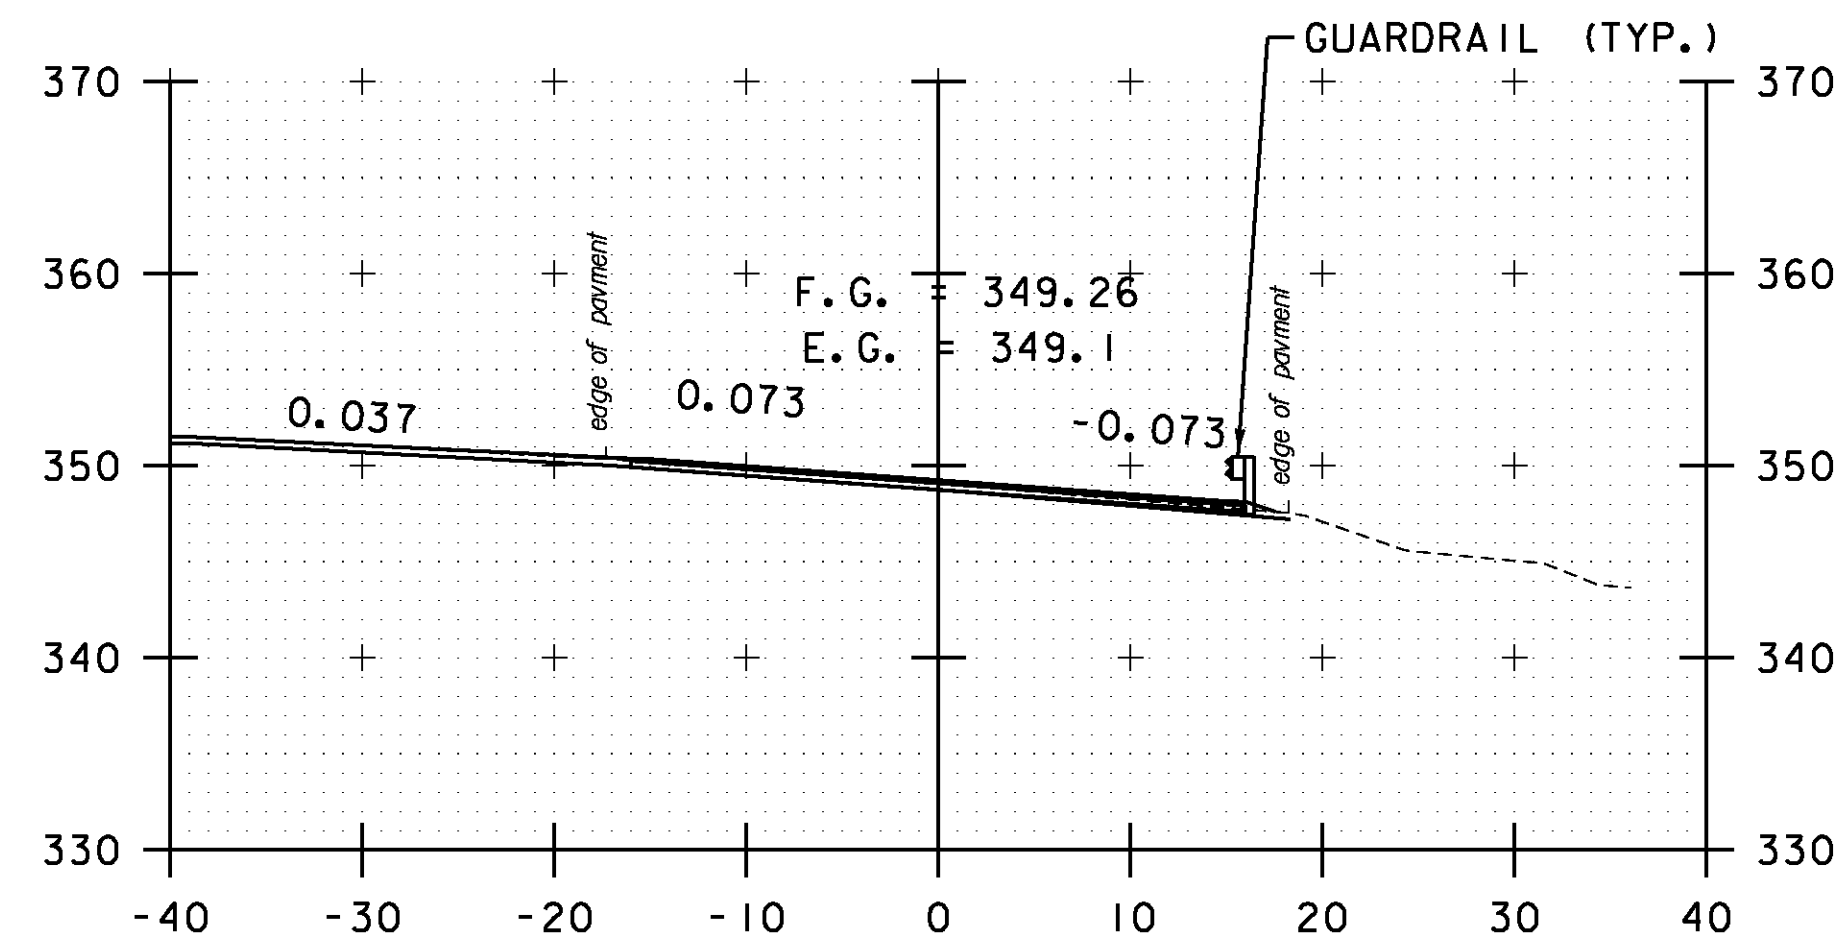


TH#3 LT  
150+95

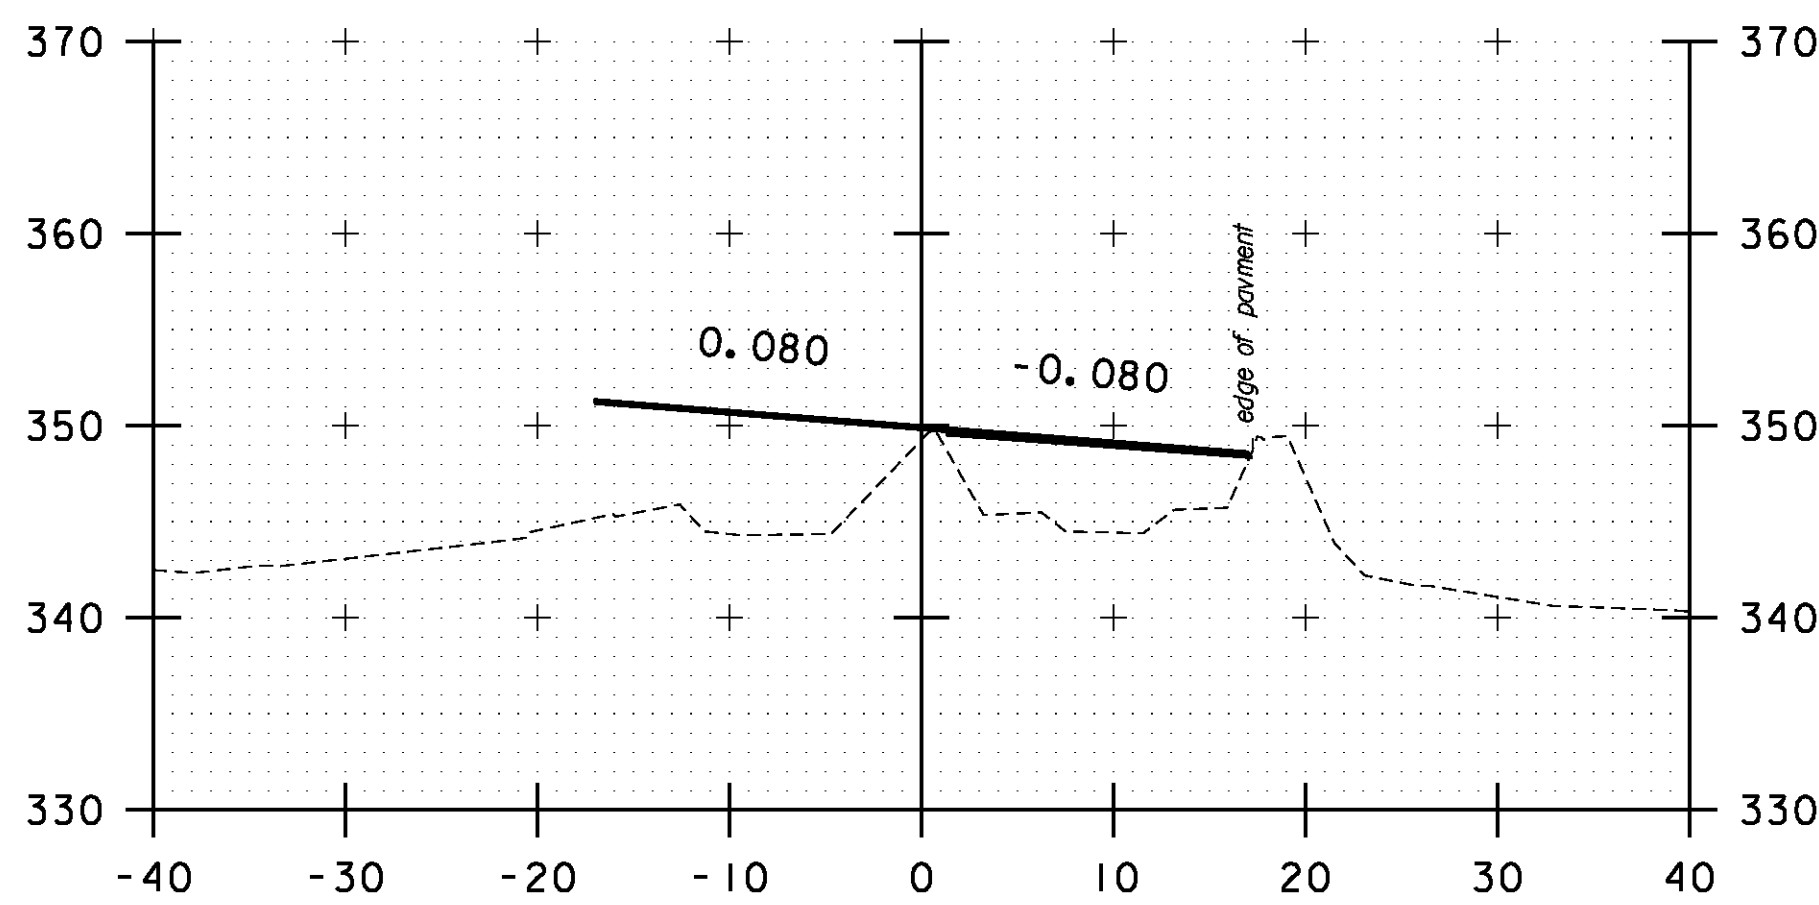


BRIDGE #37  
152+65

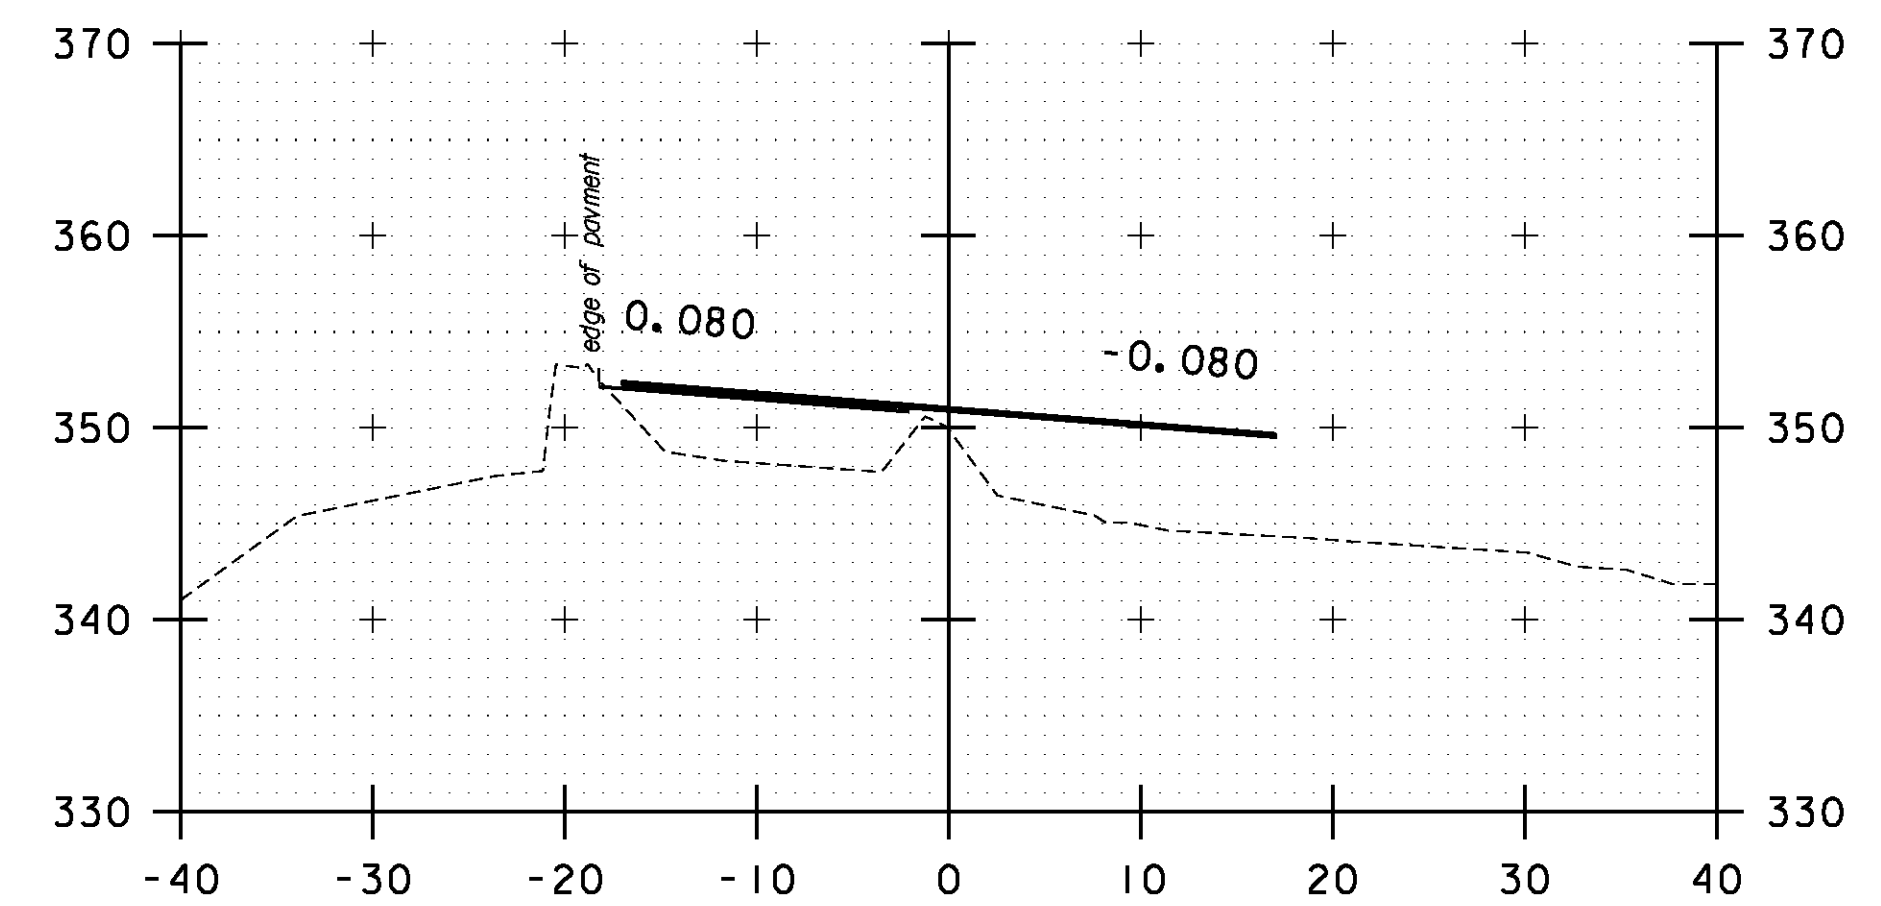


BRIDGE #37  
152+50

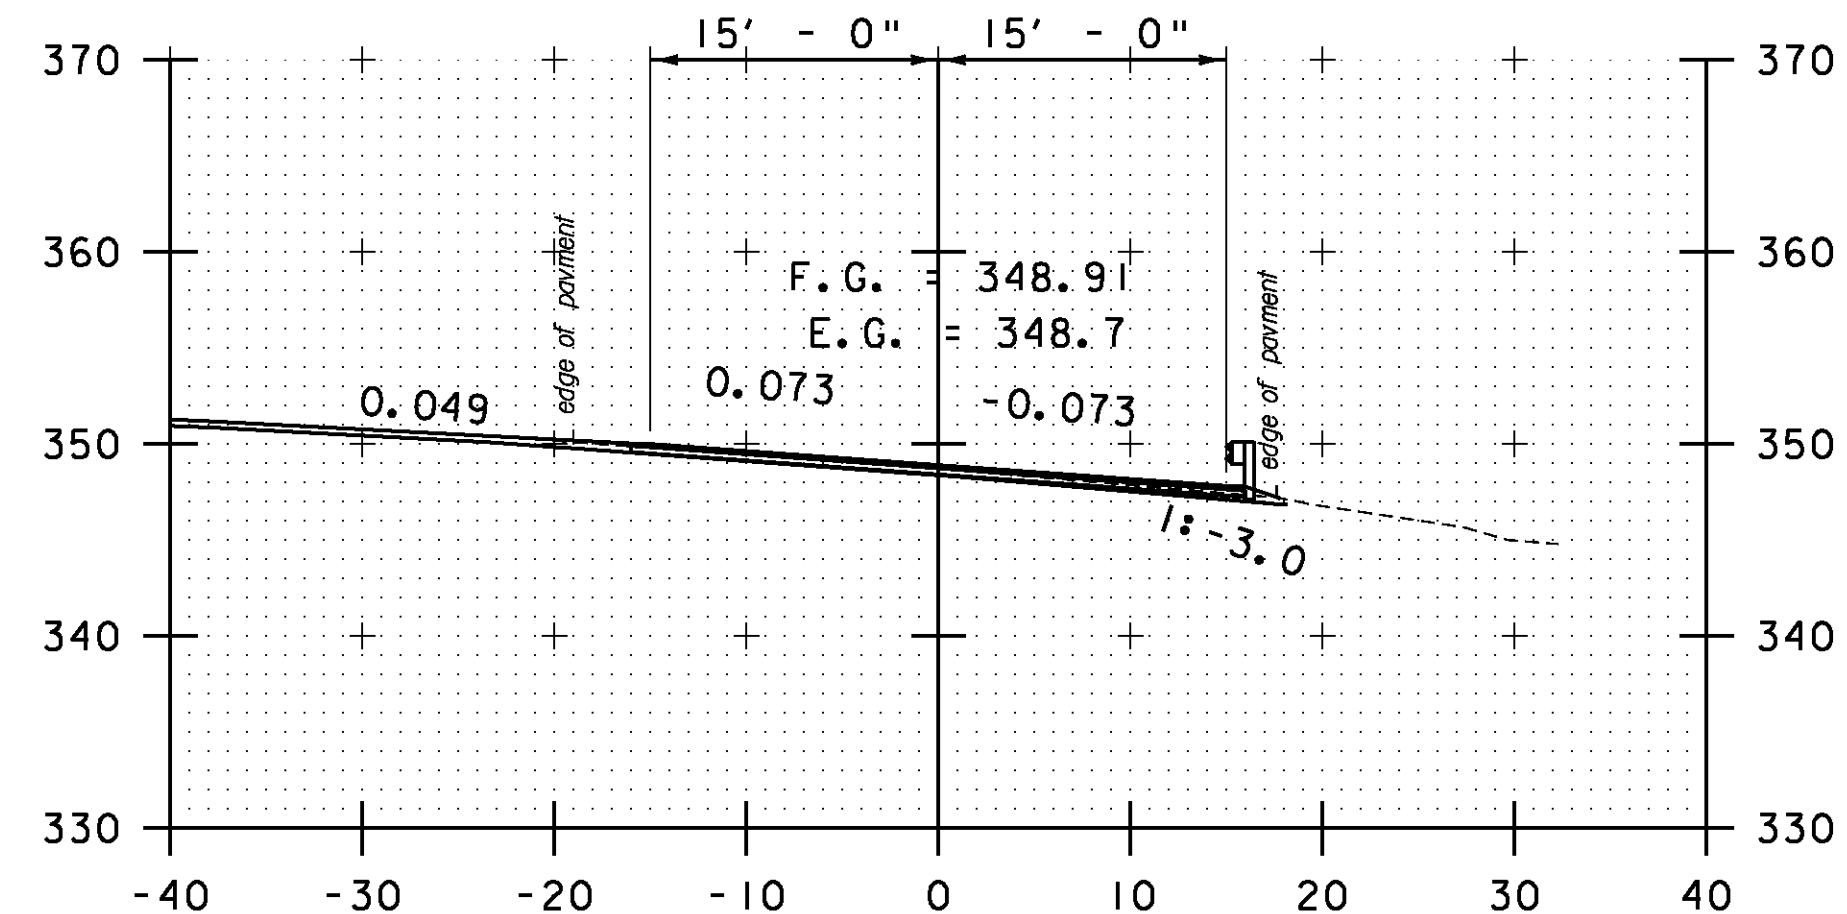

TH#3 LT  
150+66

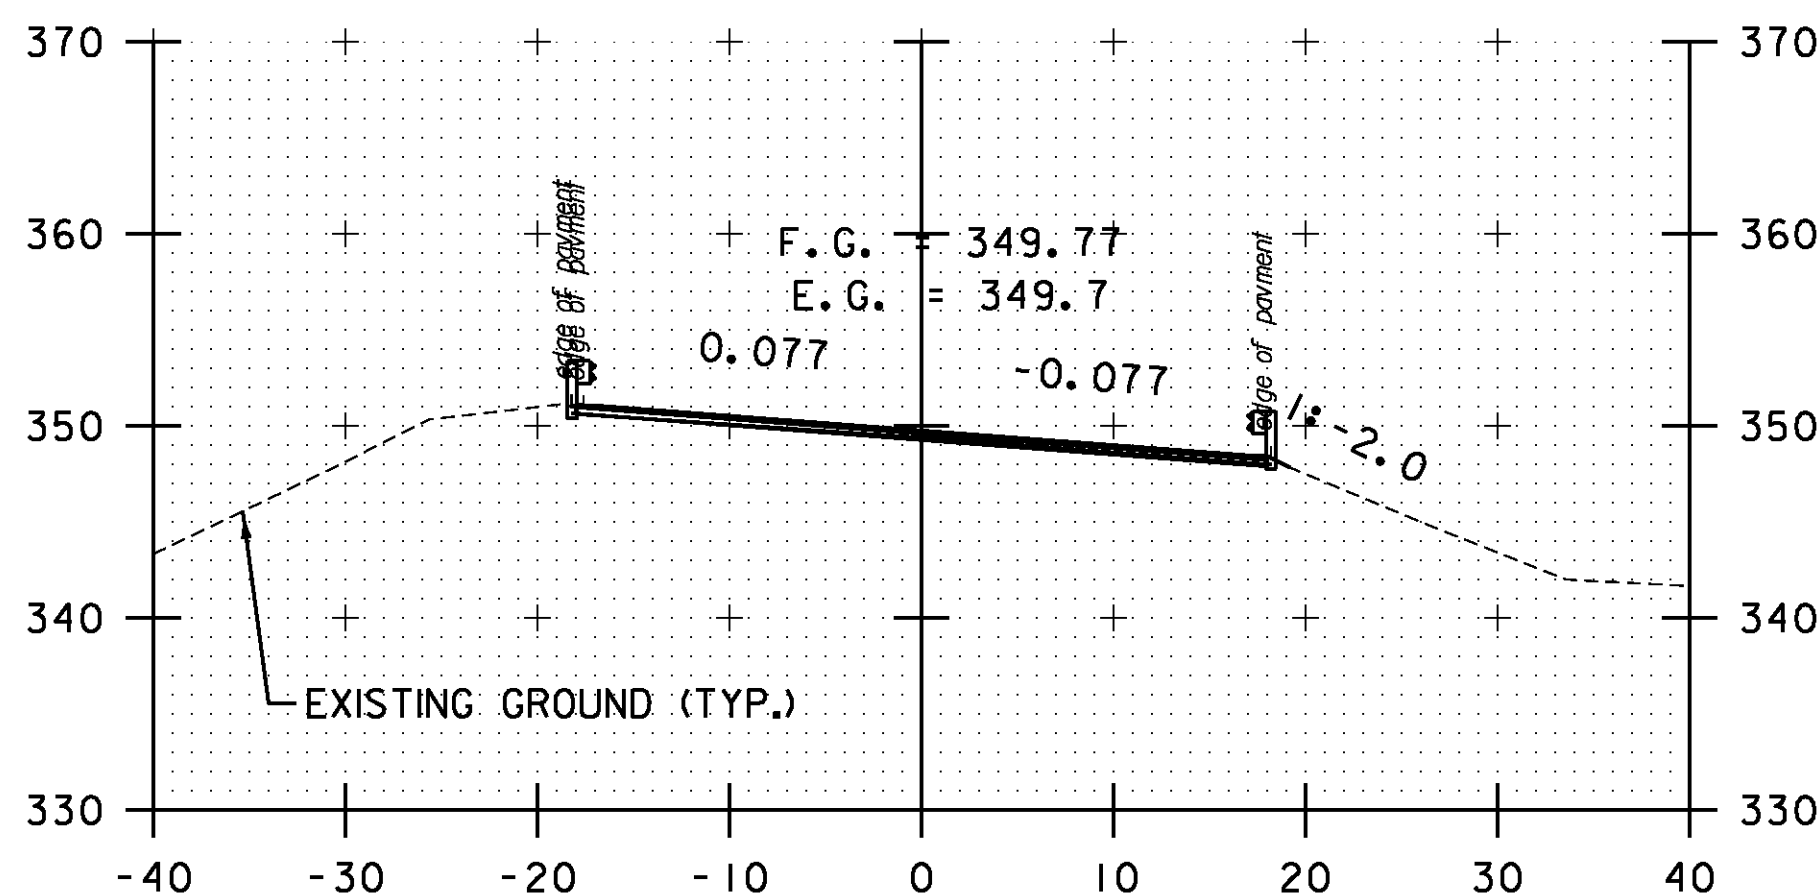

151+50

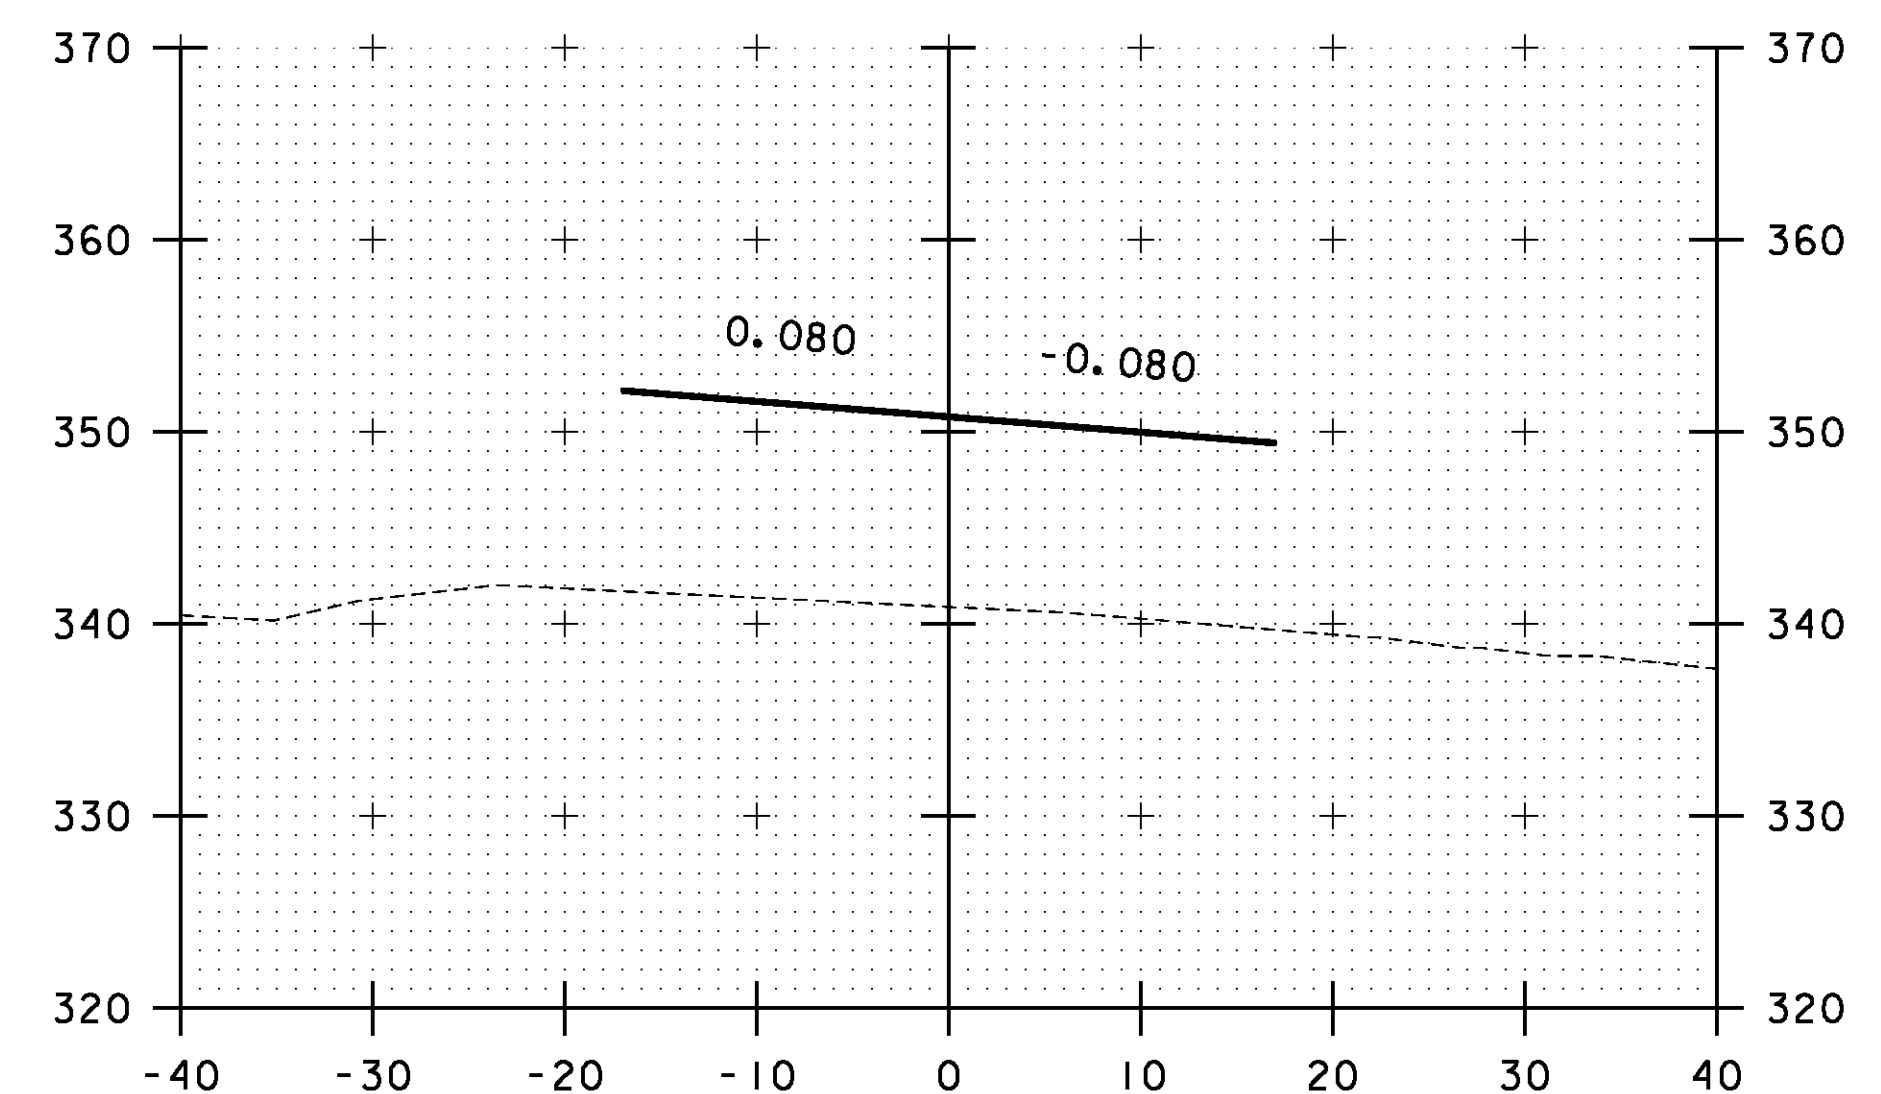

STA. 150+66 TO STA. 153+00

SCALE 1" = 10'-0"  
0 10

**CROSS SECTION SHEET 13**

PROJECT NAME: BOLTON-WATERBURY

PROJECT NUMBER: STP 2709(I)

FILE NAME: p07C172.dgn

PROJECT LEADER: CDL

DESIGNED BY: BMB

PLOT FILE: p07C172\_139.I

PLOT DATE: 4/17/2013

DRAWN BY: BMB

CHECKED BY: CDL

SHEET 139 OF 217