




DRIVE LT  
154+50

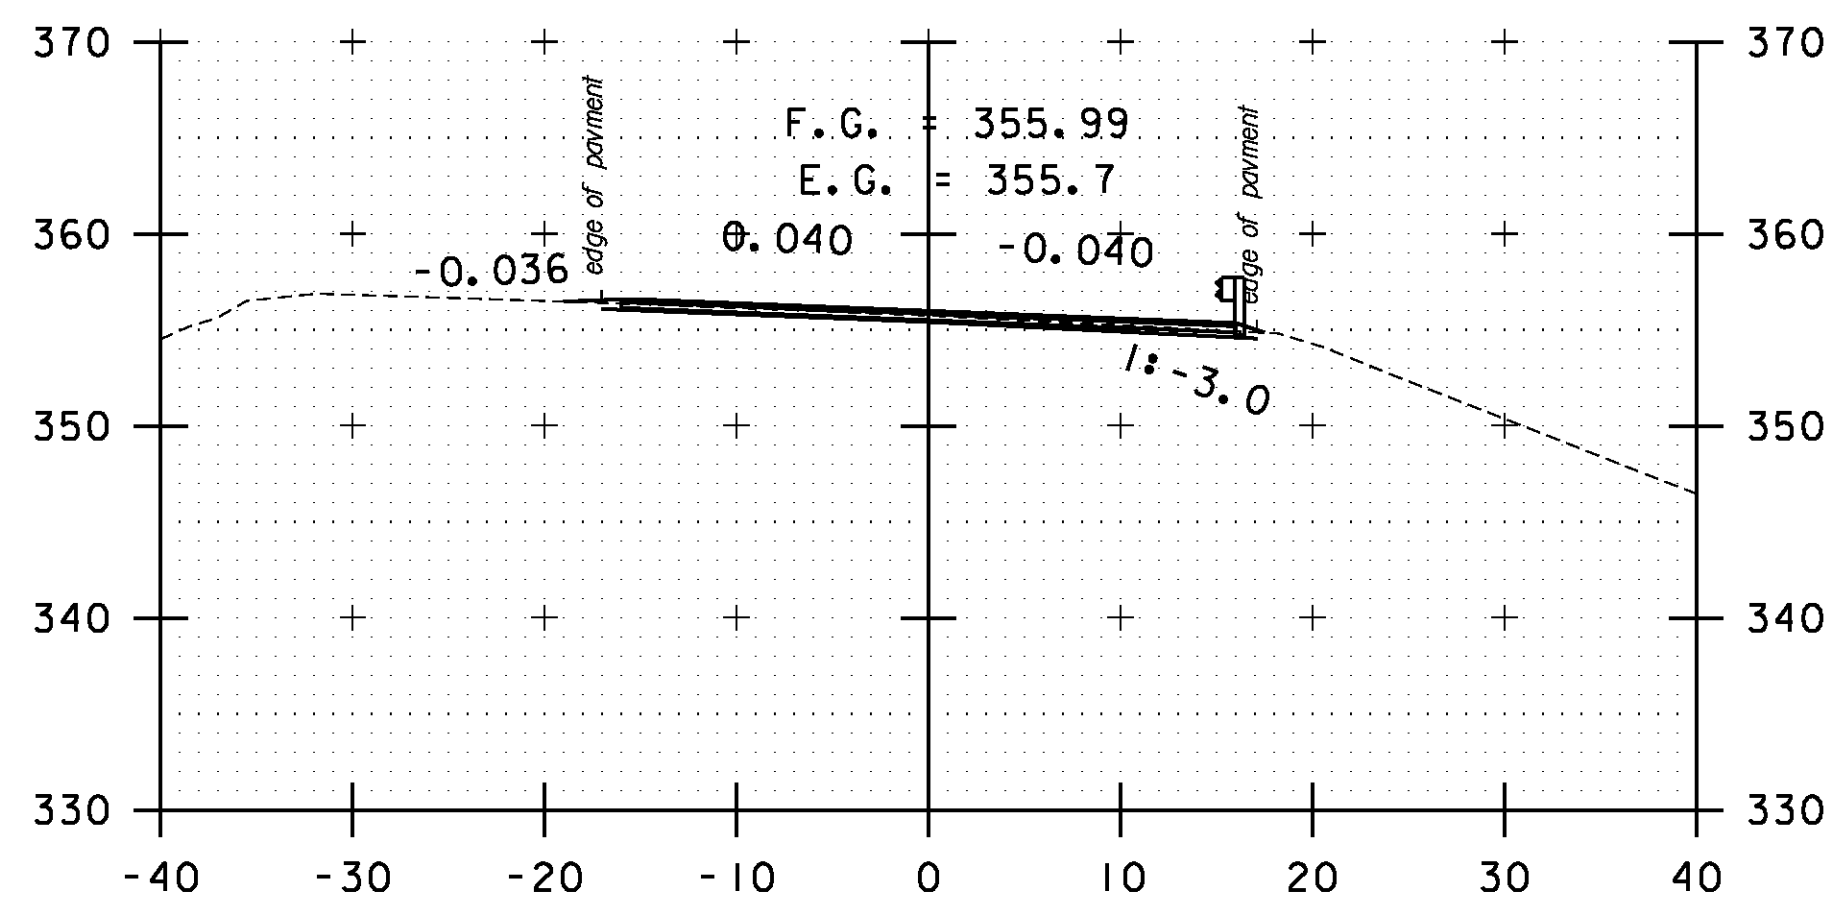


DRIVE LT  
156+00

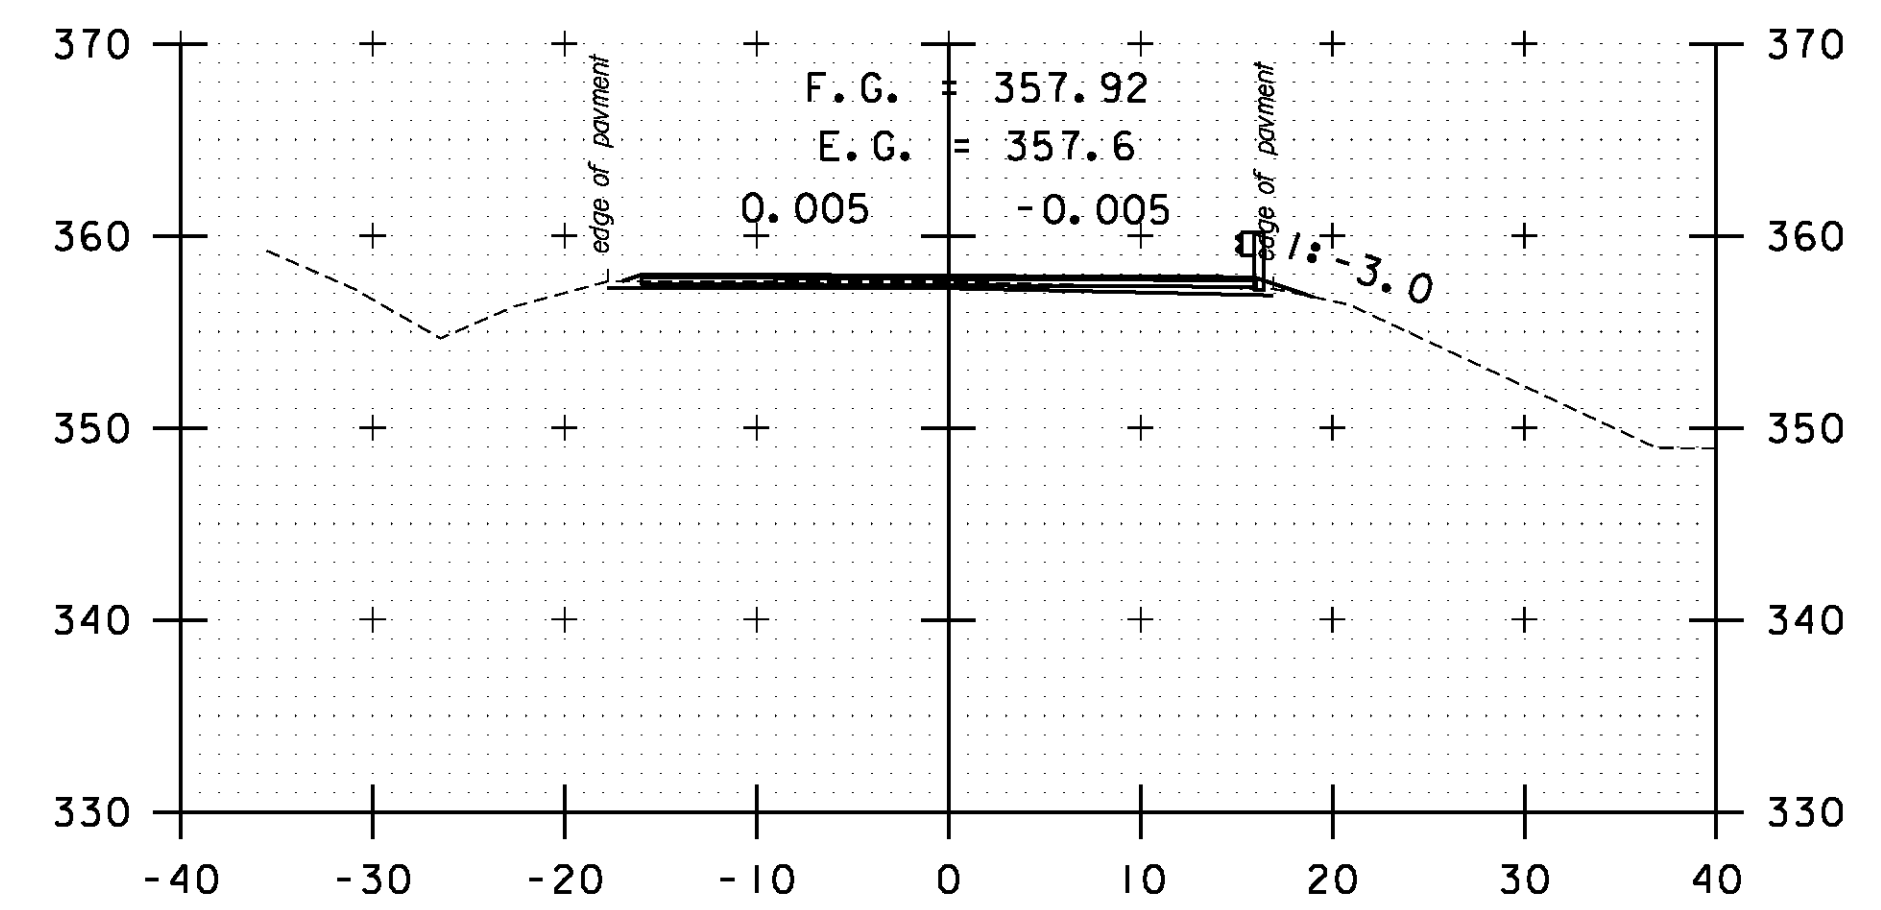


157+50

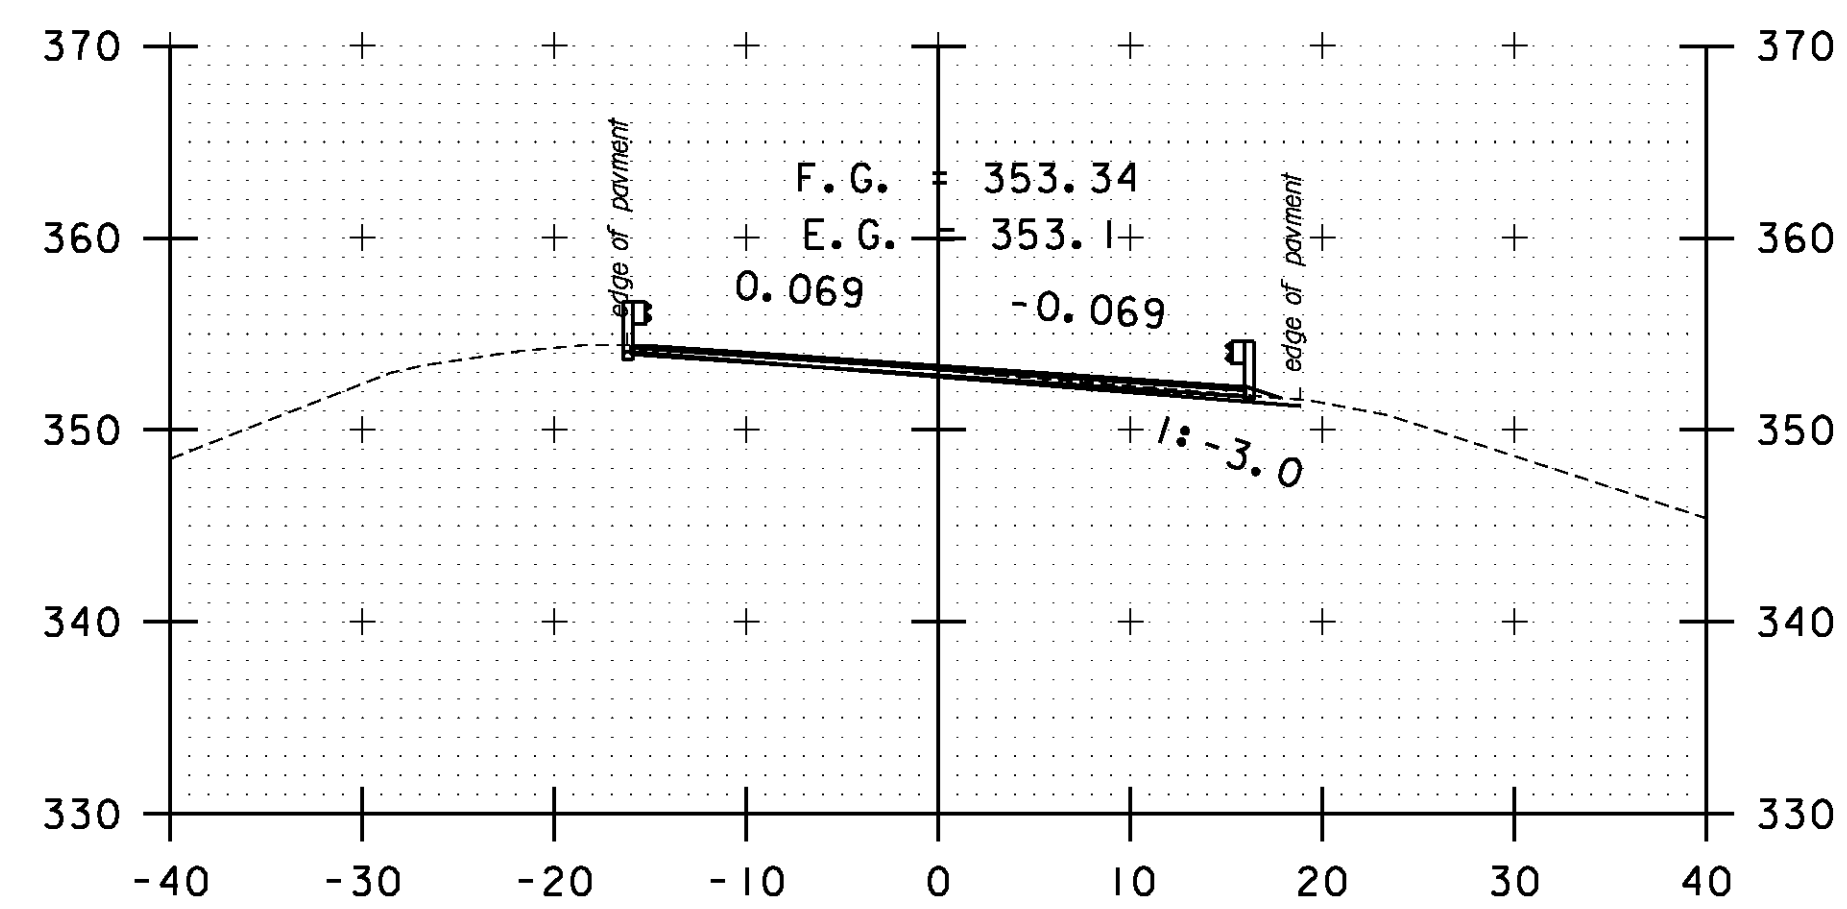


154+00

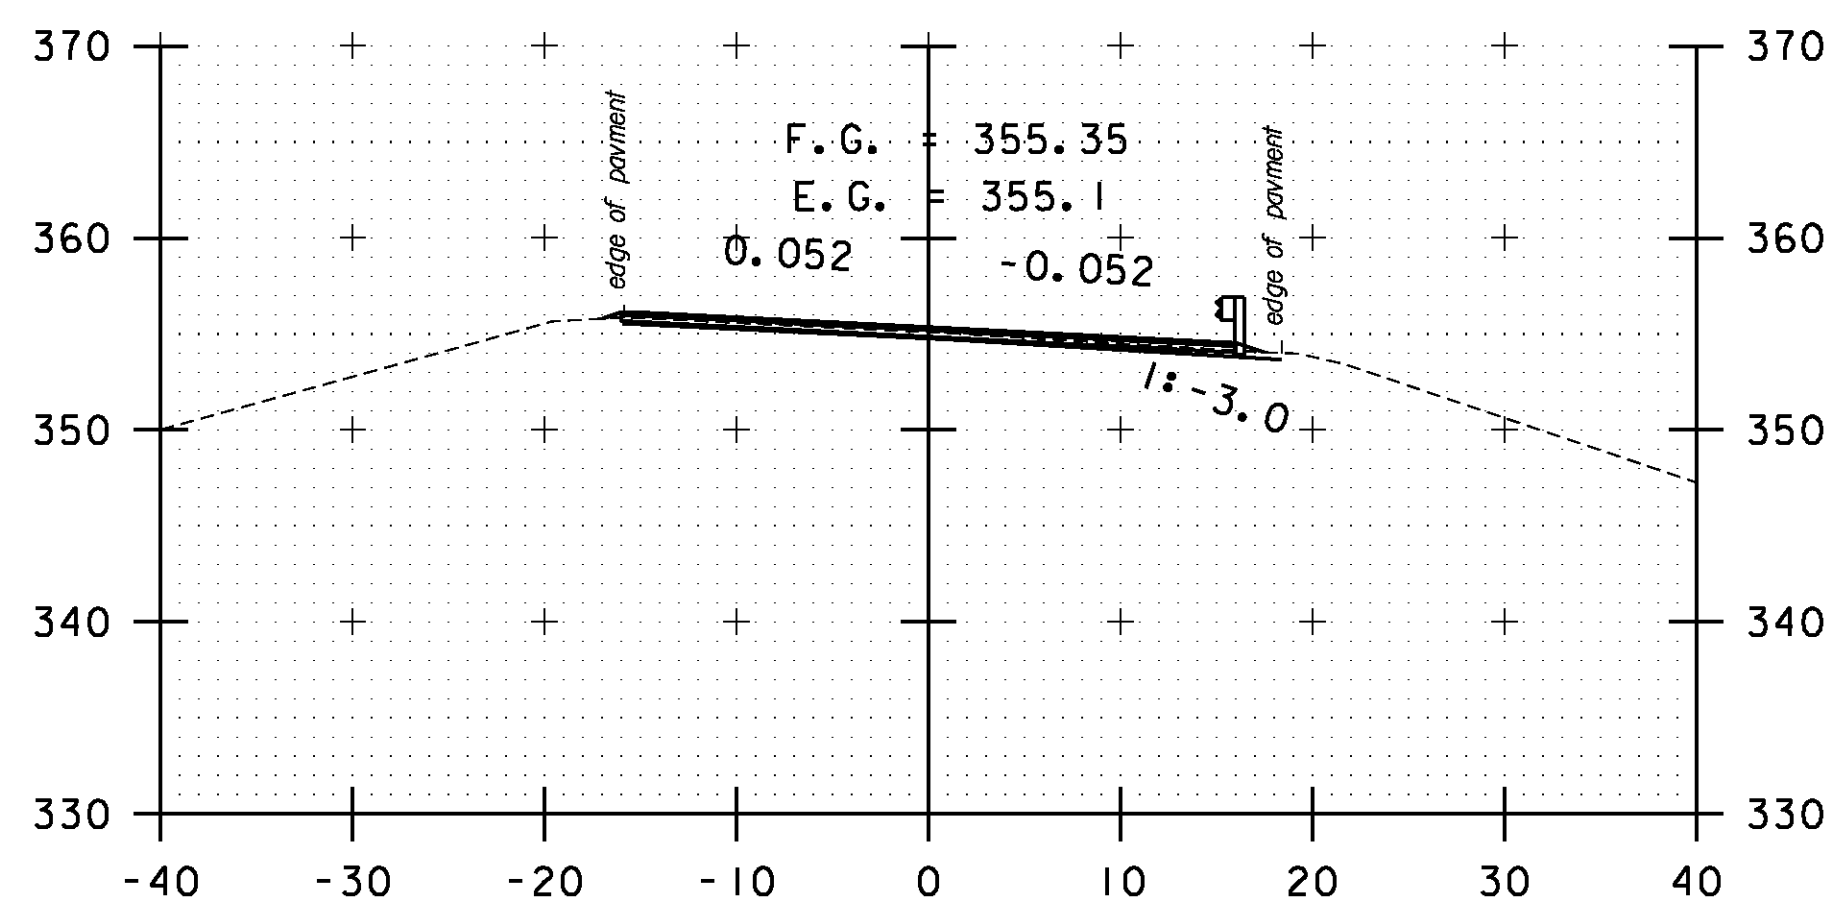


155+50

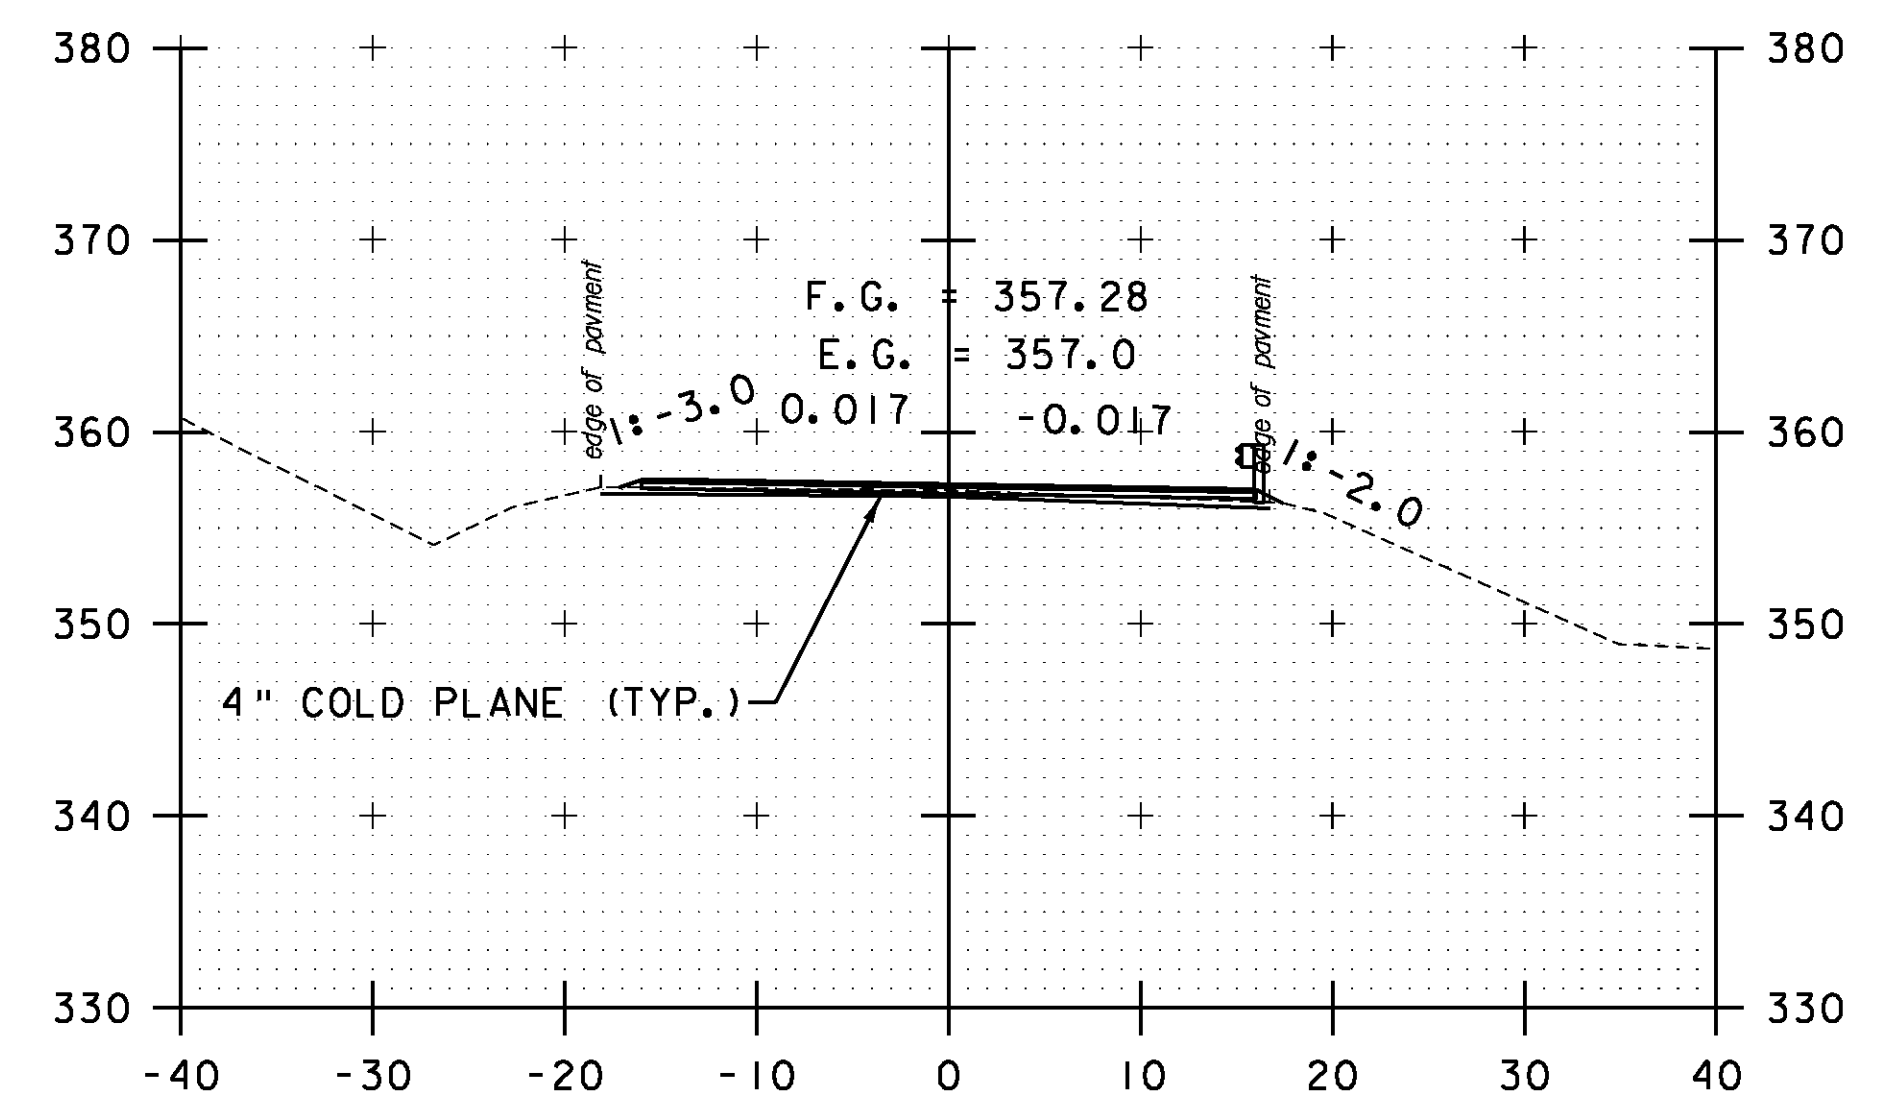


157+00

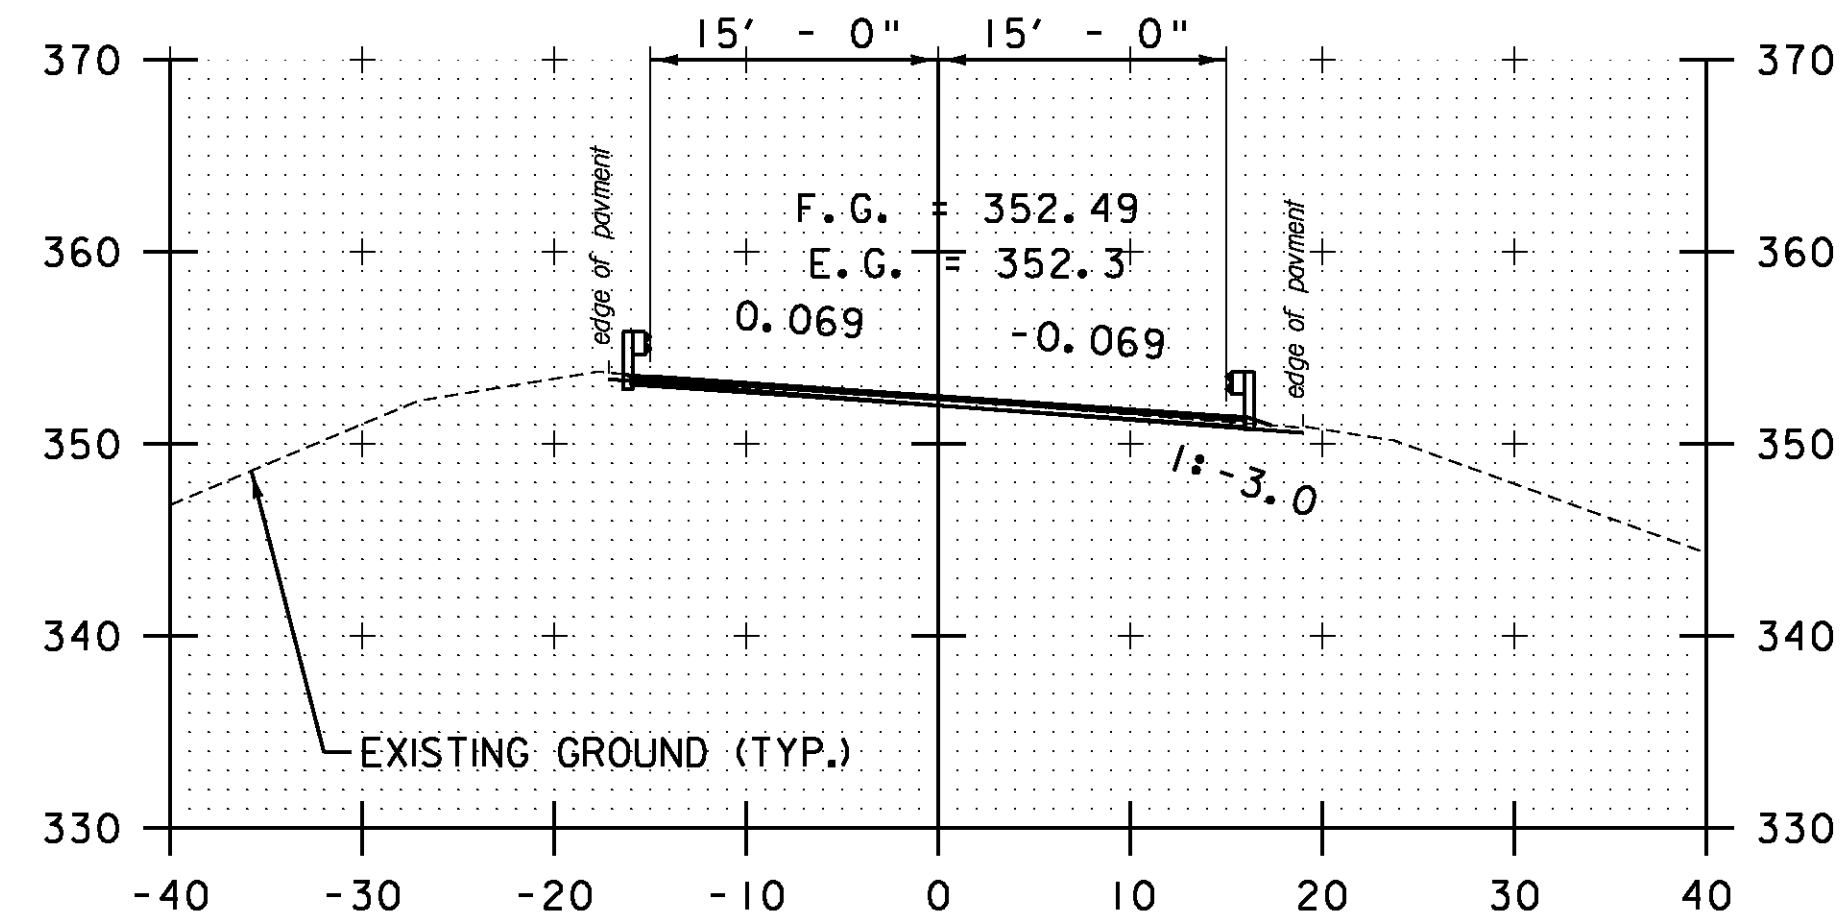

153+50

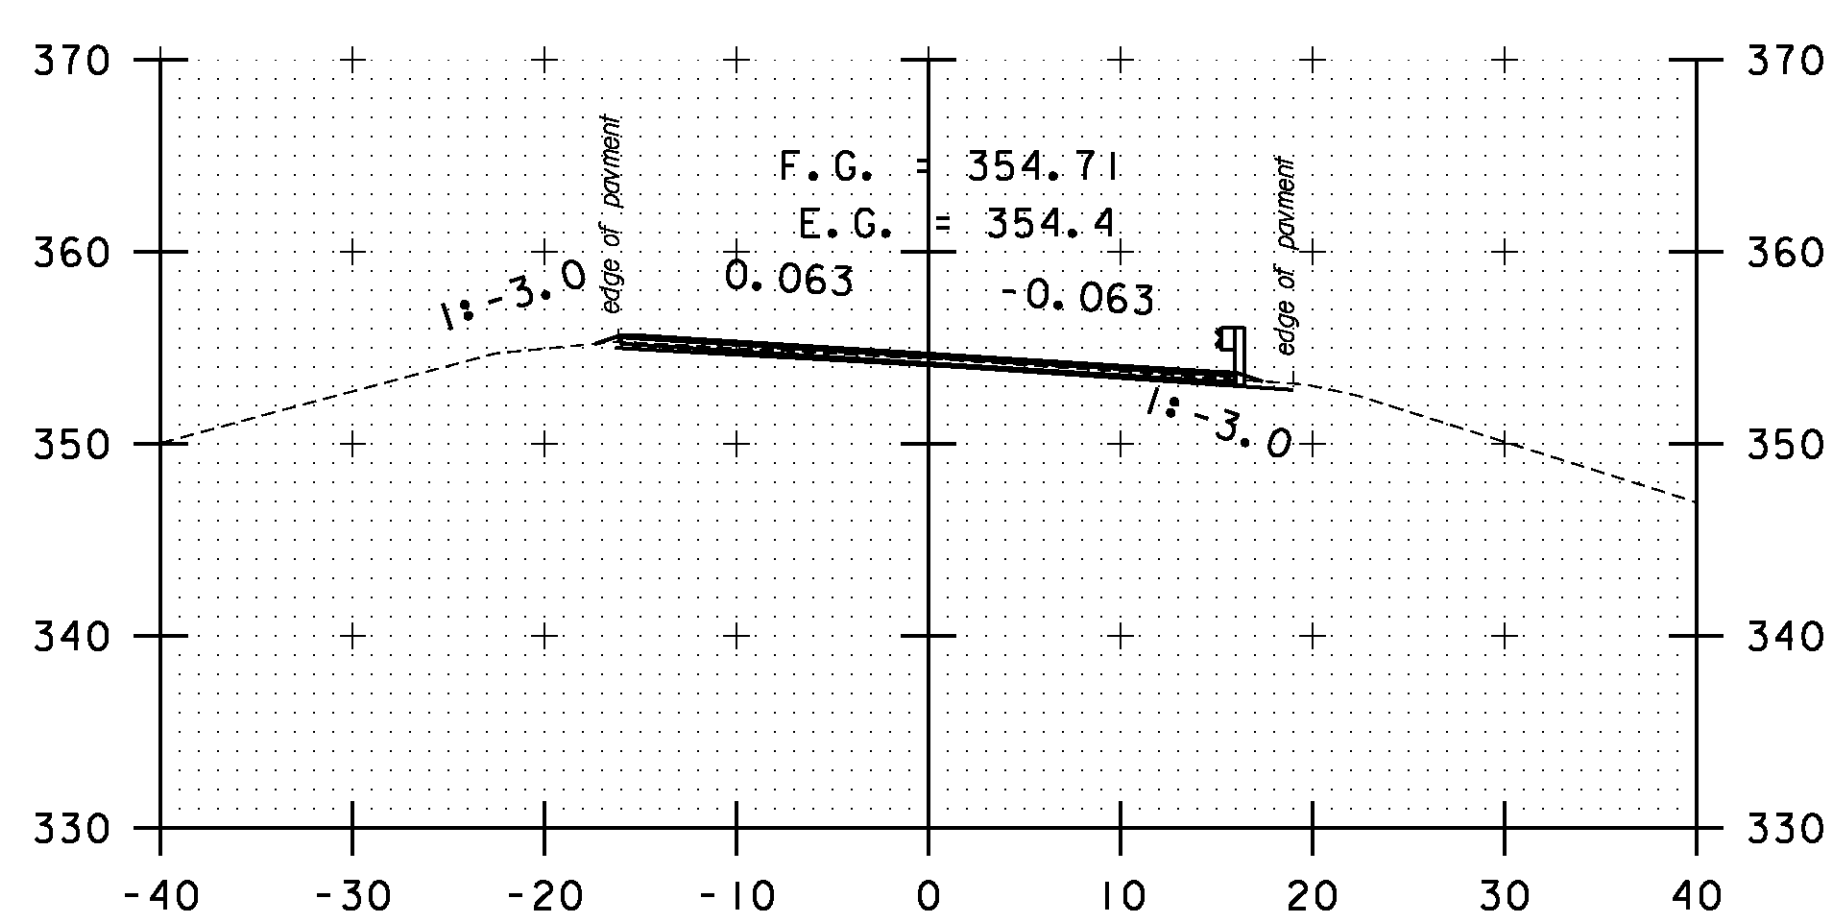

155+00

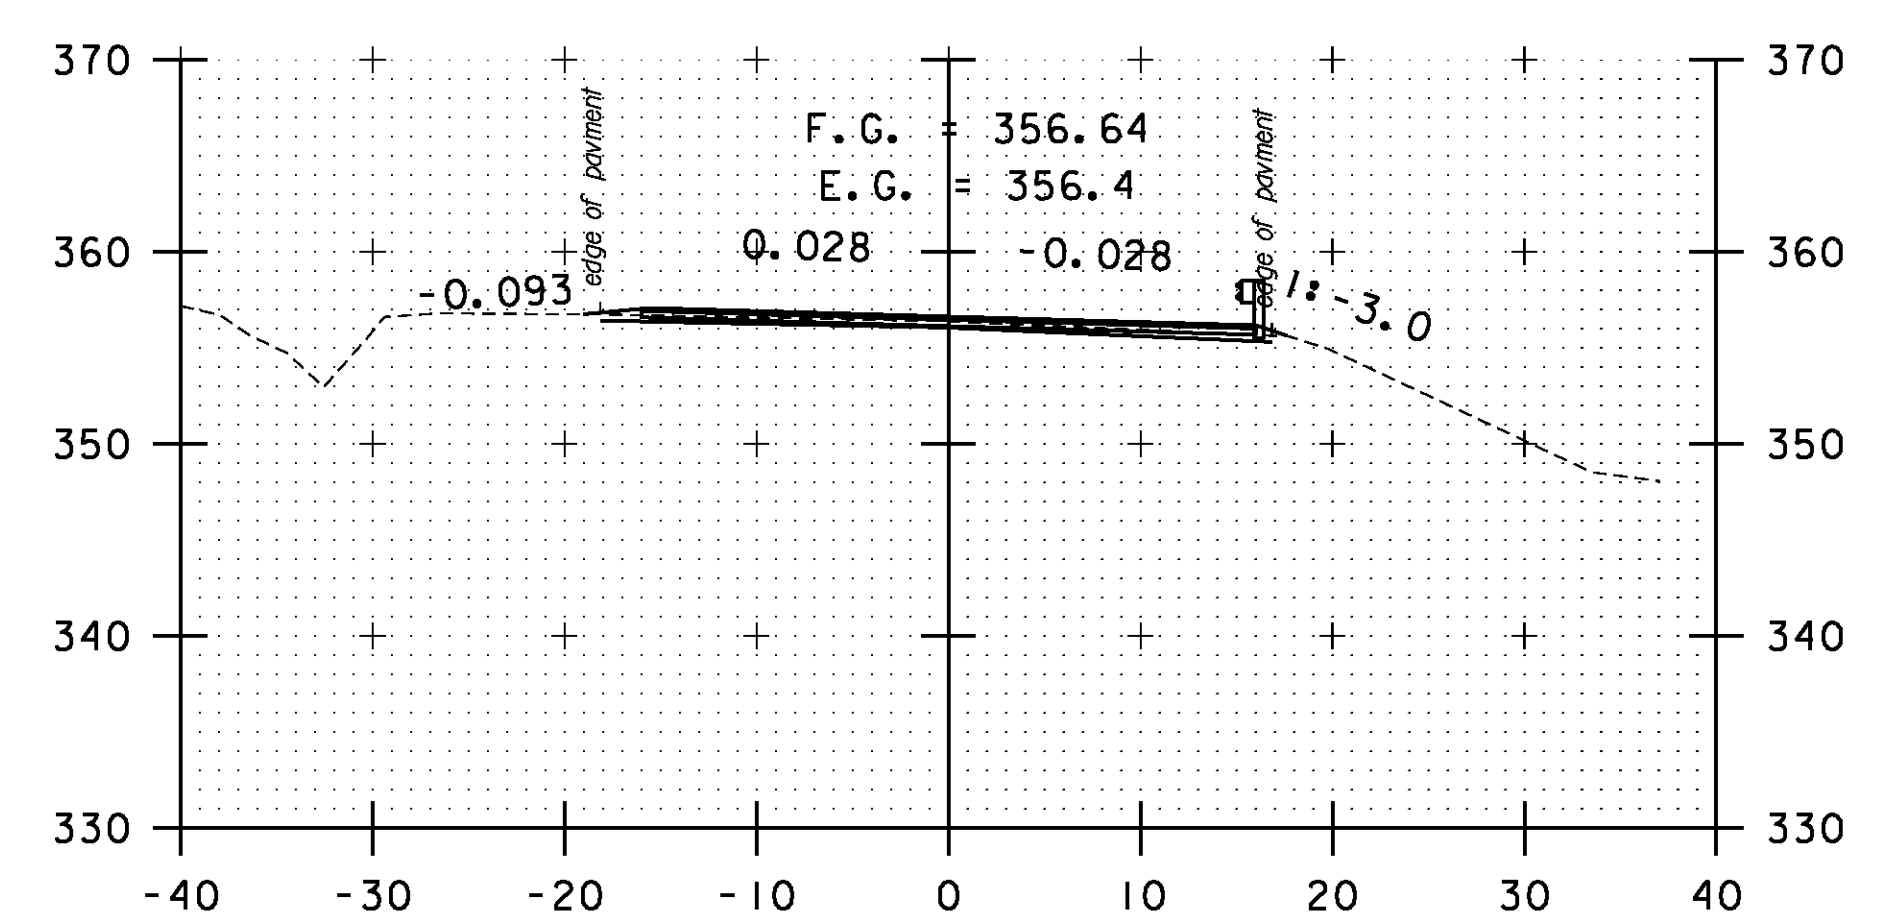

DRIVE LT  
156+50

STA. 153+50 TO STA. 157+50



**CROSS  
SECTION  
SHEET 14**

PROJECT NAME: BOLTON-WATERBURY

PROJECT NUMBER: STP 2709(1)

FILE NAME: p07C172.dgn

PROJECT LEADER: CDL

DESIGNED BY: BMB

PLOT FILE: p07C172\_140.1

PLOT DATE: 4/16/2013

DRAWN BY: BMB

CHECKED BY: CDL

SHEET 140 OF 217