




158+50

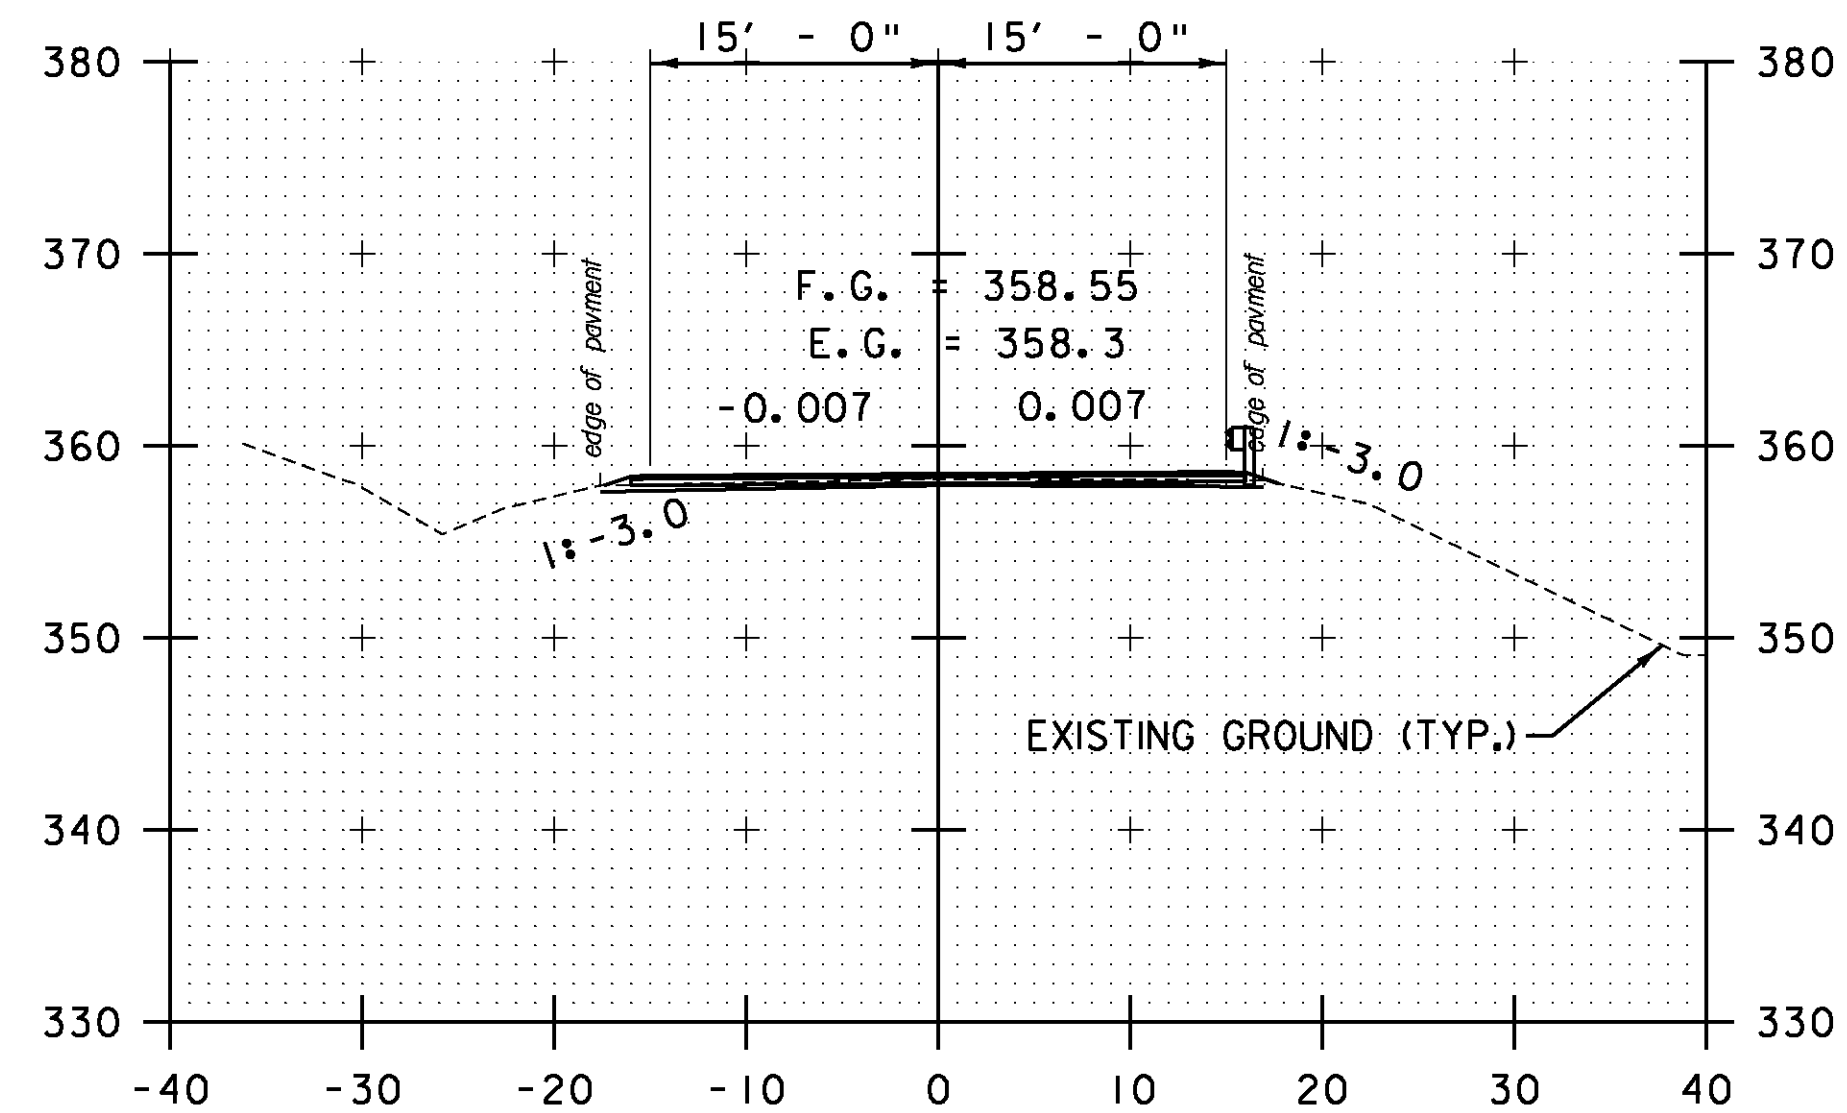


158+00

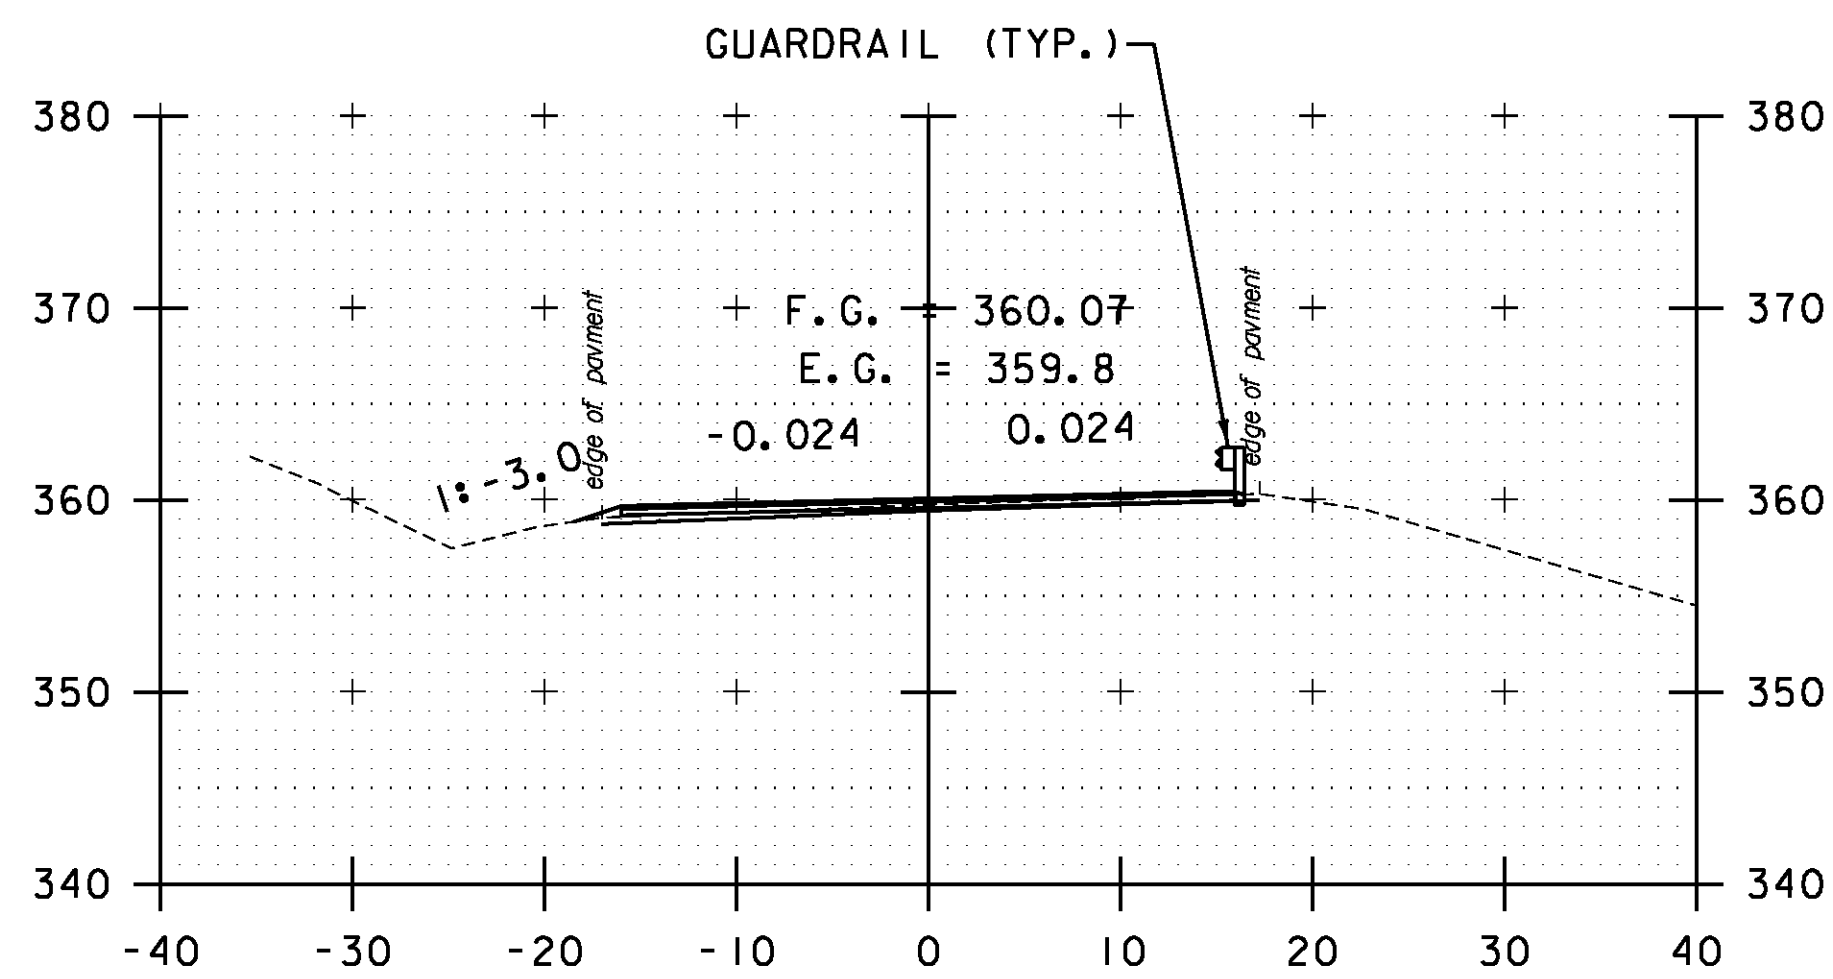


160+00

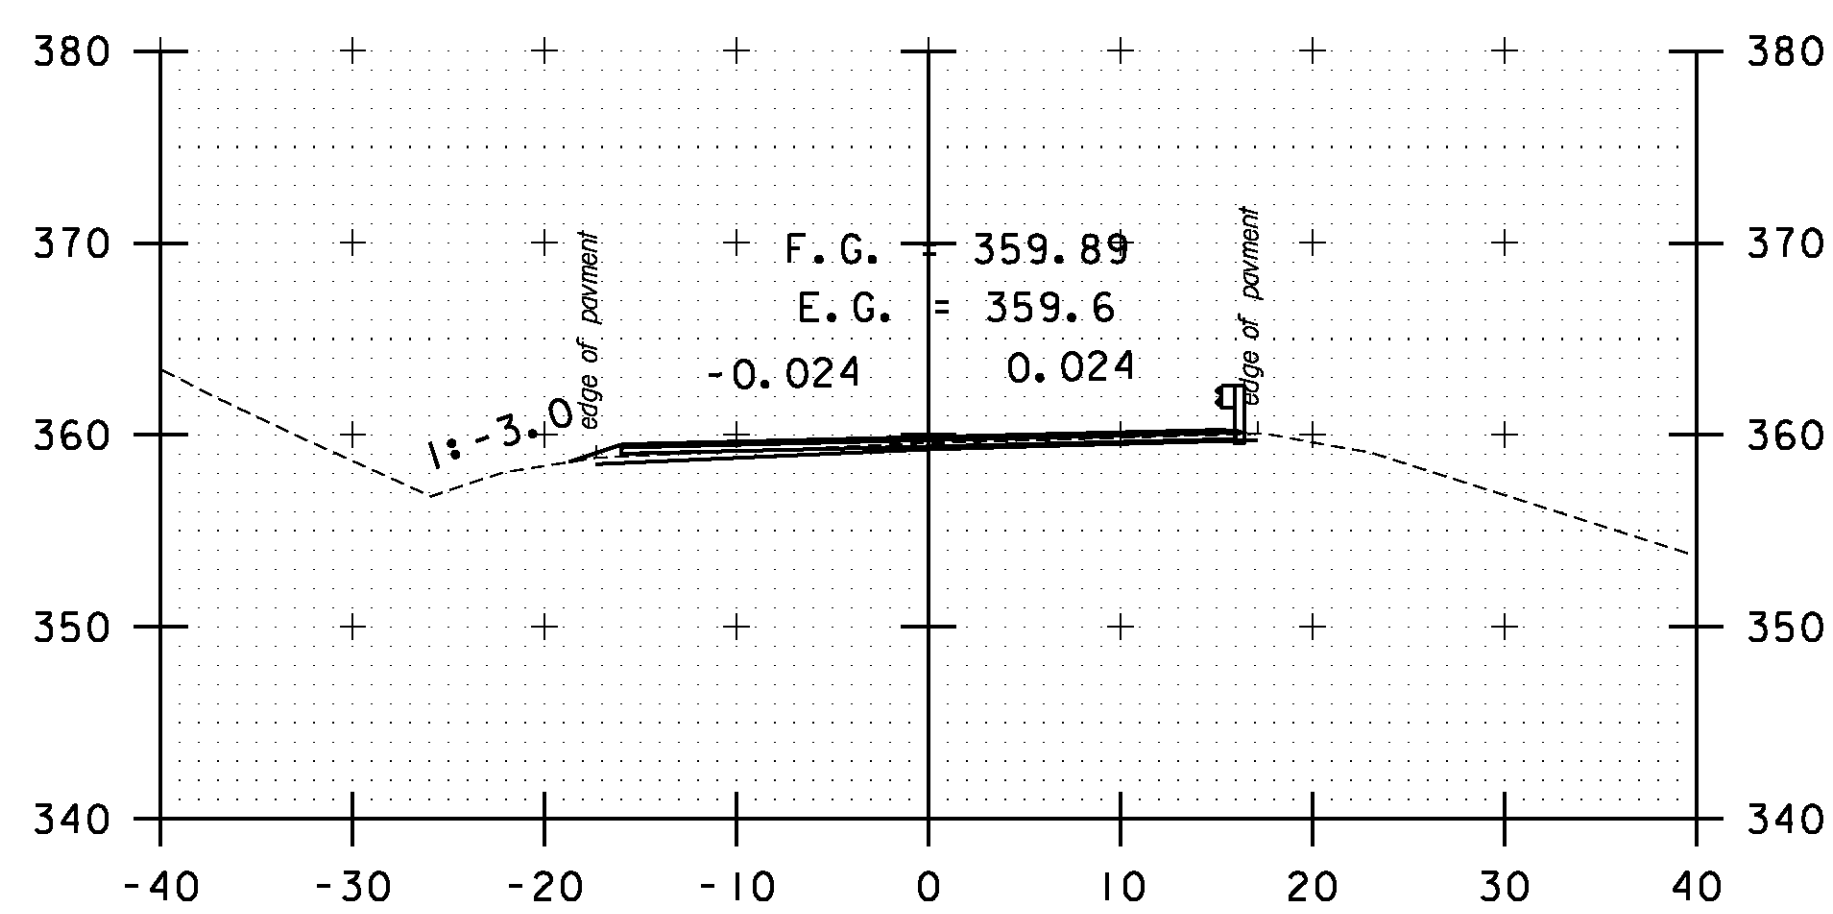


159+50

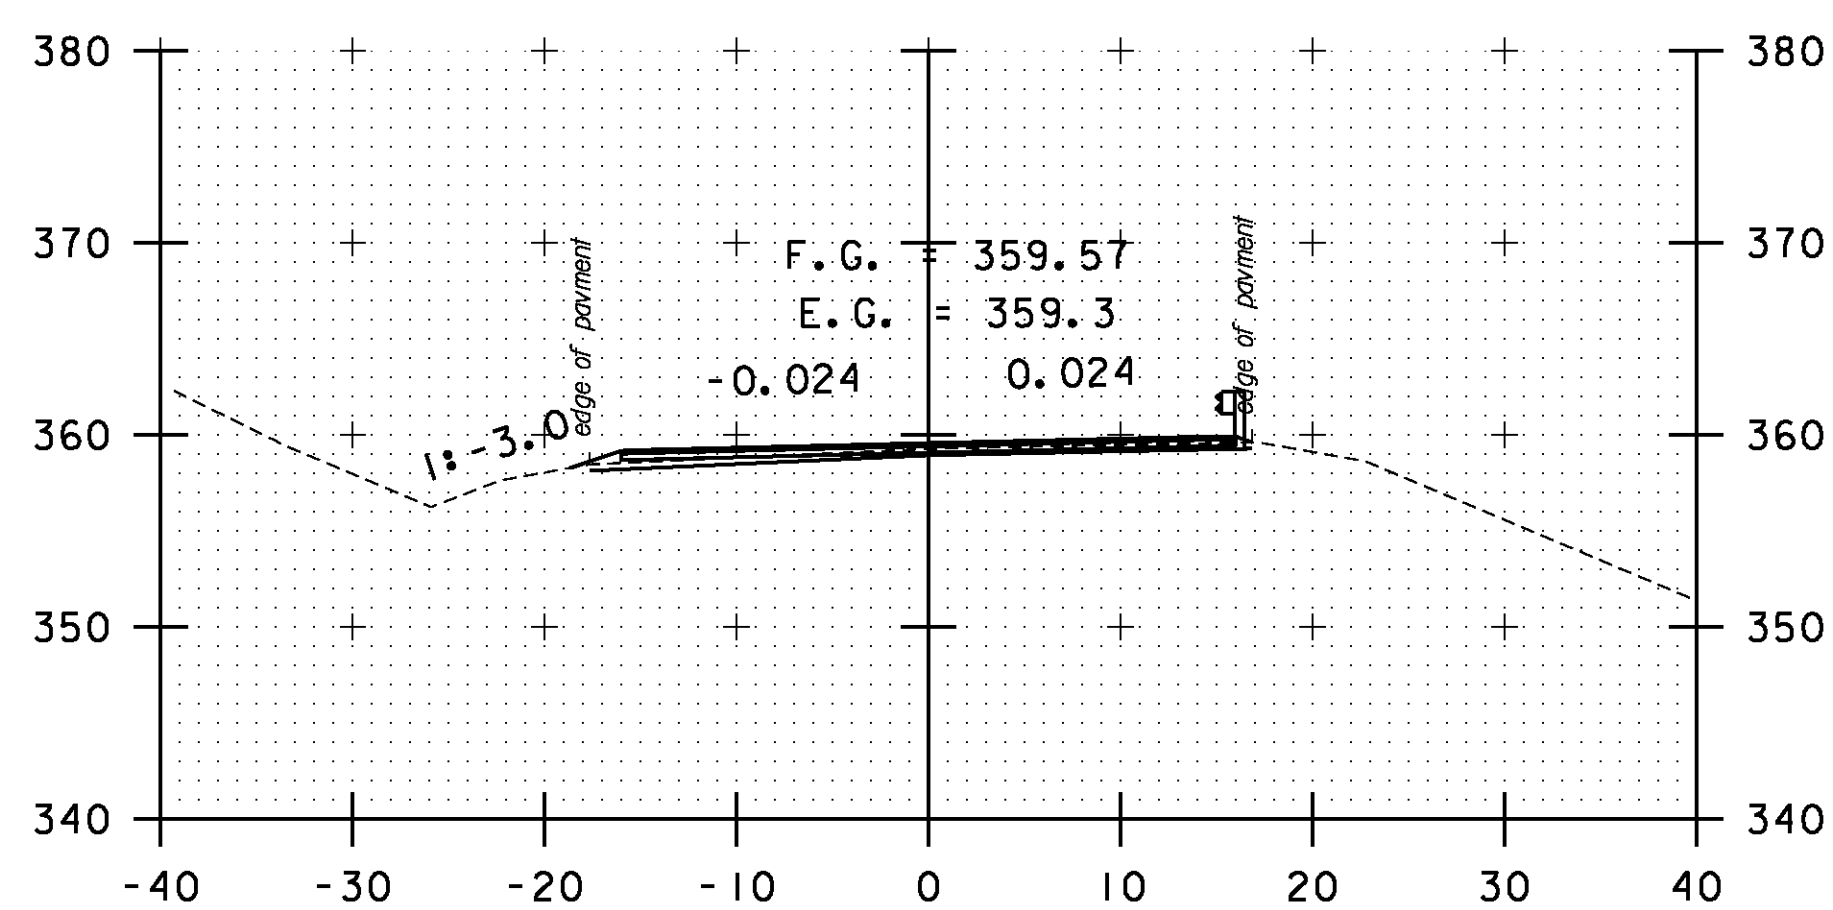


159+00

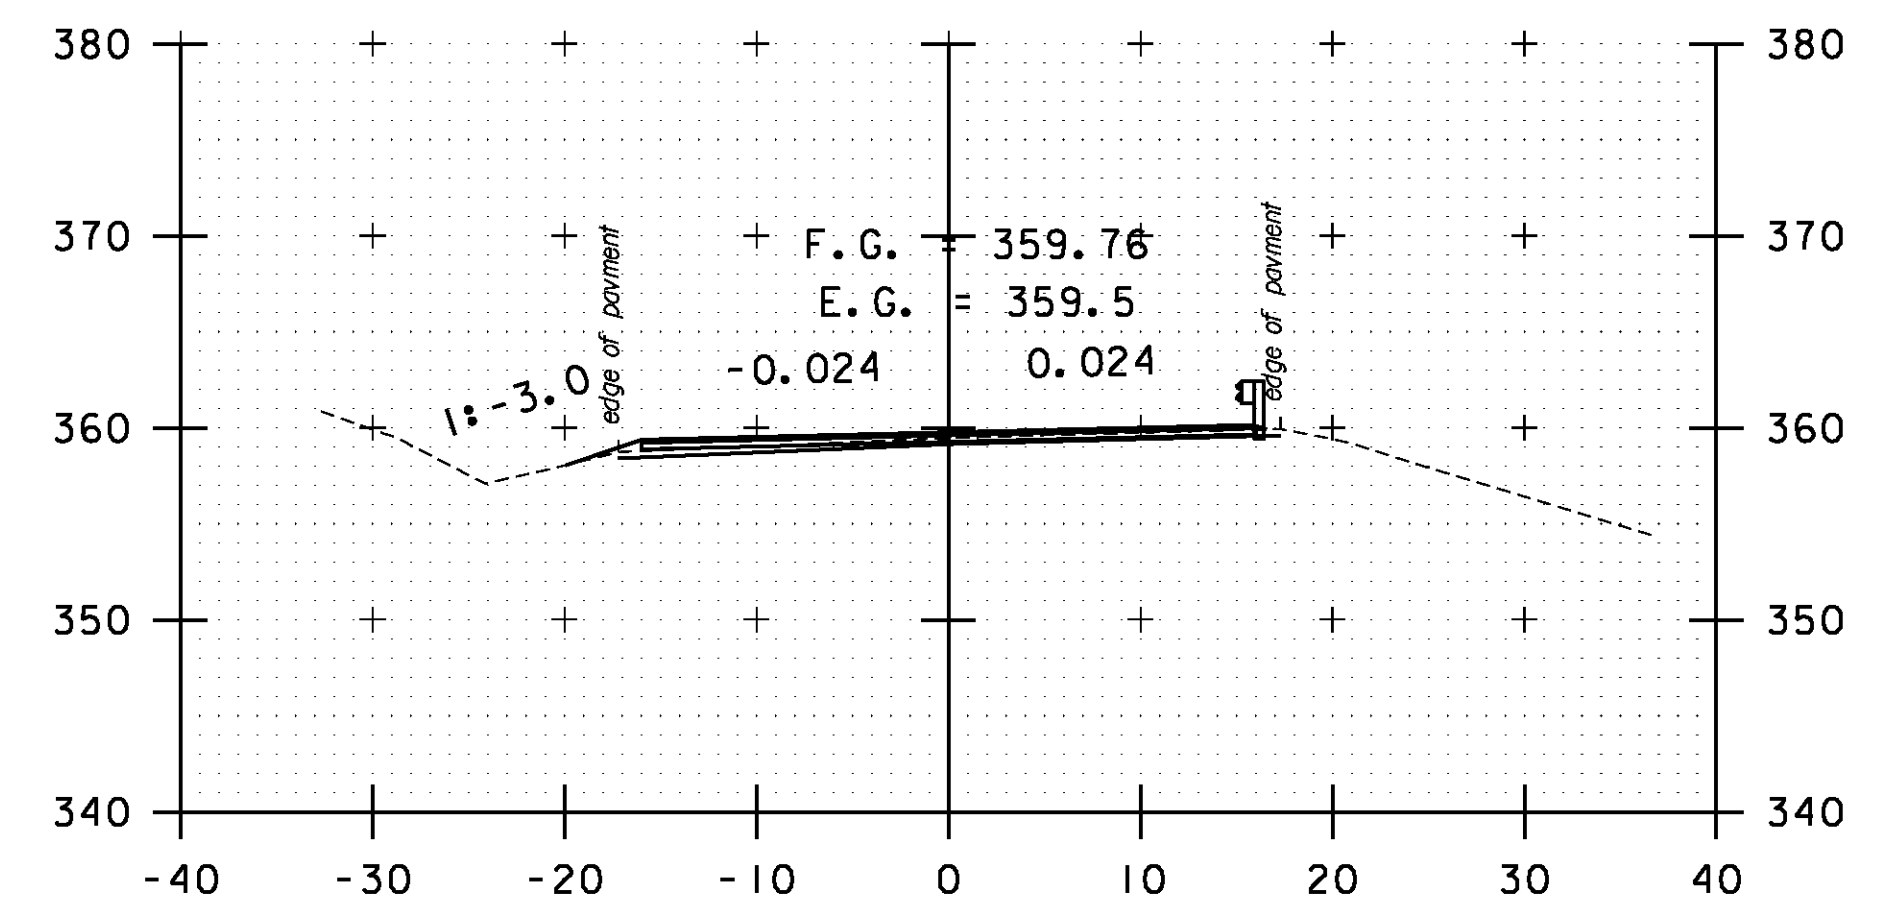

161+50

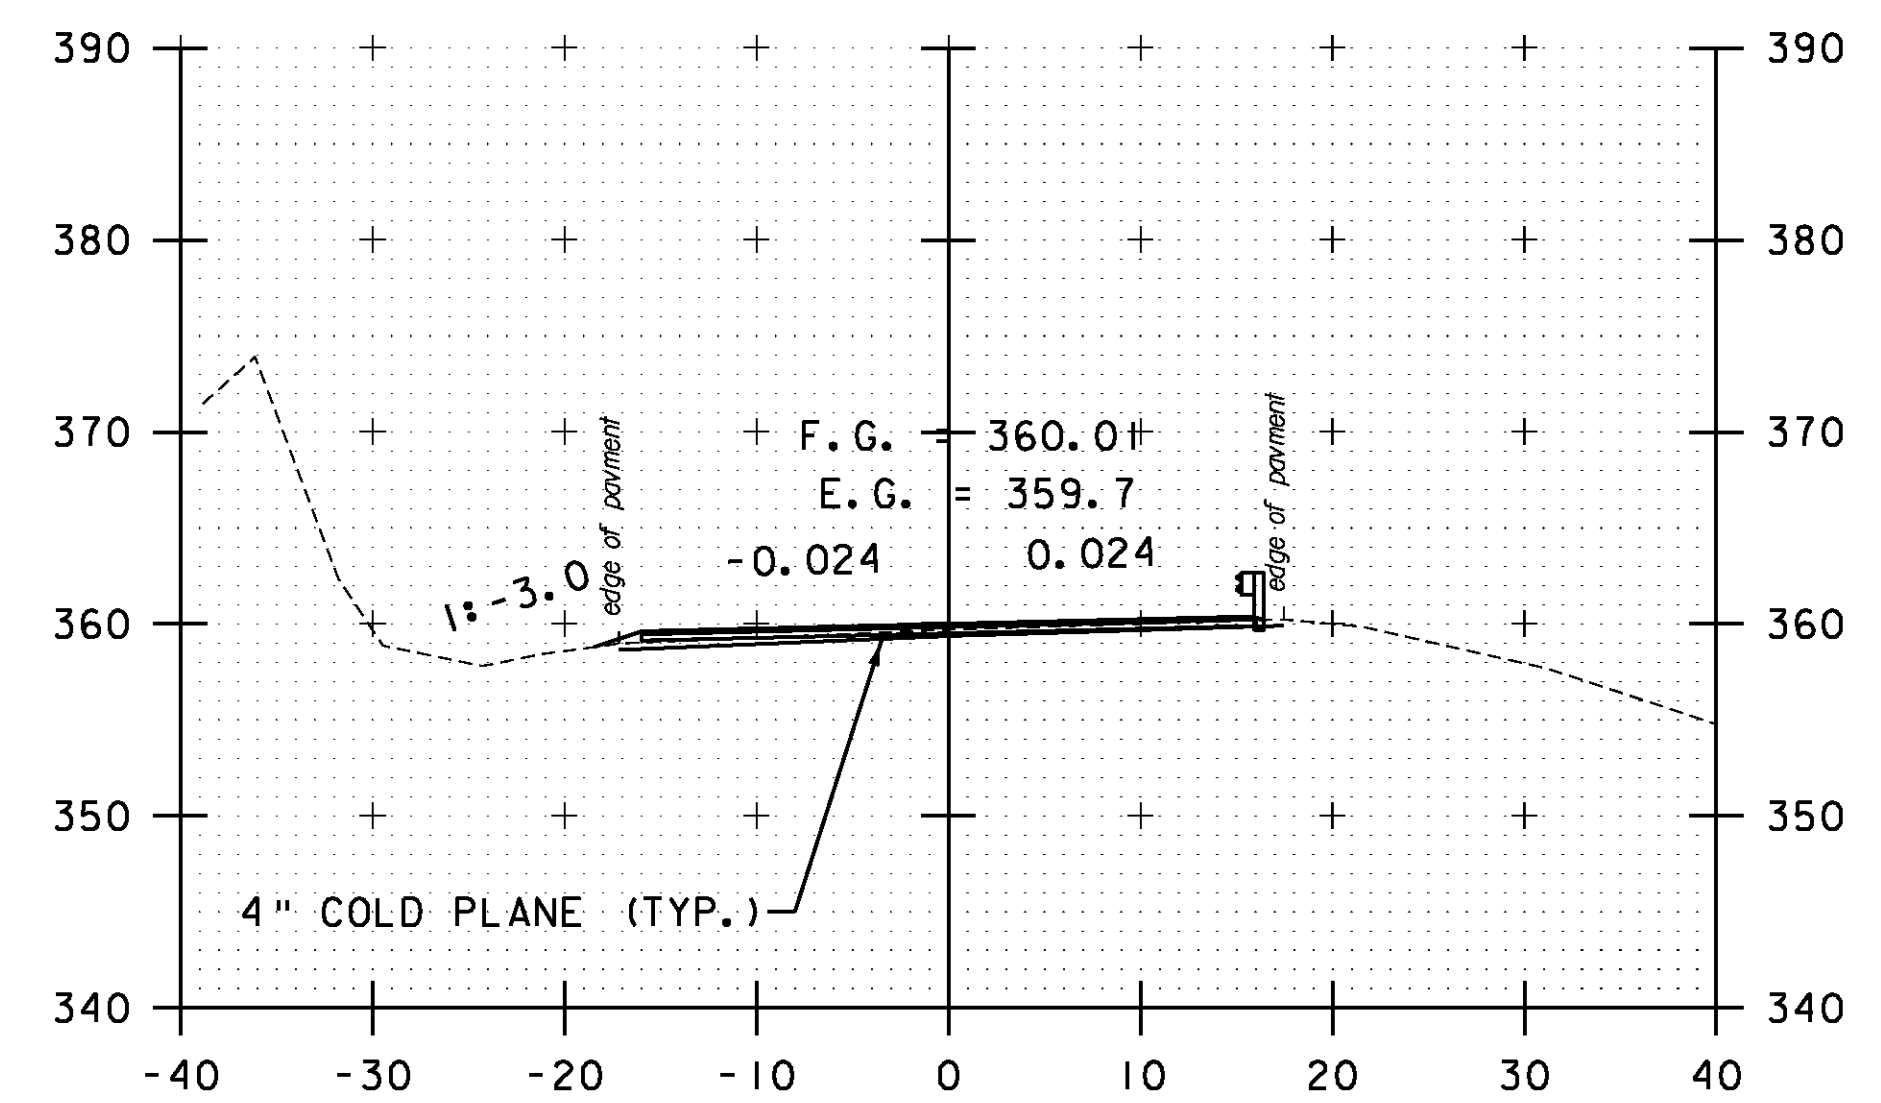

161+00

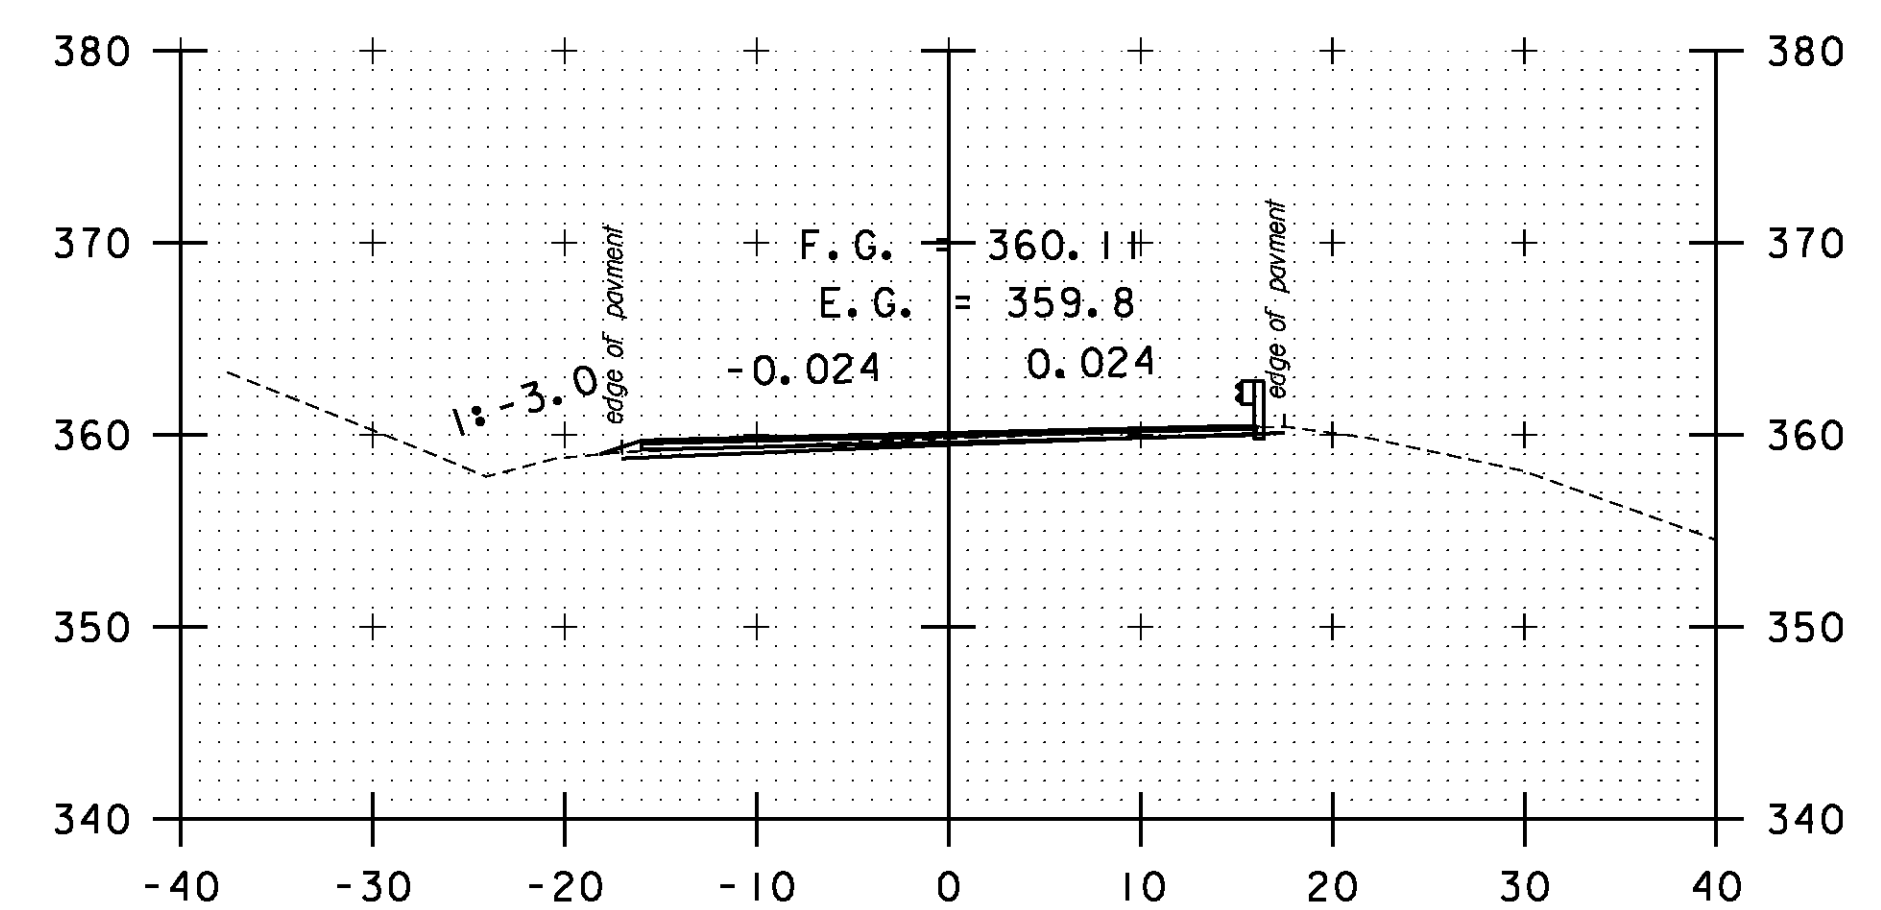

160+50

STA. 158+00 TO STA. 161+50

SCALE 1" = 10'-0"

CROSS SECTION SHEET 15

PROJECT NAME: BOLTON-WATERBURY

PROJECT NUMBER: STP 2709(1)

FILE NAME: p07C172.dgn

PROJECT LEADER: CDL

DESIGNED BY: BMB

PLOT FILE: p07C172_141.i

PLOT DATE: 4/16/2013

DRAWN BY: BMB

CHECKED BY: CDL

SHEET 141 OF 217