




167+00

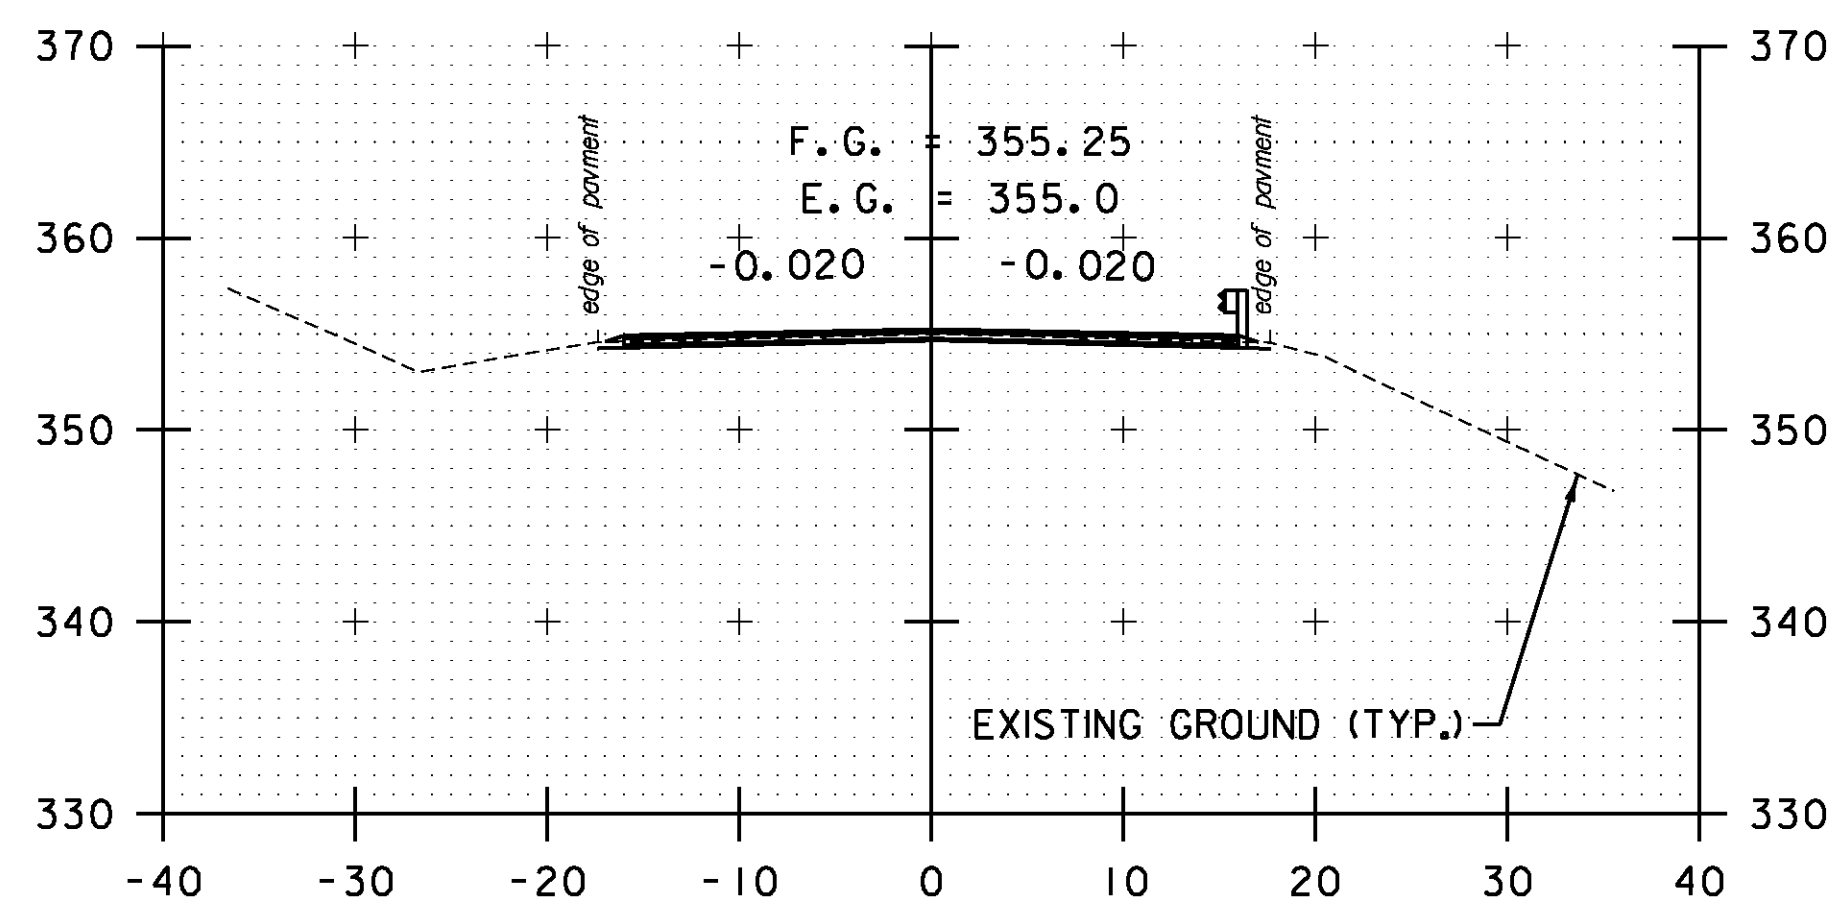


166+50

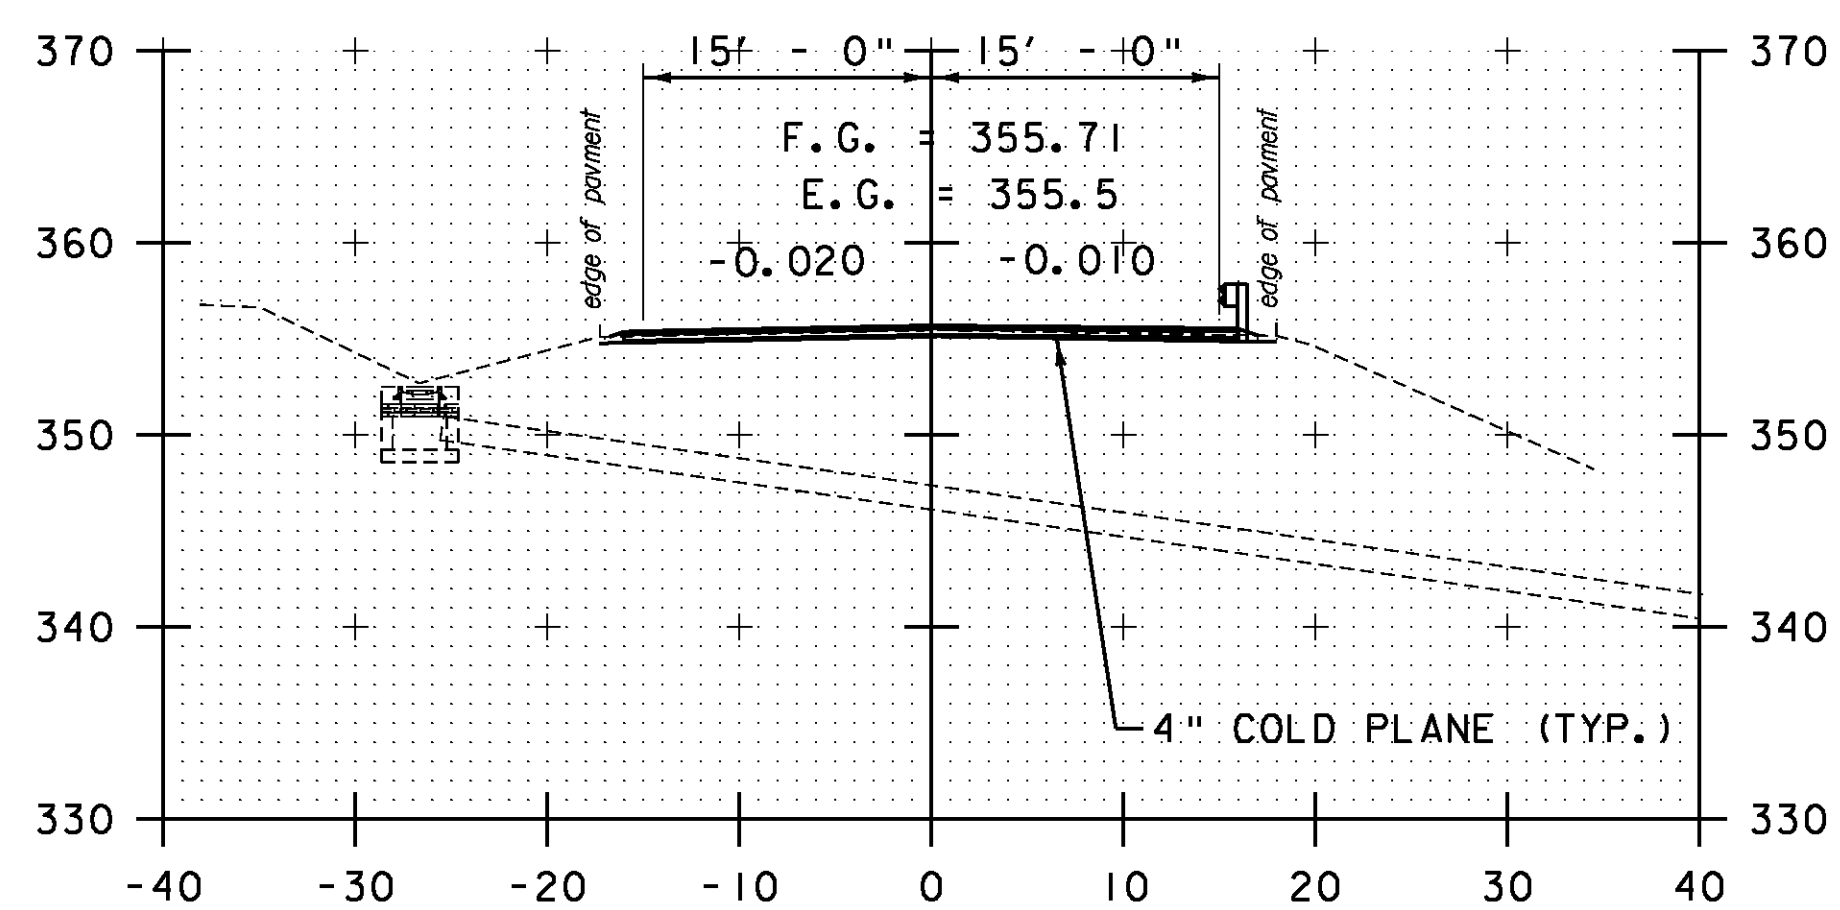


166+00

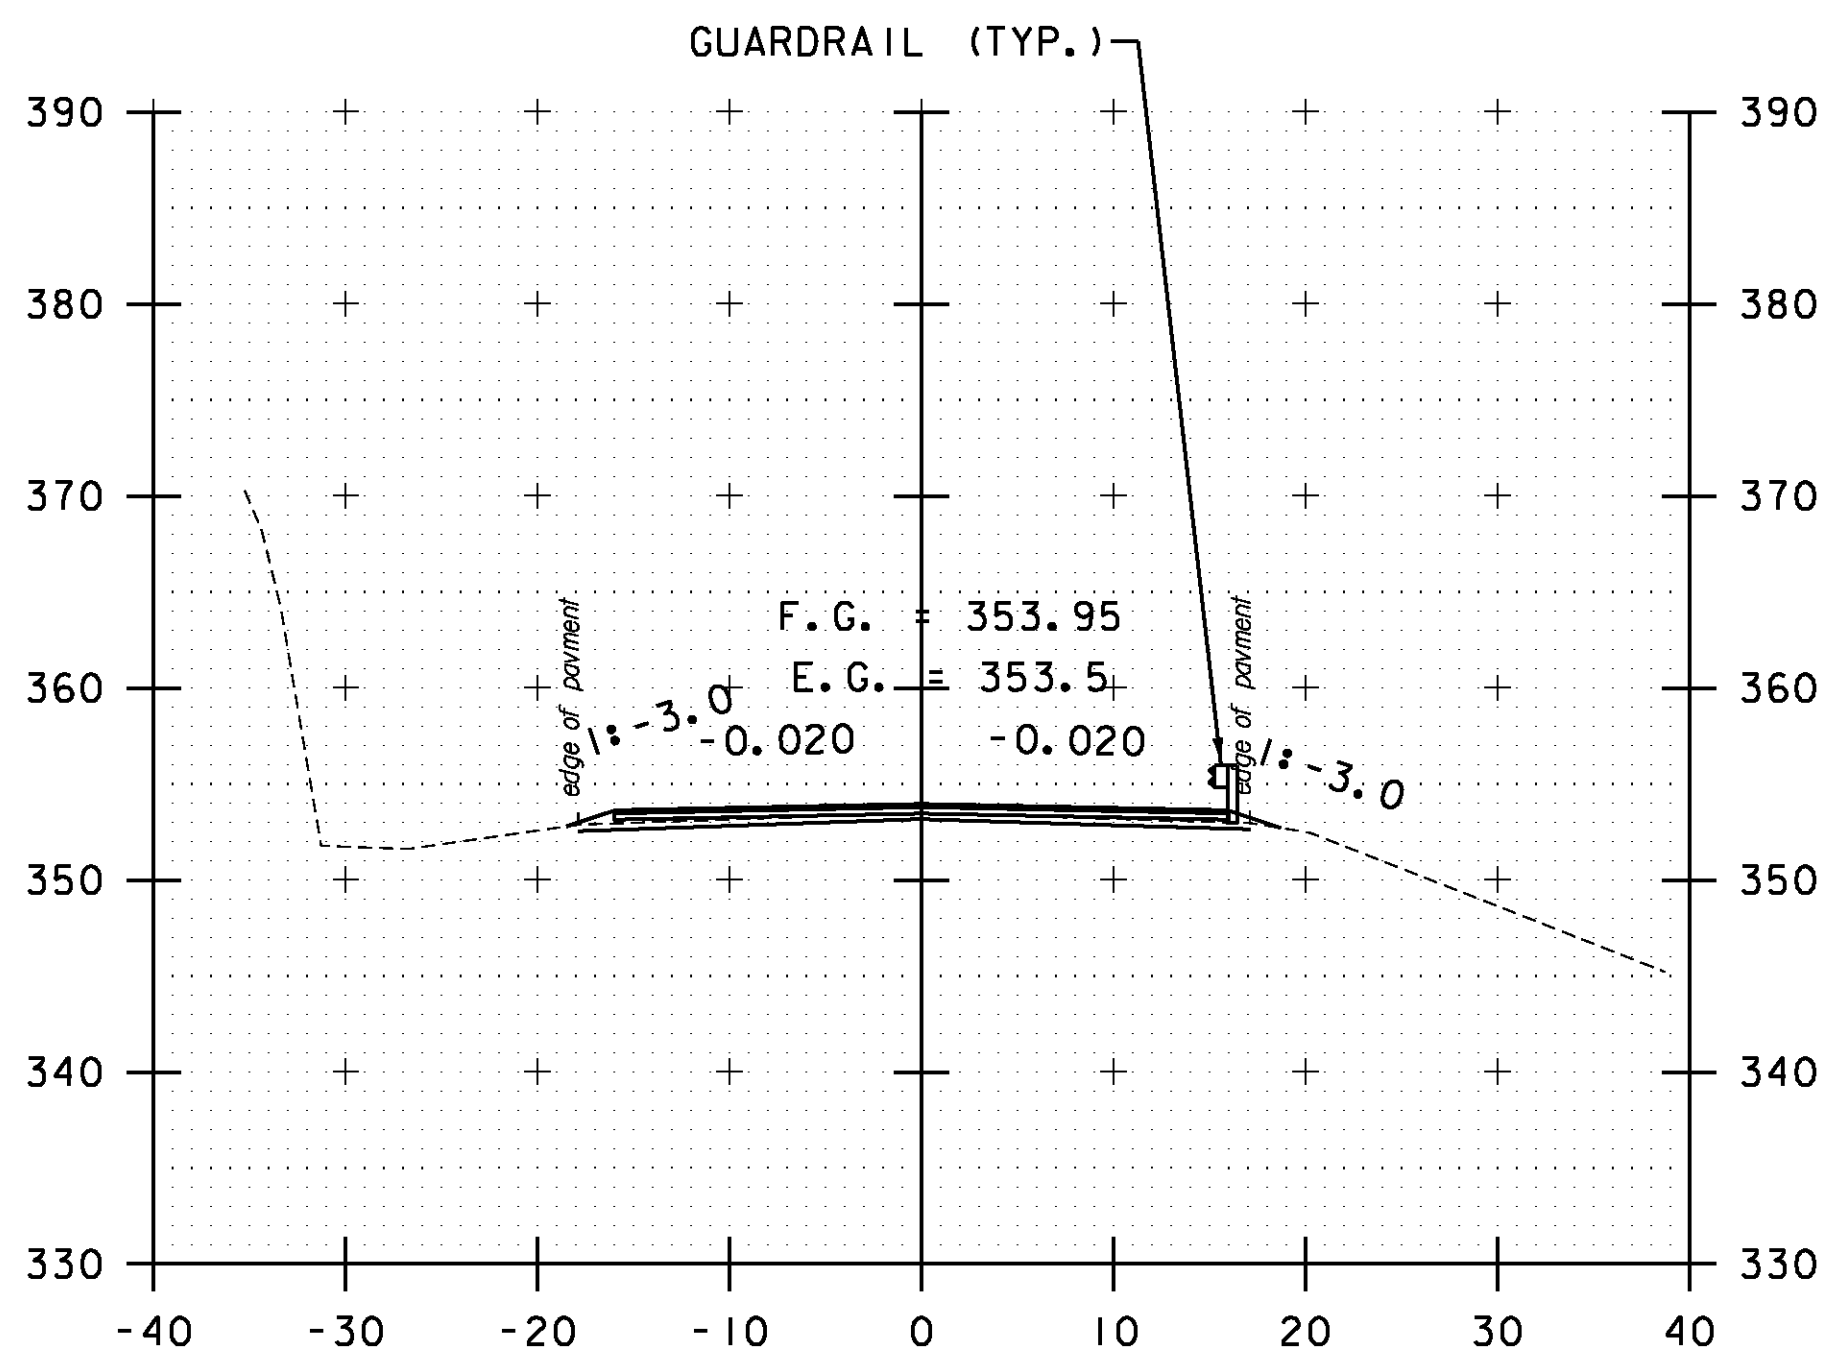


168+00

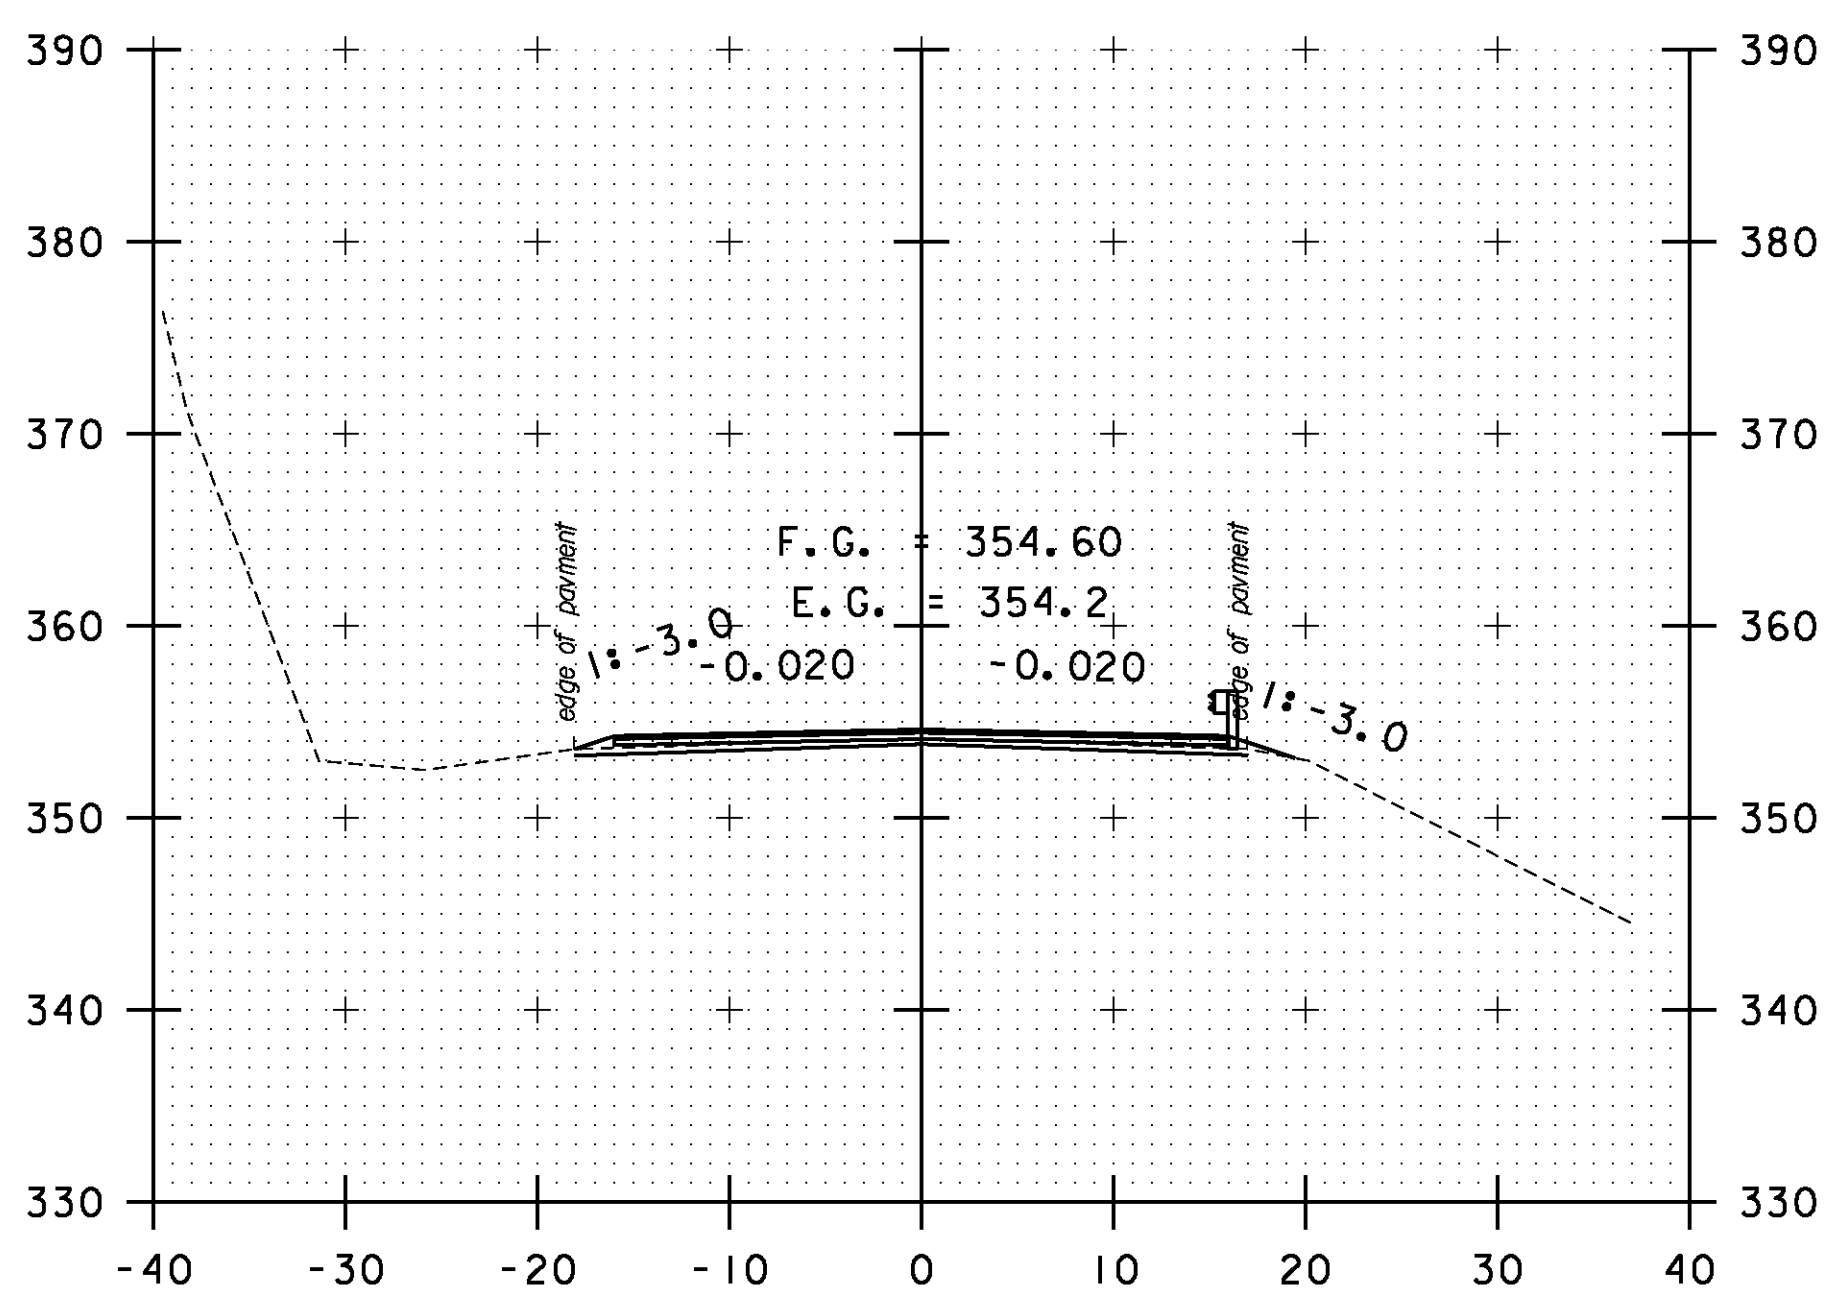


167+50

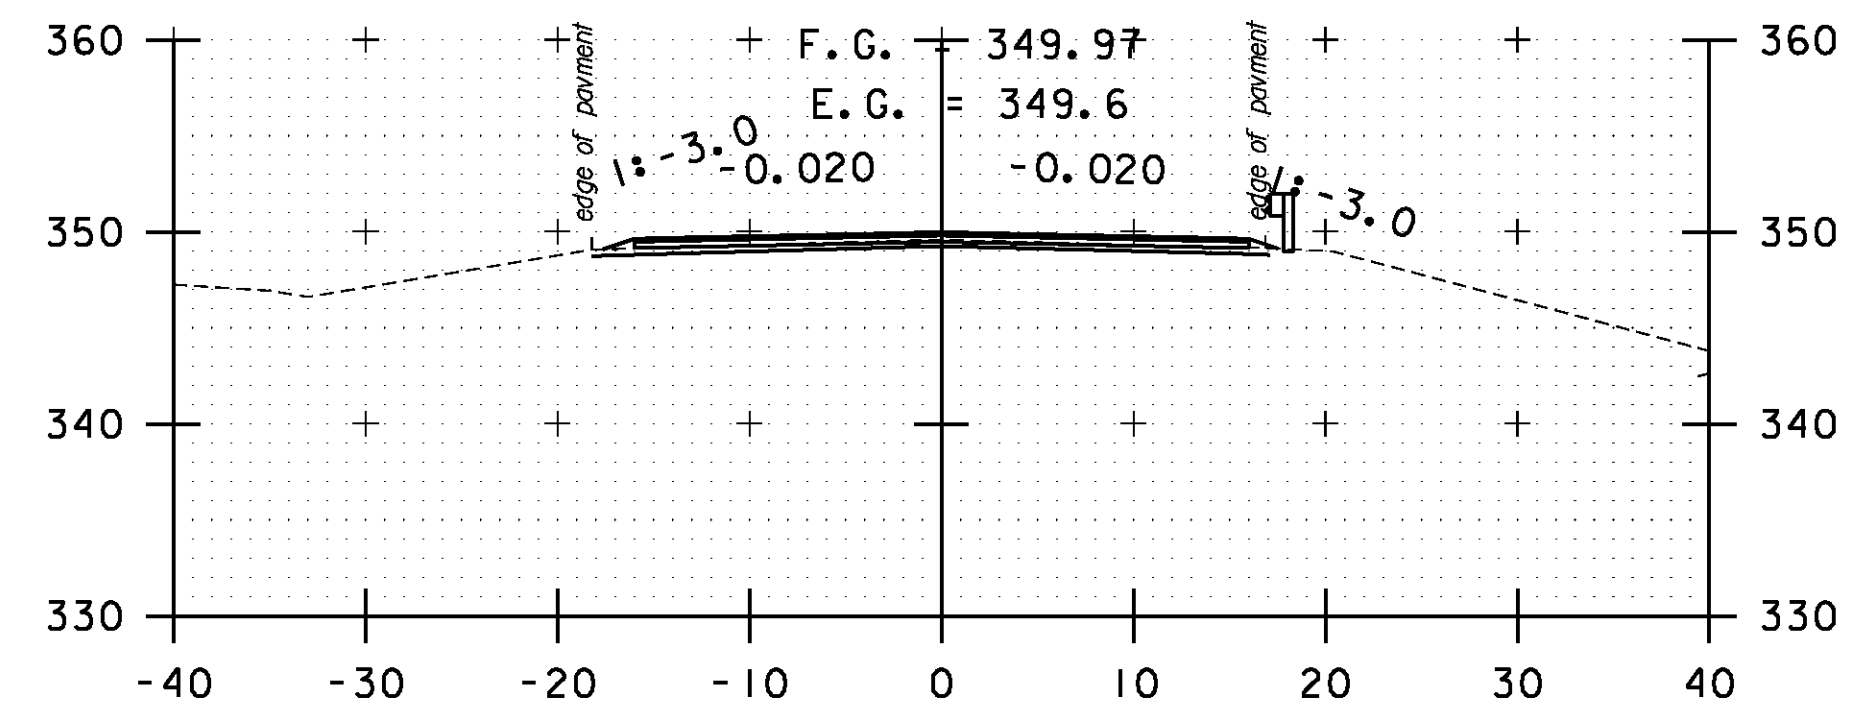

169+50

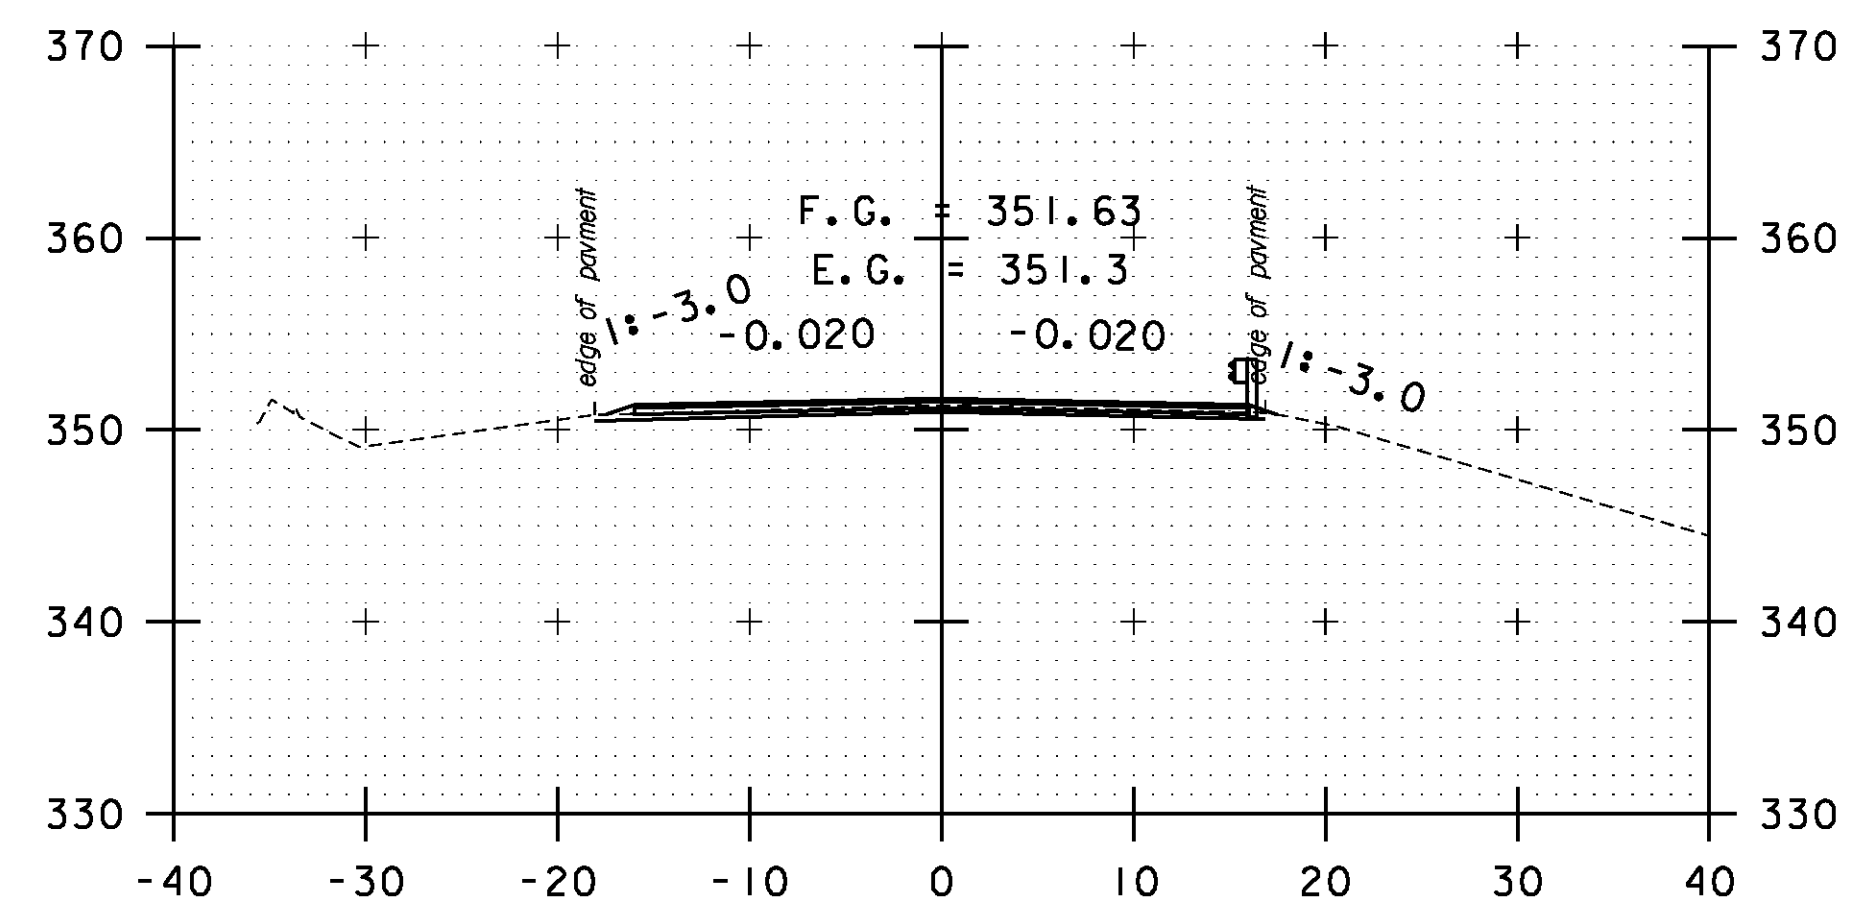


169+00

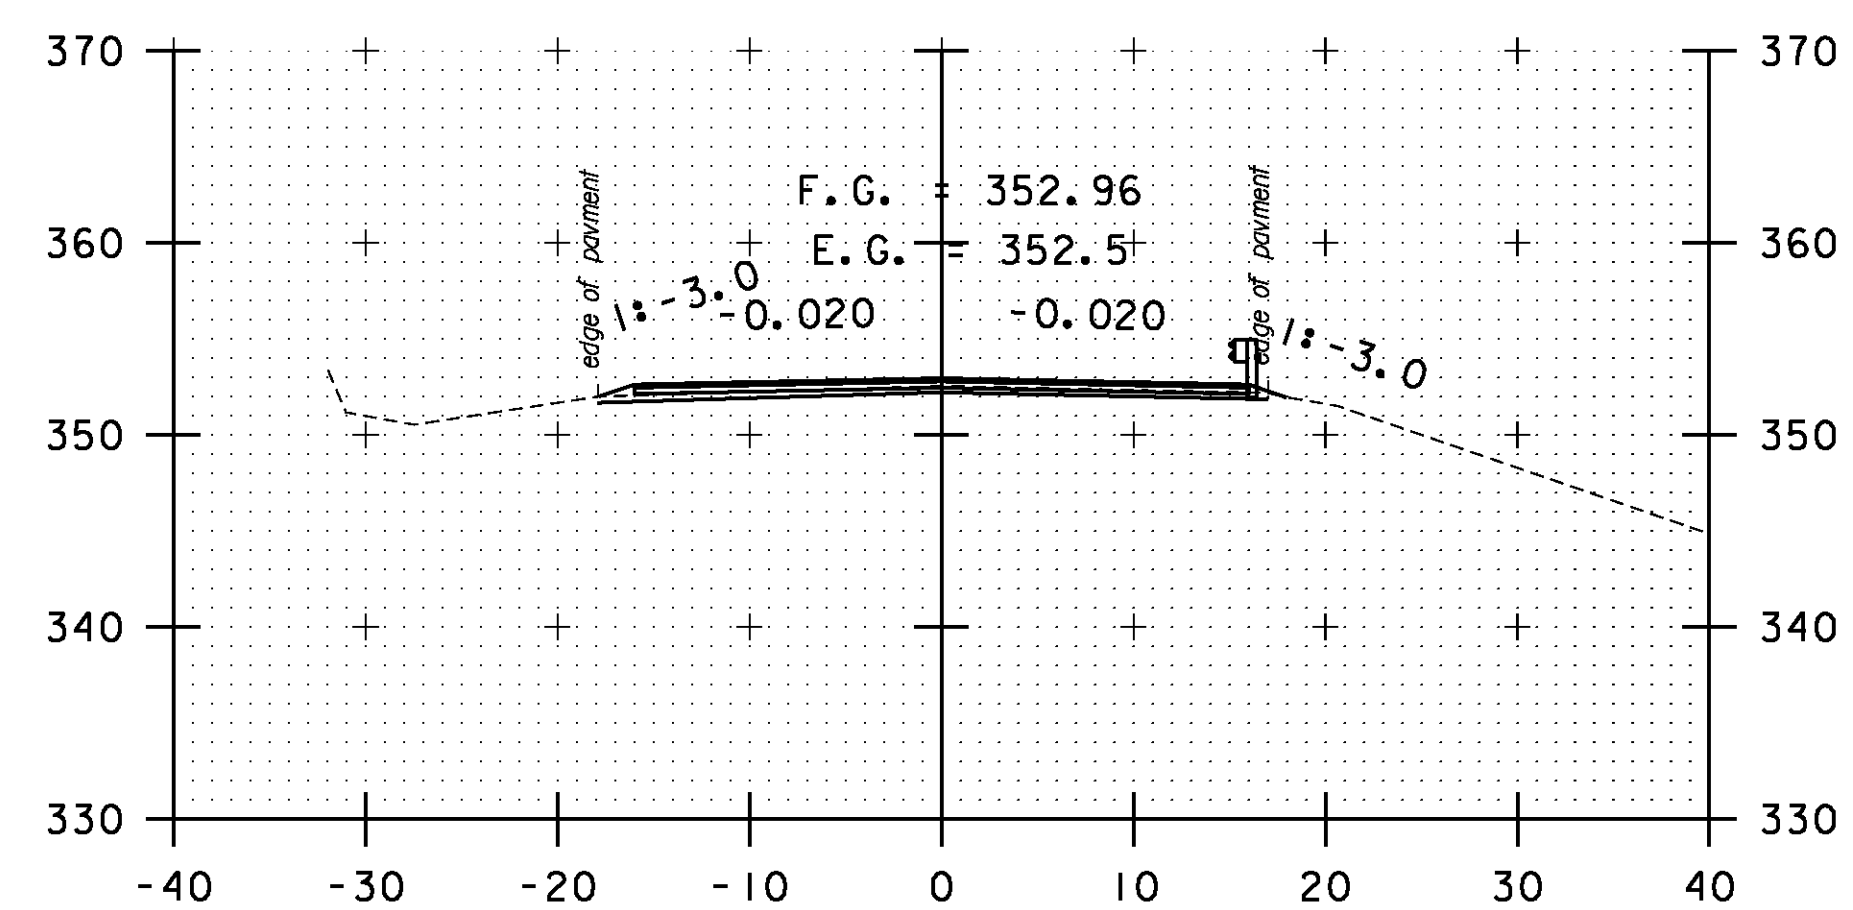

168+50

STA. 166+00 TO STA. 169+50

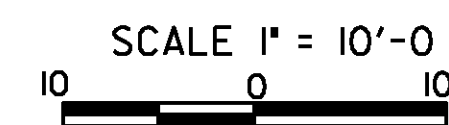

**CROSS SECTION SHEET 17**

PROJECT NAME: BOLTON-WATERBURY

PROJECT NUMBER: STP 2709(I)

FILE NAME: p07C172.dgn

PROJECT LEADER: CDL

DESIGNED BY: BMB

PLOT FILE: p07C172\_143.1

PLOT DATE: 4/16/2013

DRAWN BY: BMB

CHECKED BY: CDL

SHEET 143 OF 217