




DRIVE LT  
175+50

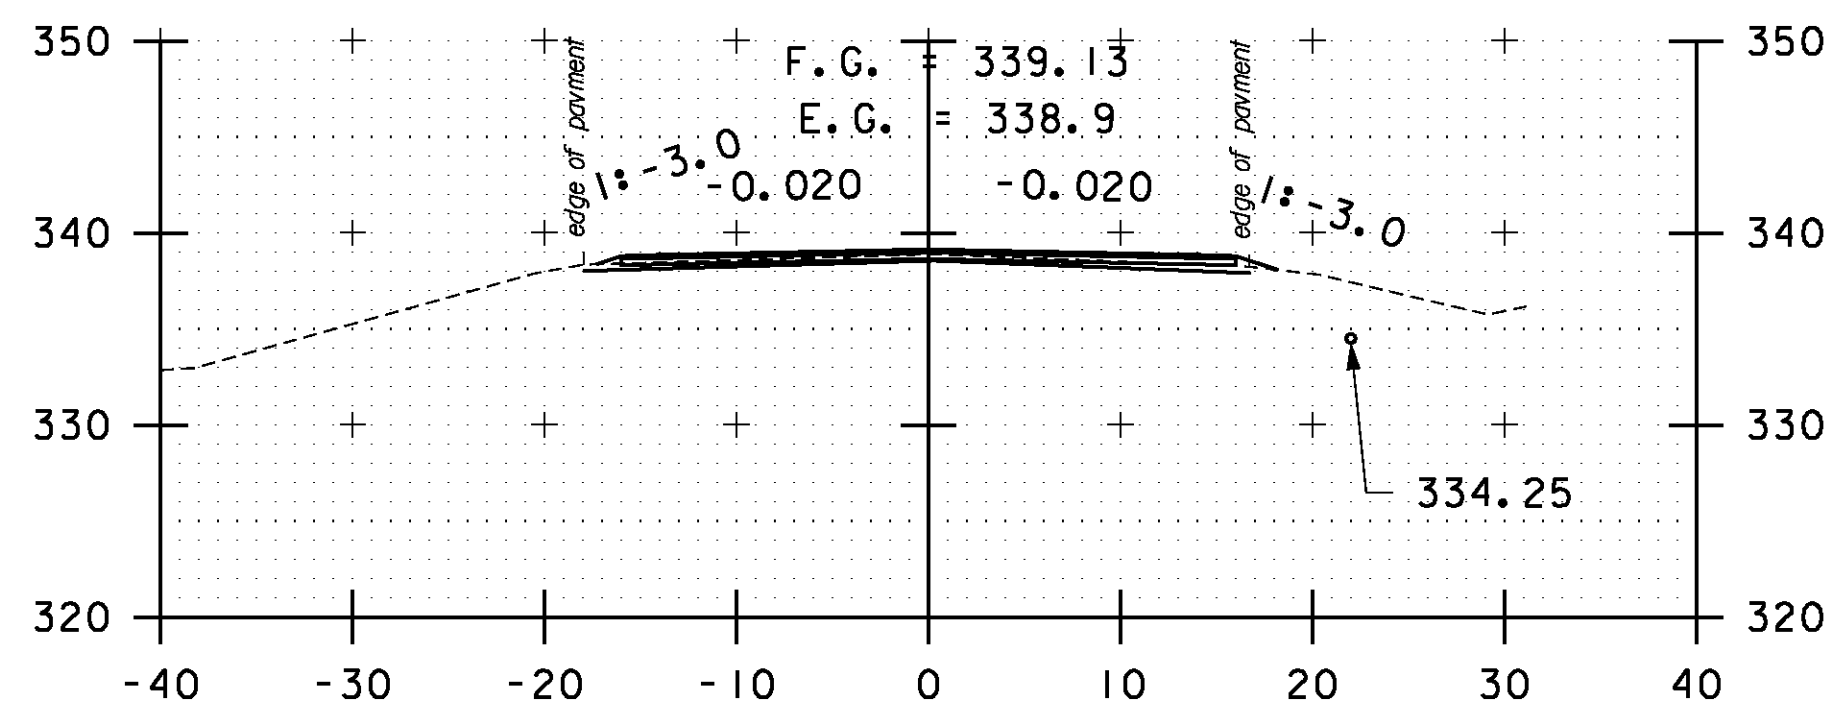


177+00

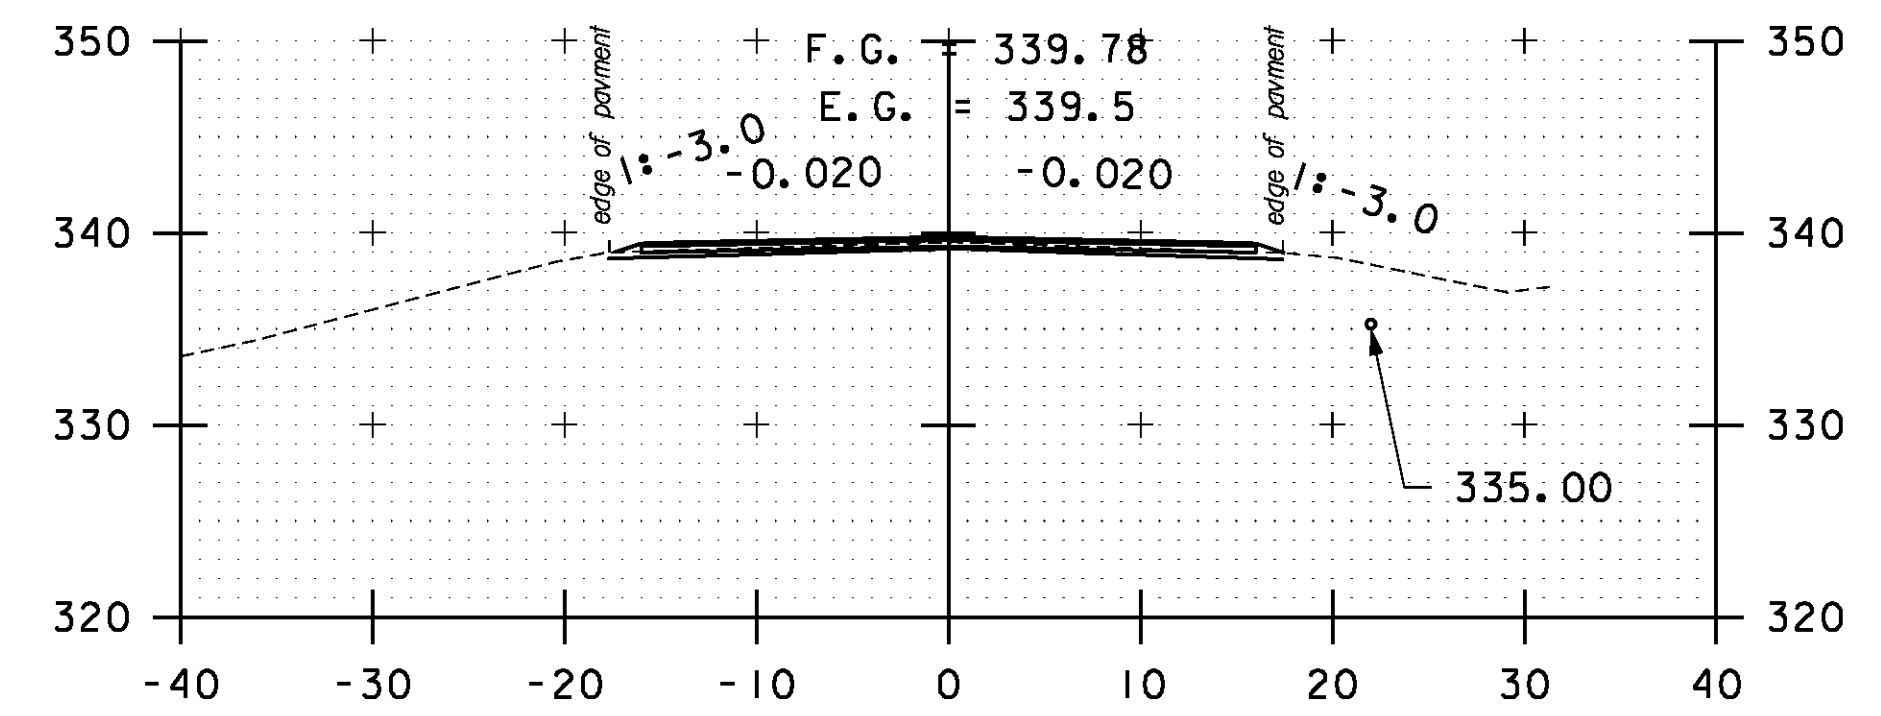


178+50

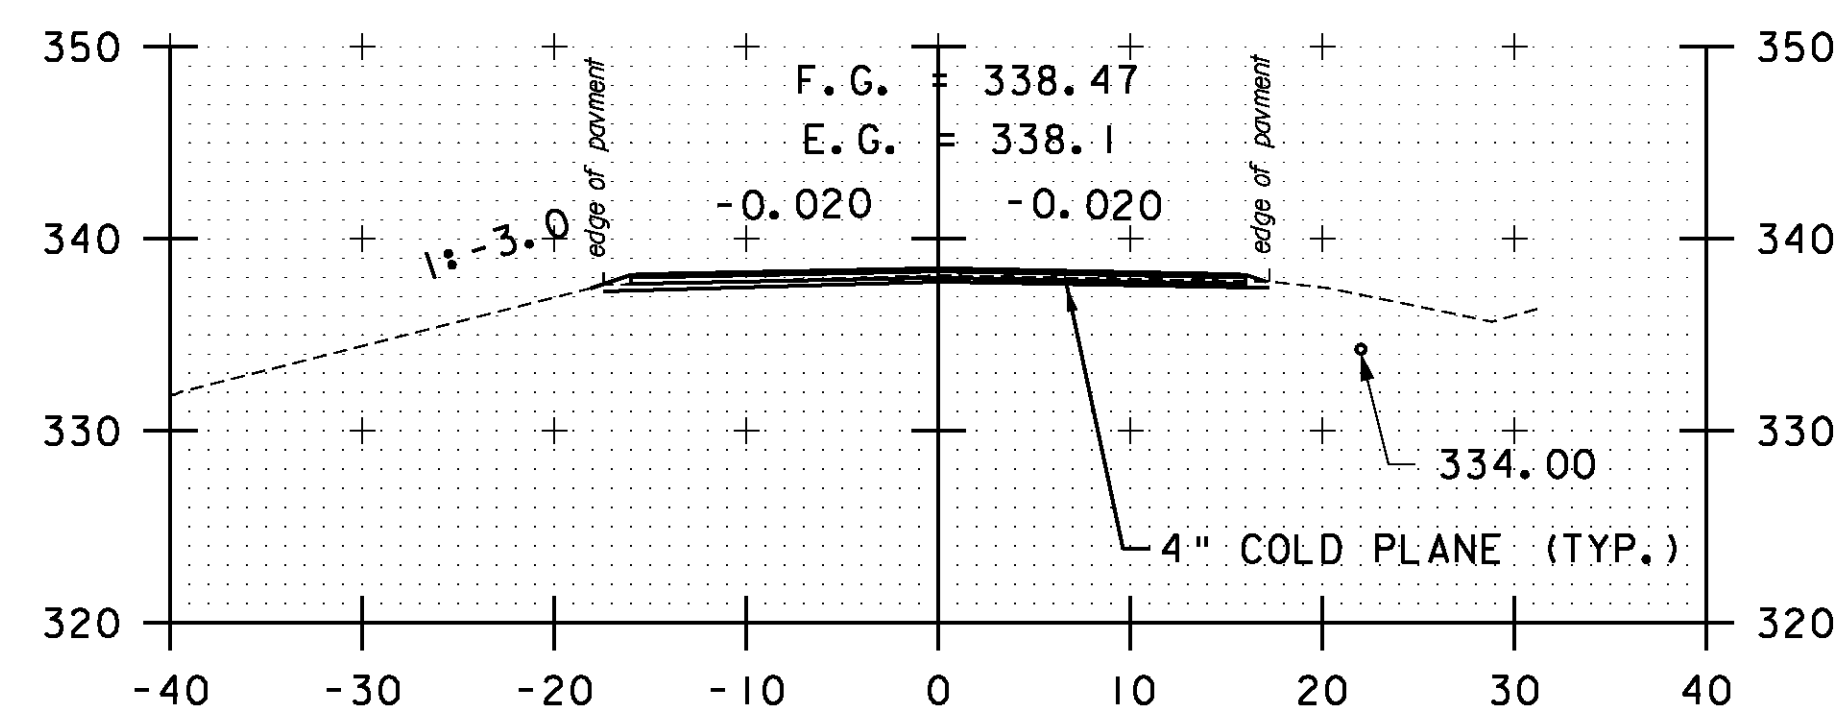


175+00

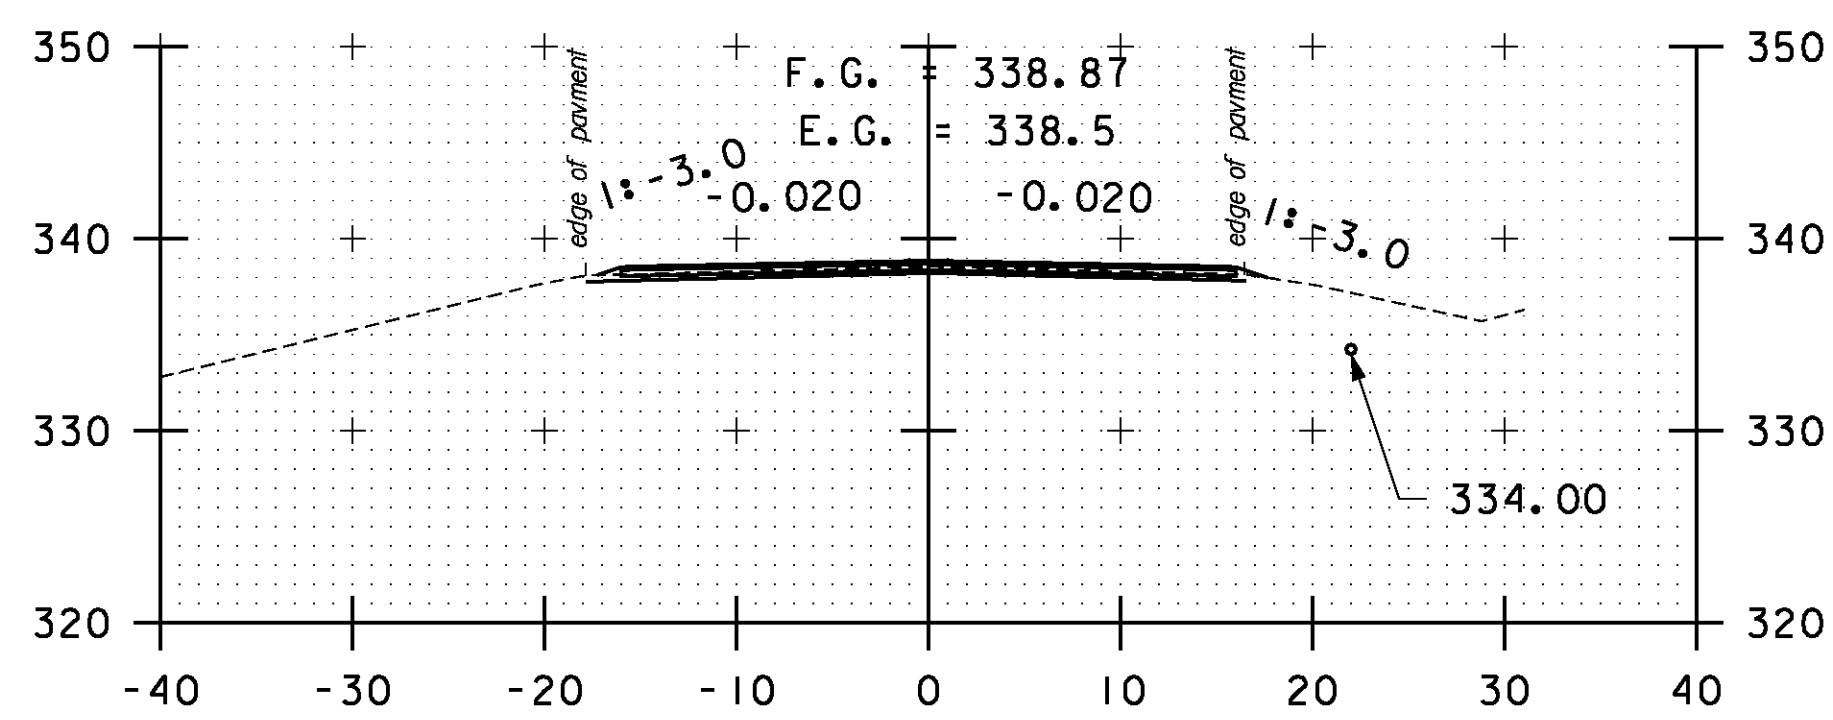


176+50

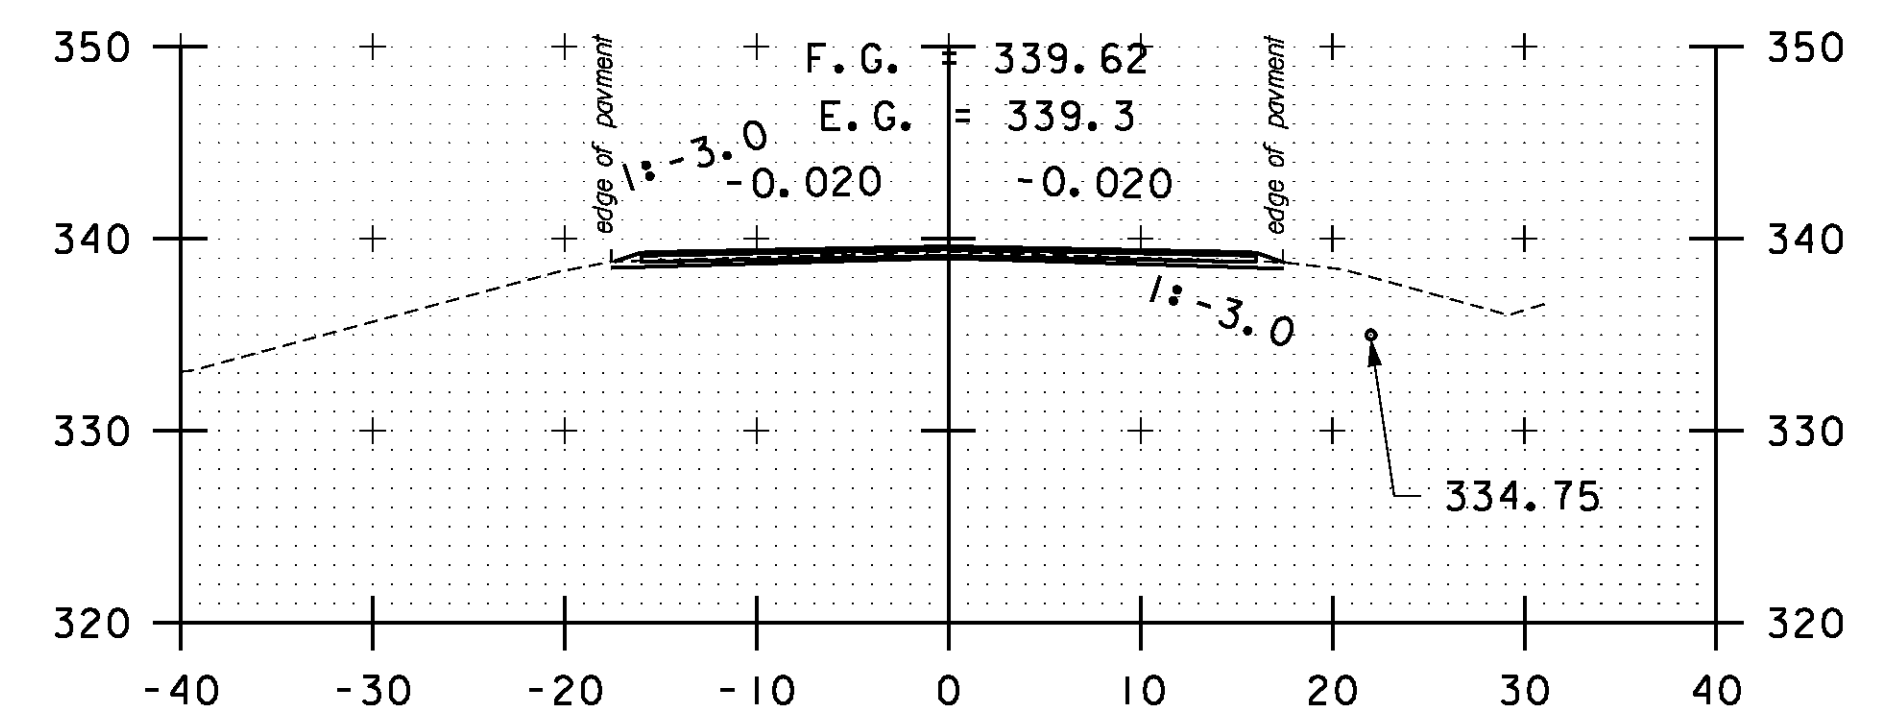


178+00

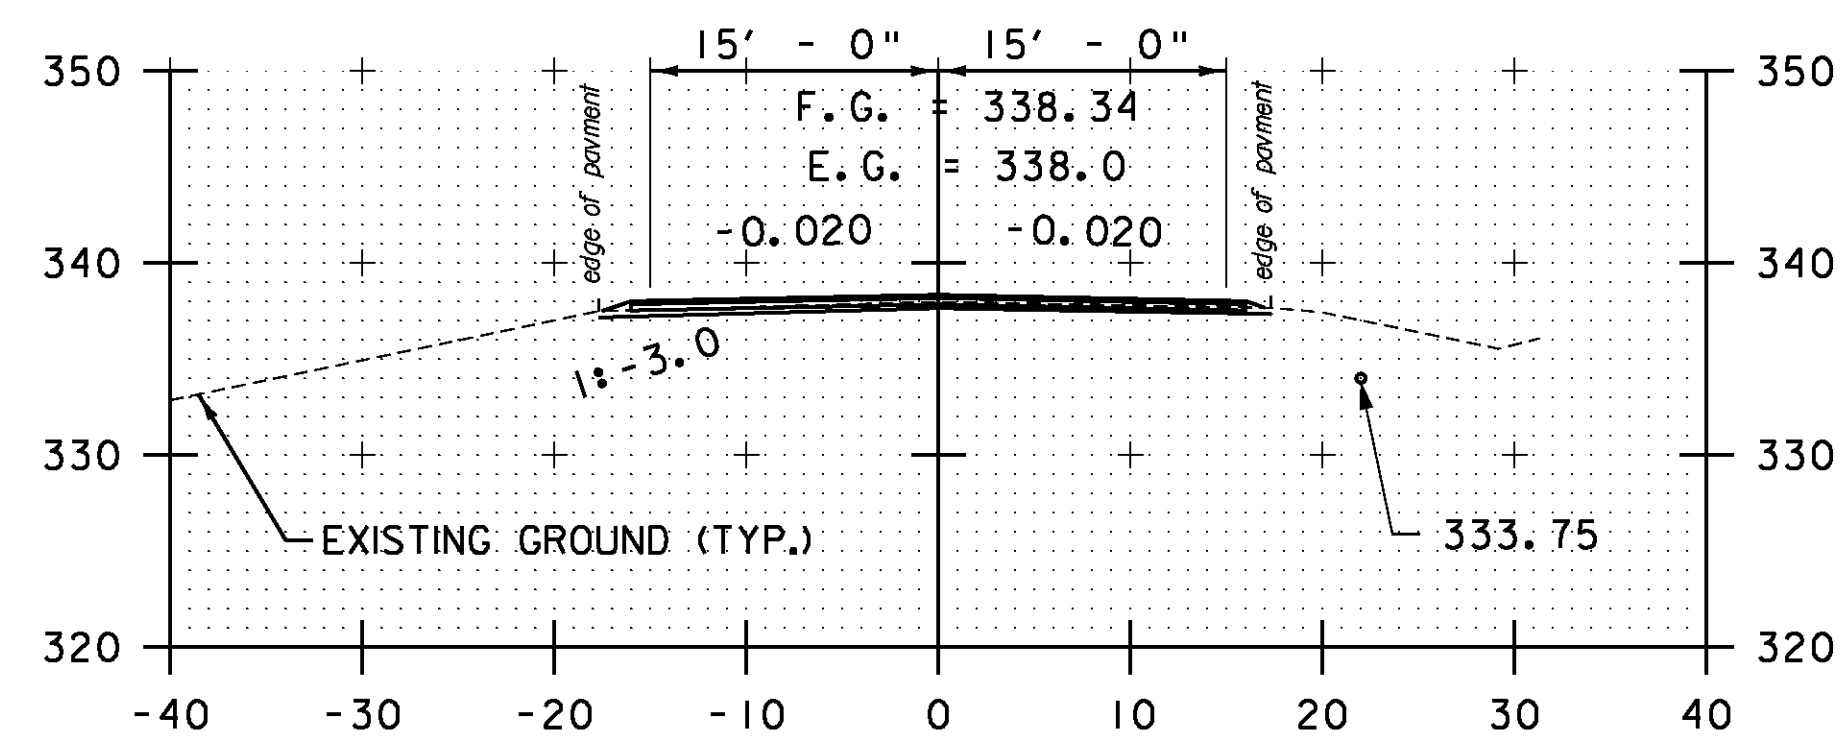

174+50

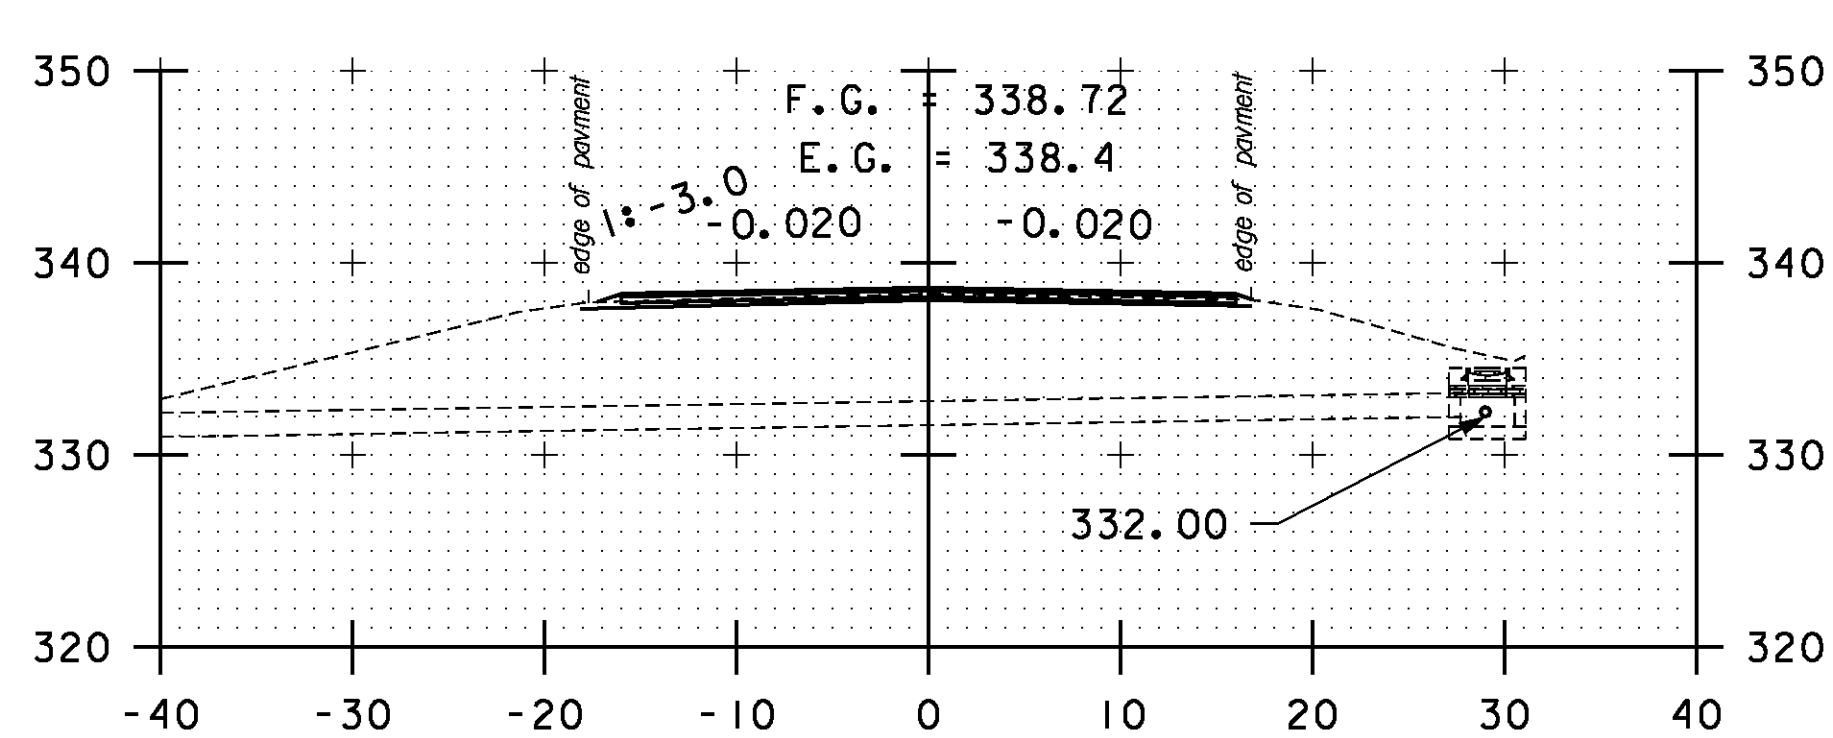

176+00

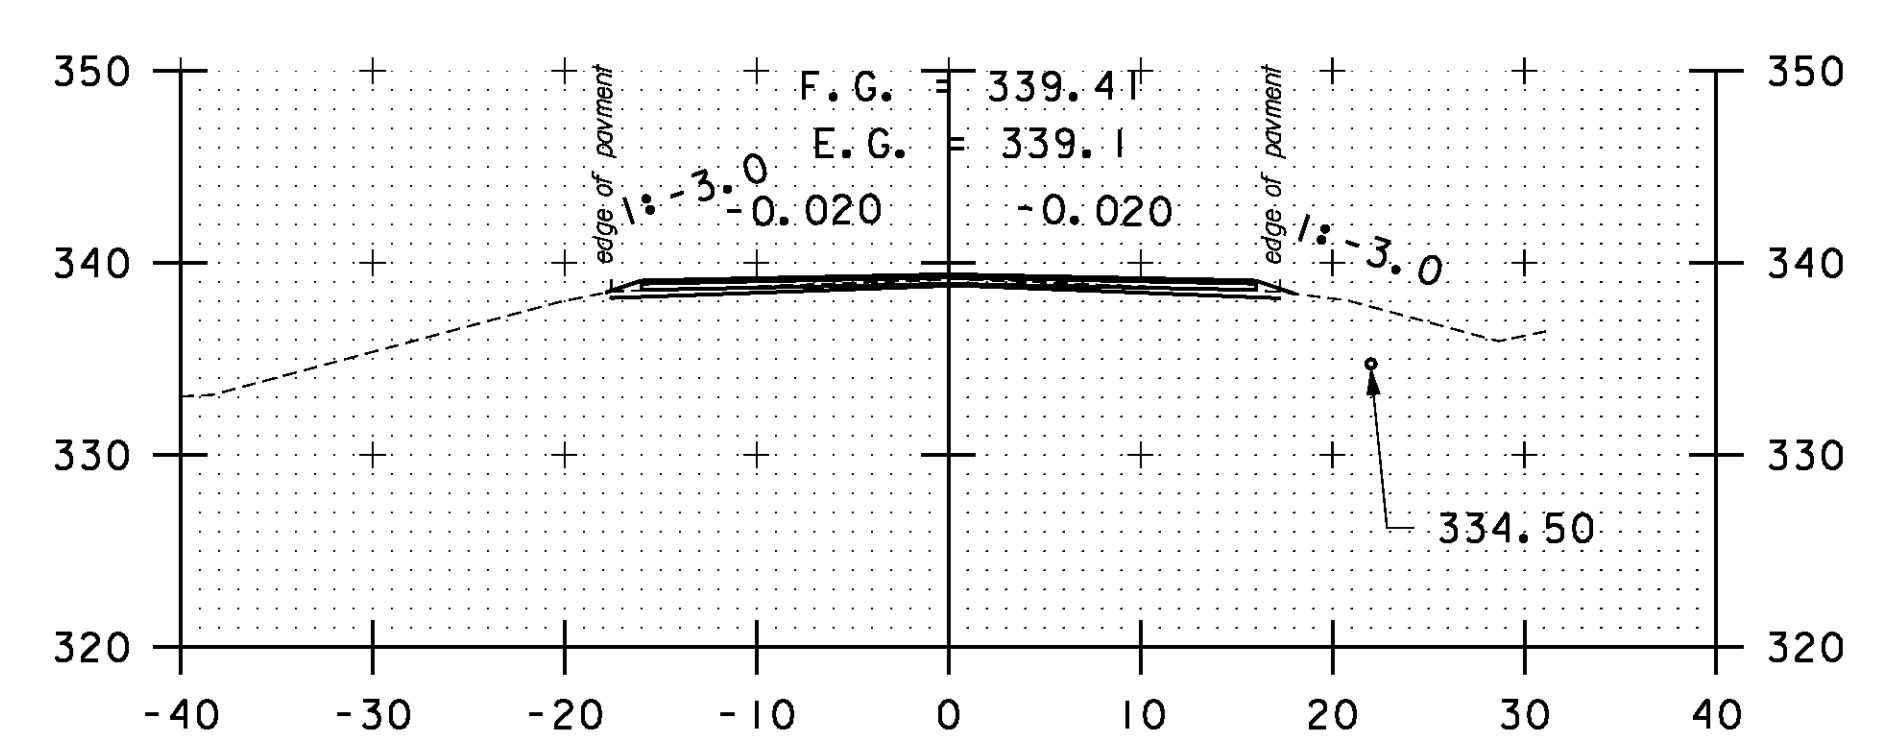

177+50

STA. 174+50 TO STA. 178+50

SCALE 1" = 10'-0"  
0 10

**CROSS SECTION SHEET 19**

PROJECT NAME: BOLTON-WATERBURY

PROJECT NUMBER: STP 2709(1)

FILE NAME: p07C172.dgn

PROJECT LEADER: CDL

DESIGNED BY: BMB

PLOT FILE: p07C172\_145.1

PLOT DATE: 4/16/2013

DRAWN BY: BMB

CHECKED BY: CDL

SHEET 145 OF 217