




180+00

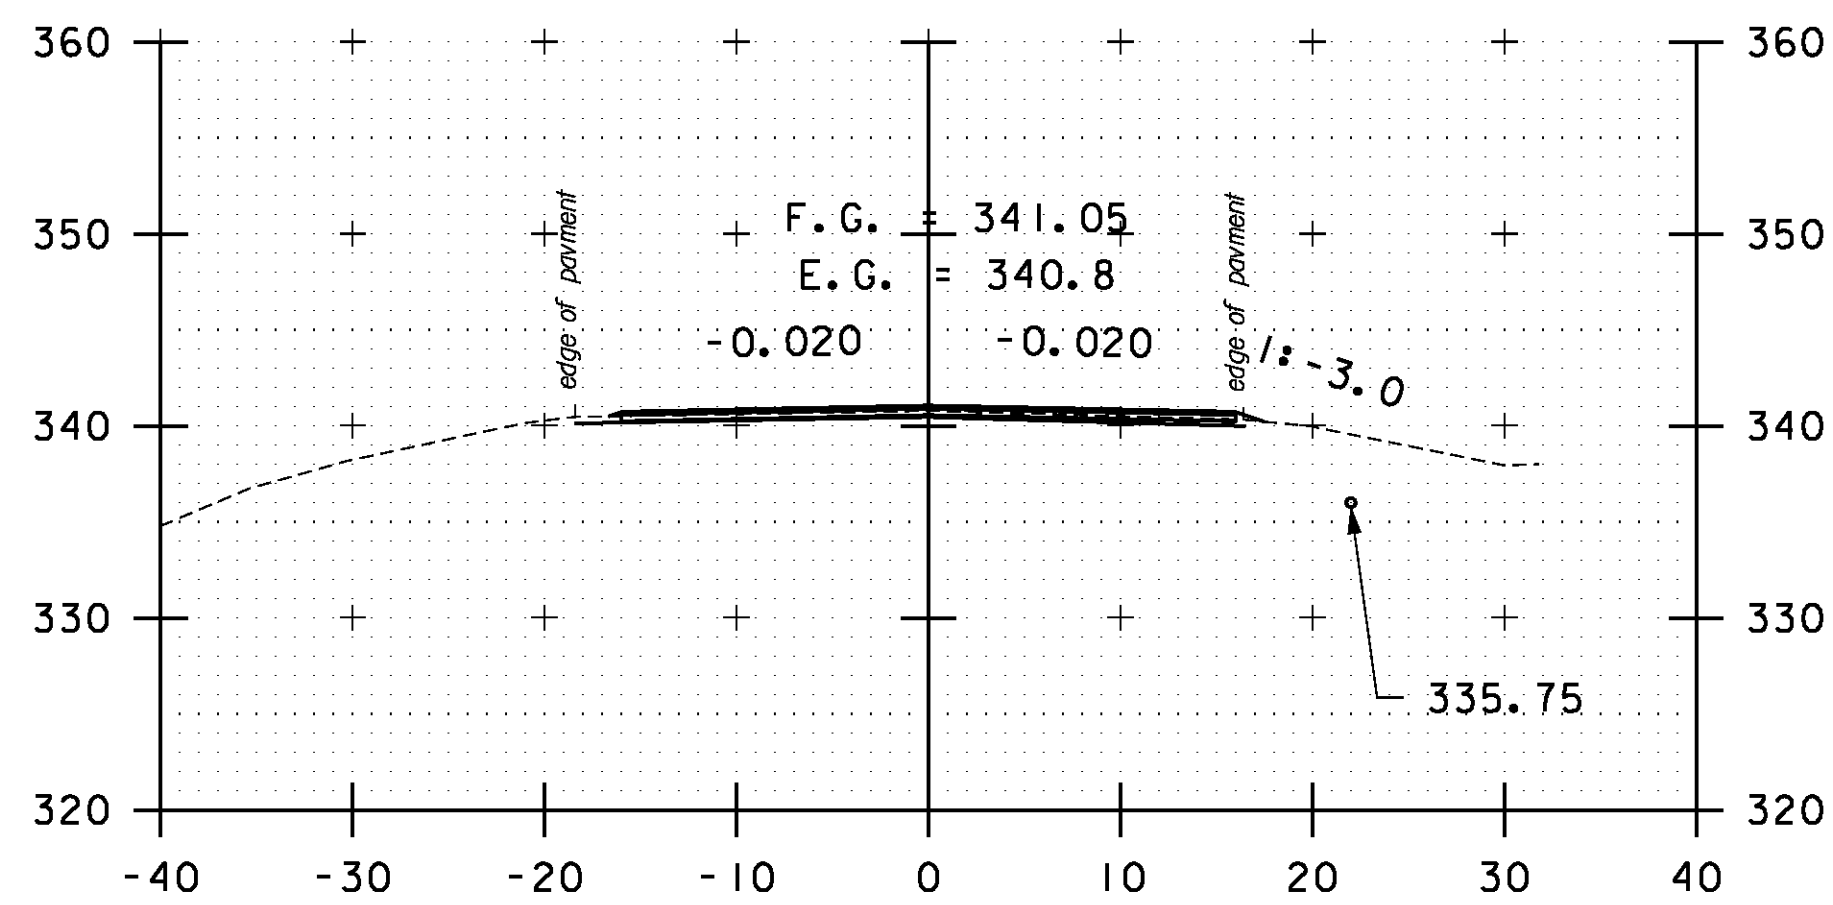


181+50

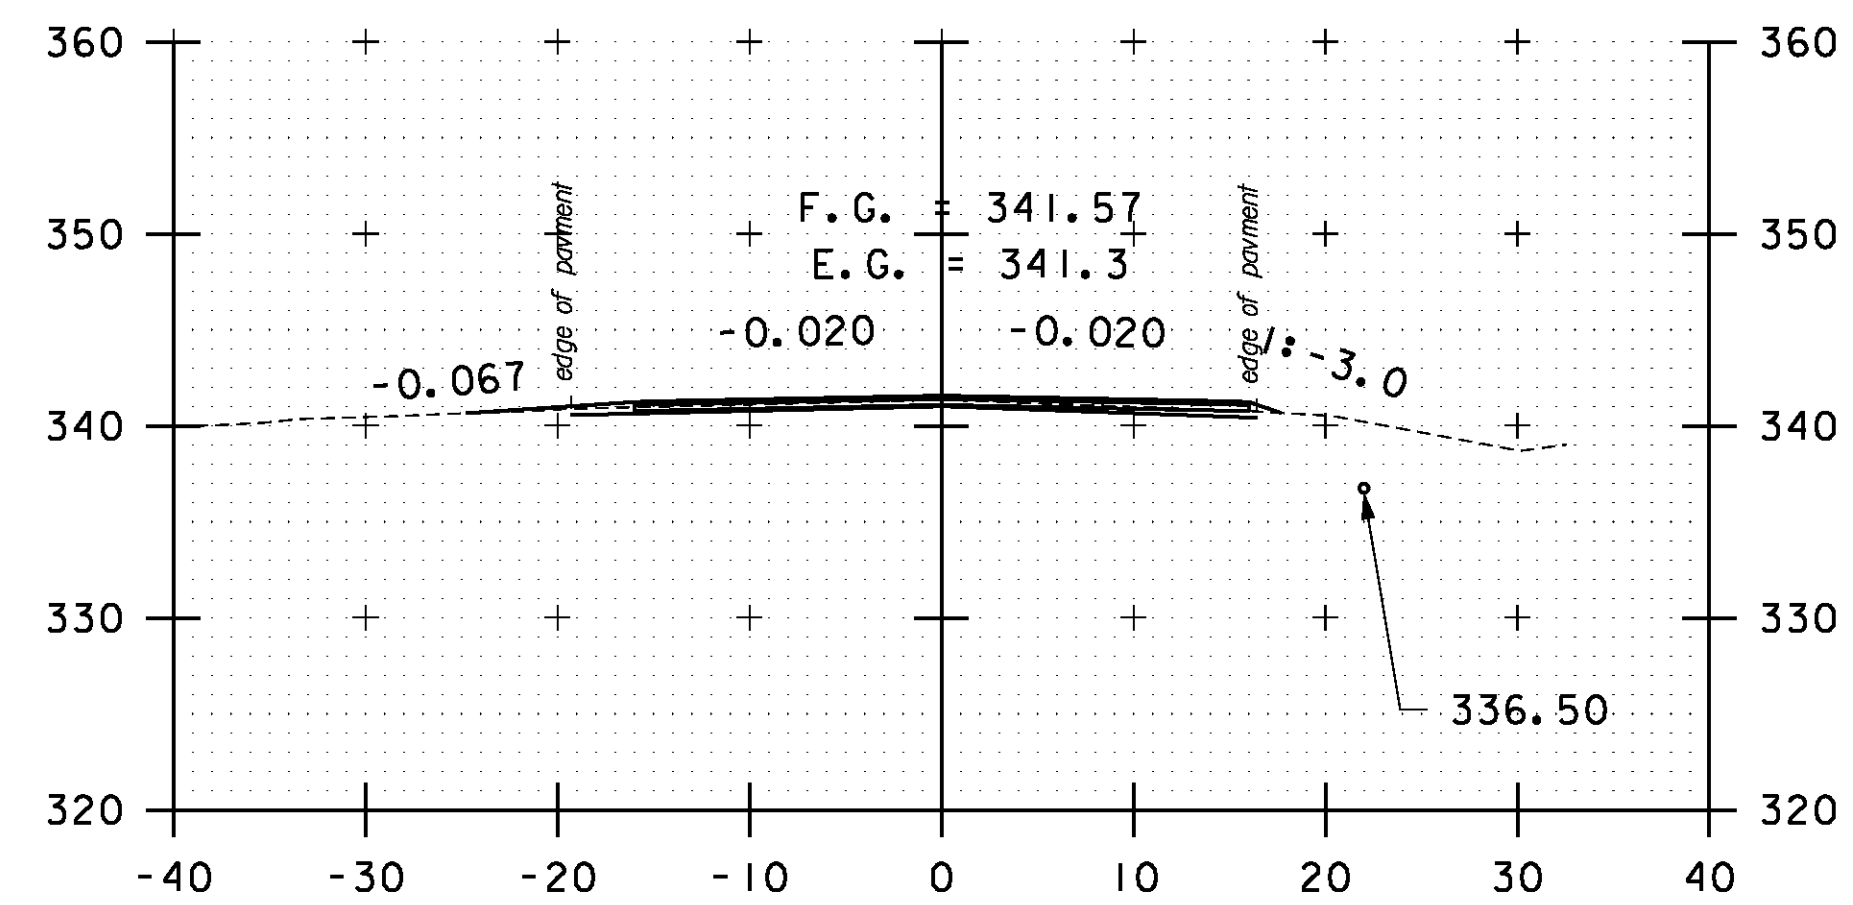


DRIVE LT
183+00

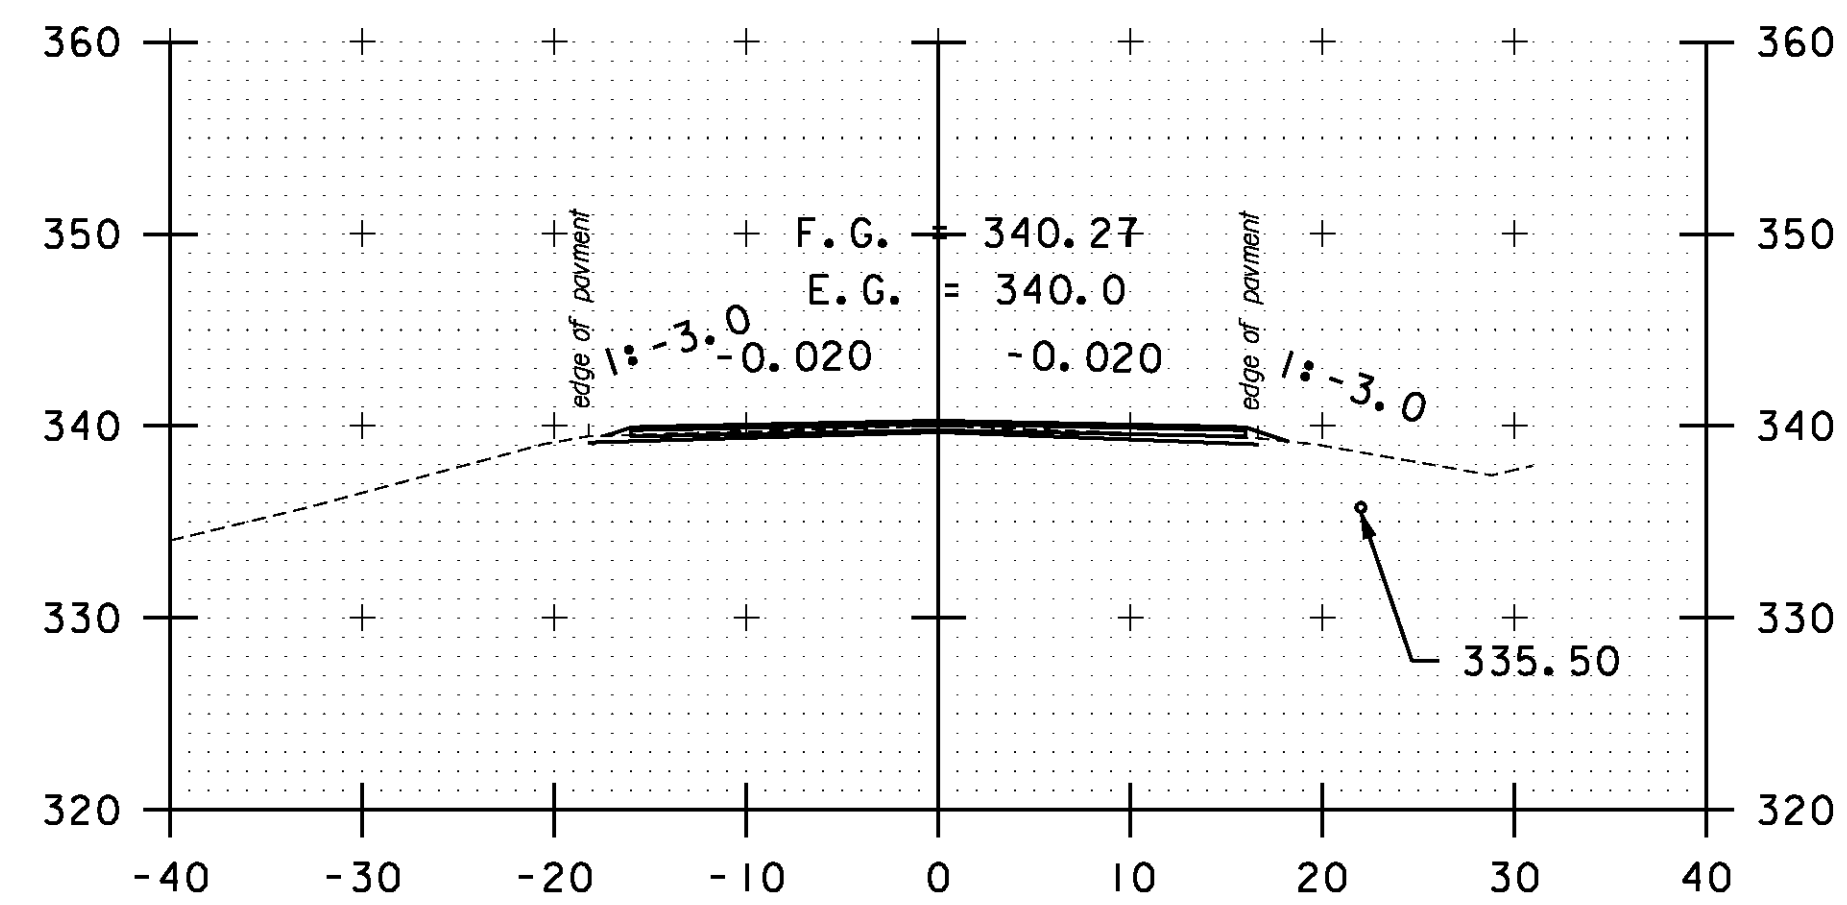


179+50

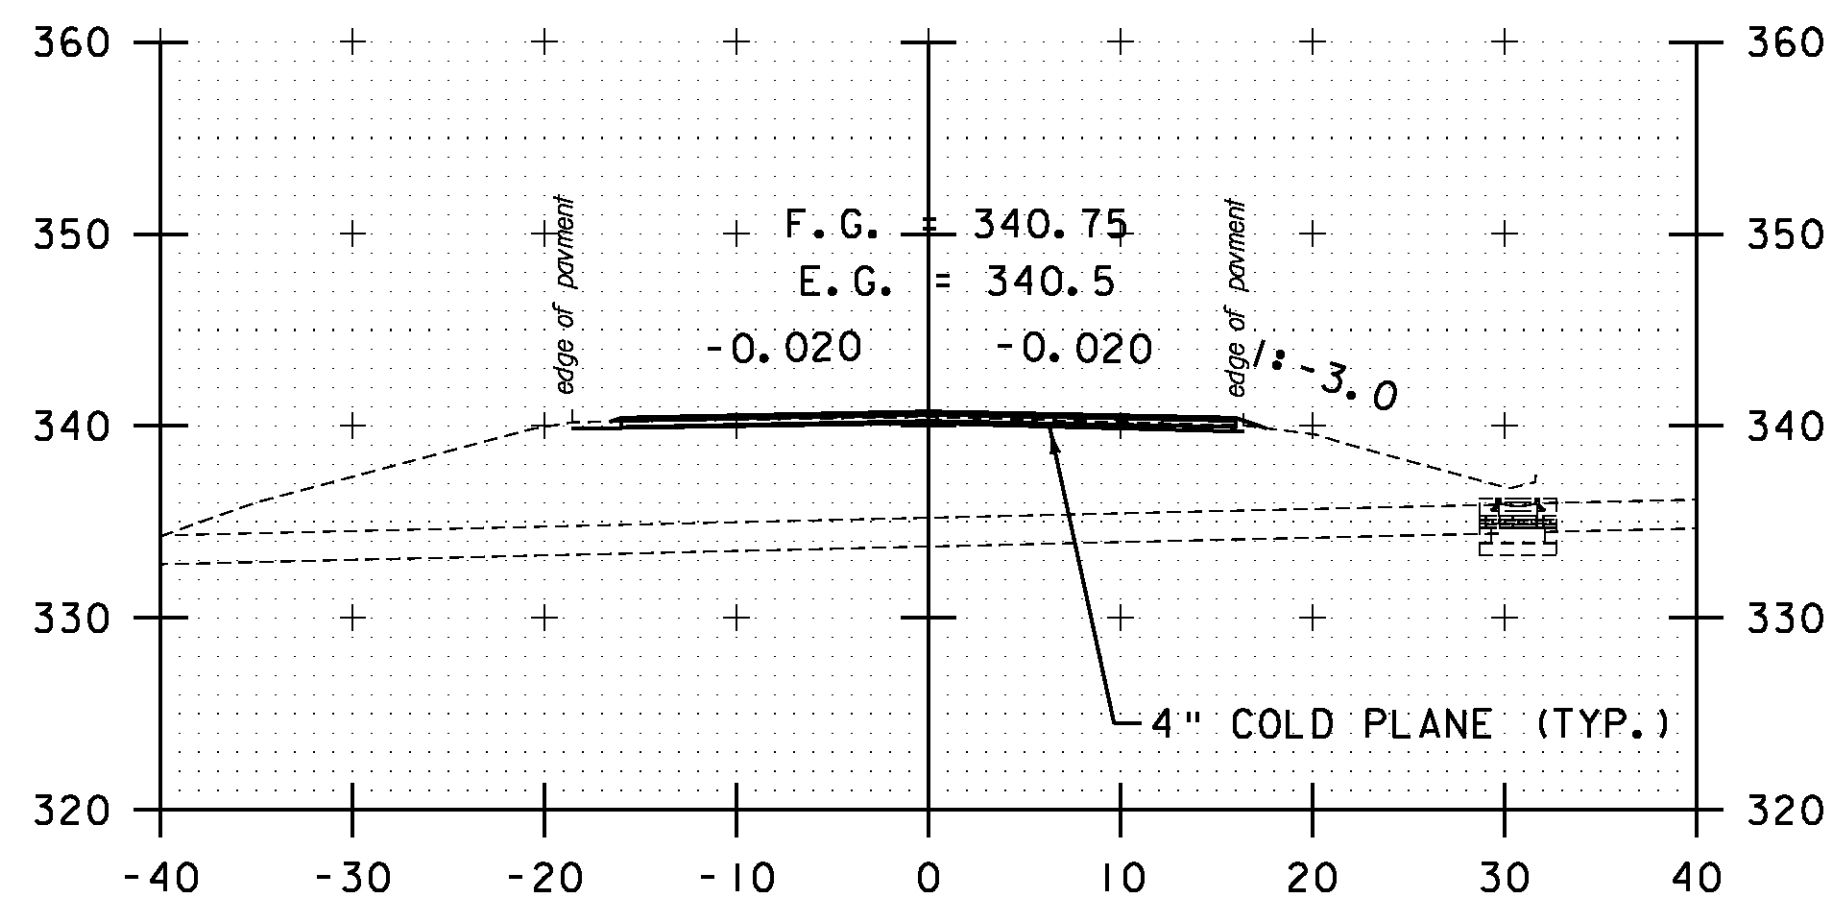


181+00

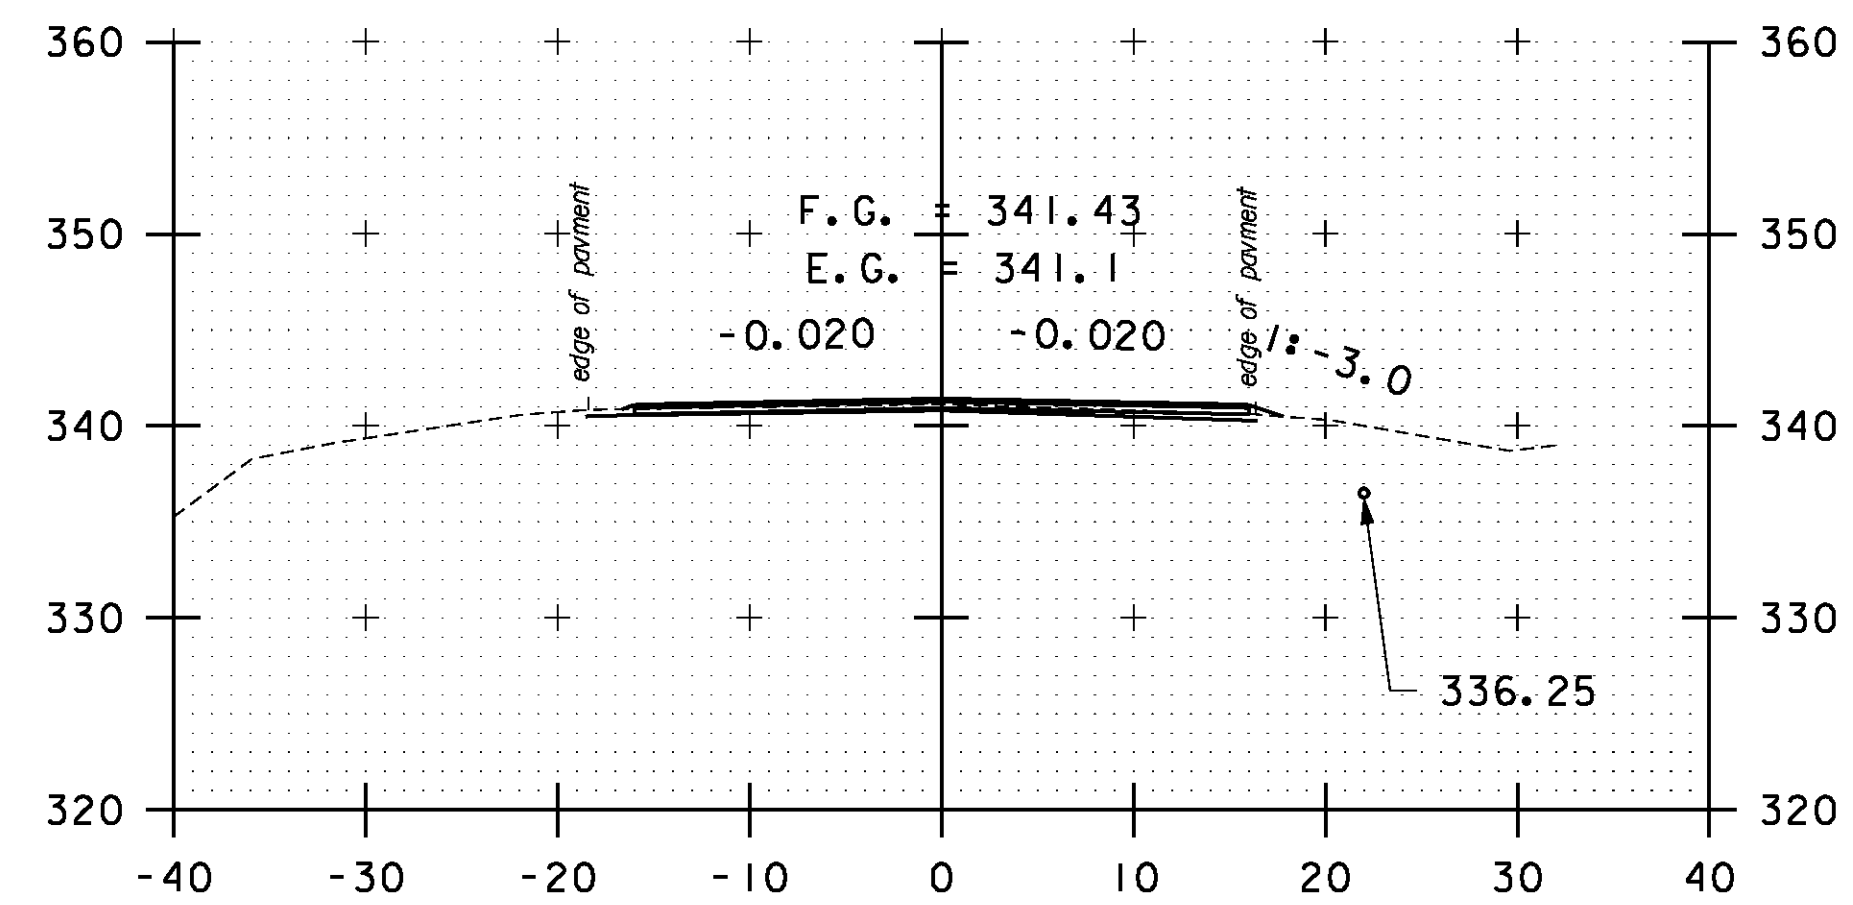


182+50

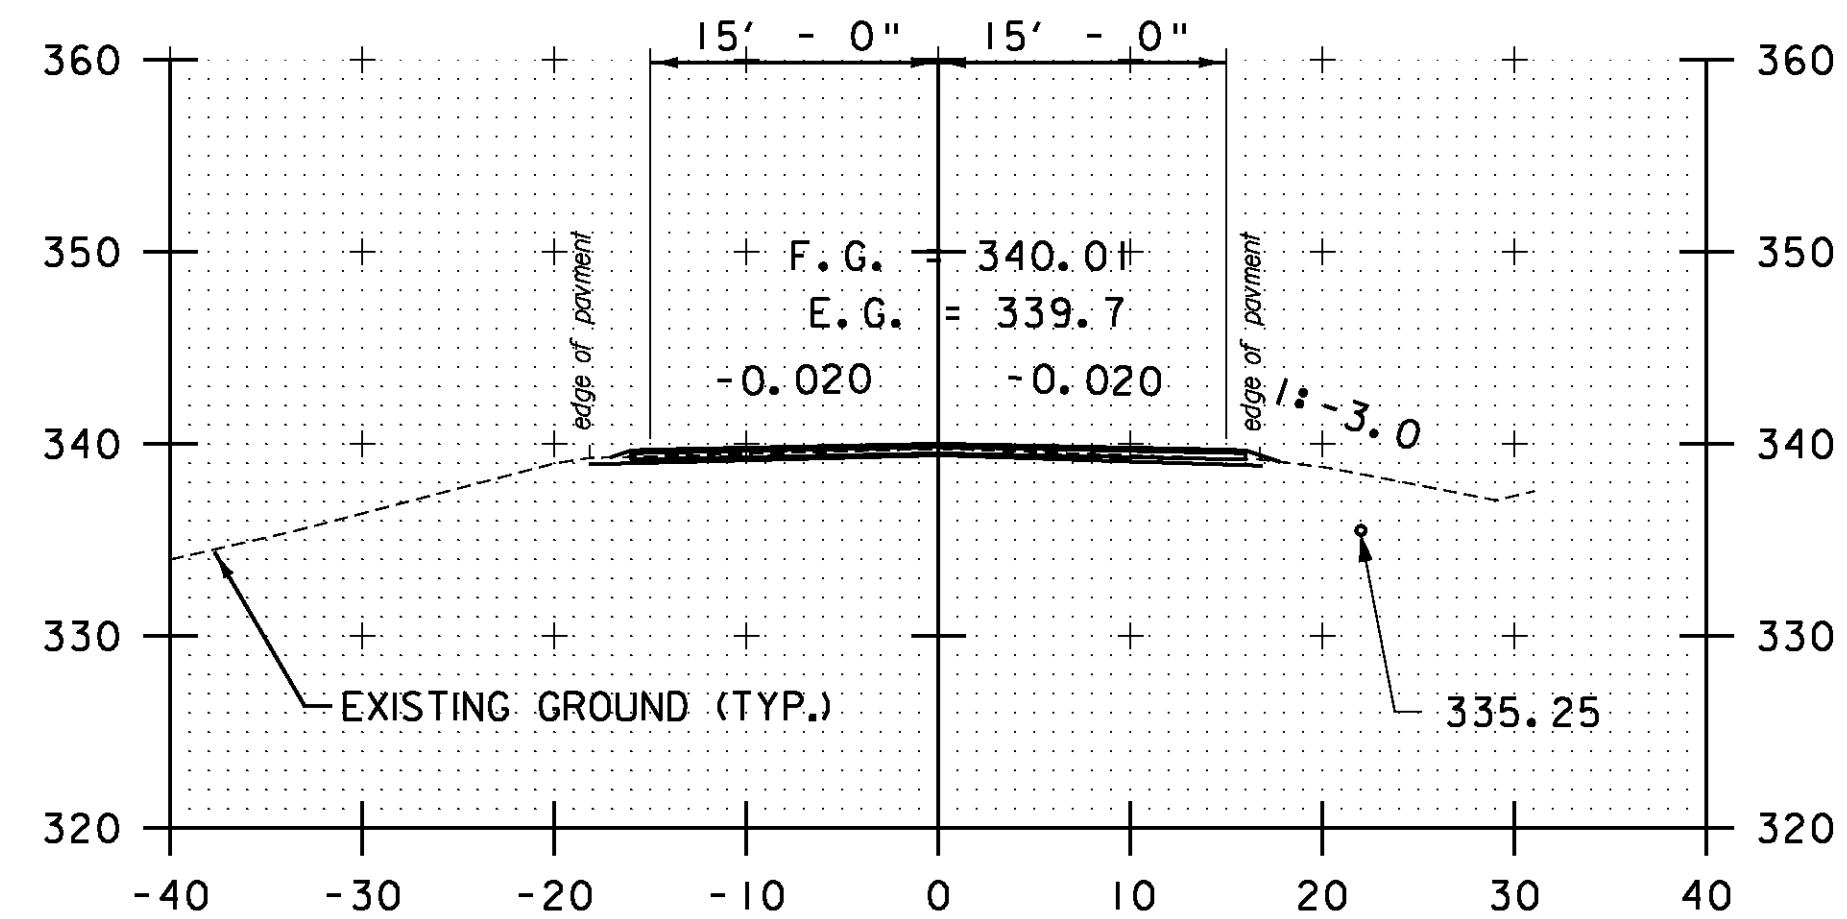

179+00

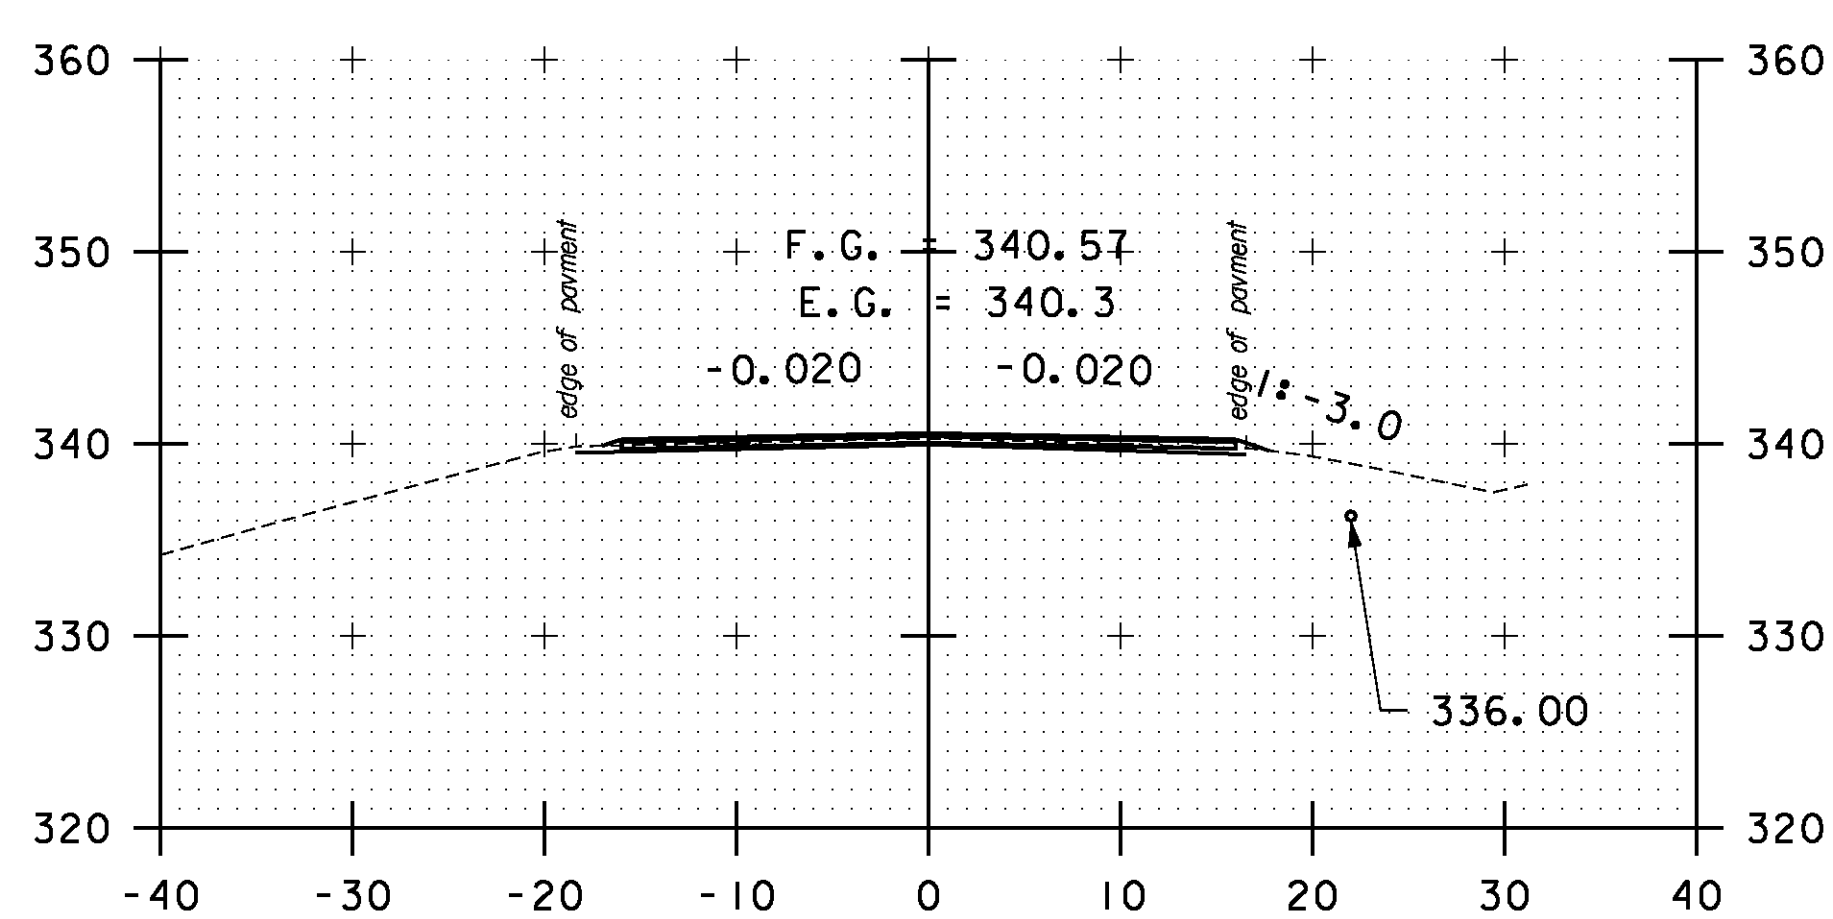

180+50

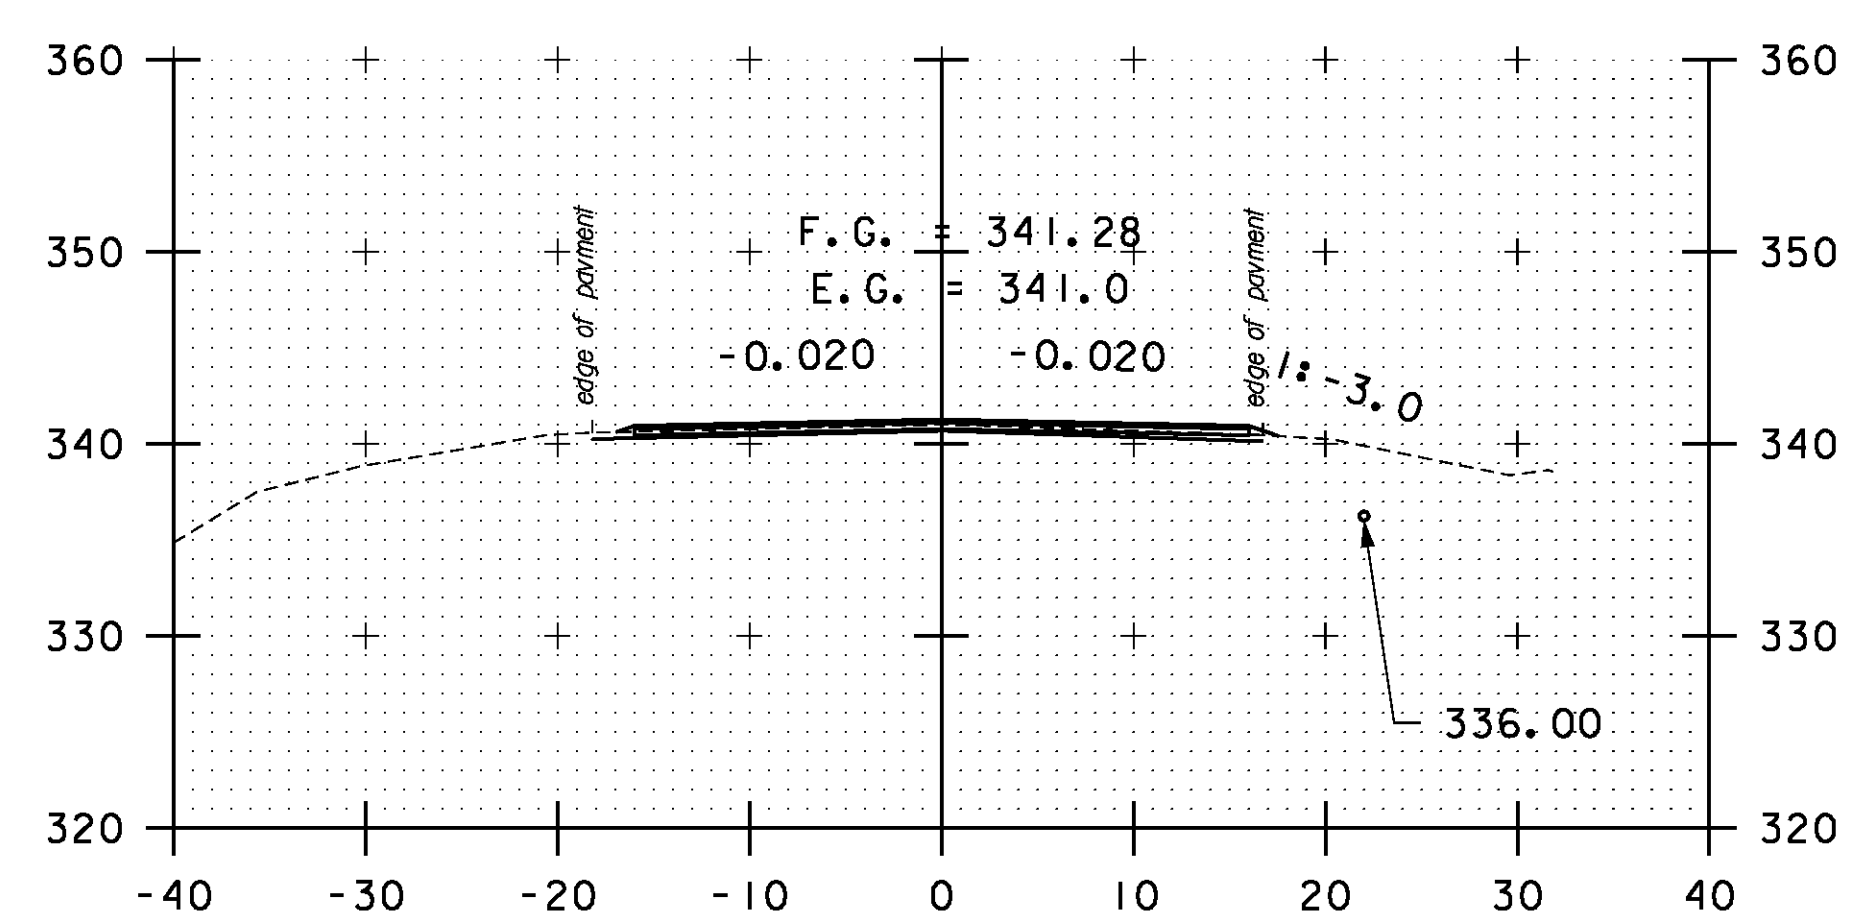

182+00

STA. 179+00 TO STA. 183+00

SCALE 1" = 10'-0"
0 10

CROSS SECTION SHEET 20

PROJECT NAME: BOLTON-WATERBURY

PROJECT NUMBER: STP 2709(I)

FILE NAME: p07C172.dgn

PROJECT LEADER: CDL

DESIGNED BY: BMB

PLOT FILE: p07C172_146.1

PLOT DATE: 4/16/2013

DRAWN BY: BMB

CHECKED BY: CDL

SHEET 146 OF 217