




184+50

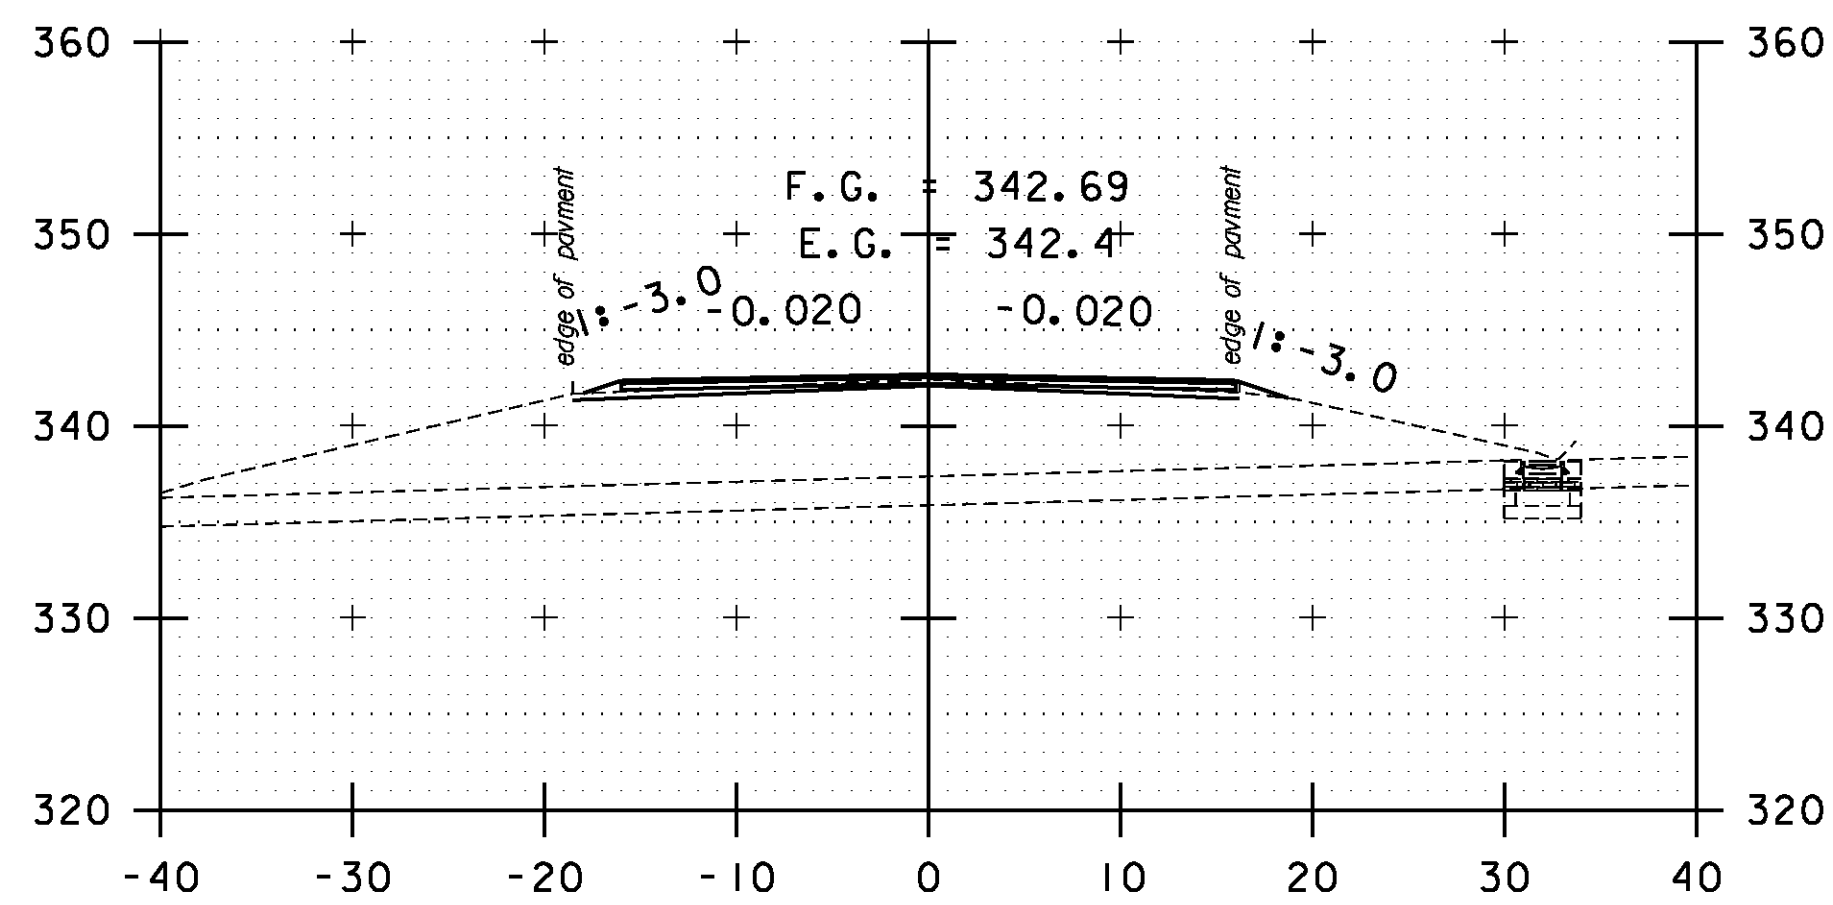


186+00

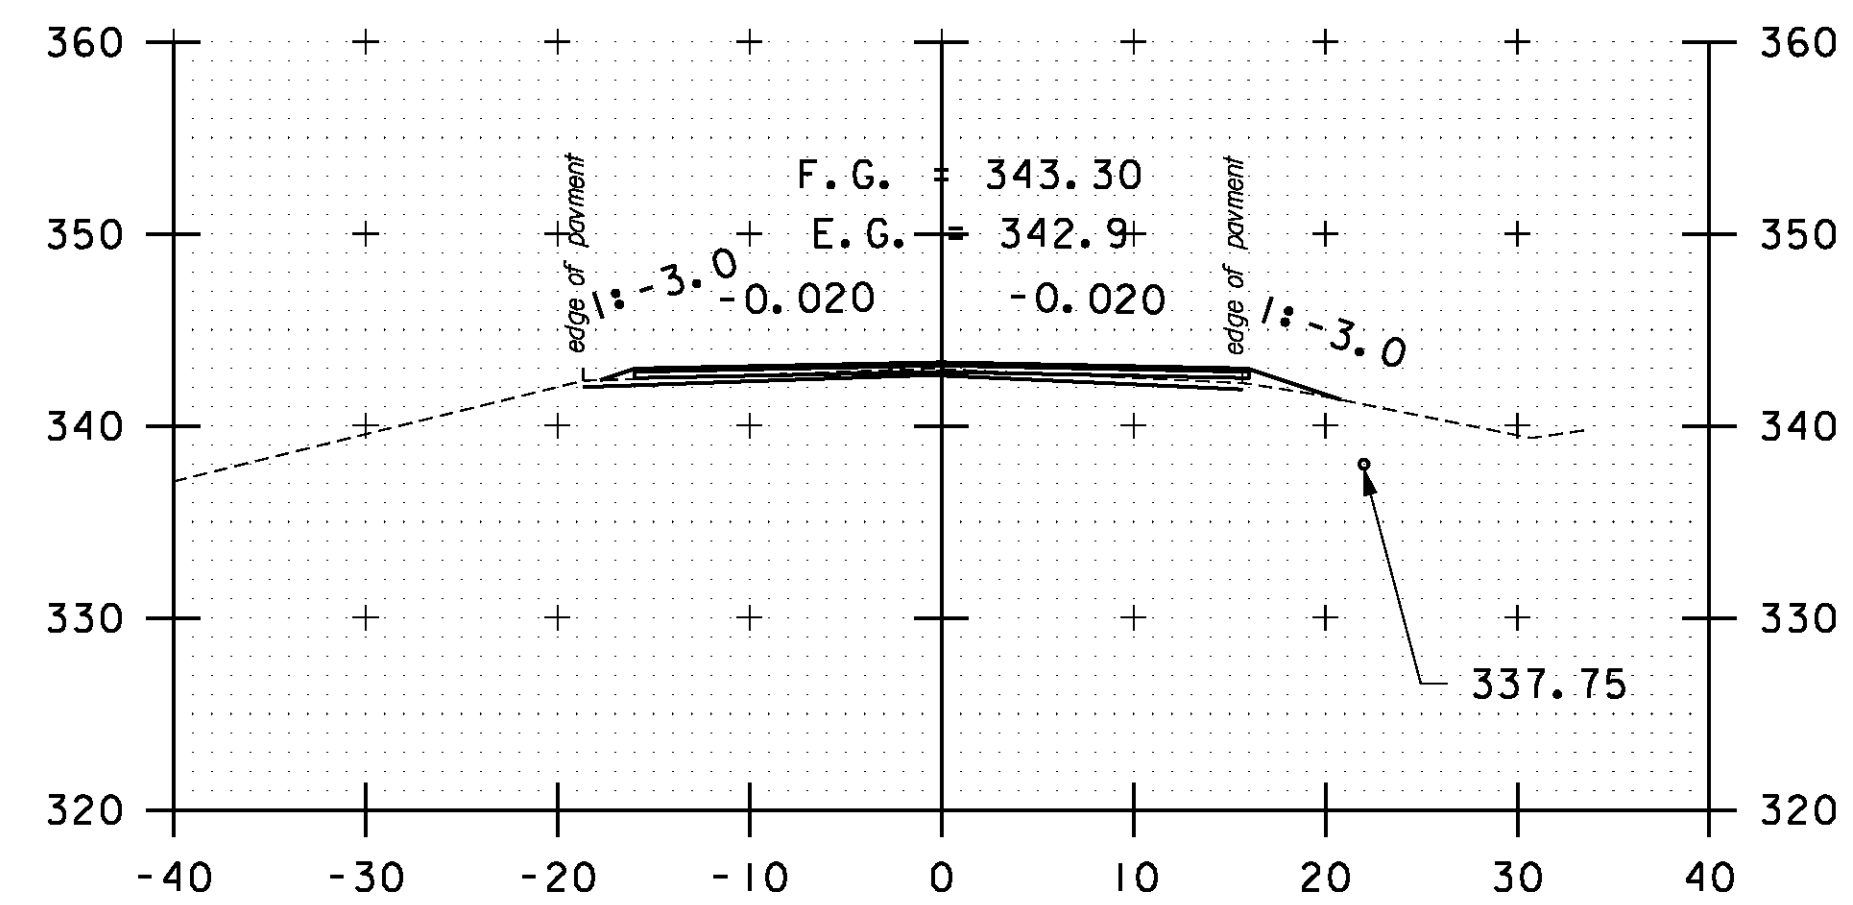


187+50

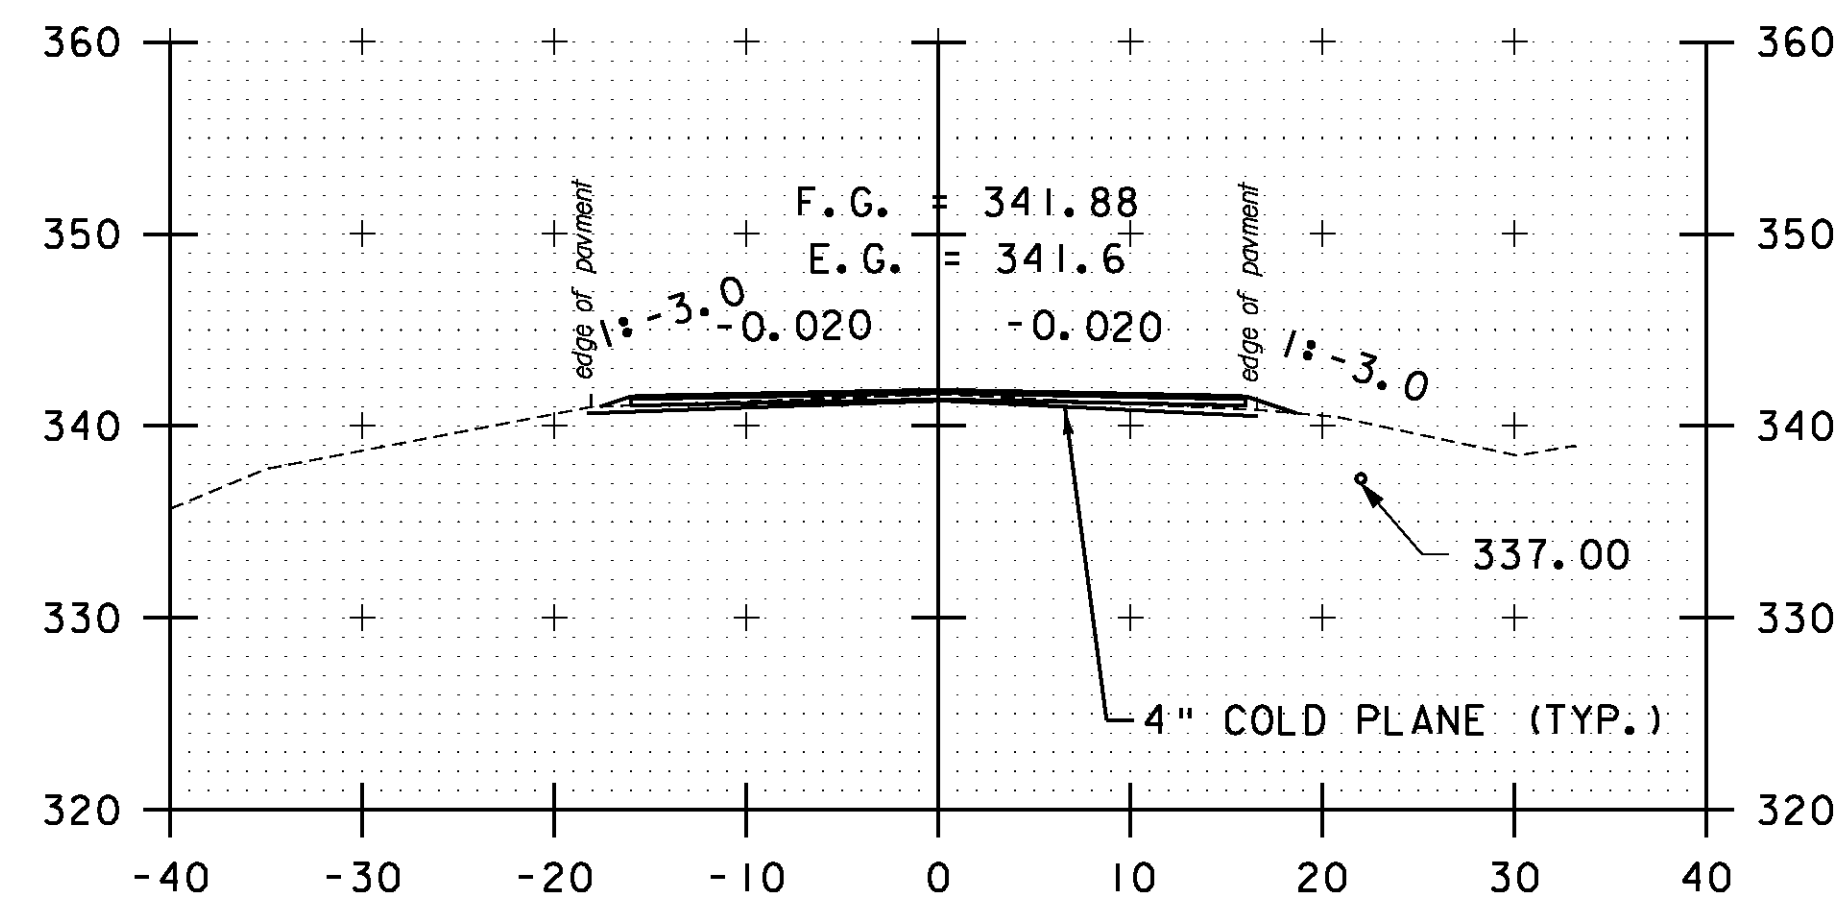


184+00

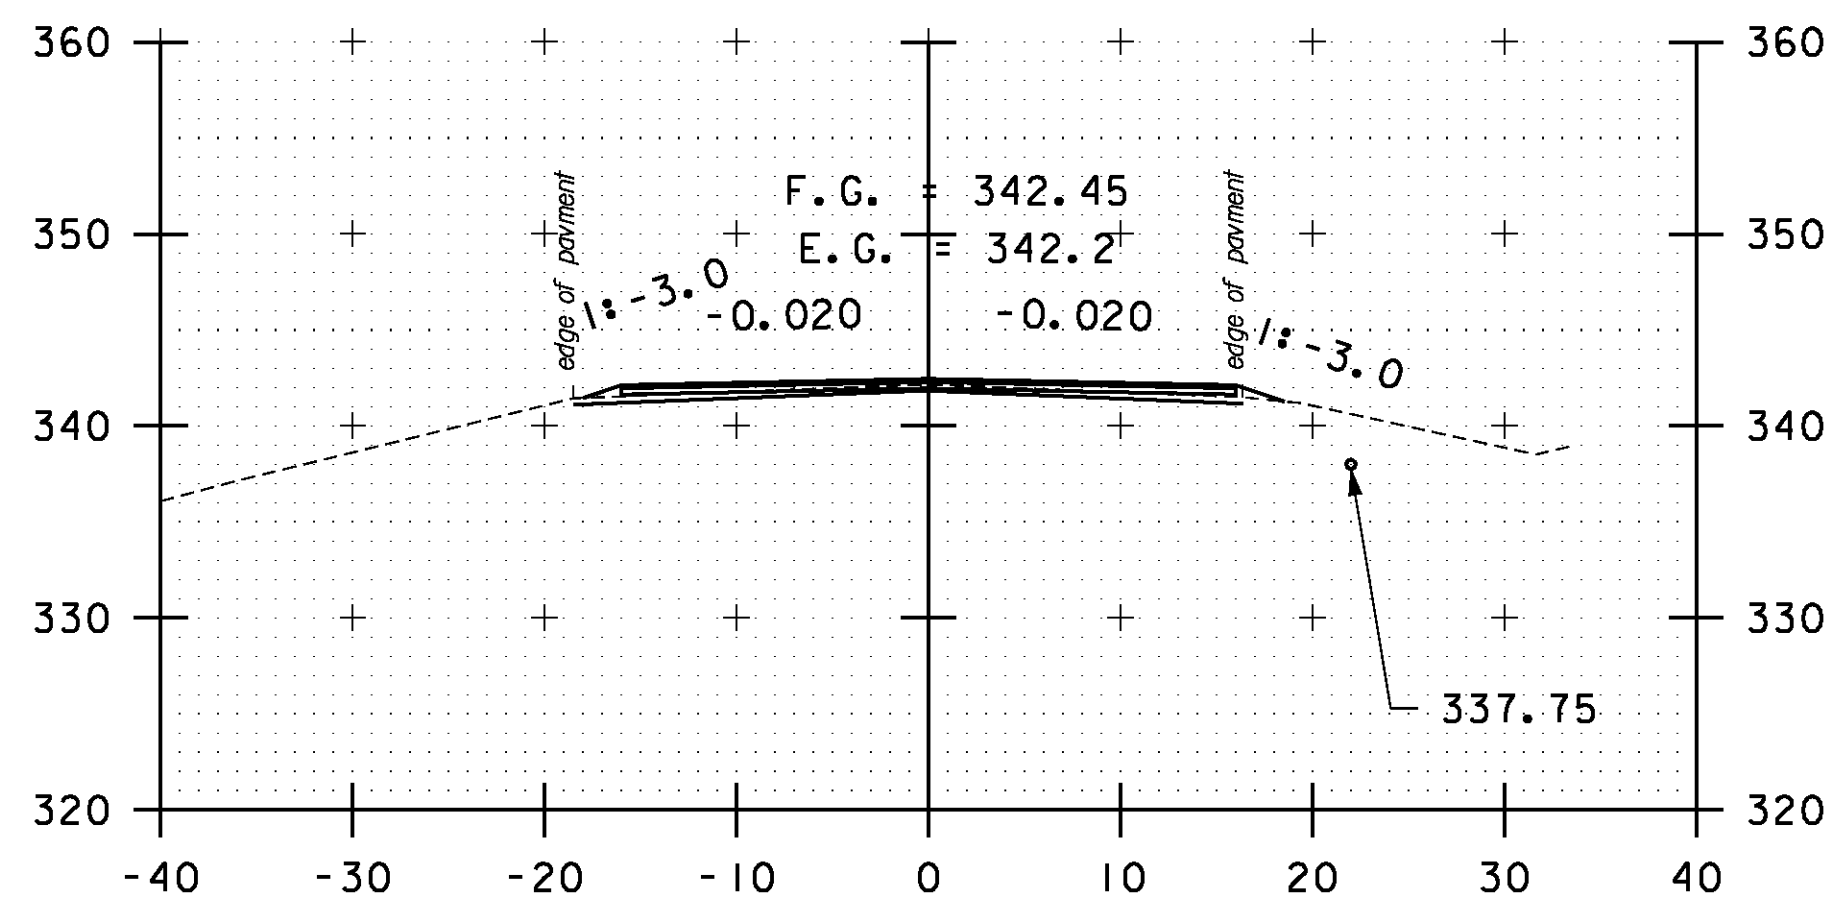


185+50

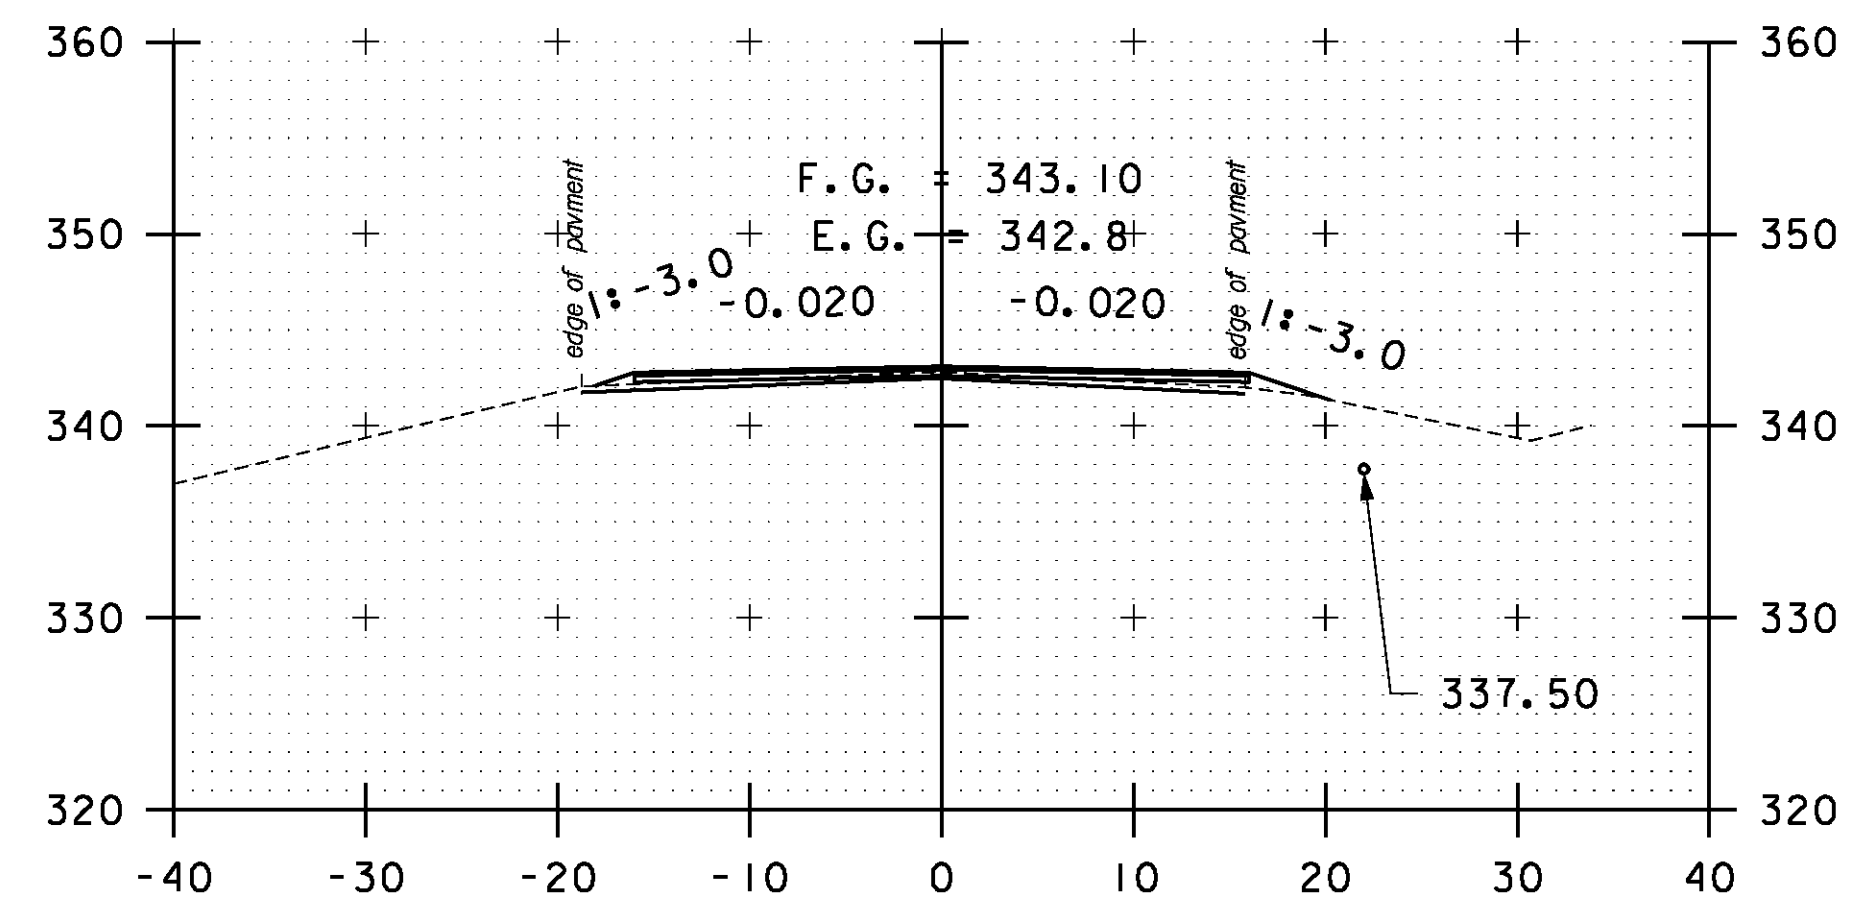


187+00

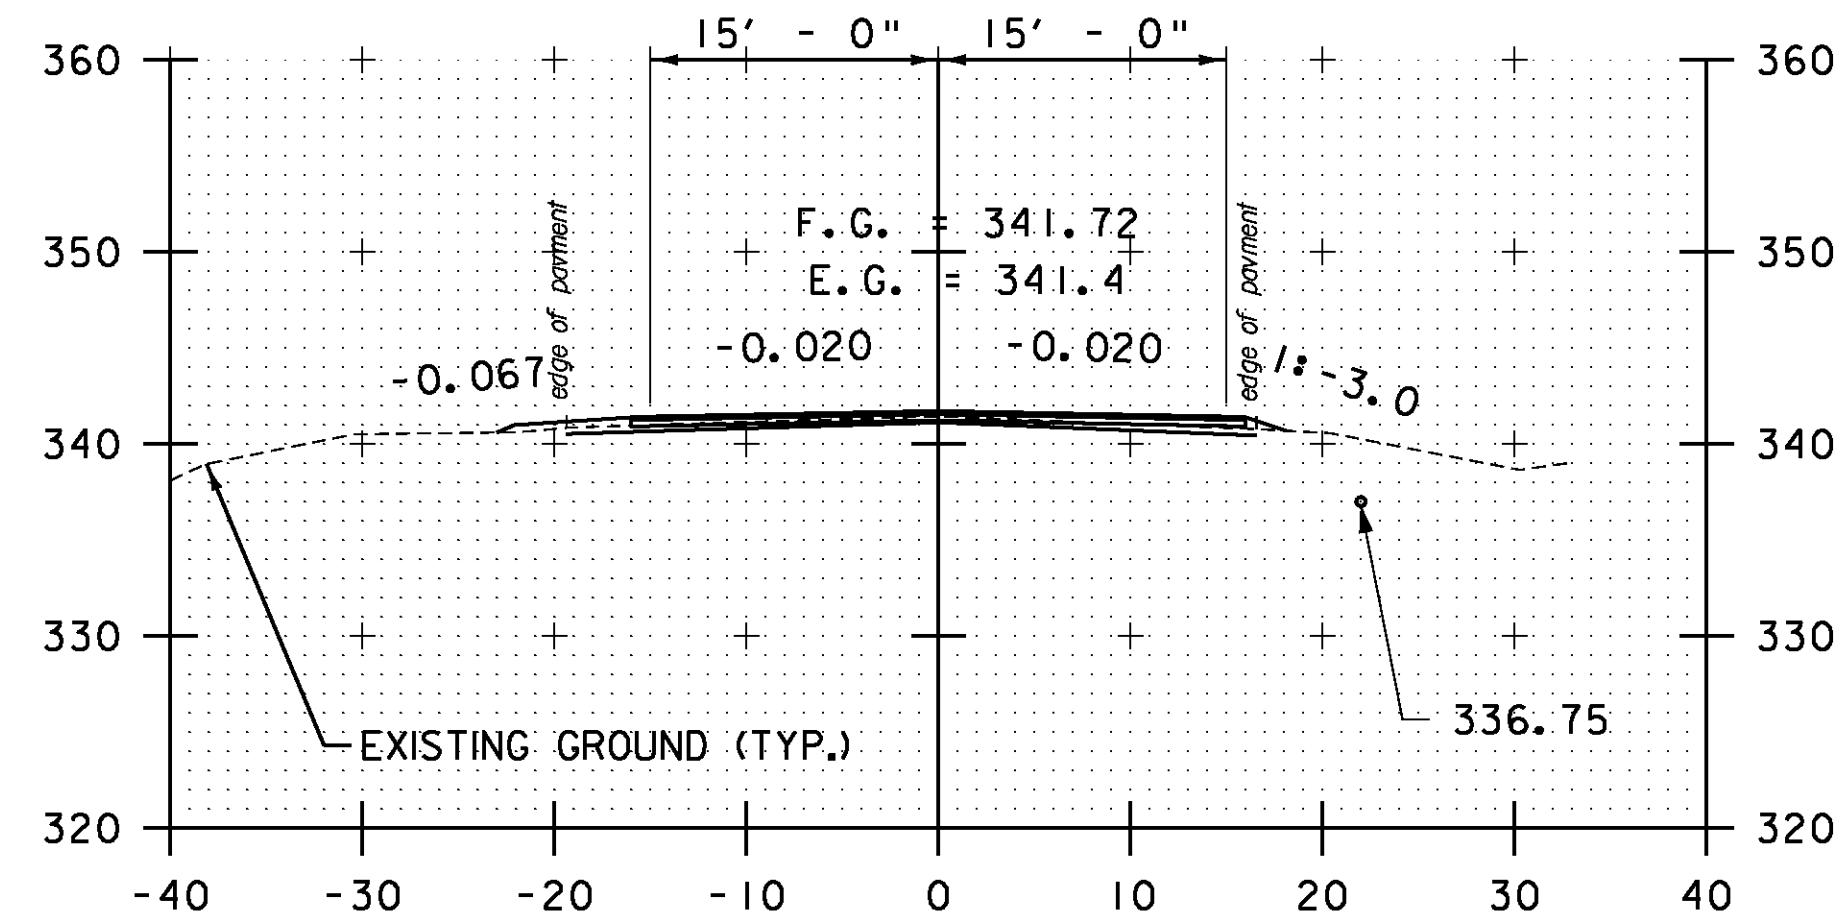

DRIVE LT
183+50

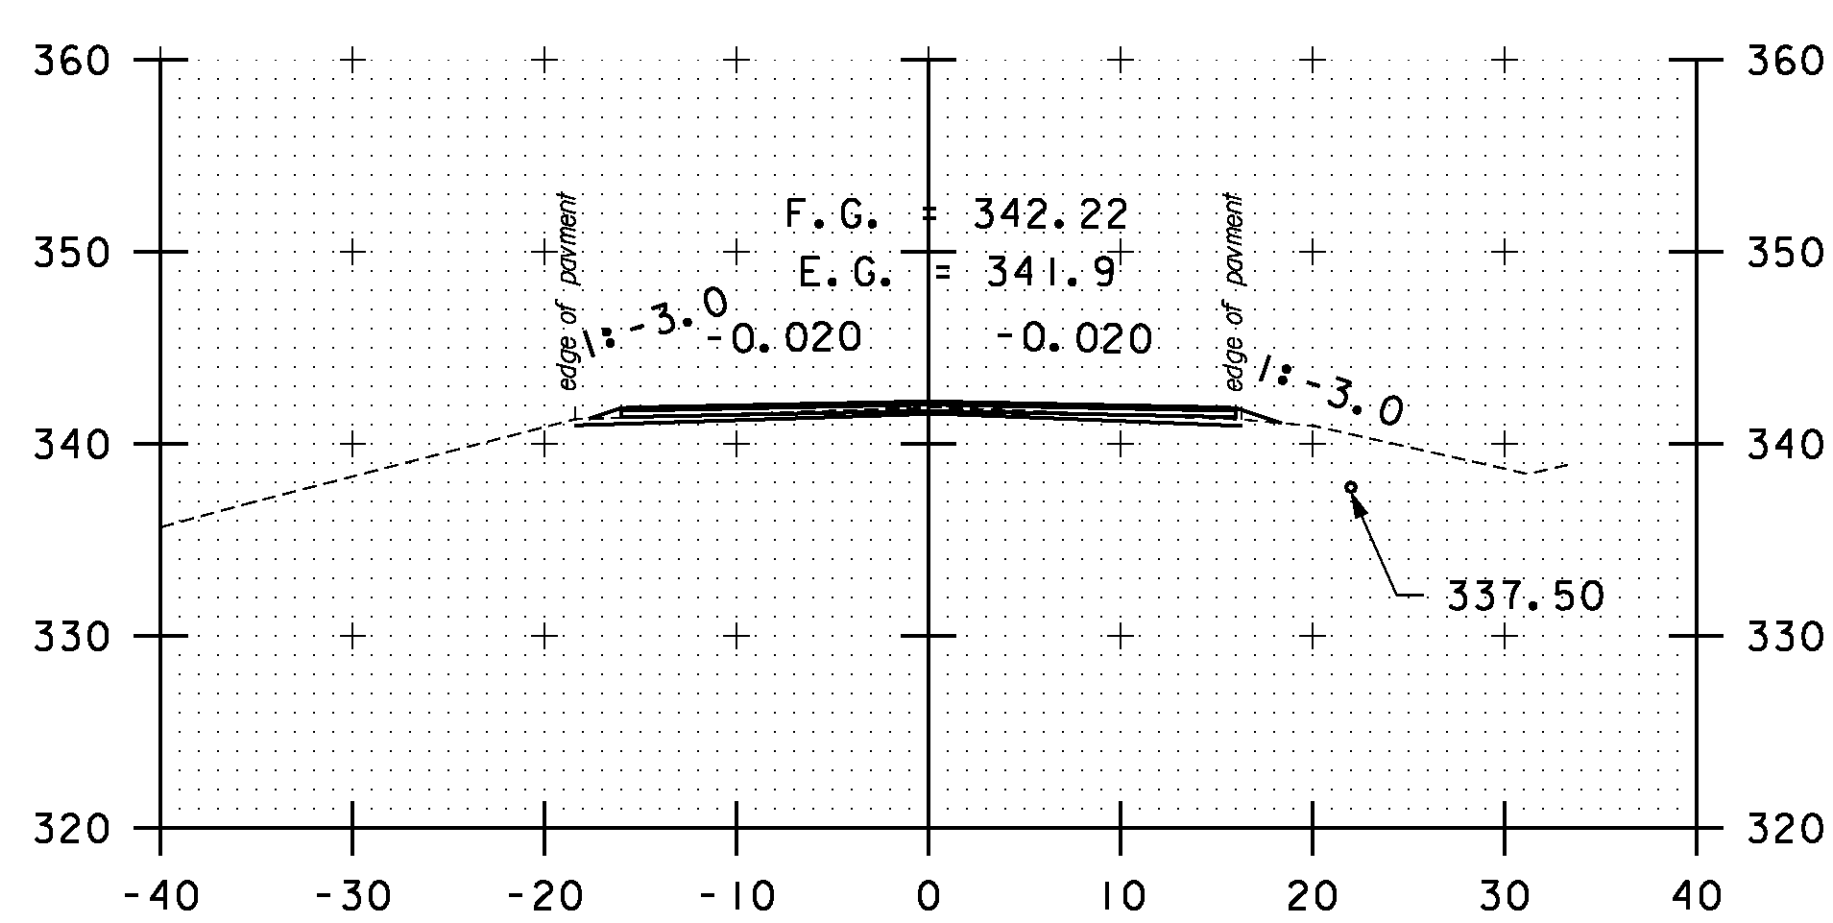

185+00

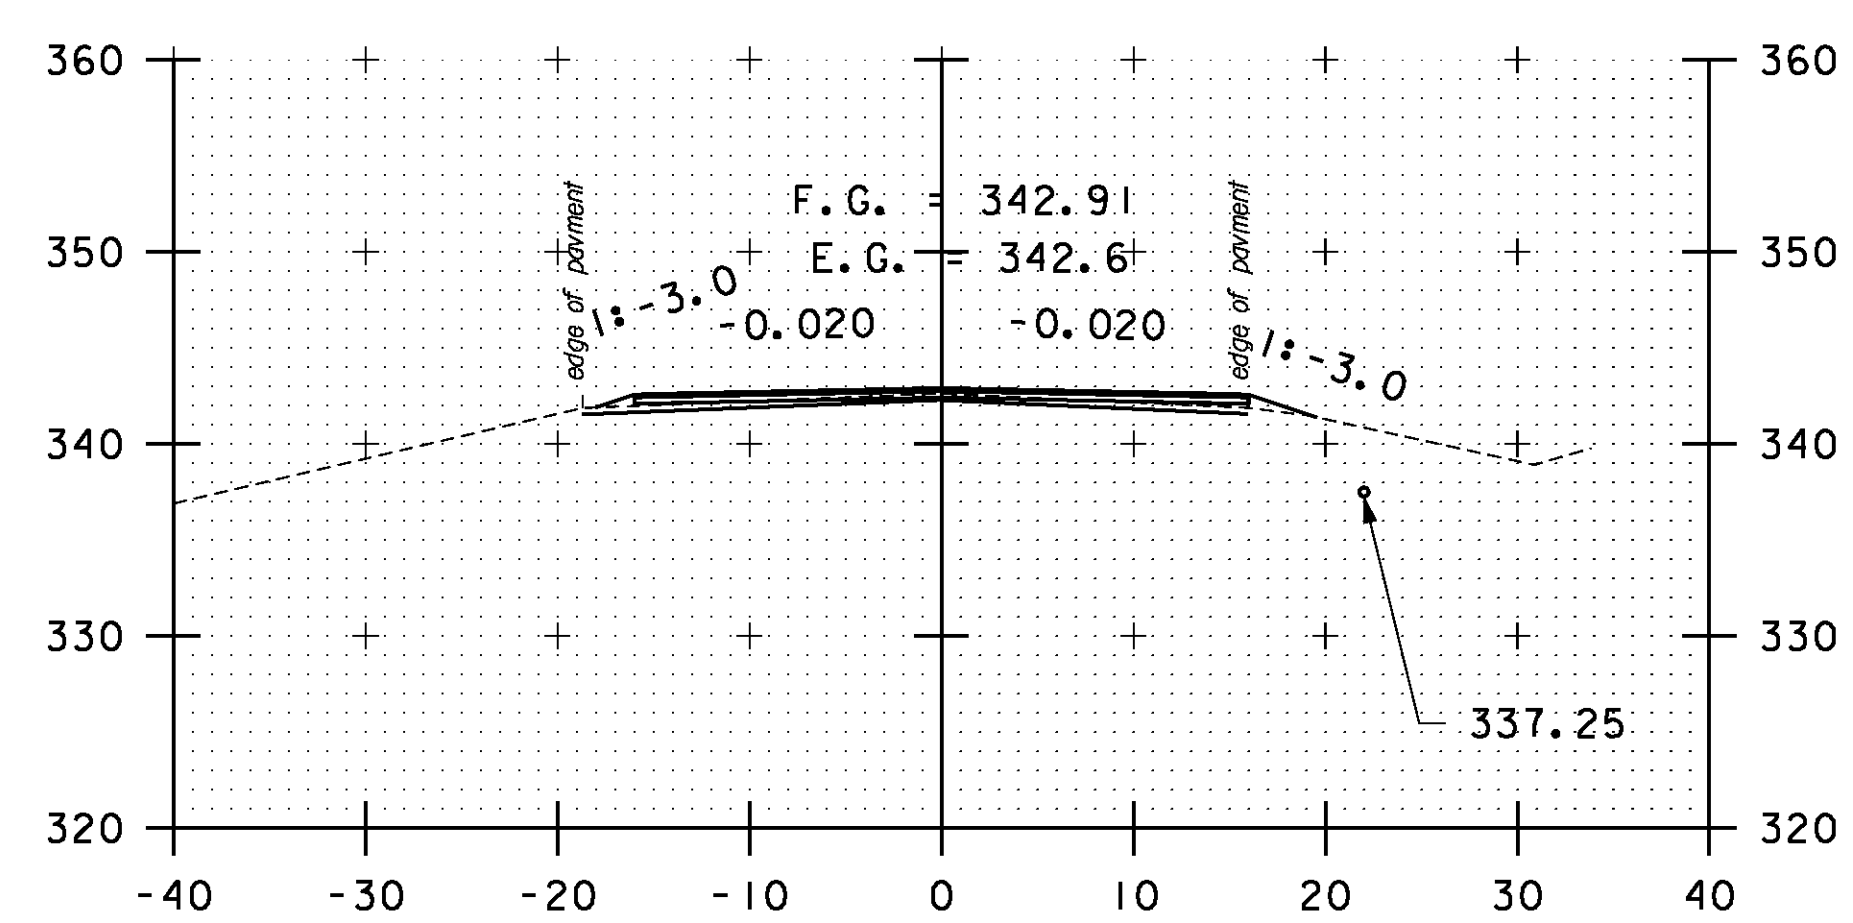

186+50

STA. 183+50 TO STA. 187+50

SCALE 1" = 10'-0"

CROSS SECTION SHEET 21

PROJECT NAME: BOLTON-WATERBURY

PROJECT NUMBER: STP 2709(I)

FILE NAME: p07C172.dgn

PROJECT LEADER: CDL

DESIGNED BY: BMB

PLOT FILE: p07C172_147.1

PLOT DATE: 4/16/2013

DRAWN BY: BMB

CHECKED BY: CDL

SHEET 147 OF 217