




202+50

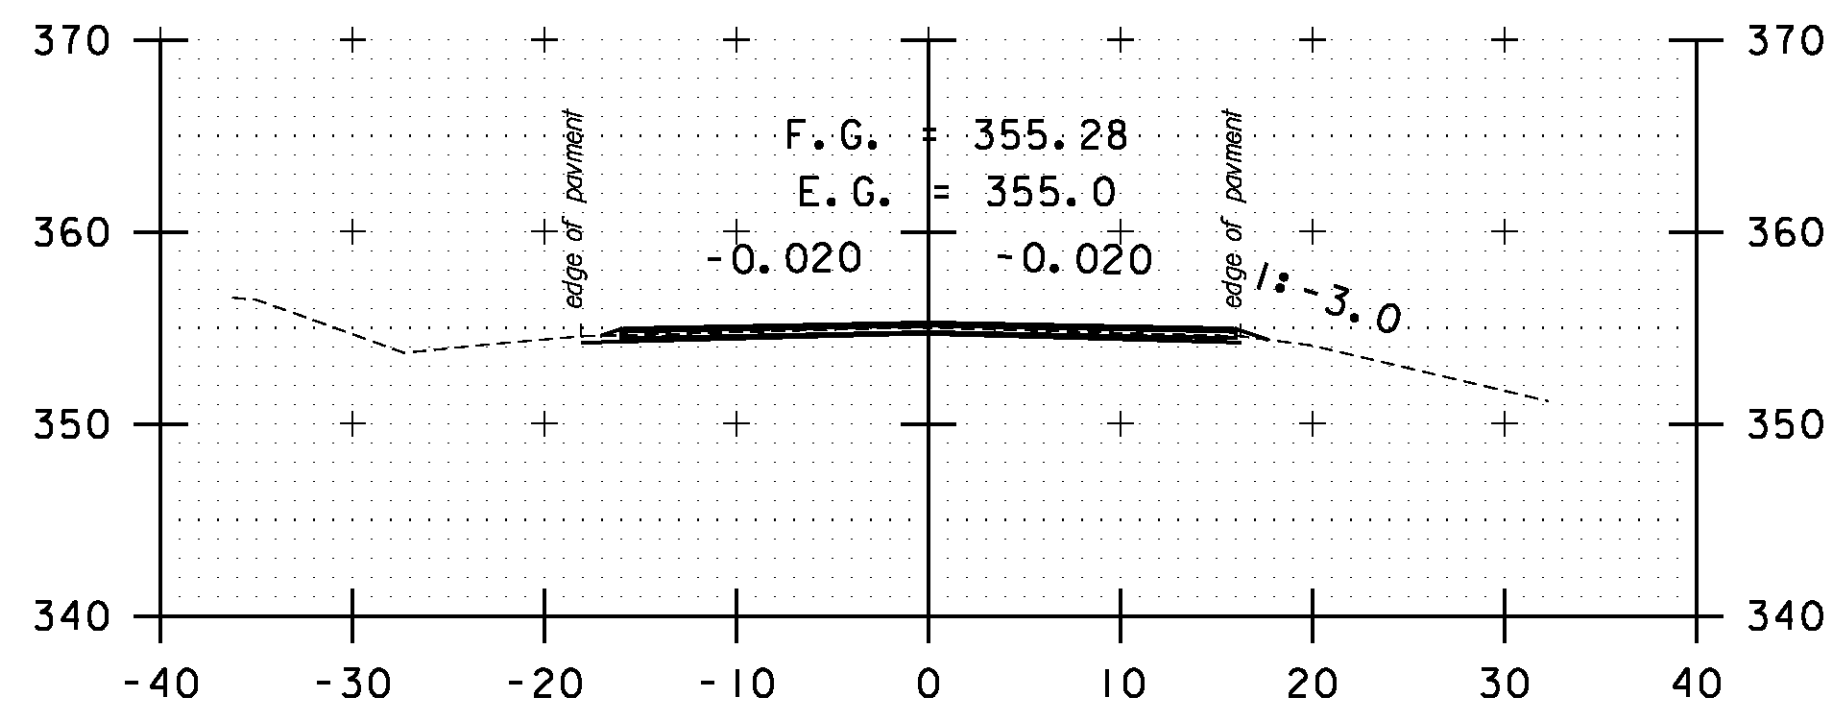


204+00

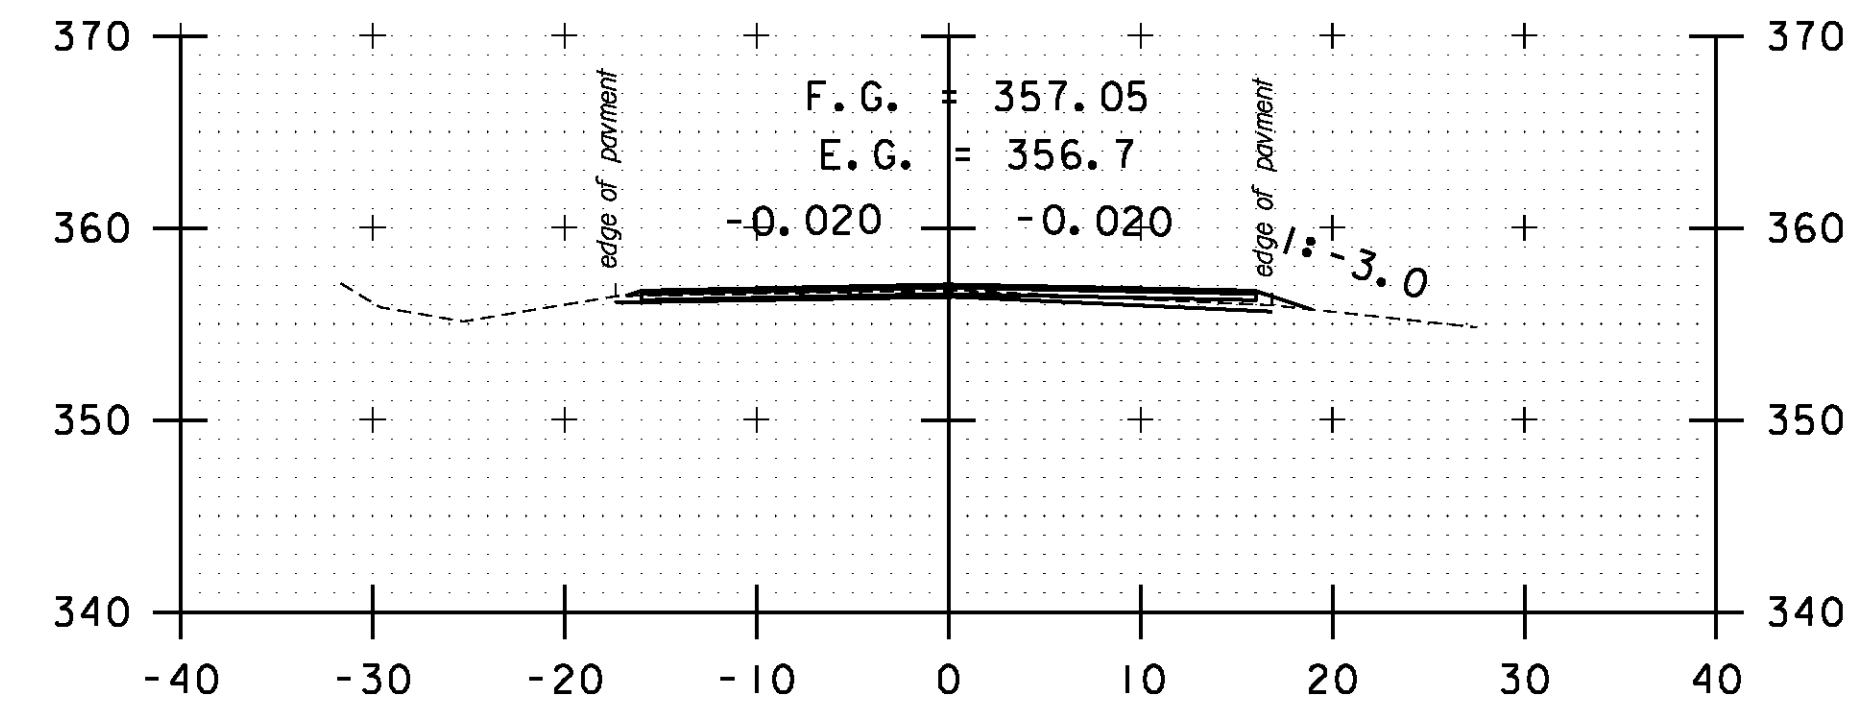


205+50

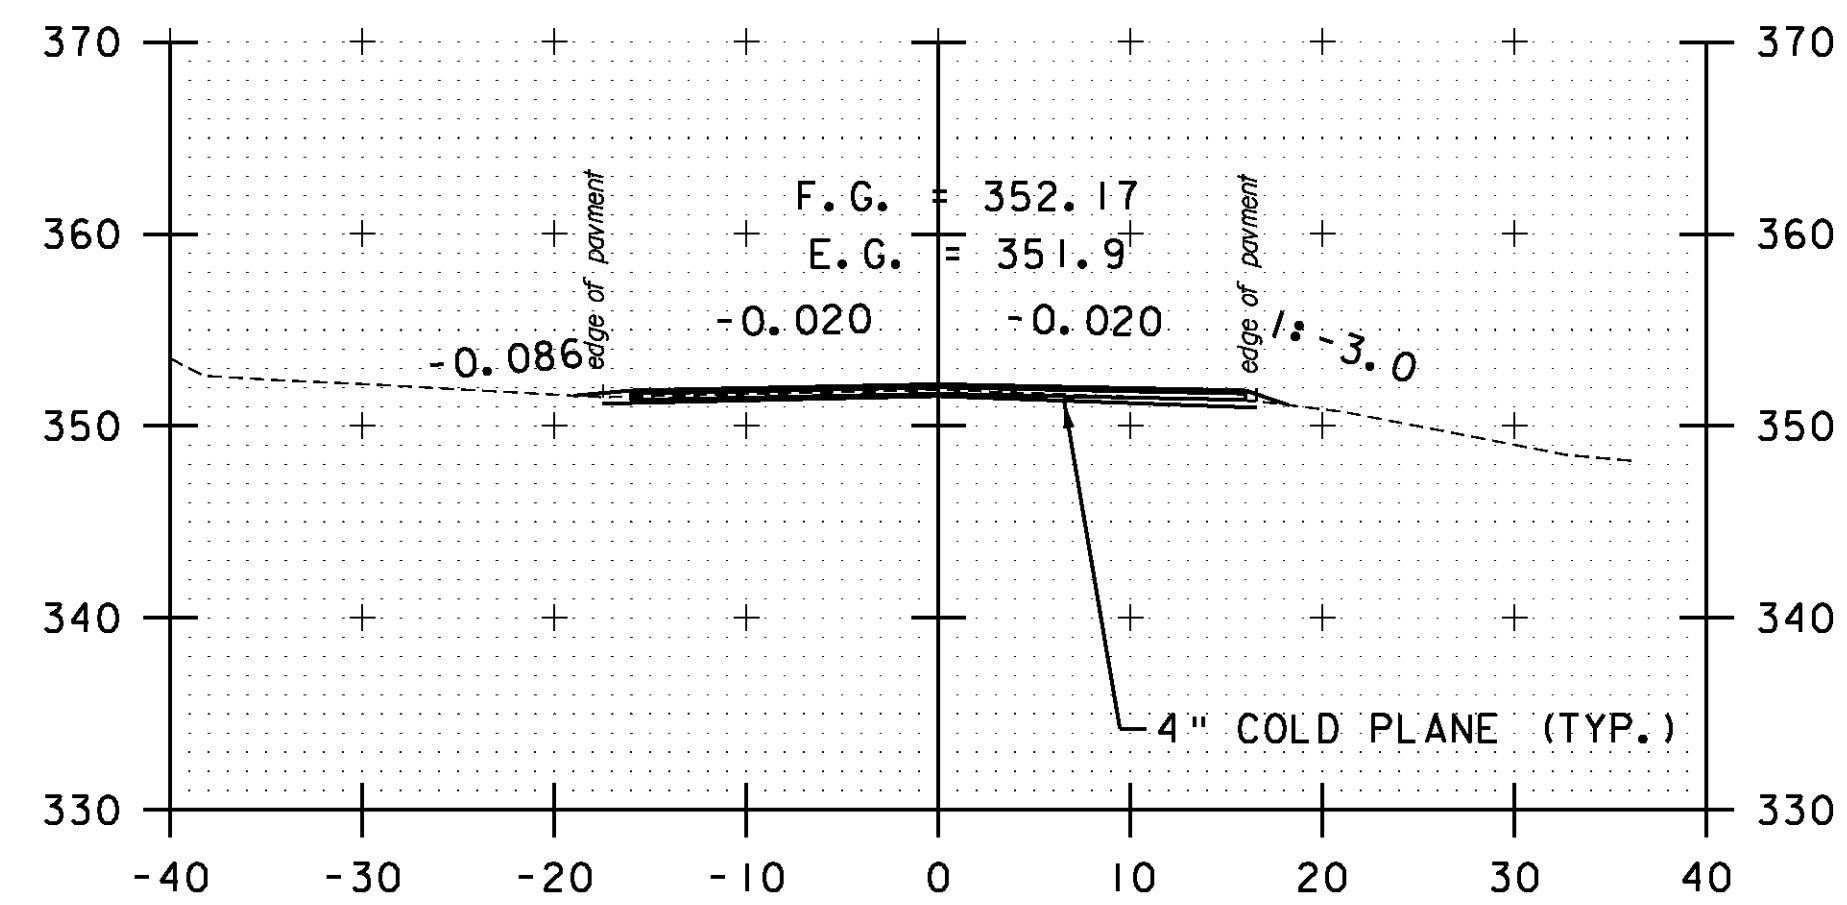


DRIVE LT
202+00

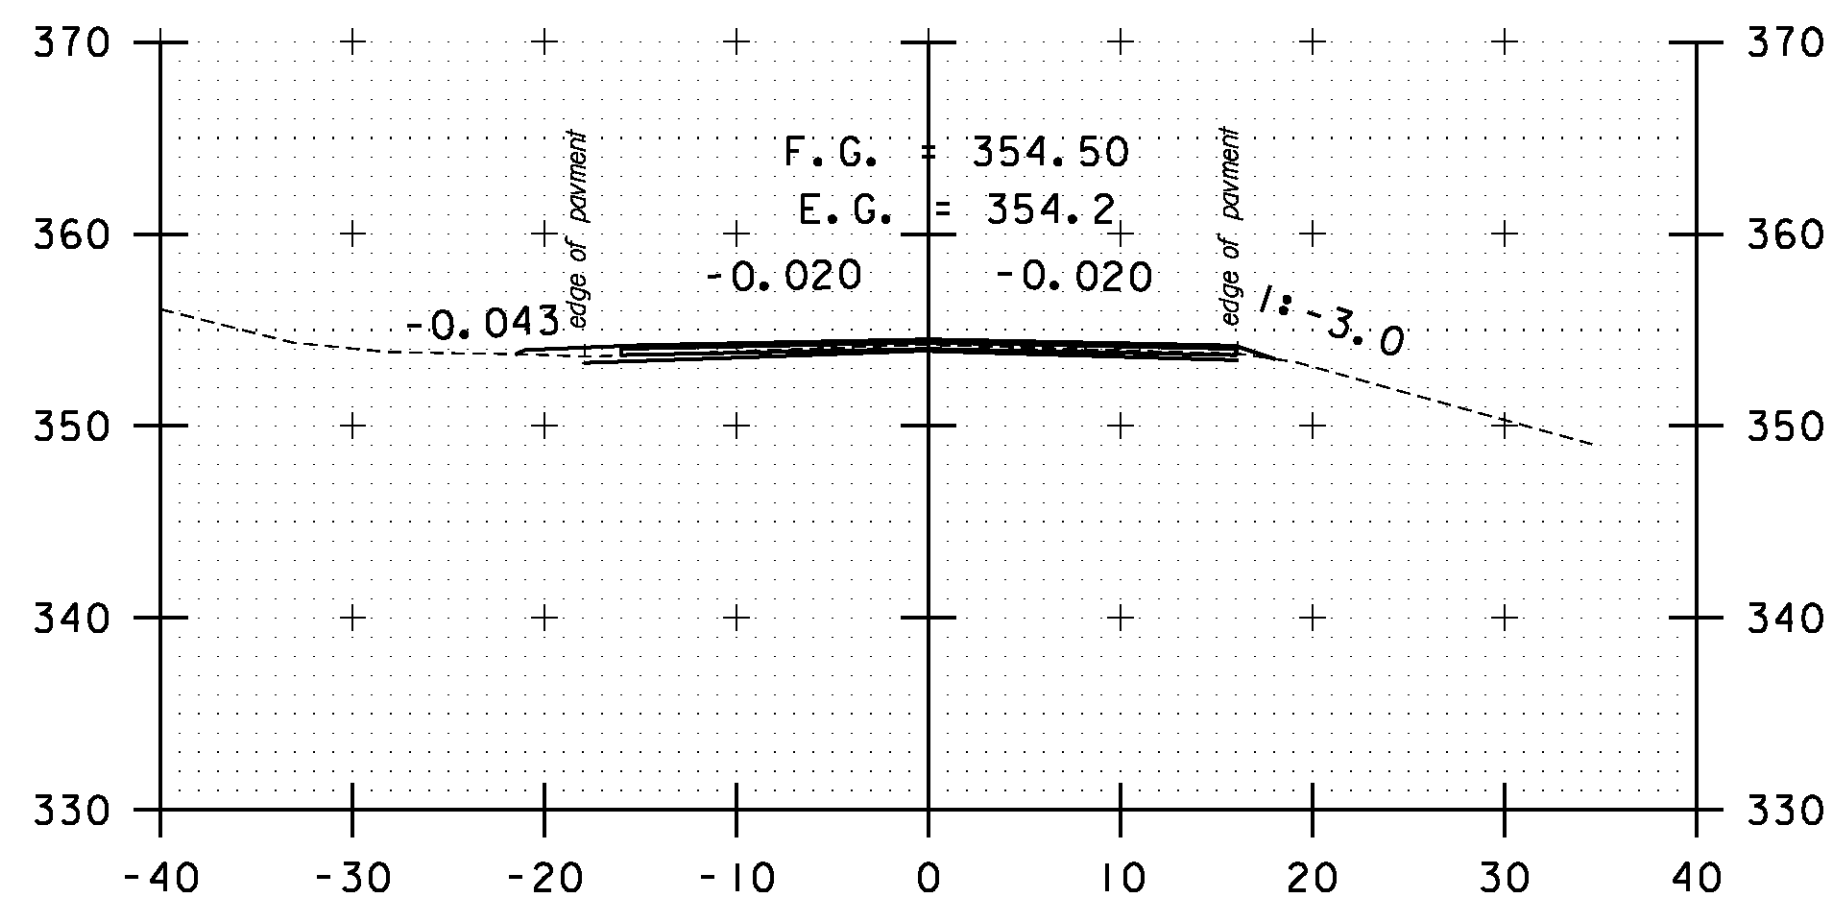


DRIVE LT
203+50

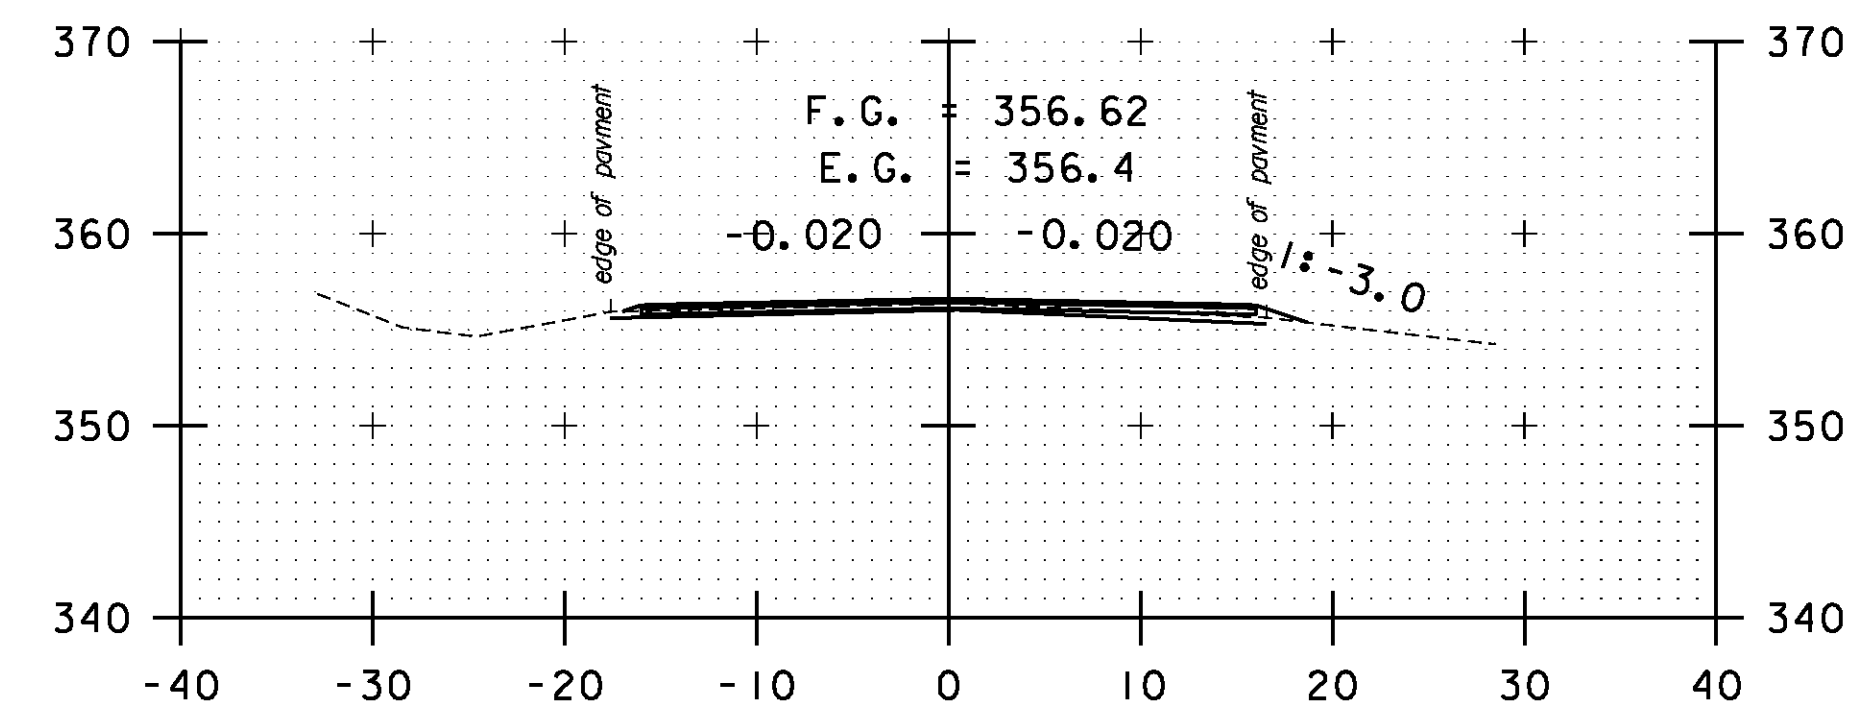


205+00

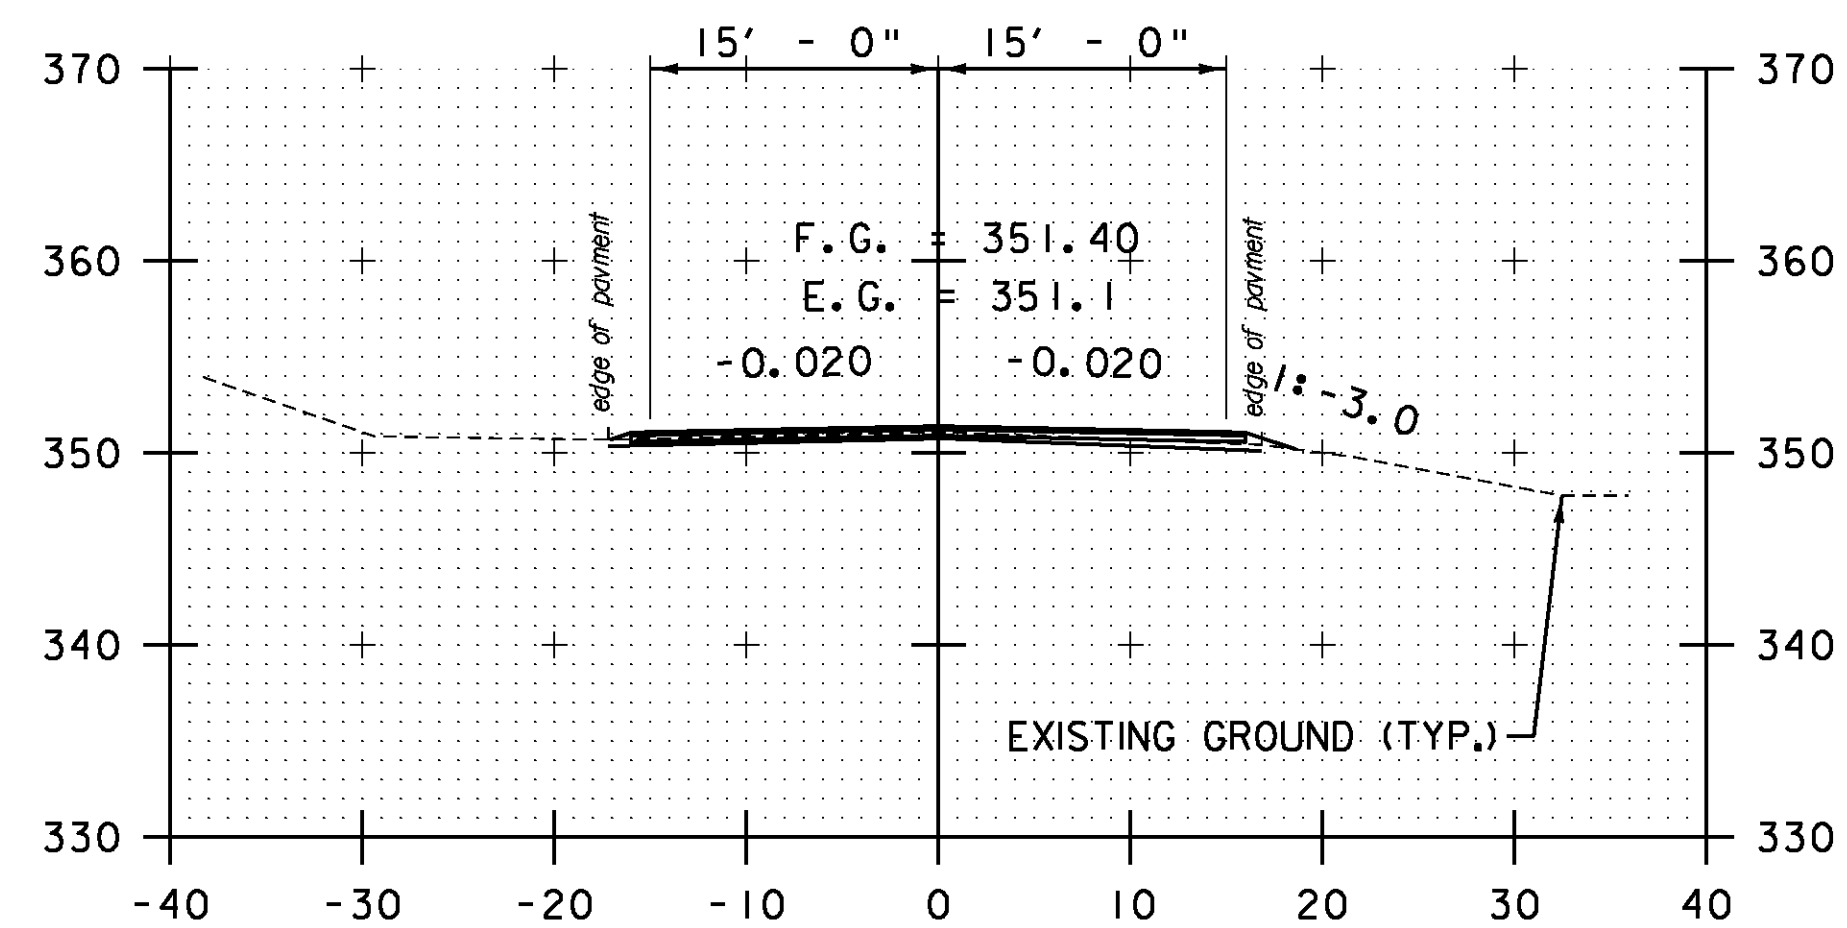

201+50

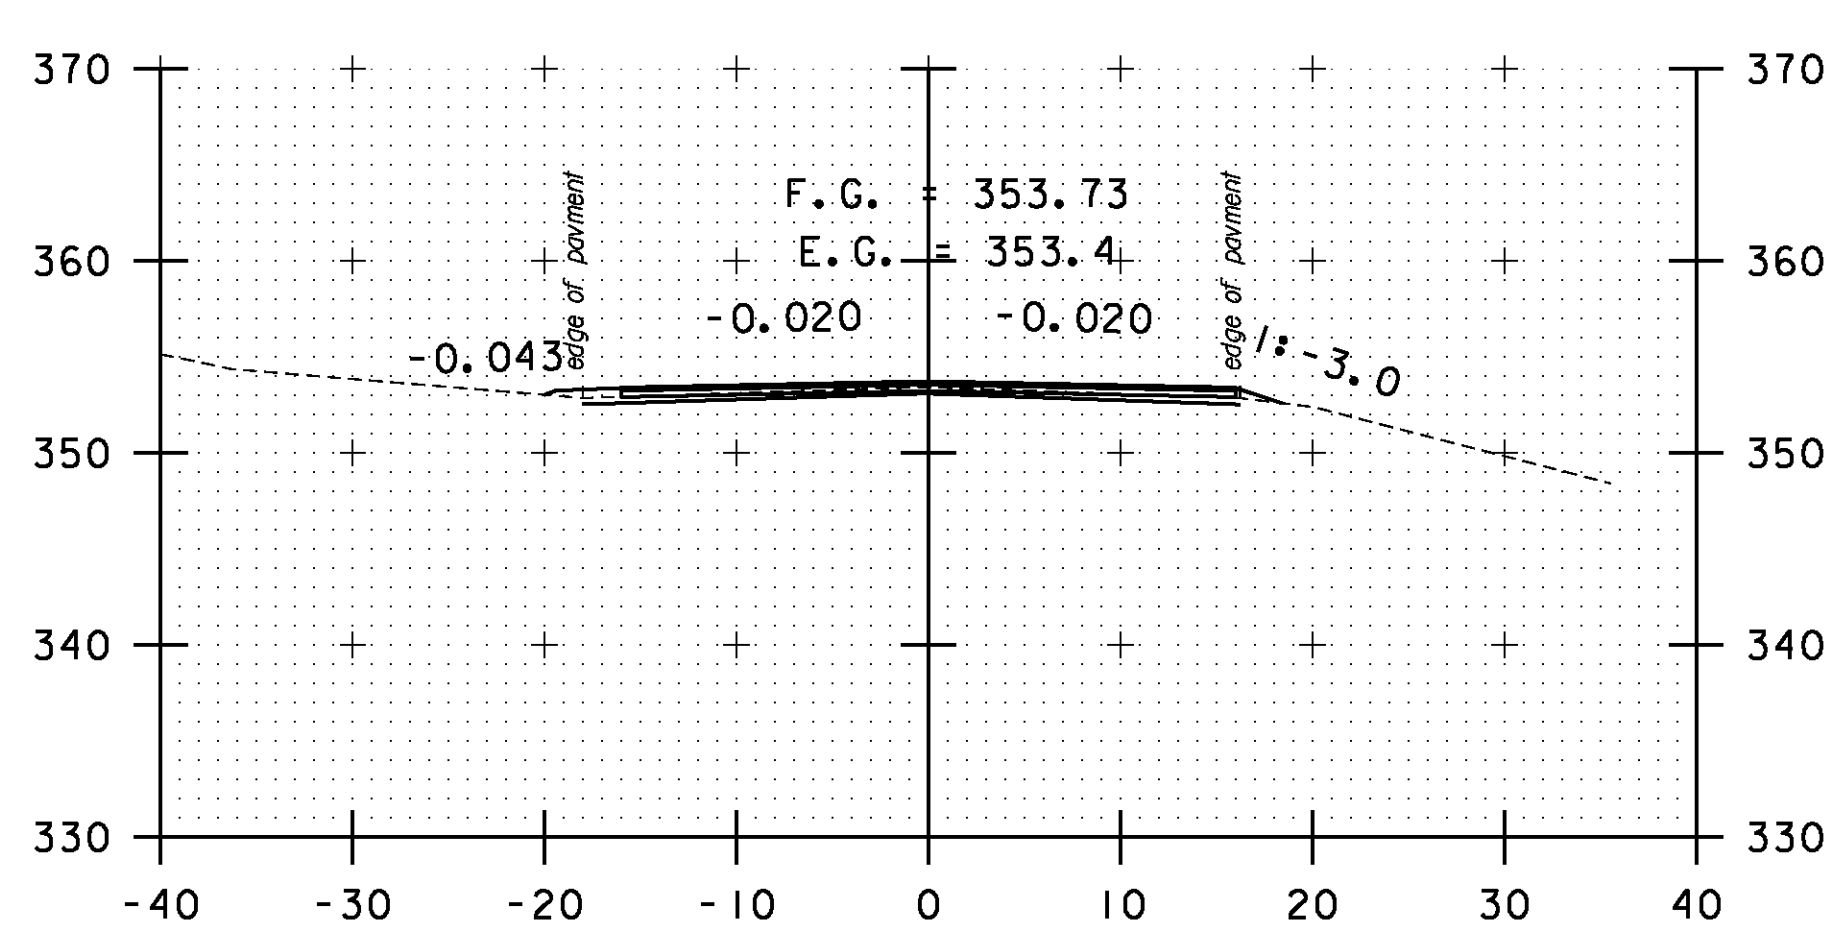

DRIVE LT
203+00

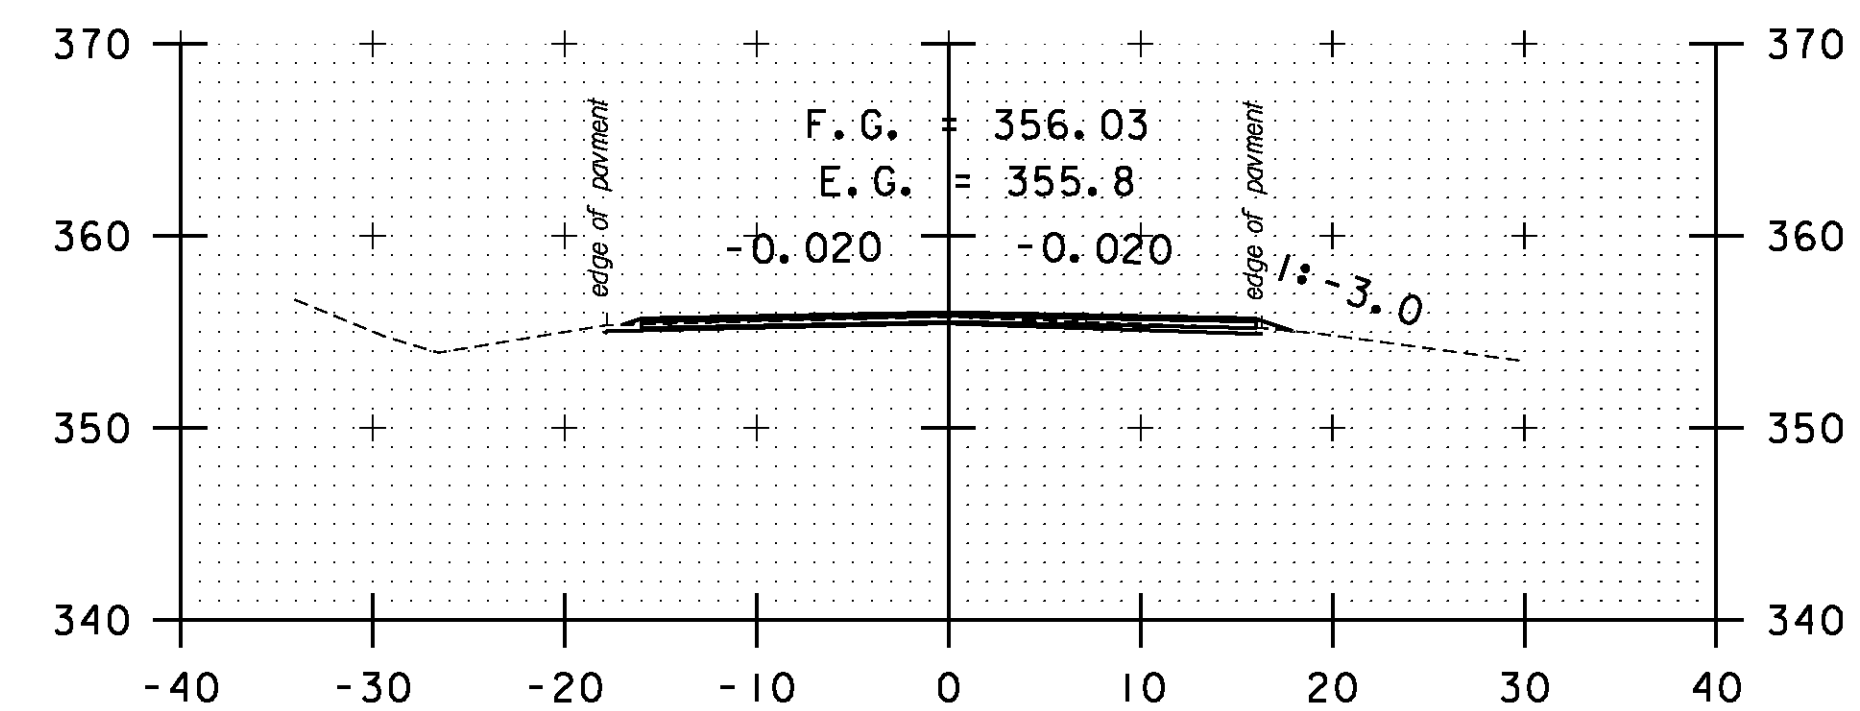

204+50

STA. 201+50 TO STA. 205+50

SCALE 1" = 10'-0"
0 10

CROSS SECTION SHEET 25

PROJECT NAME: BOLTON-WATERBURY

PROJECT NUMBER: STP 2709(I)

FILE NAME: p07C172.dgn

PROJECT LEADER: CDL

DESIGNED BY: BMB

PLOT FILE: p07C172.151.I

PLOT DATE: 4/16/2013

DRAWN BY: BMB

CHECKED BY: CDL

SHEET 151 OF 217