




211+50

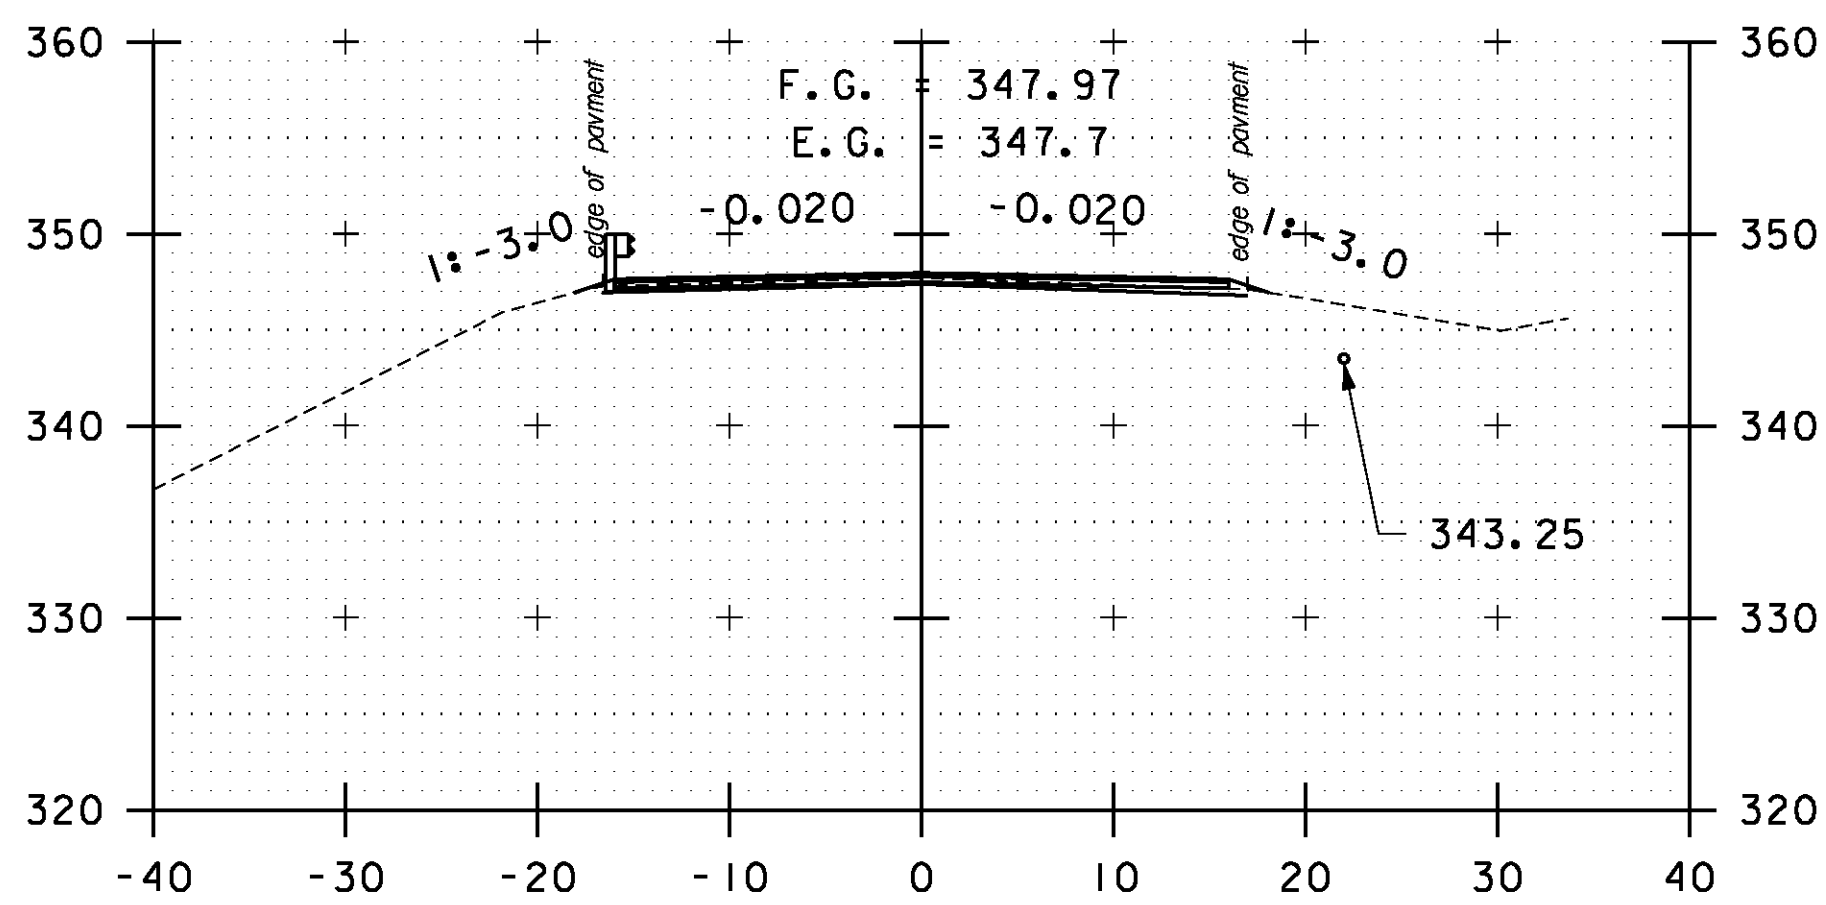


213+00

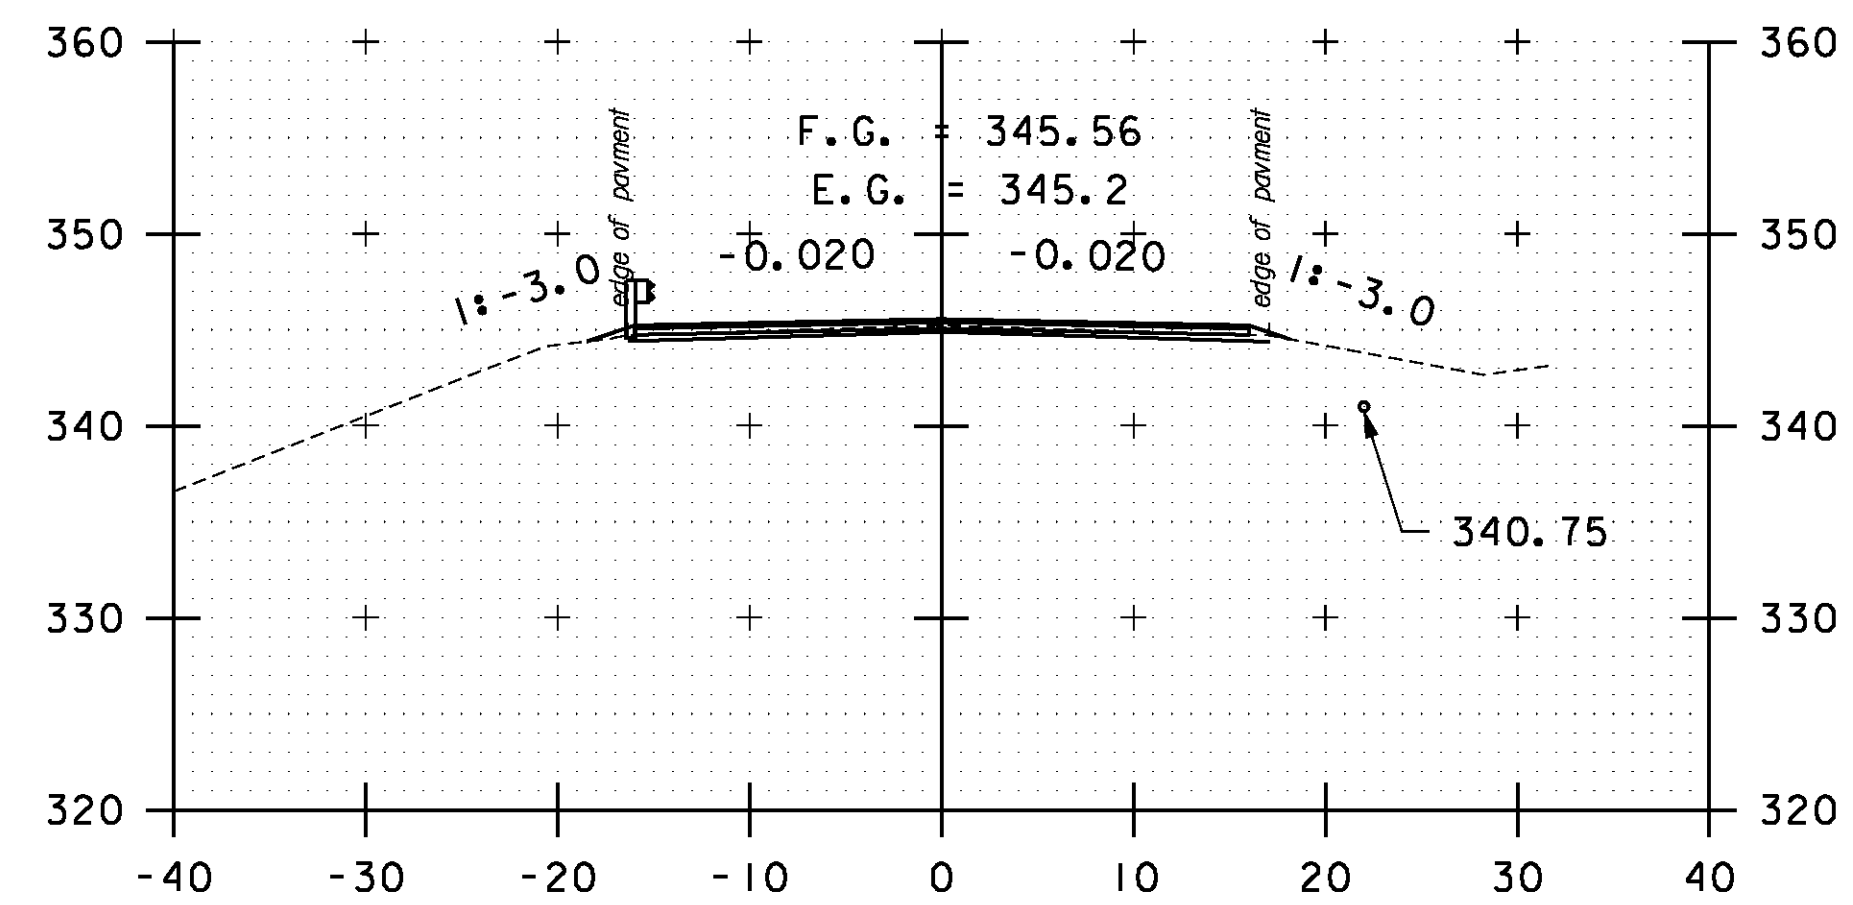


214+50

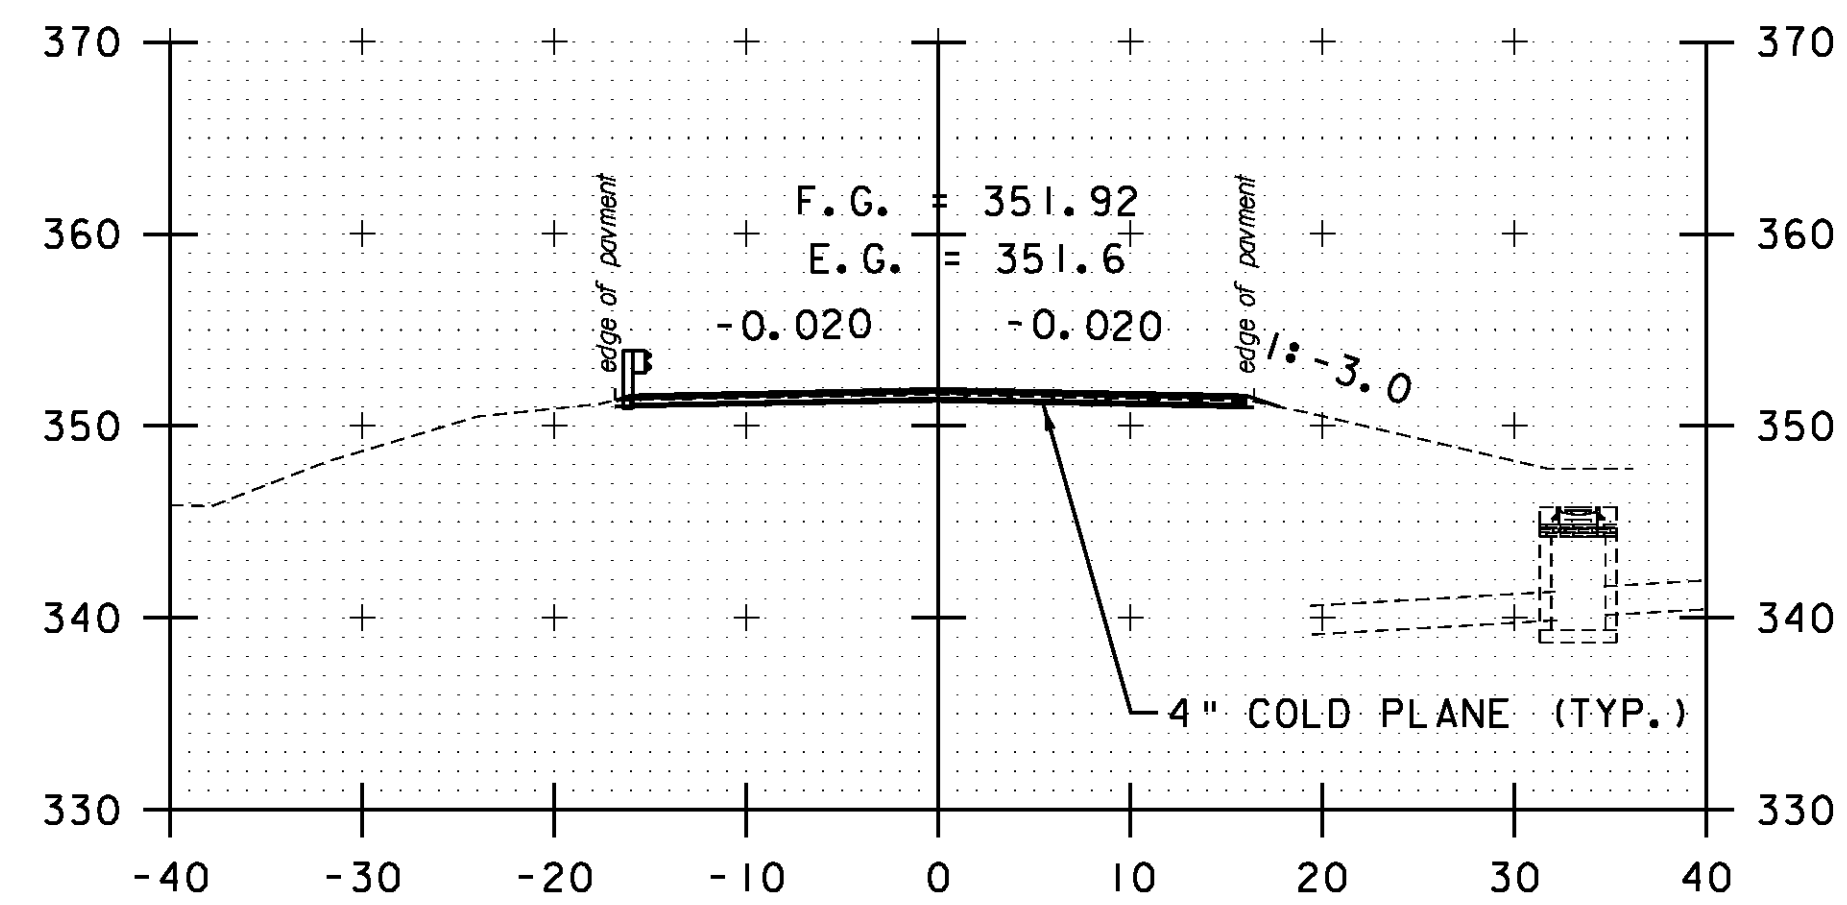


211+00

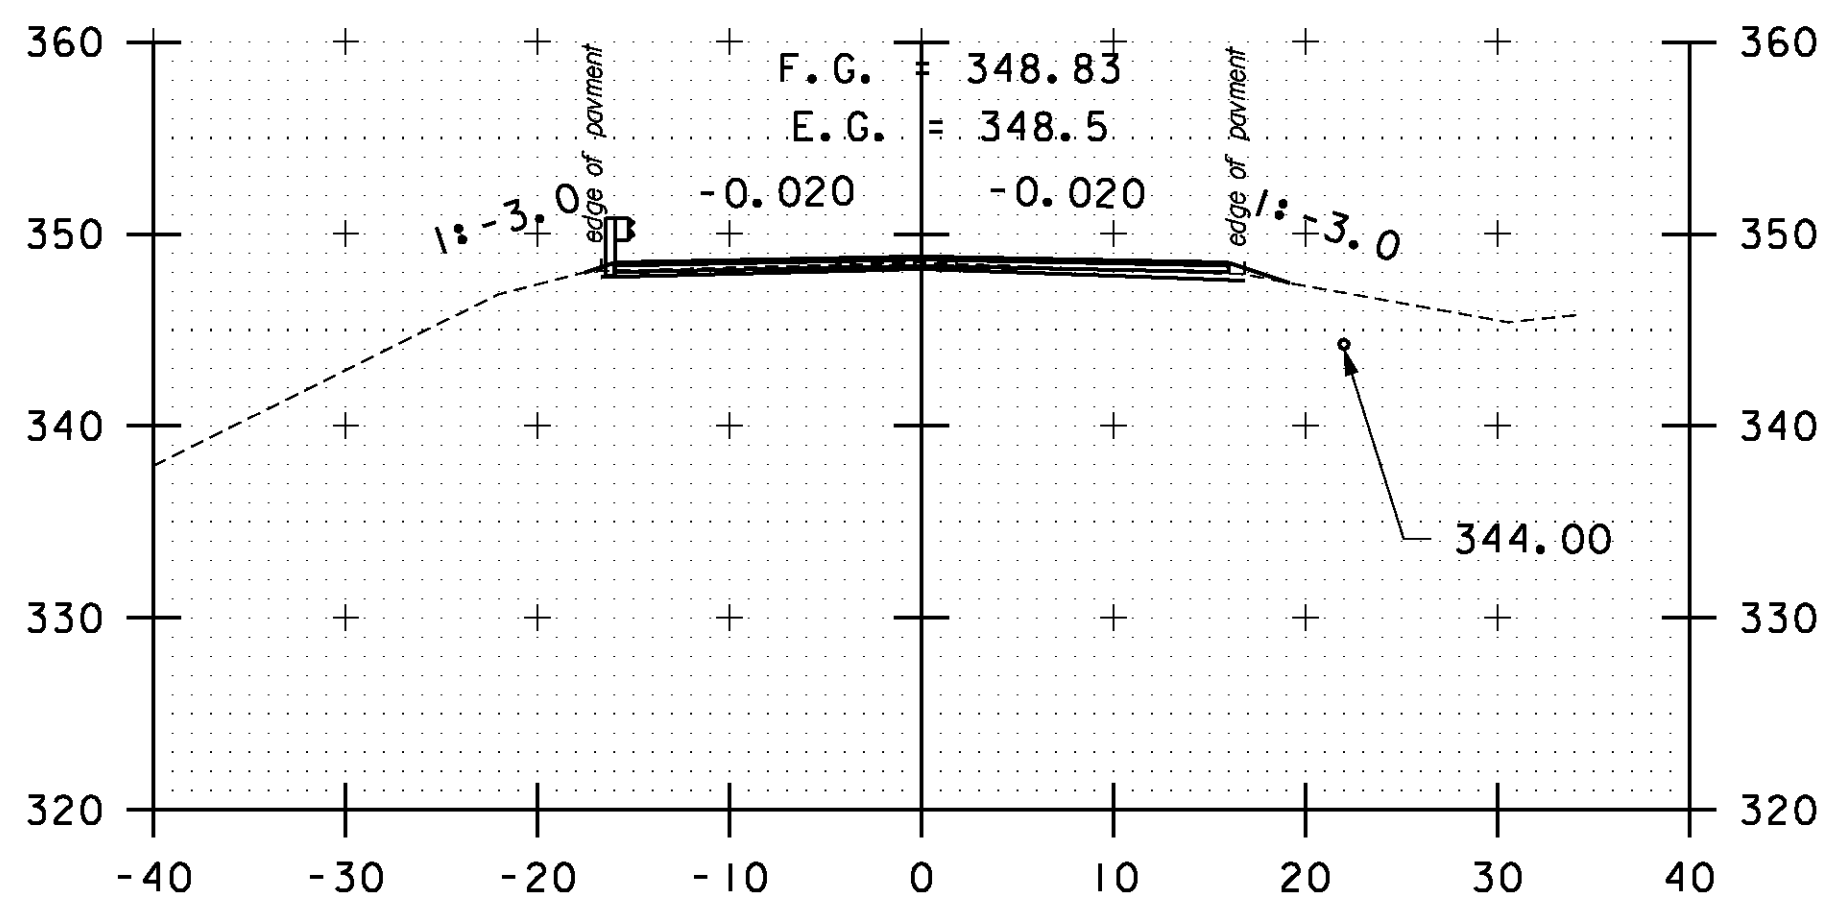


212+50

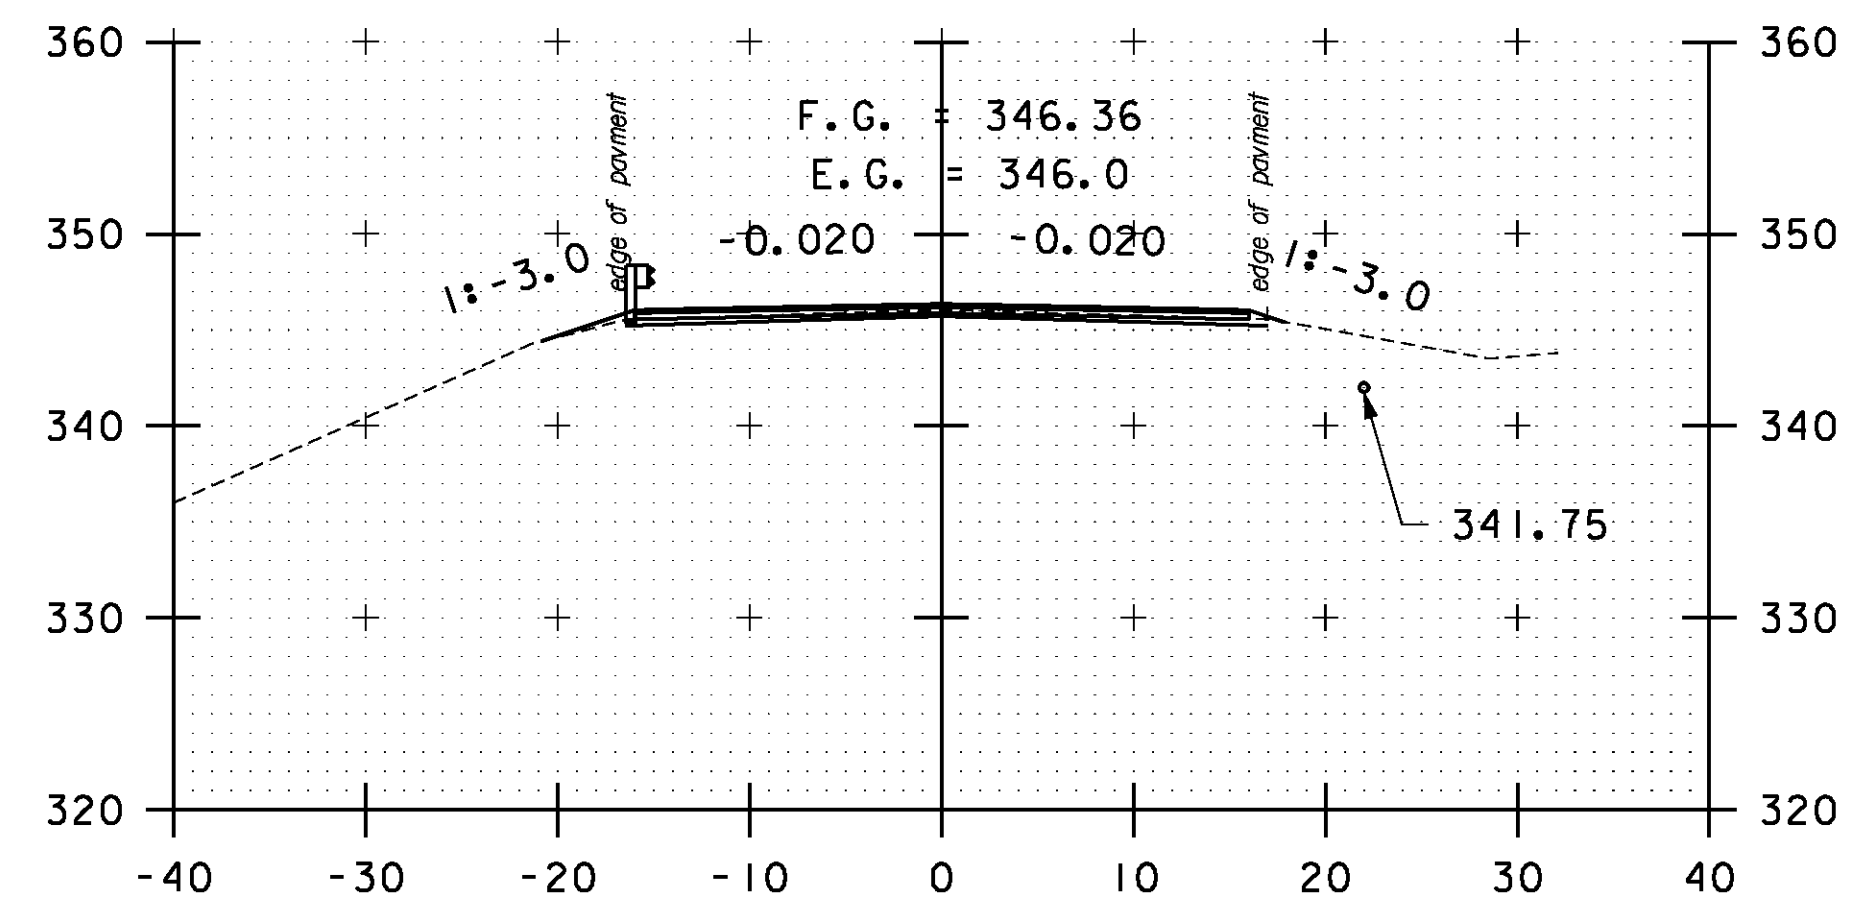


214+00

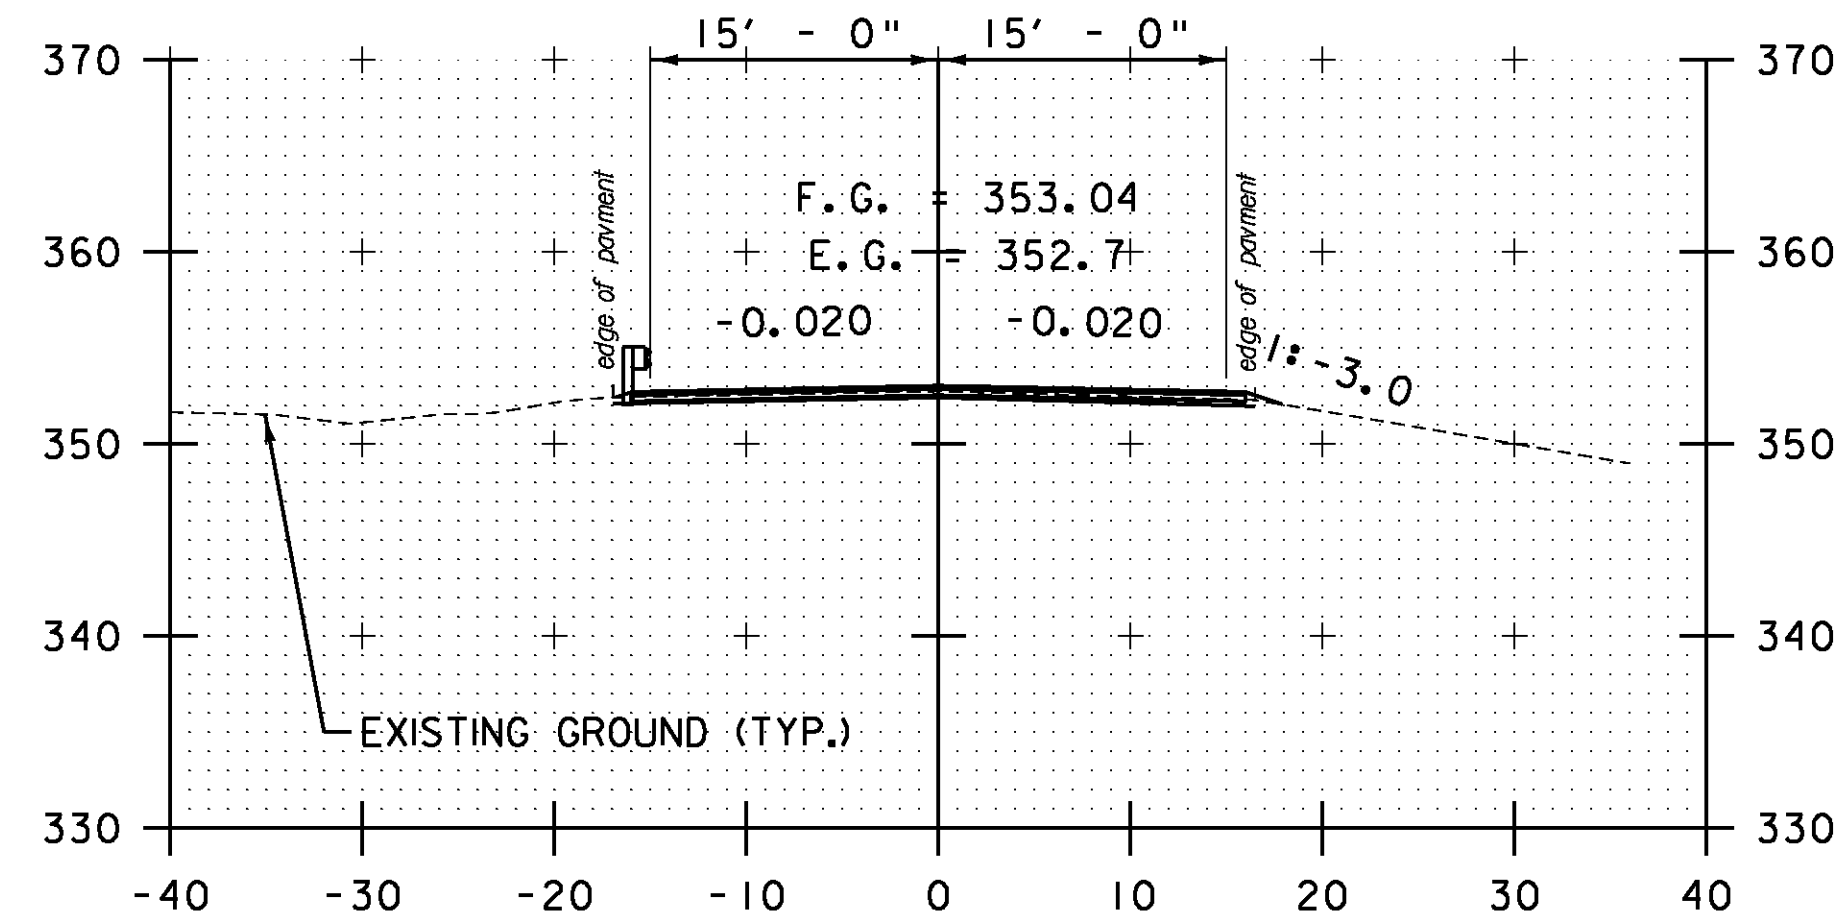

210+50

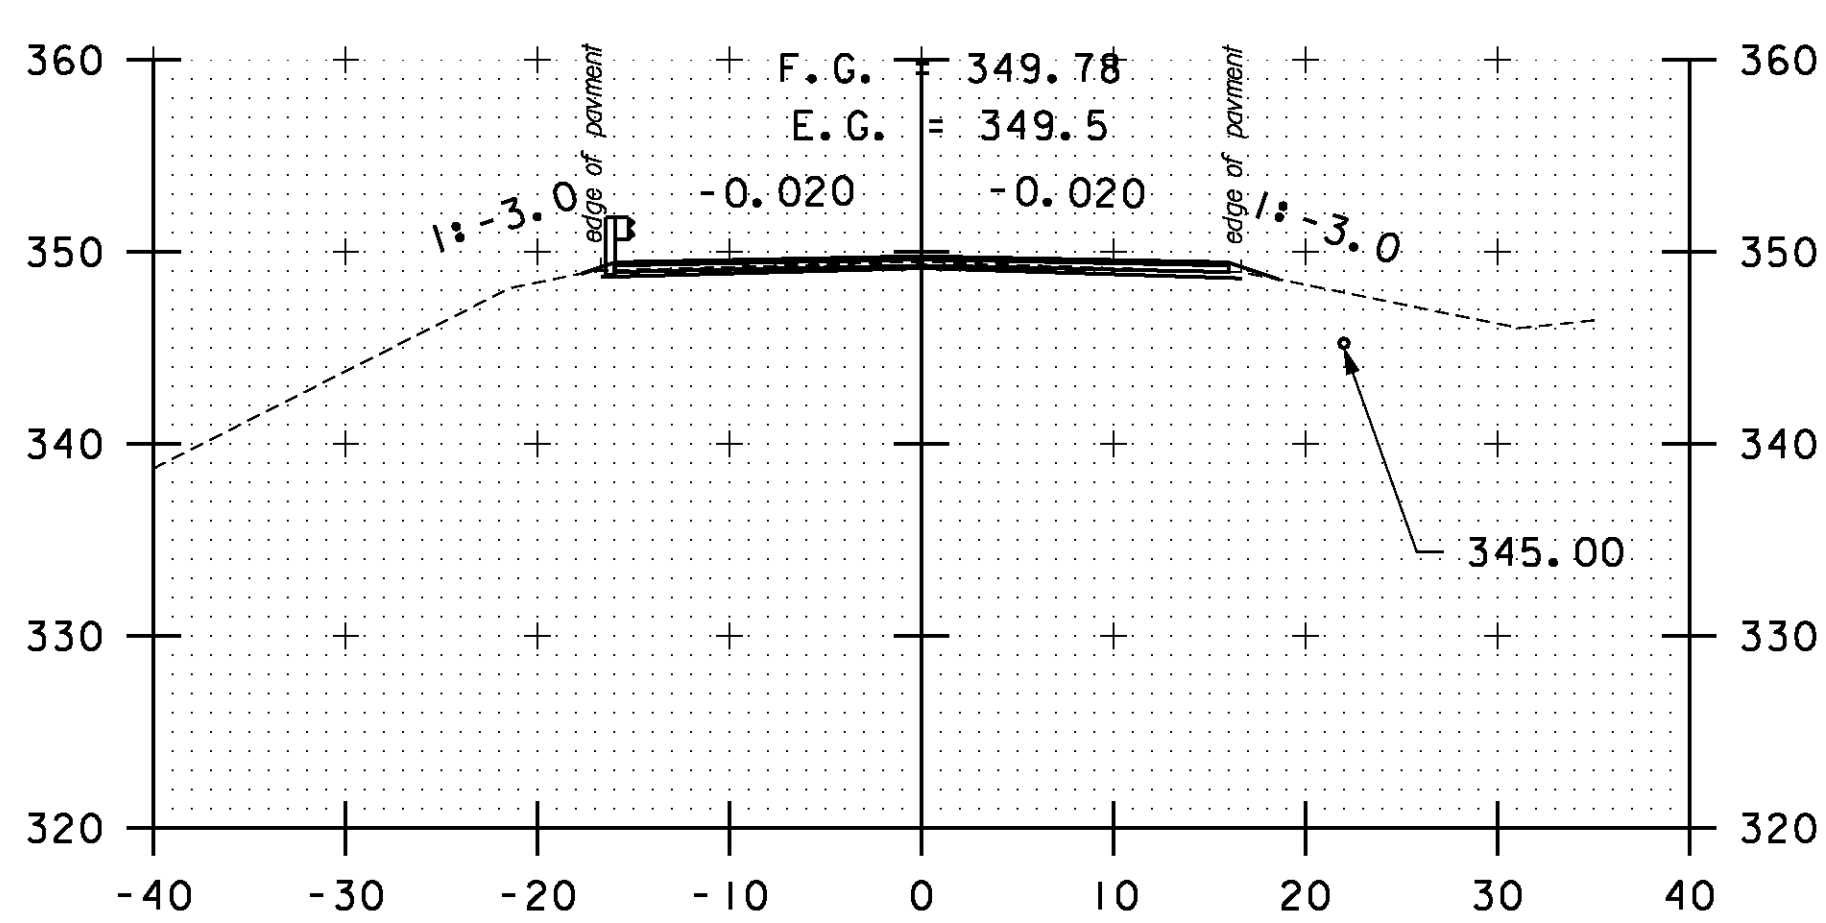

212+00

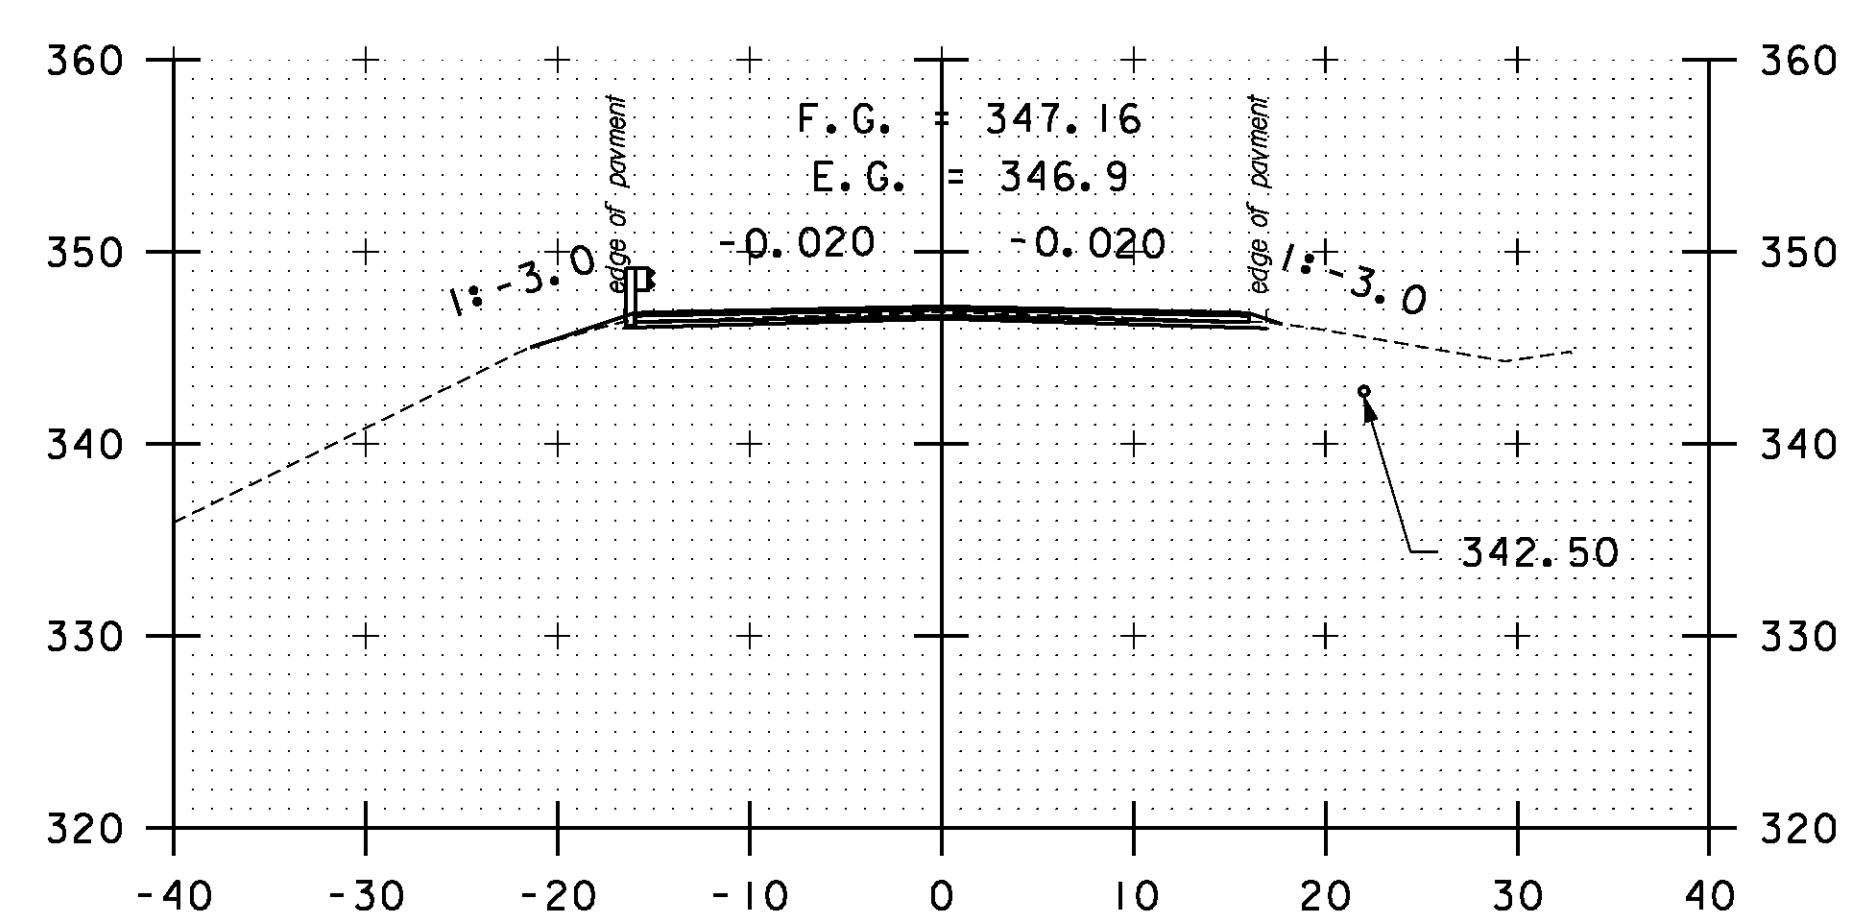

213+50

STA. 210+50 TO STA. 214+50

SCALE 1" = 10'-0"

CROSS SECTION SHEET 27

PROJECT NAME: BOLTON-WATERBURY

PROJECT NUMBER: STP 2709(I)

FILE NAME: p07C172.dgn

PROJECT LEADER: CDL

DESIGNED BY: BMB

PLOT FILE: p07C172.I53.1

PLOT DATE: 4/16/2013

DRAWN BY: BMB

CHECKED BY: CDL

SHEET 153 OF 217