




216+00

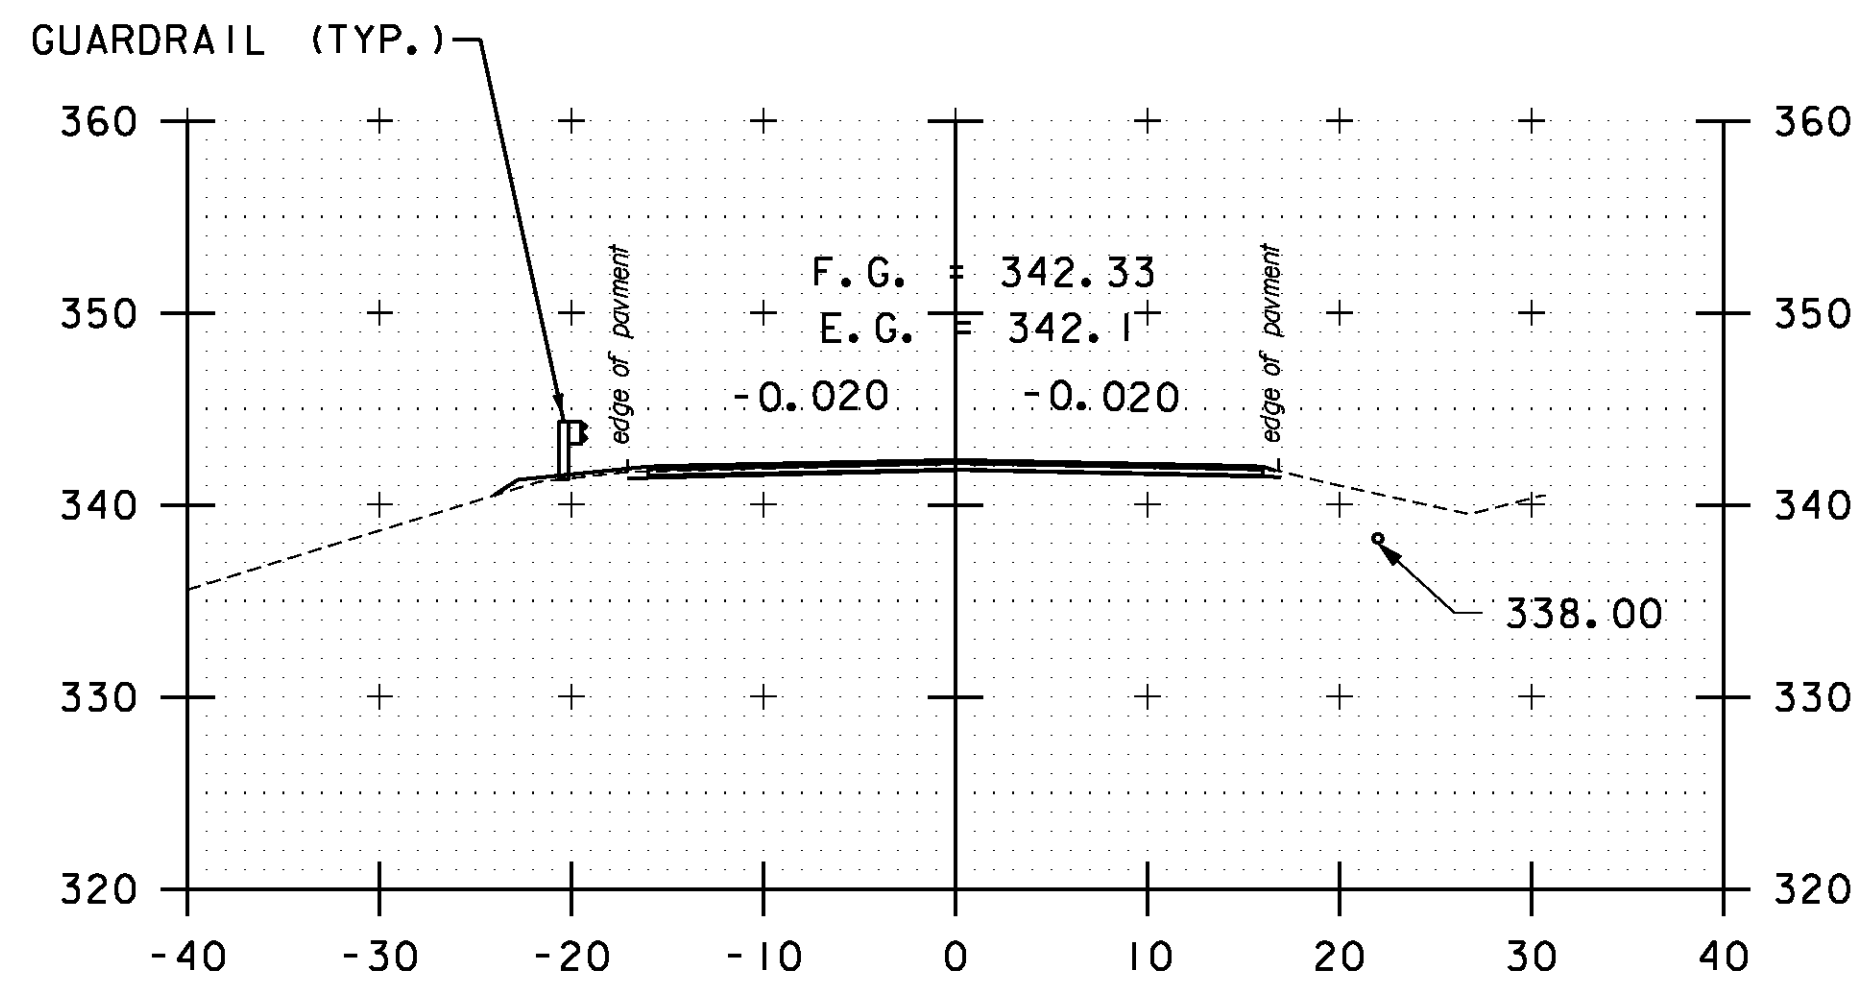


217+50

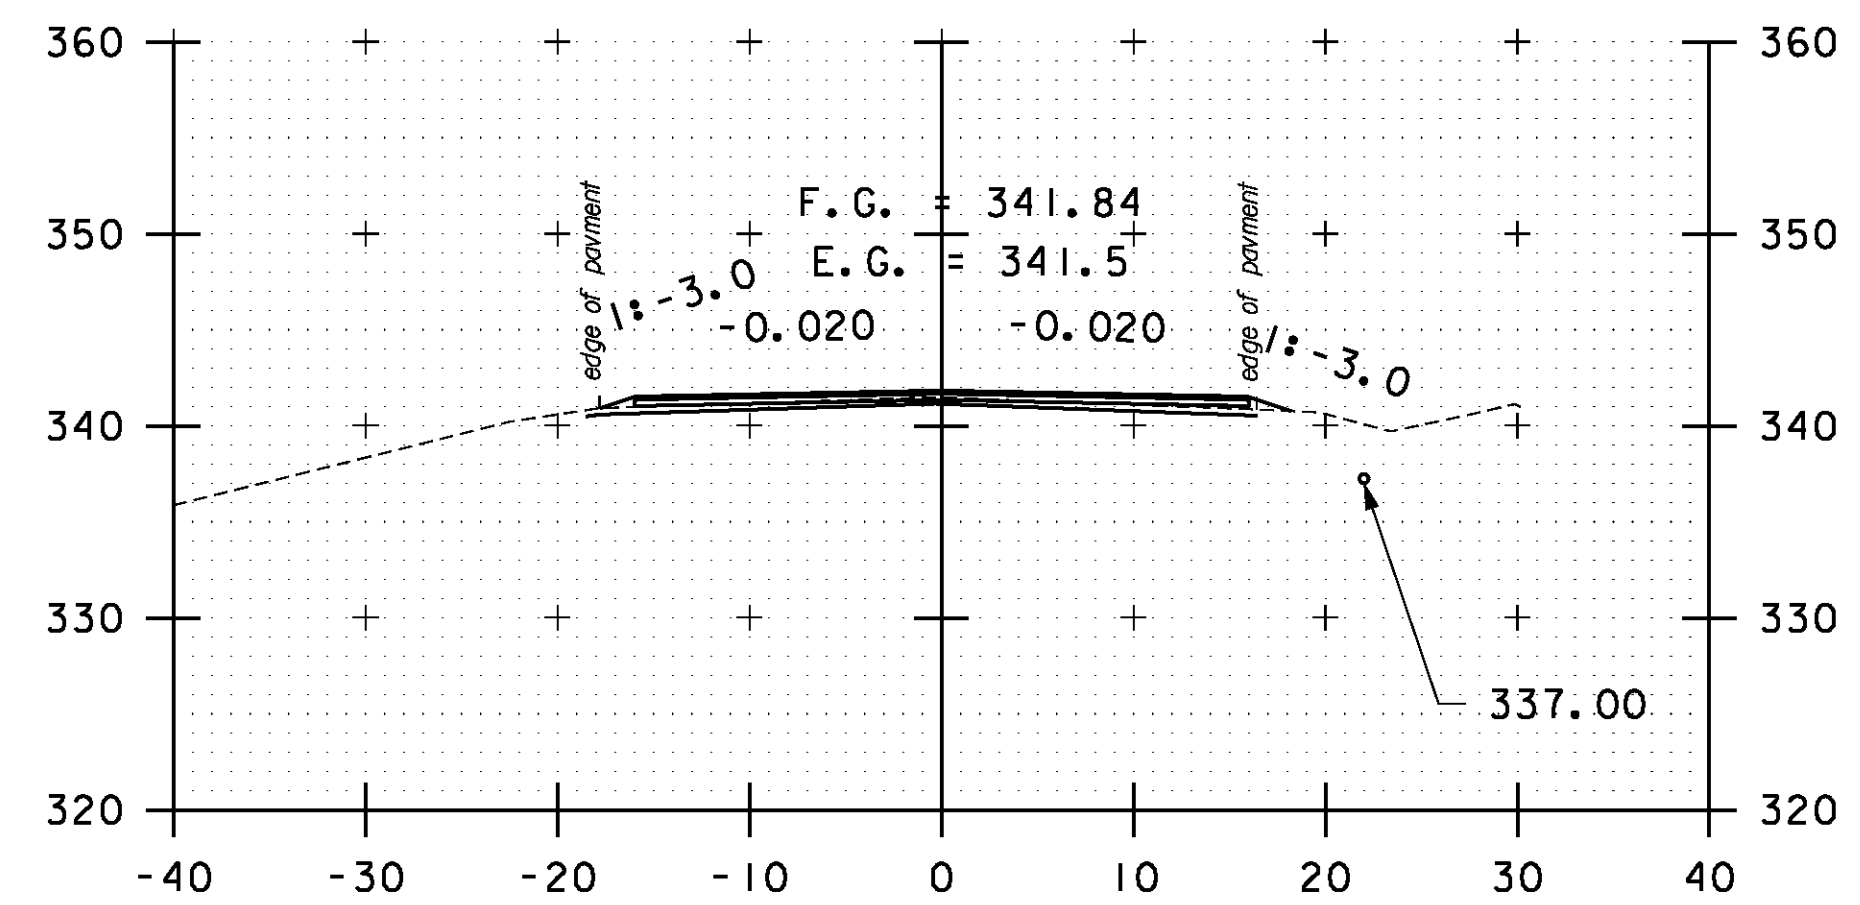


219+00

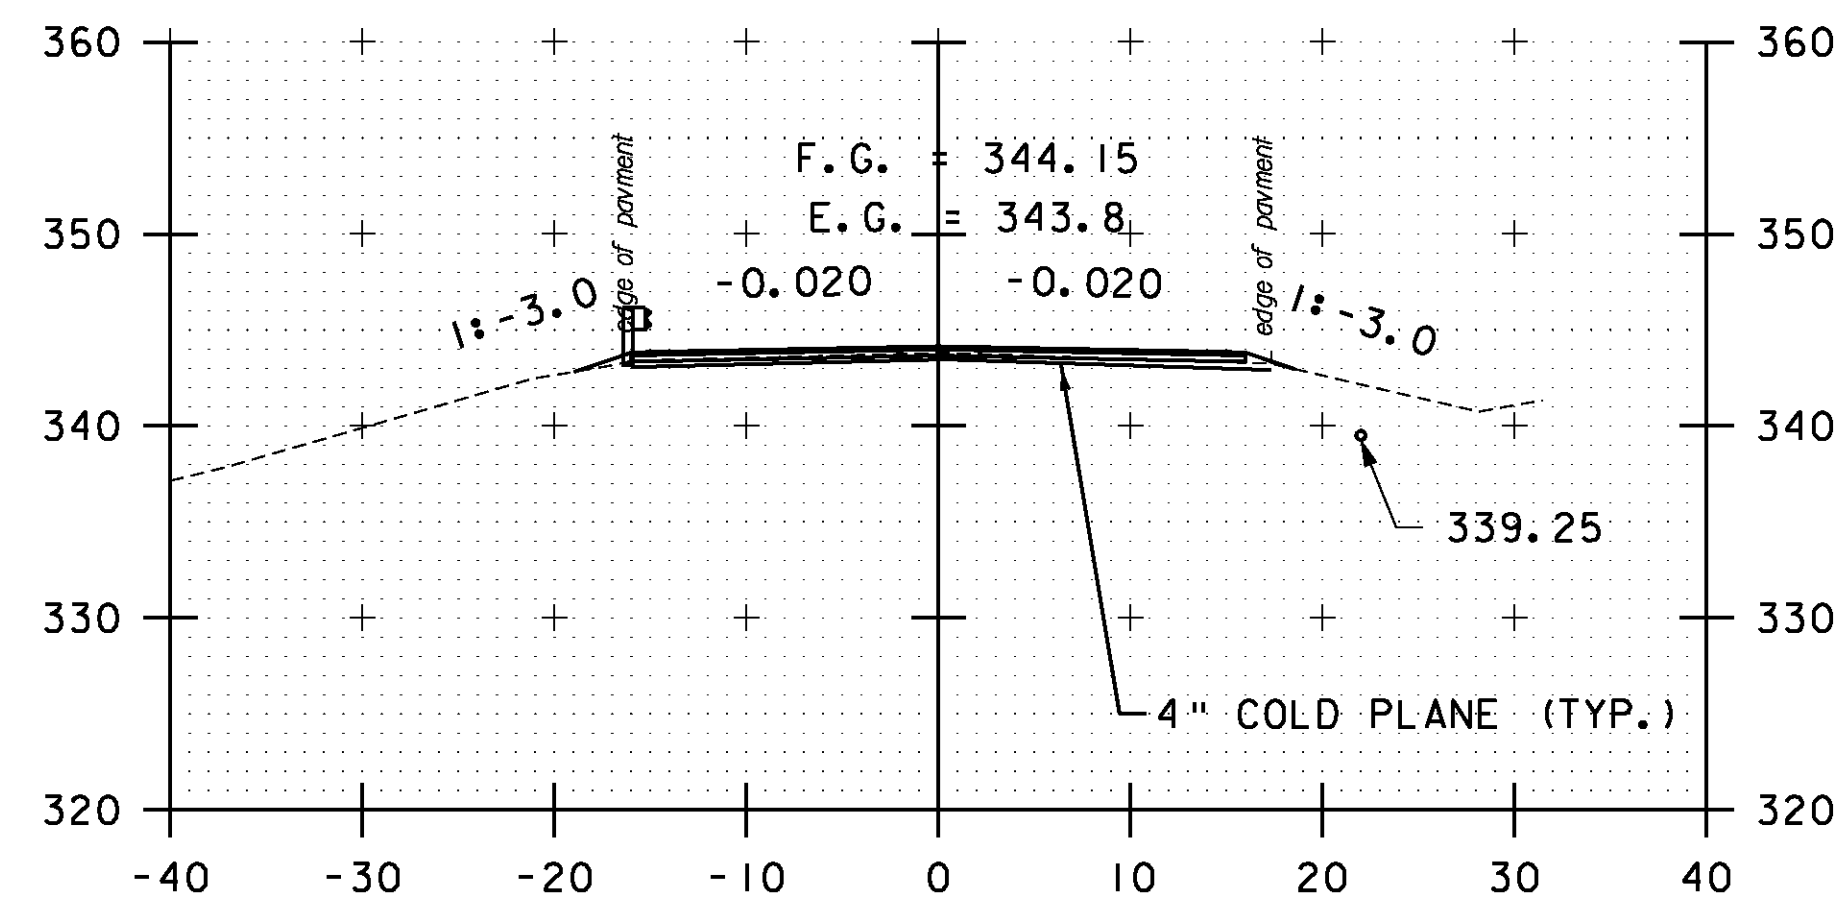


215+50

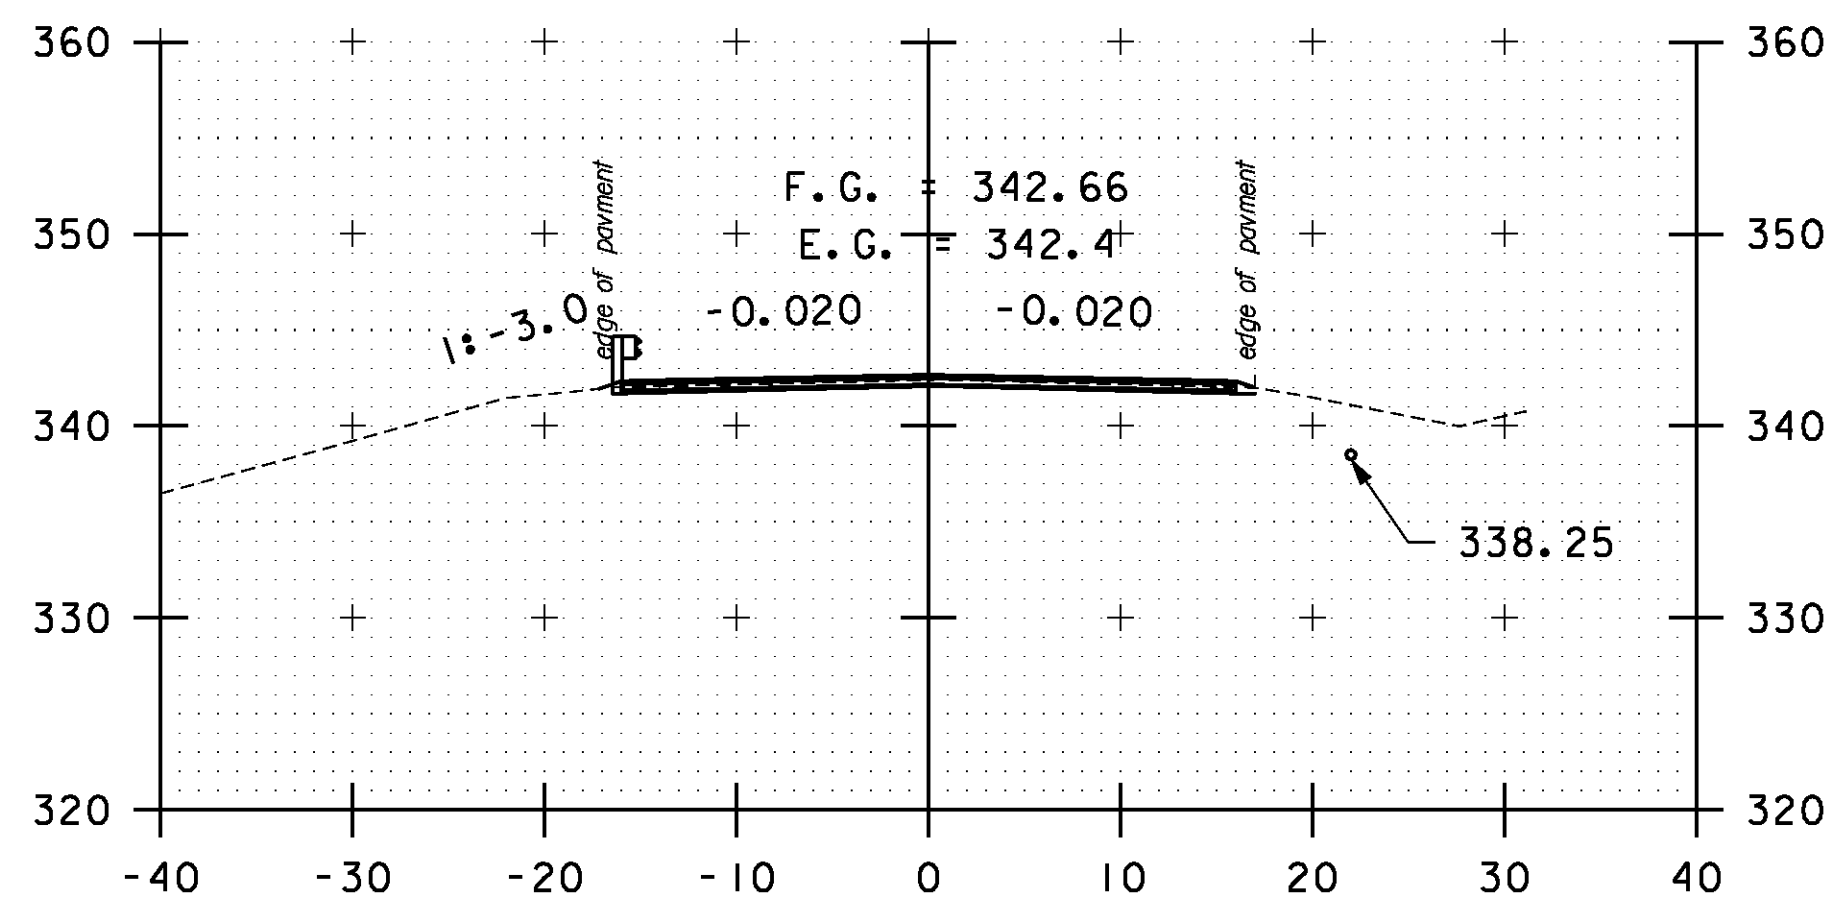


217+00

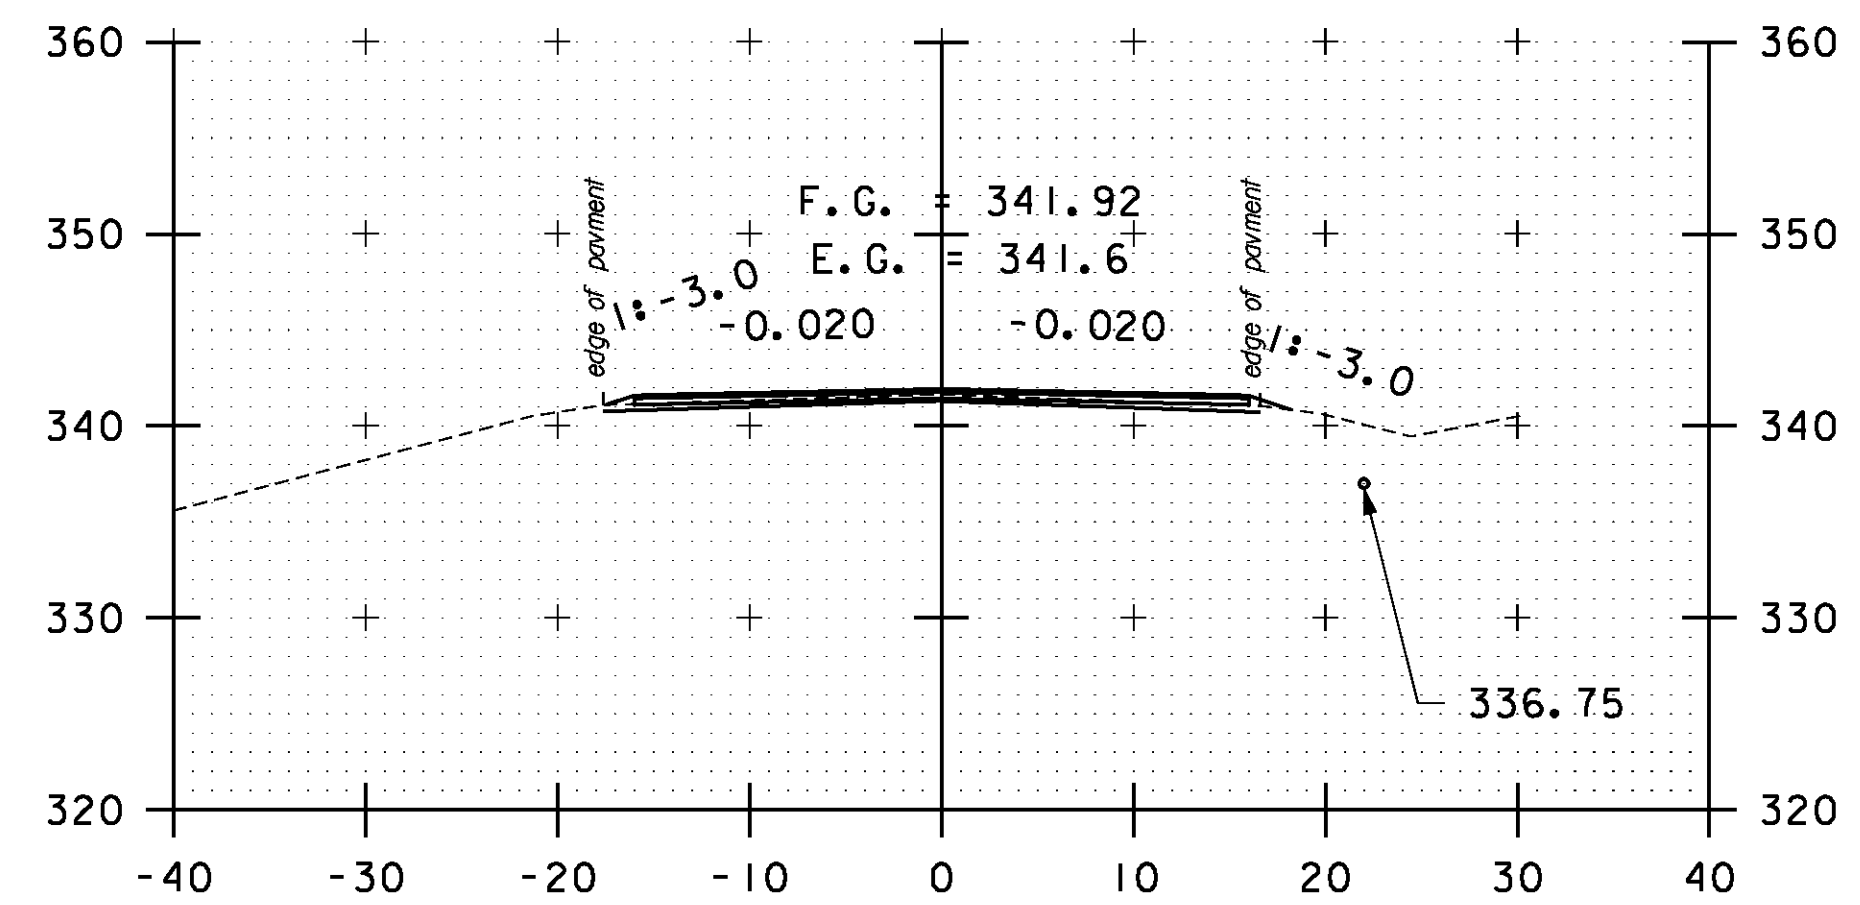


218+50

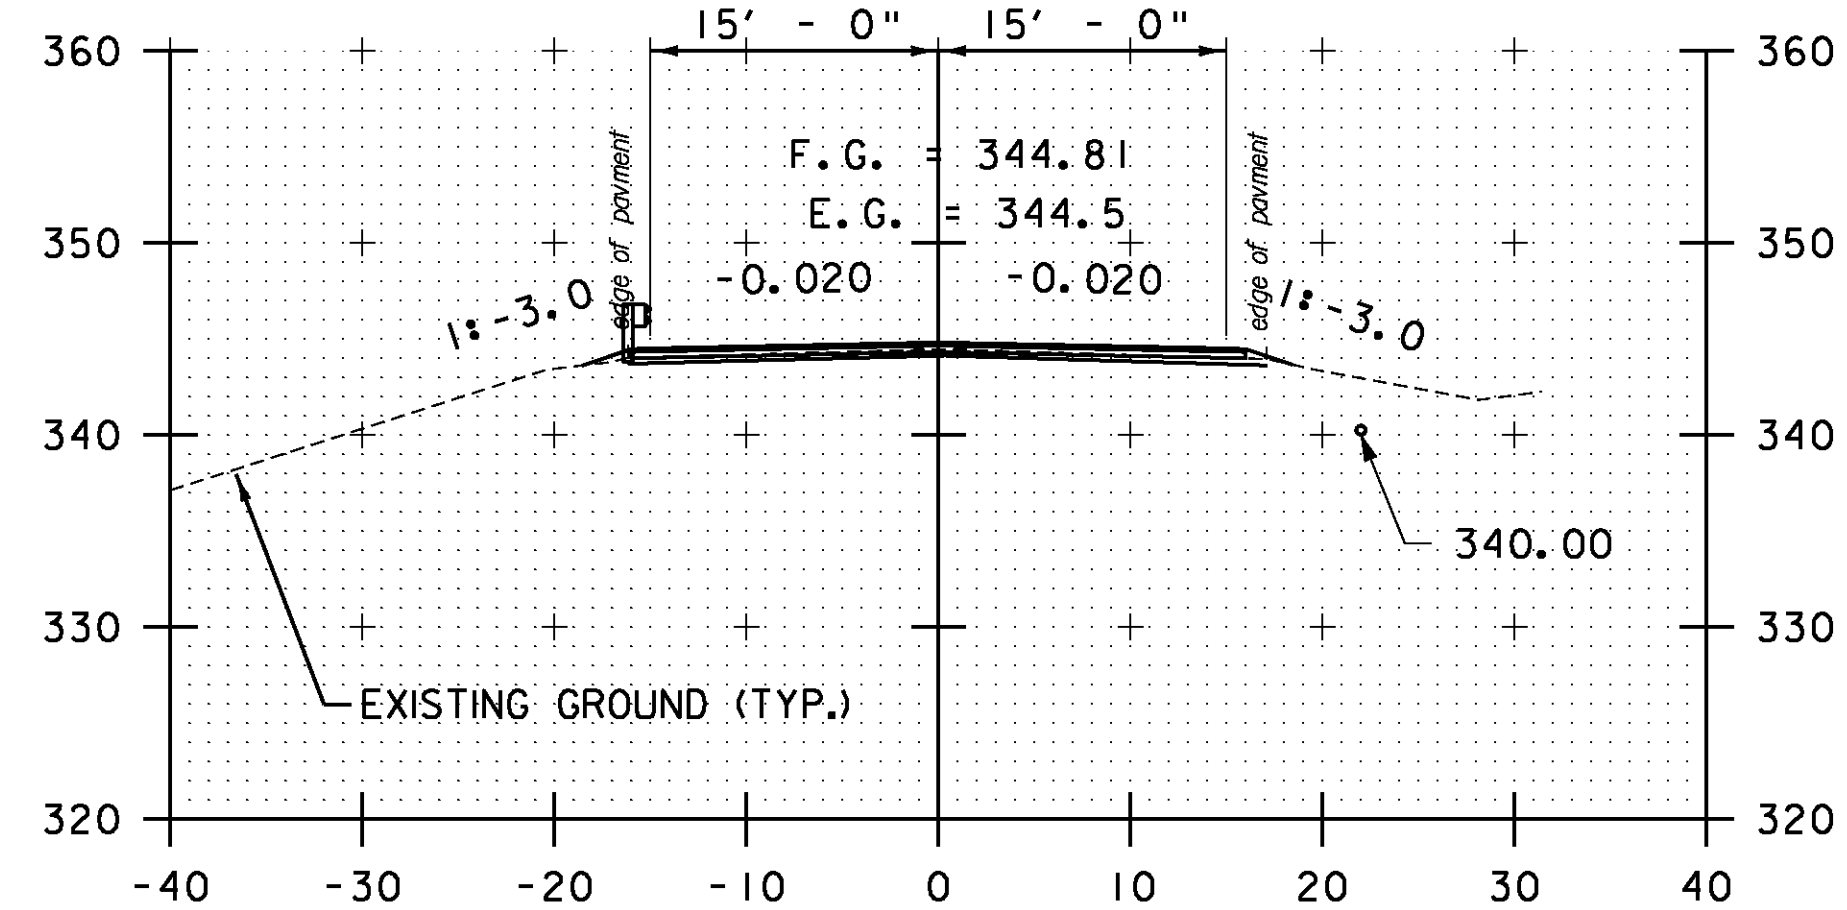

215+00

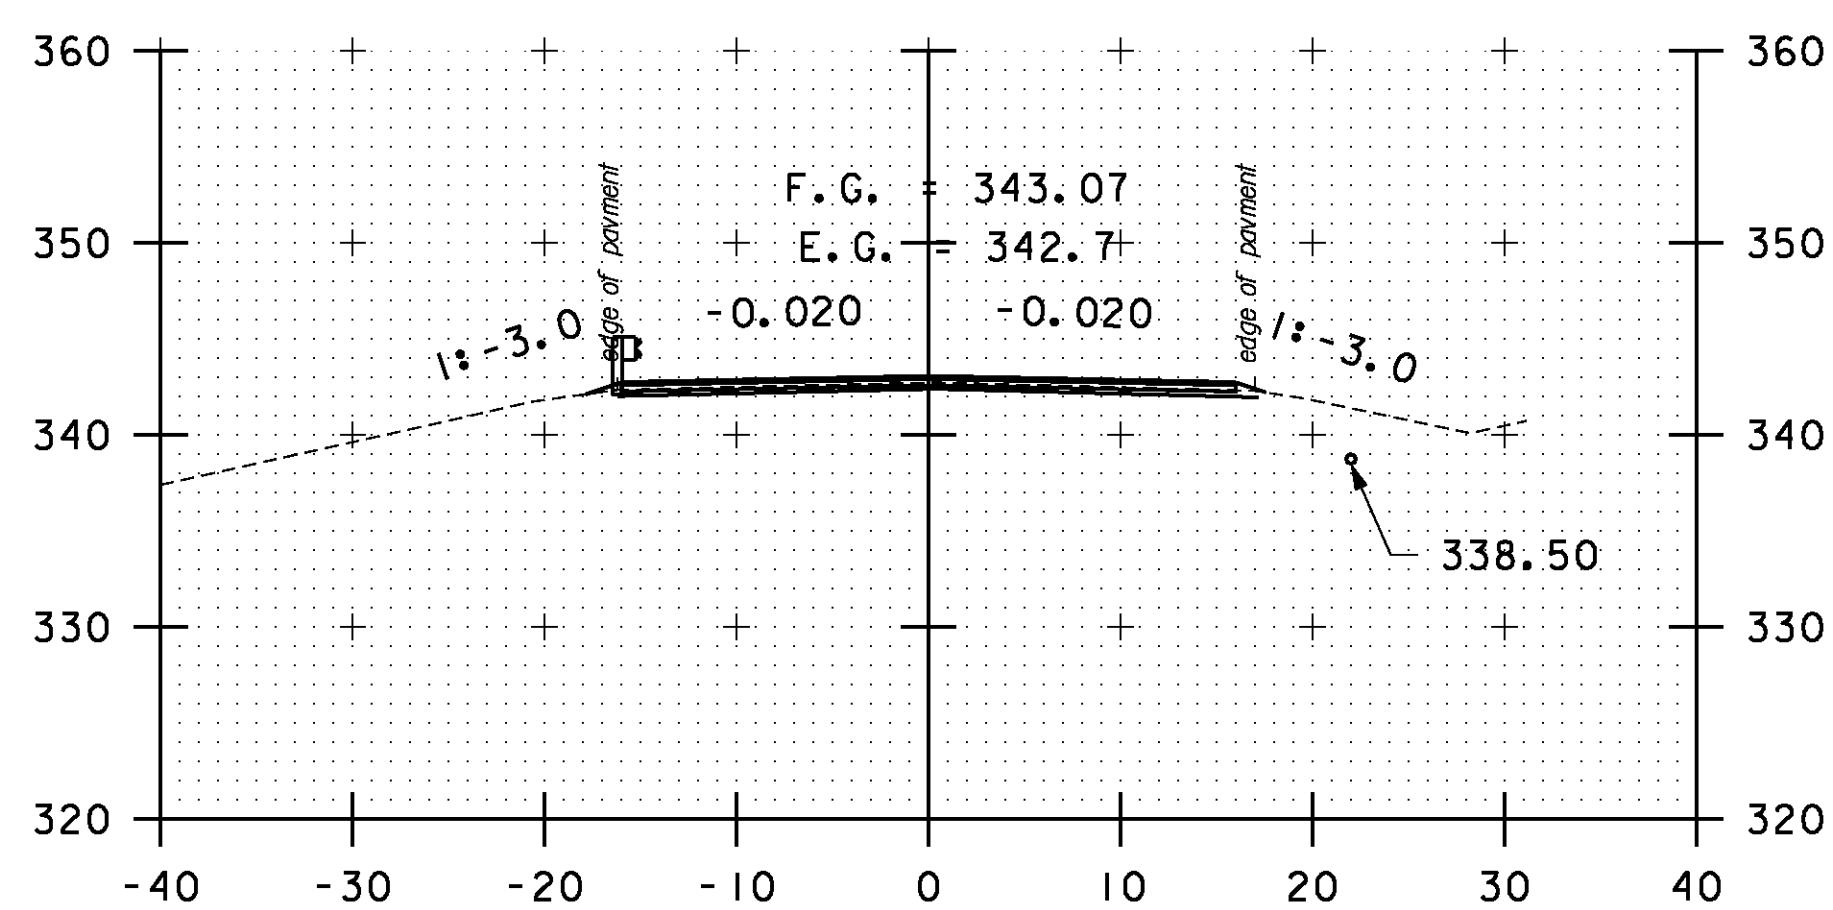

216+50

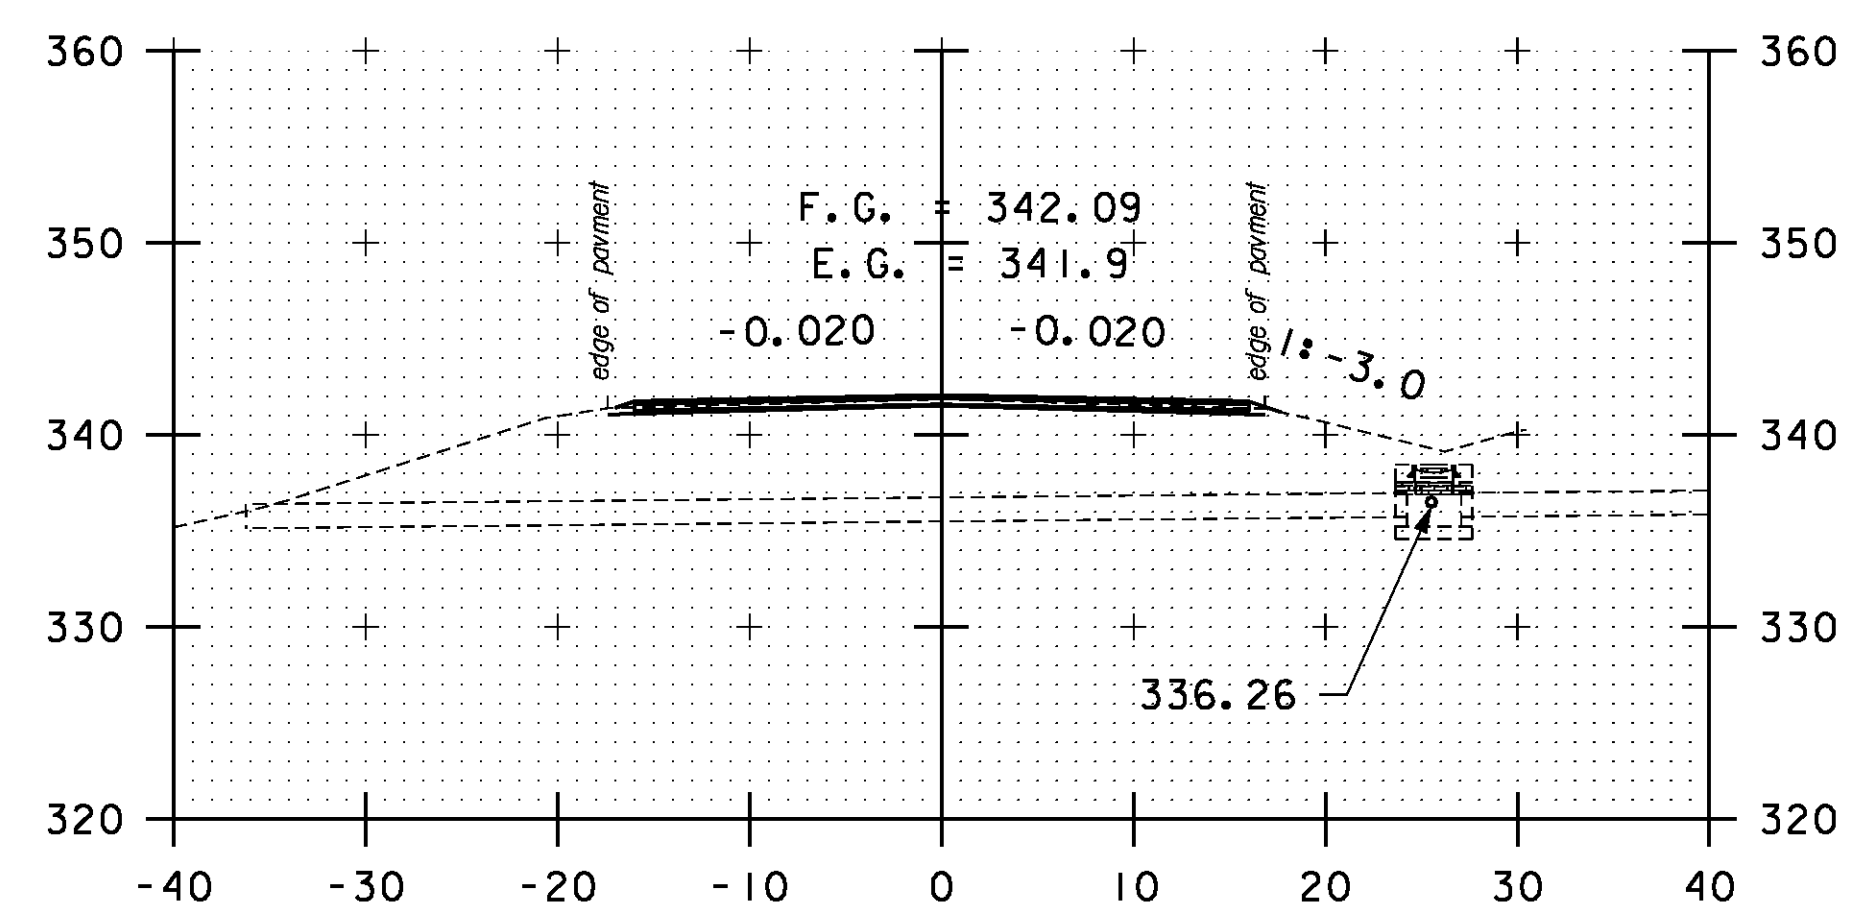

218+00

STA. 215+00 TO STA. 219+00

SCALE 1" = 10'-0"

CROSS SECTION SHEET 28

PROJECT NAME: BOLTON-WATERBURY

PROJECT NUMBER: STP 2709(I)

FILE NAME: p07C172.dgn

PROJECT LEADER: CDL

DESIGNED BY: BMB

PLOT FILE: p07C172.I54.1

PLOT DATE: 4/16/2013

DRAWN BY: BMB

CHECKED BY: CDL

SHEET 154 OF 217