




225+00

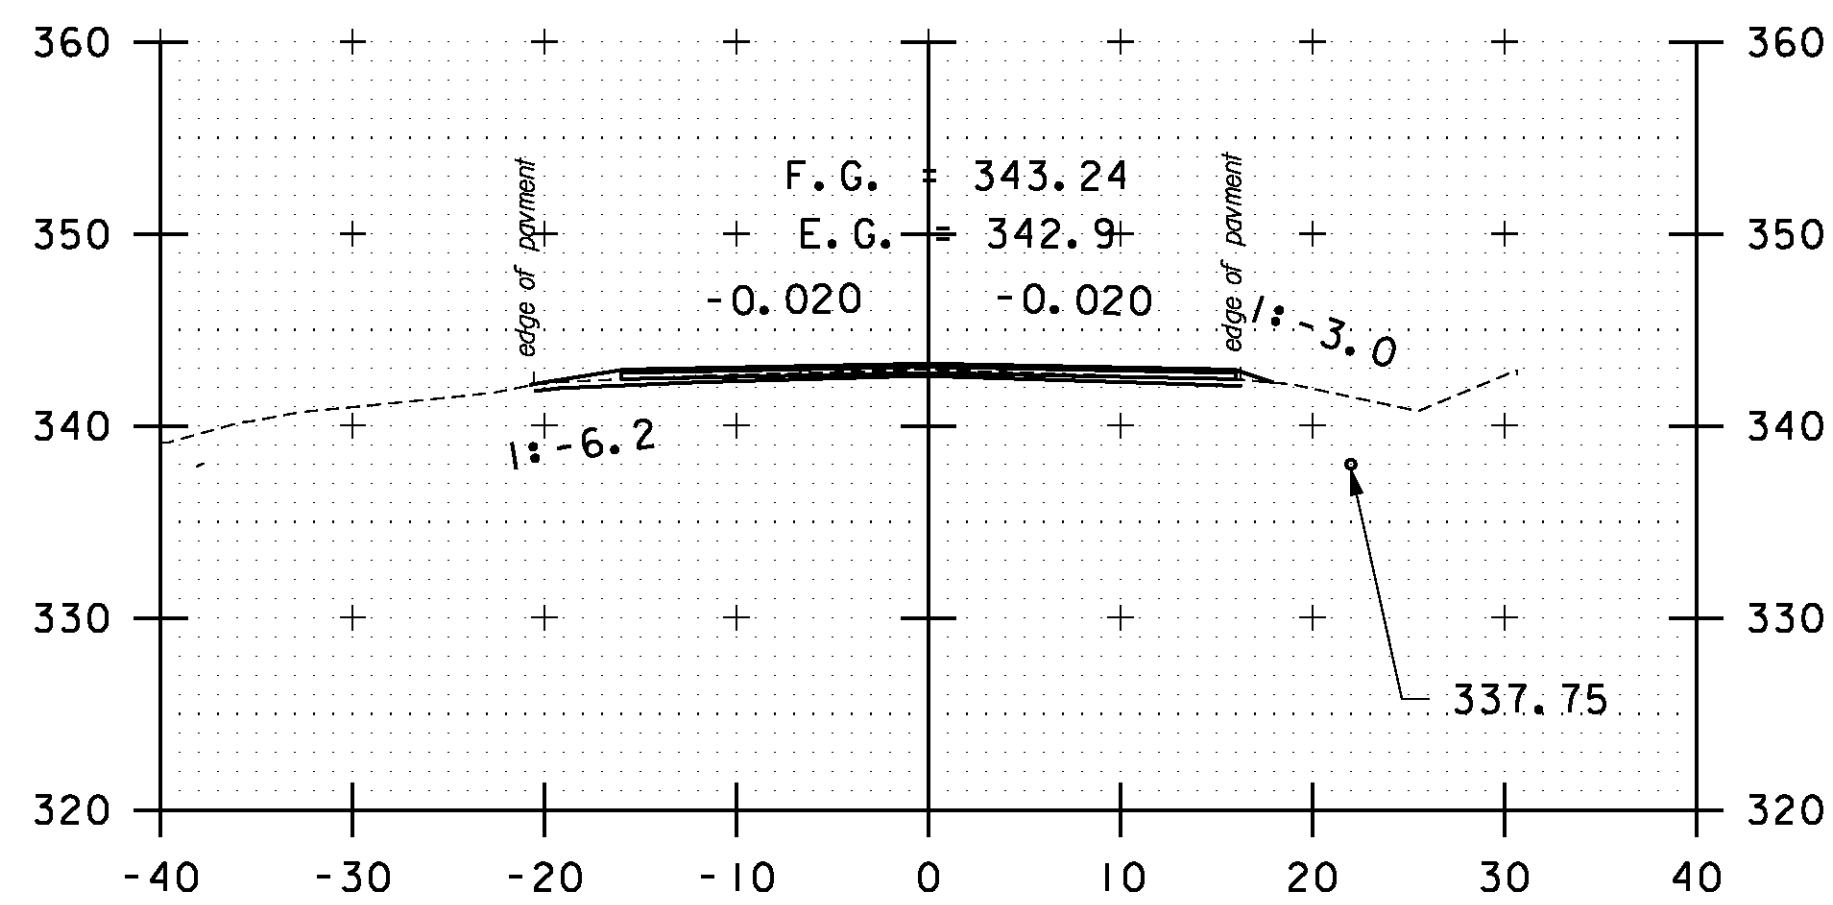


DRIVE LT
226+50

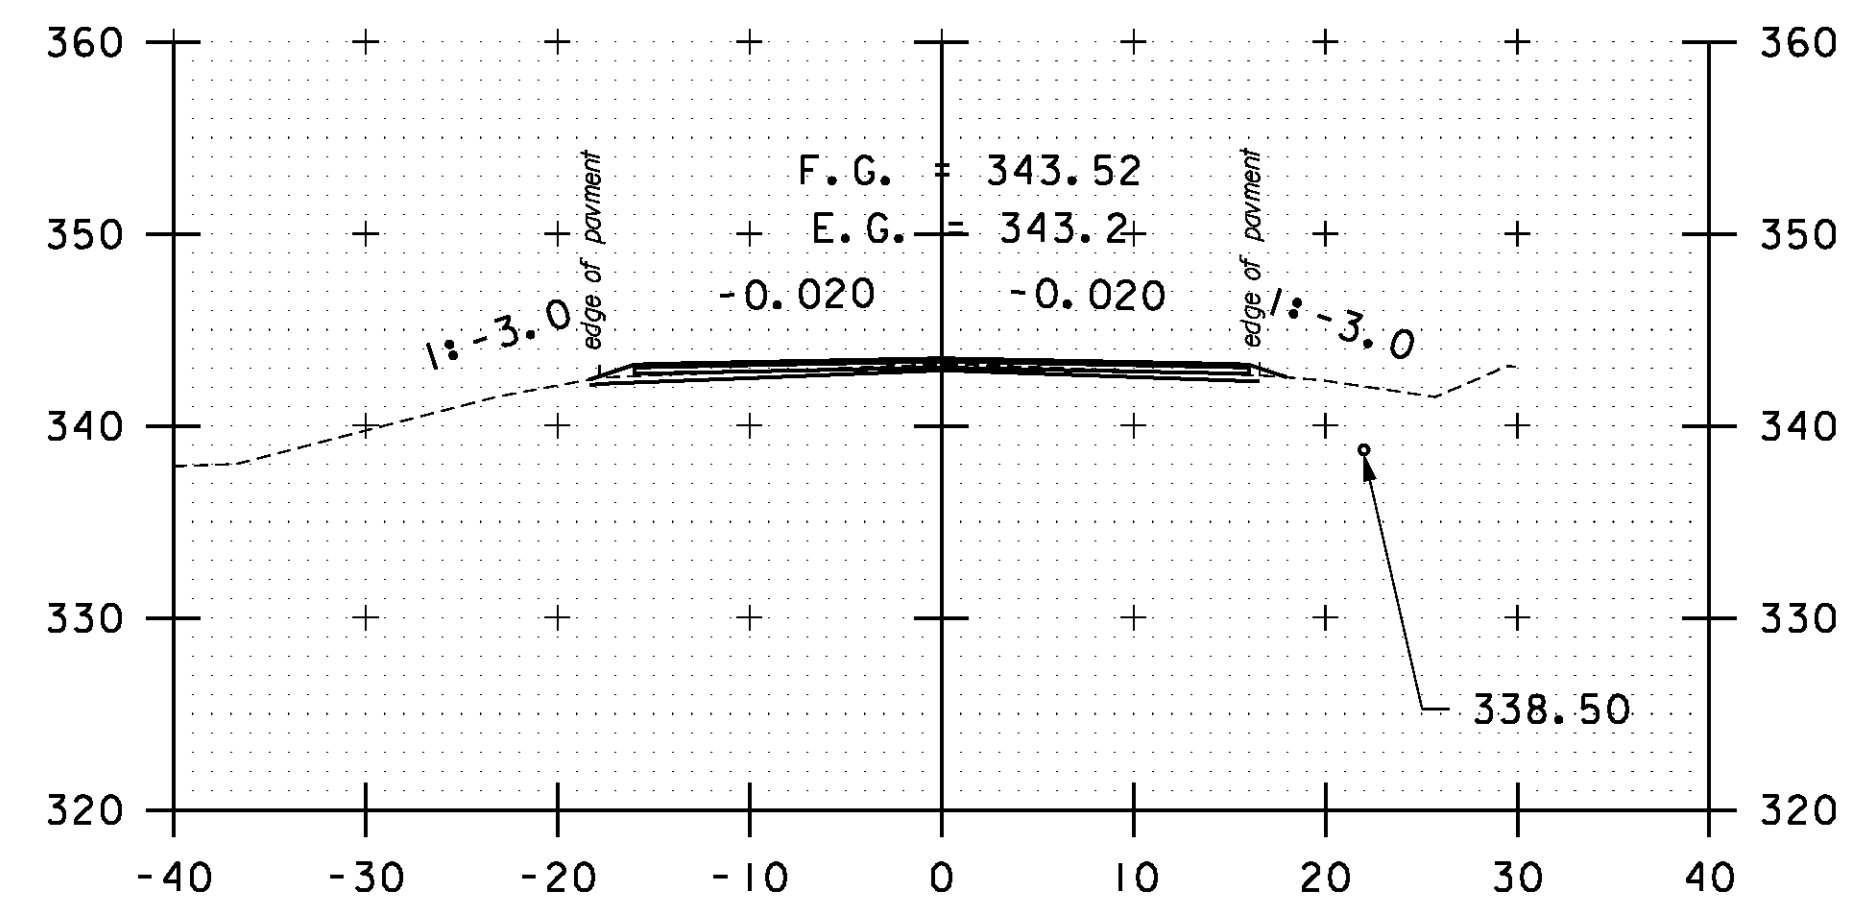


228+00

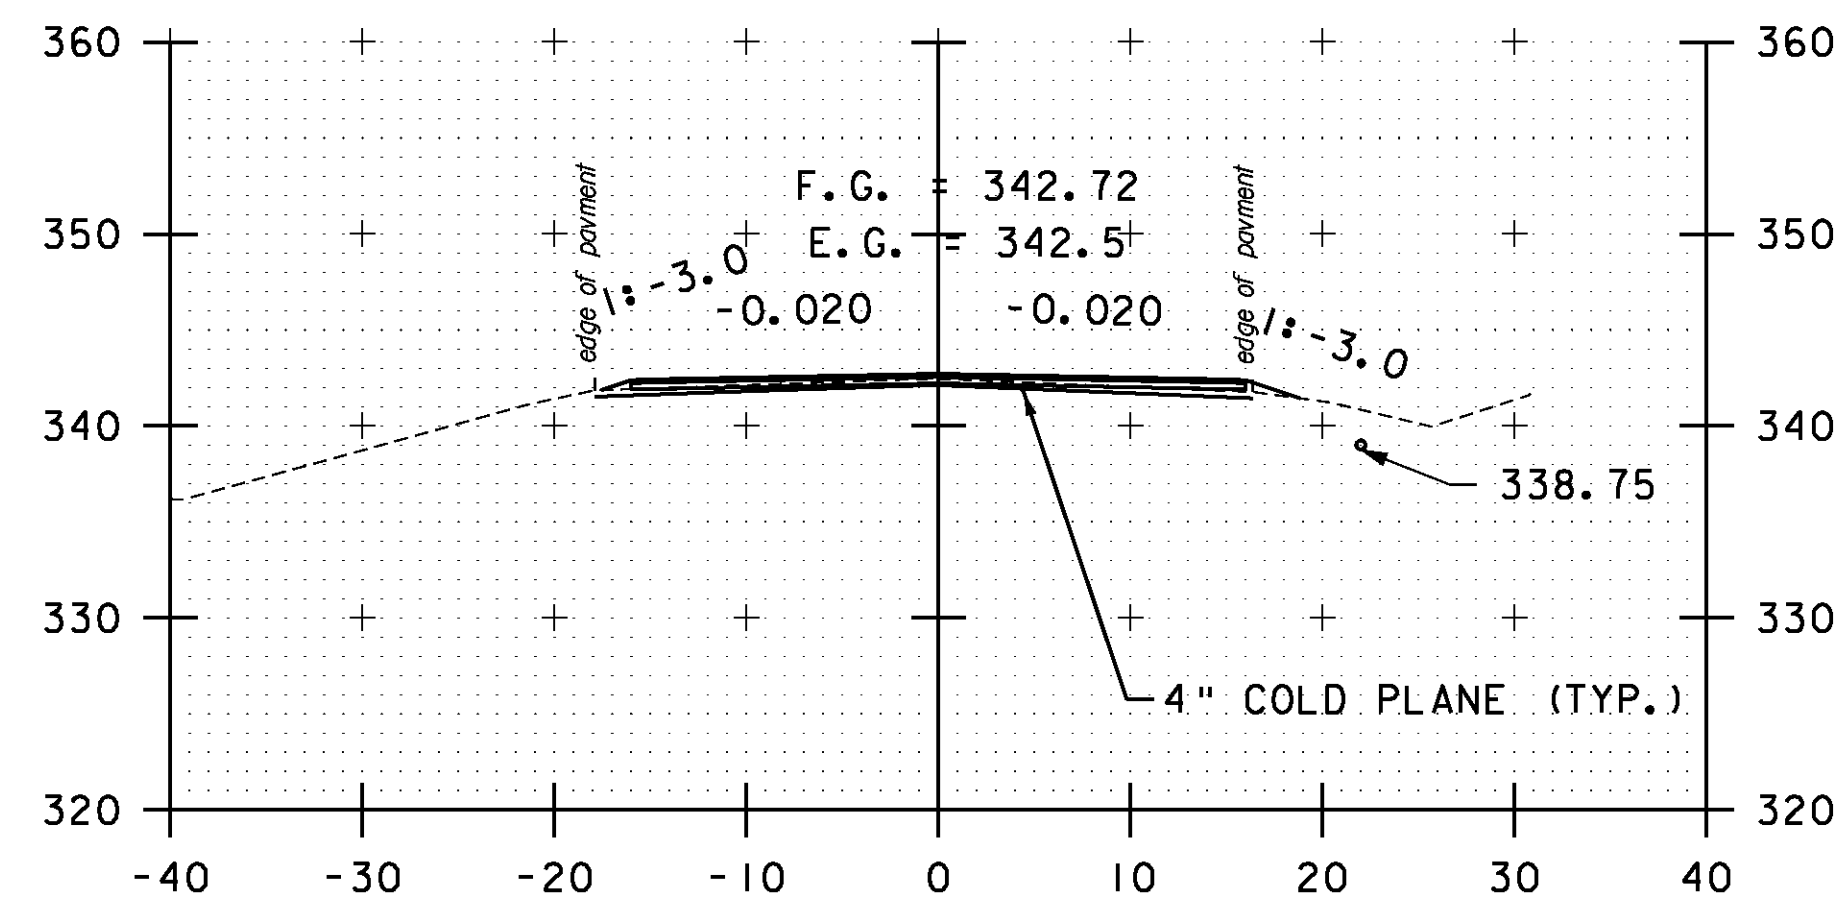


224+50

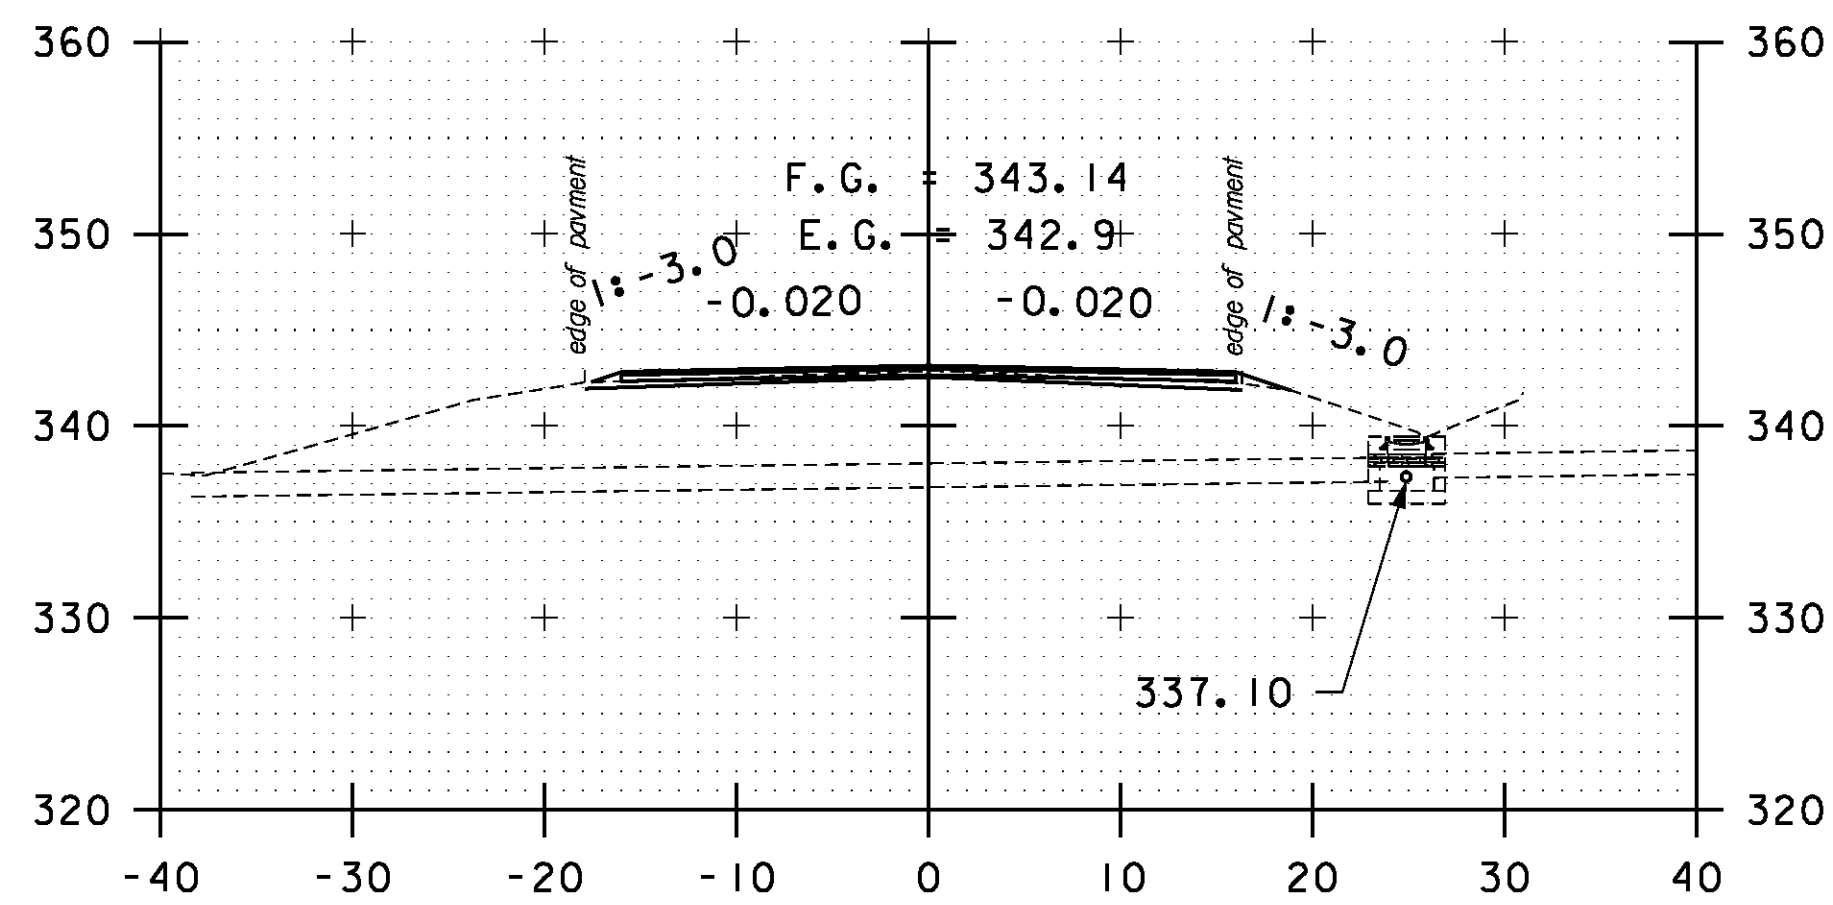


226+00

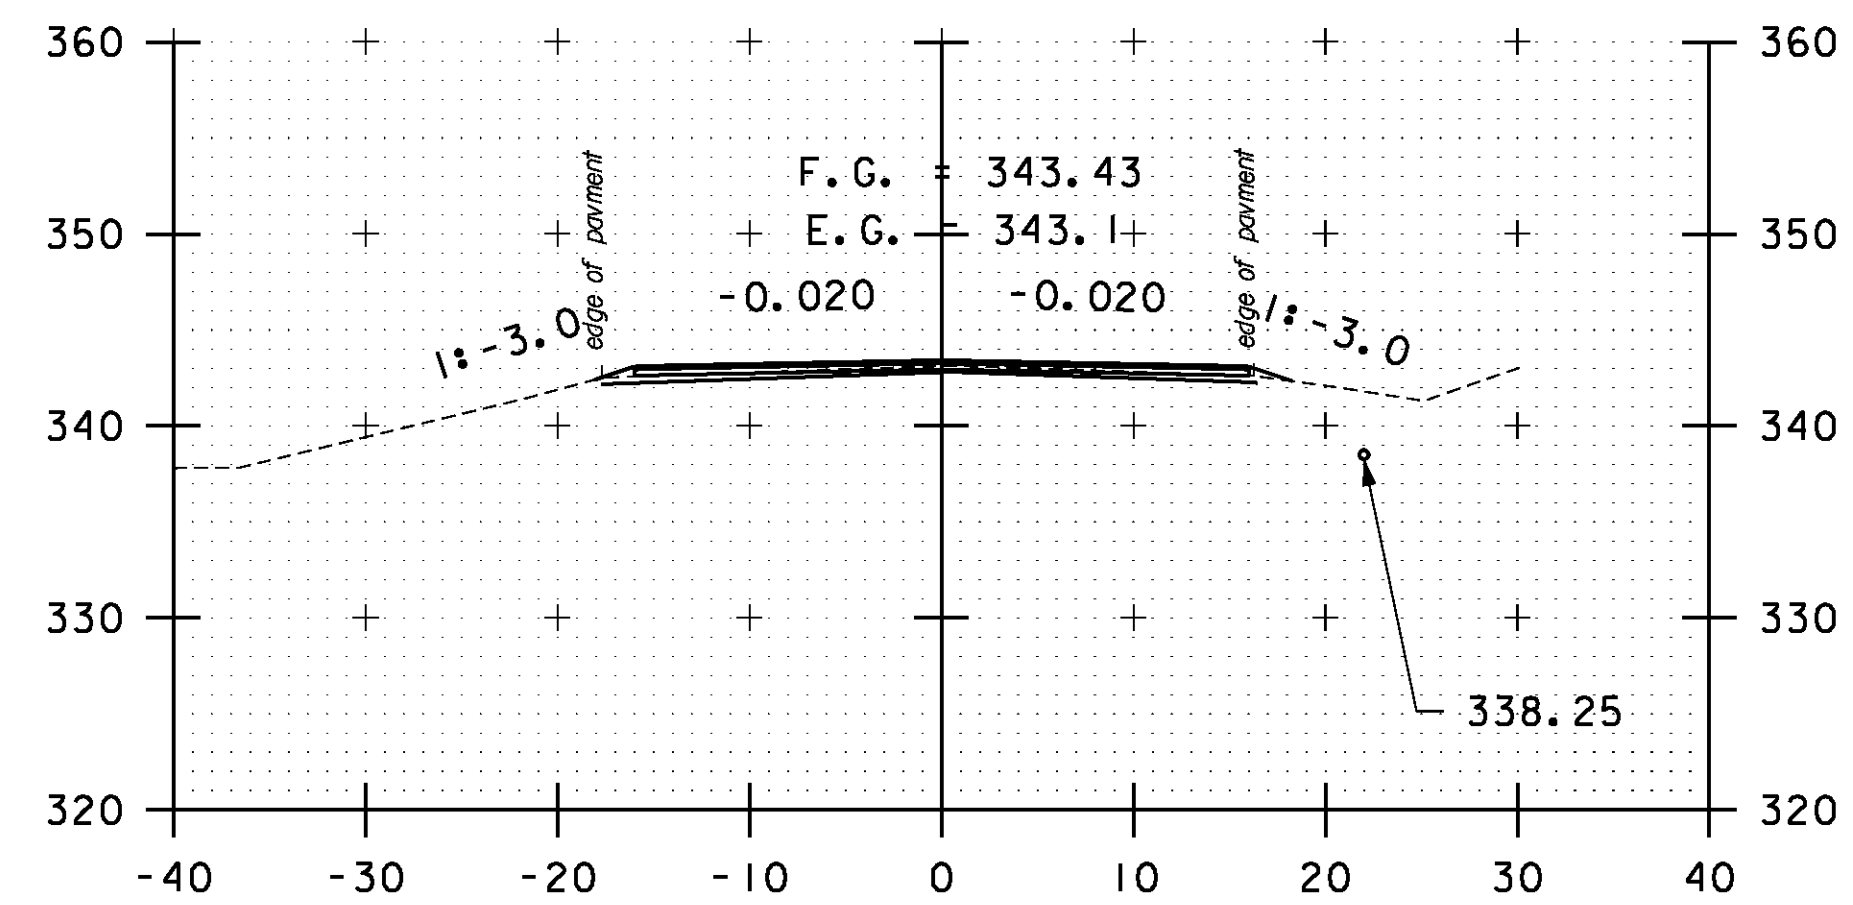


227+50

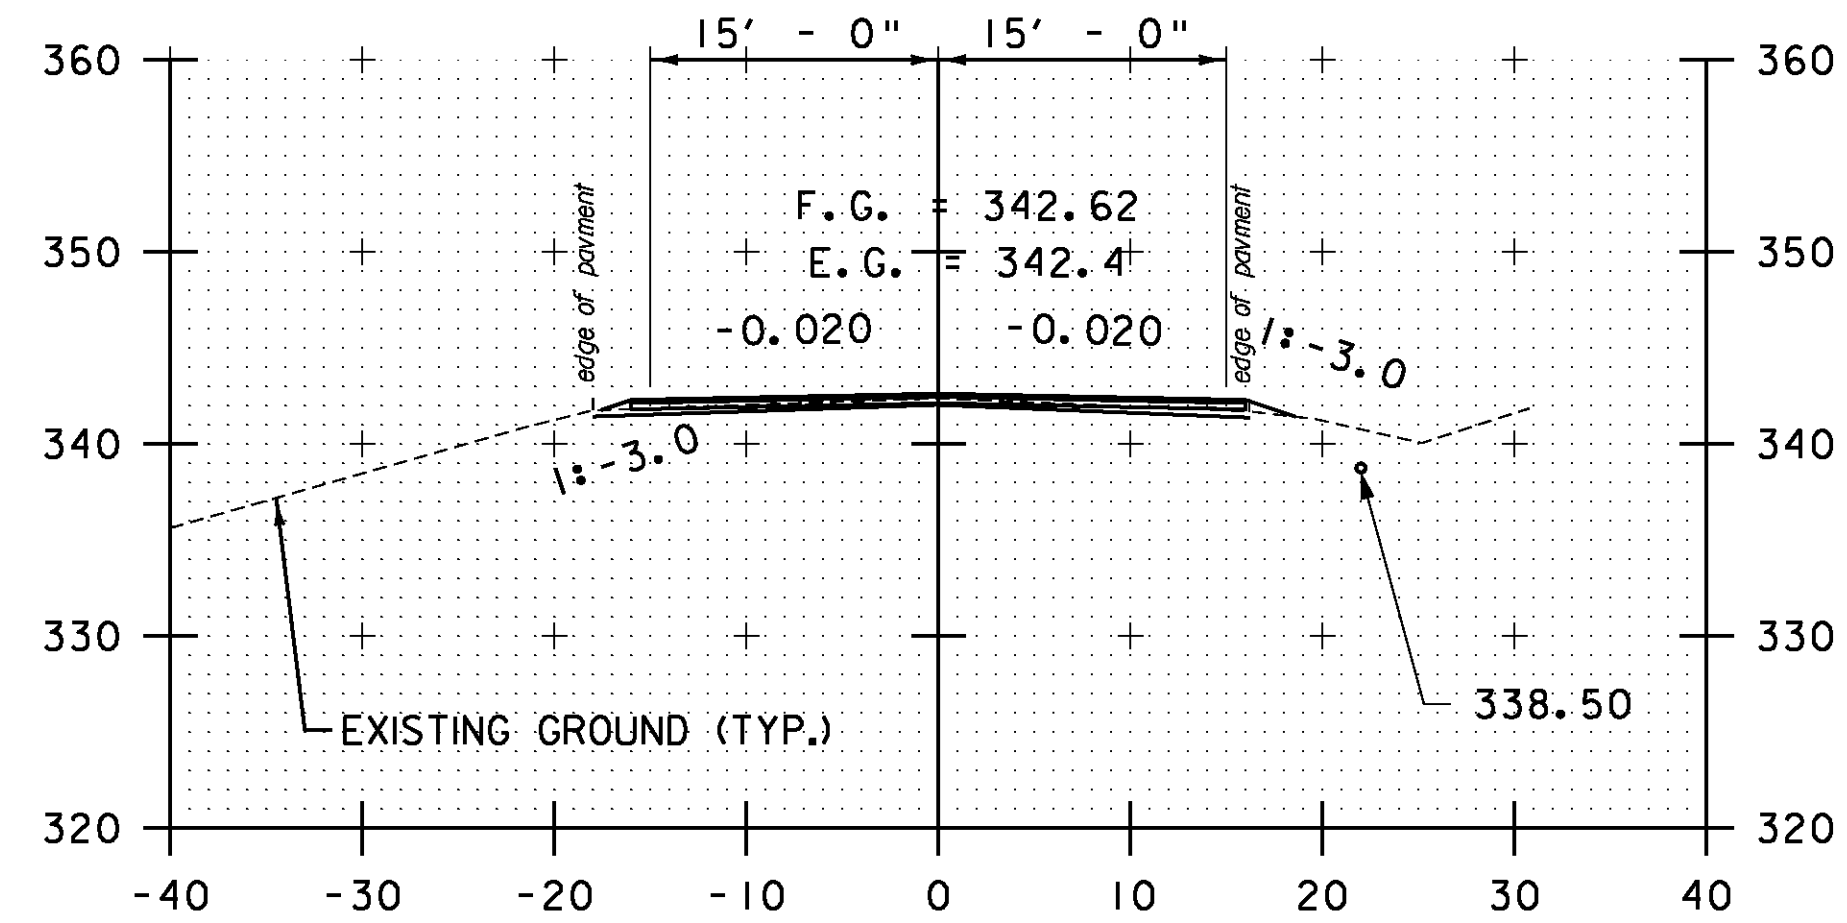

224+00

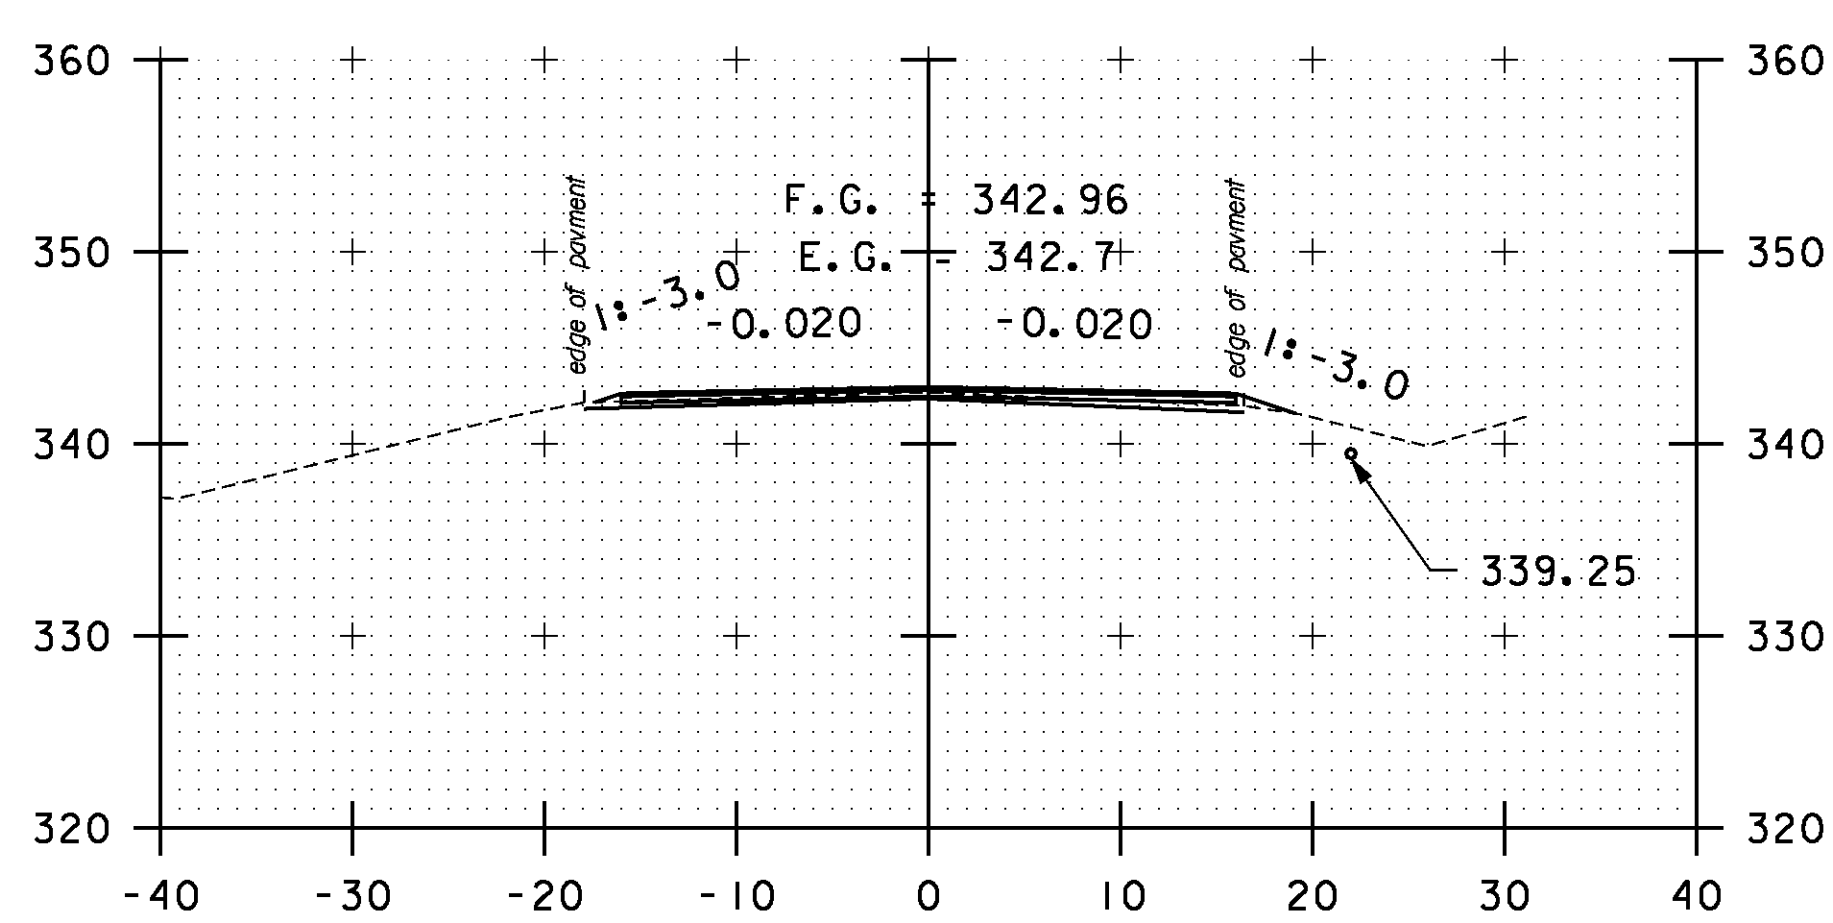

225+50

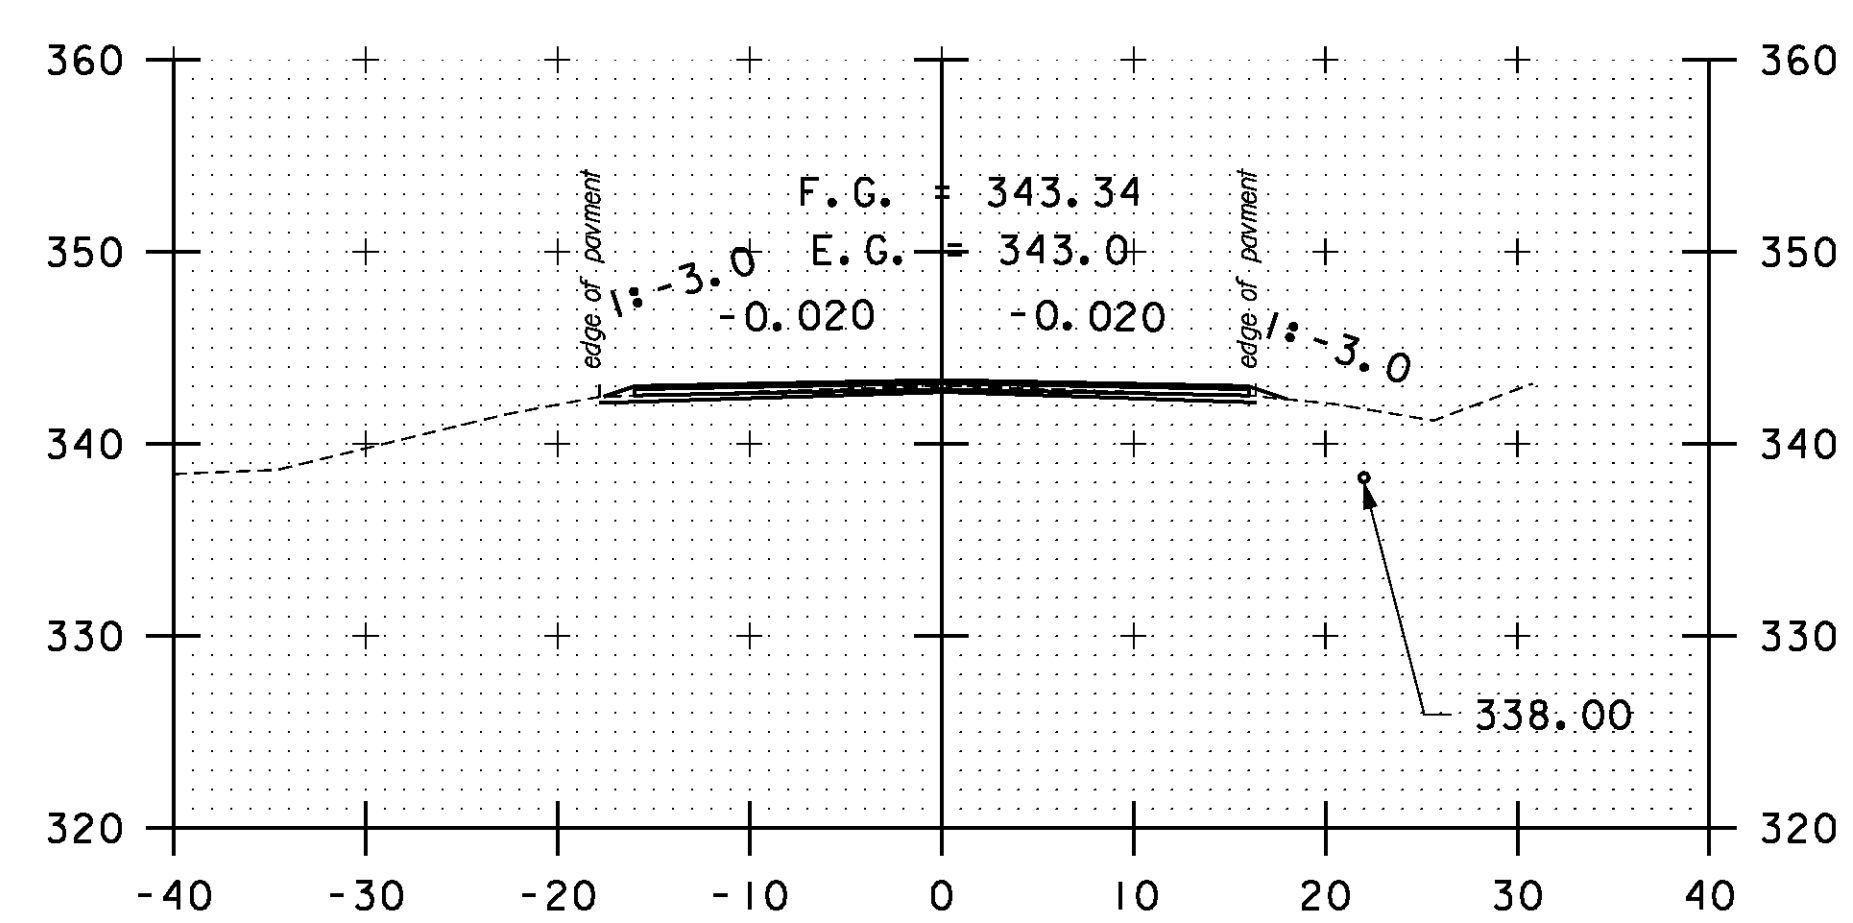

227+00

STA. 224+00 TO STA. 228+00

SCALE 1" = 10'-0"

CROSS SECTION SHEET 30

PROJECT NAME: BOLTON-WATERBURY

PROJECT NUMBER: STP 2709(I)

FILE NAME: p07C172.dgn

PROJECT LEADER: CDL

DESIGNED BY: BMB

PLOT FILE: p07C172_156.1

PLOT DATE: 4/16/2013

DRAWN BY: BMB

CHECKED BY: CDL

SHEET 156 OF 217