




229+50

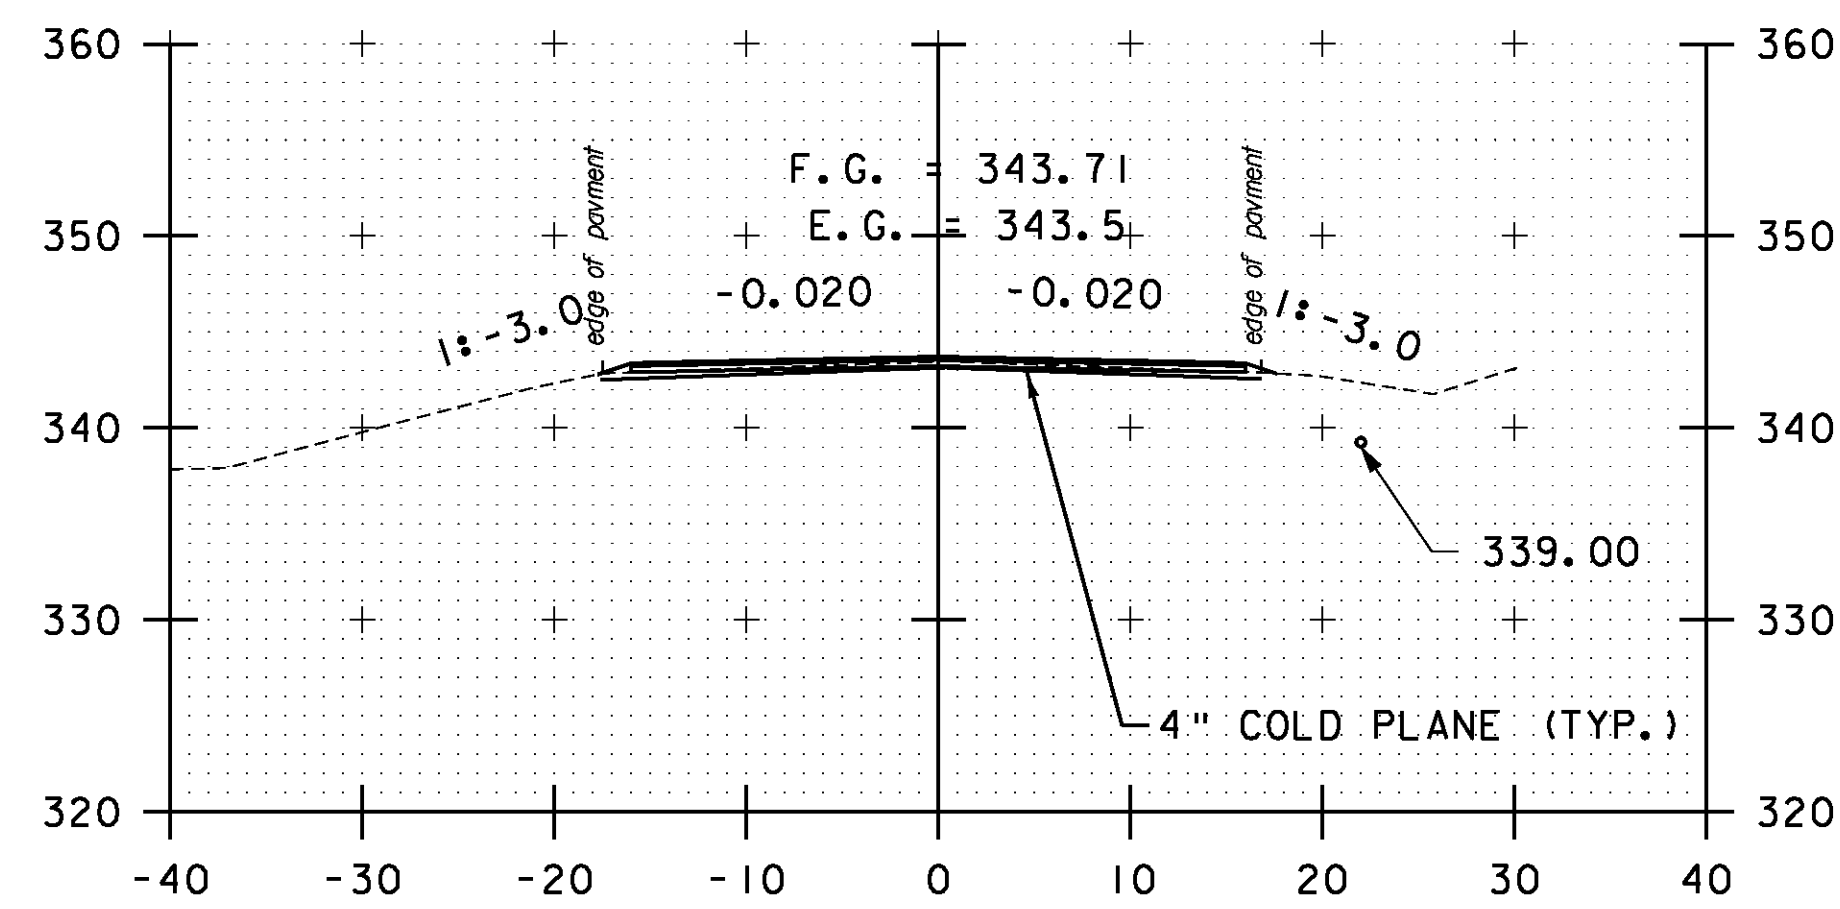


229+00

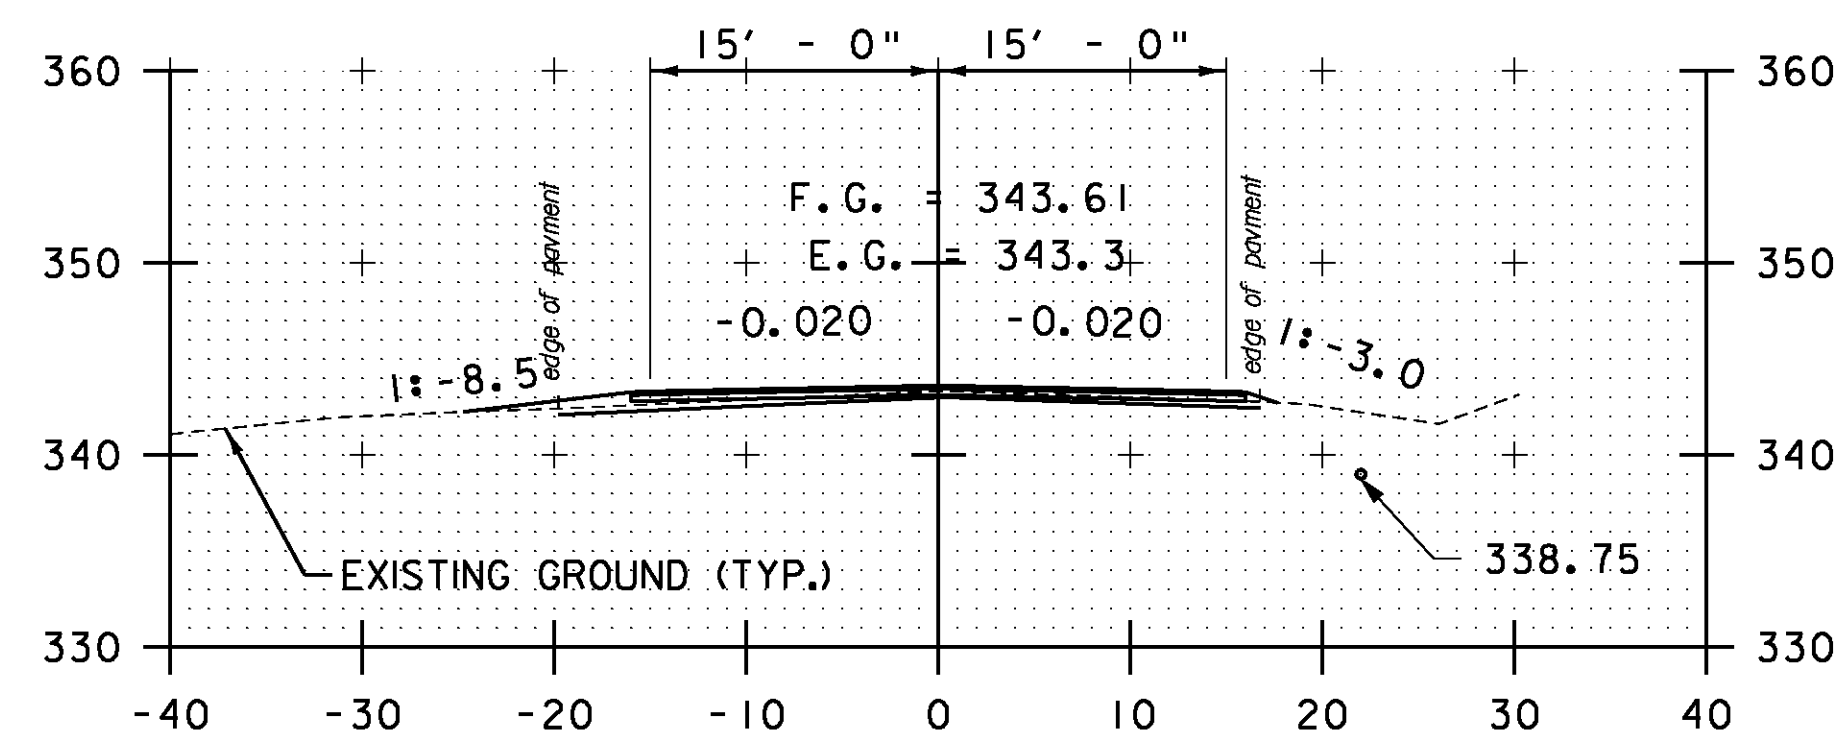


DRIVE LT  
228+50

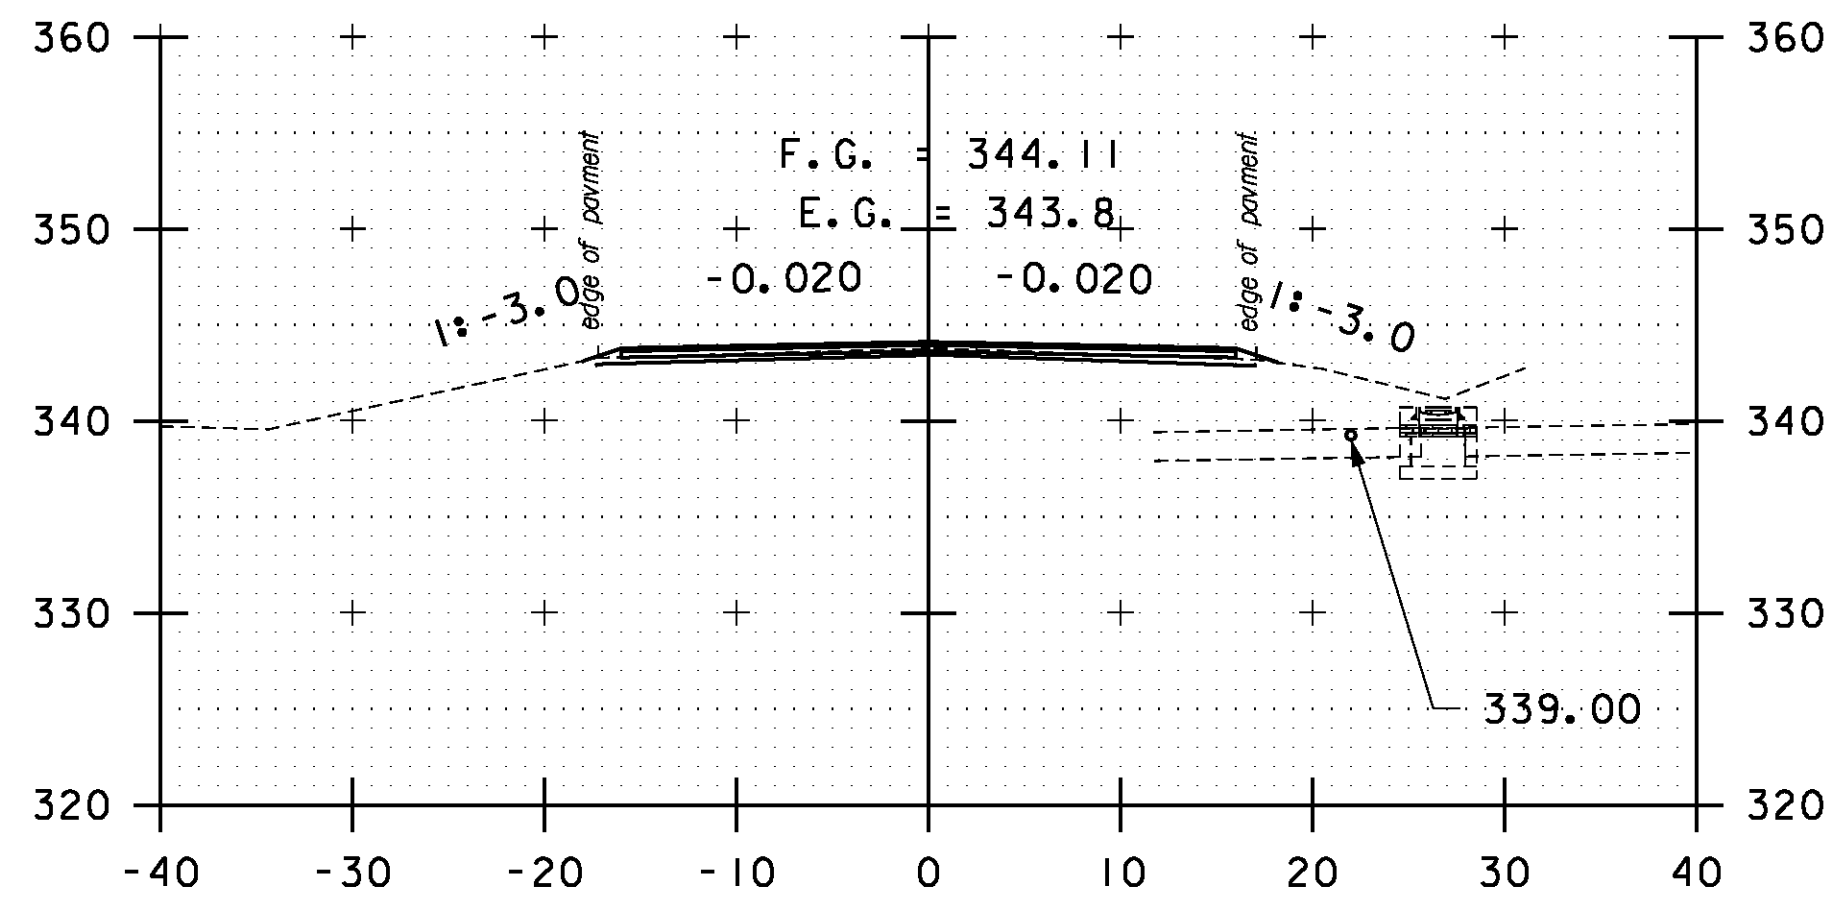


231+00

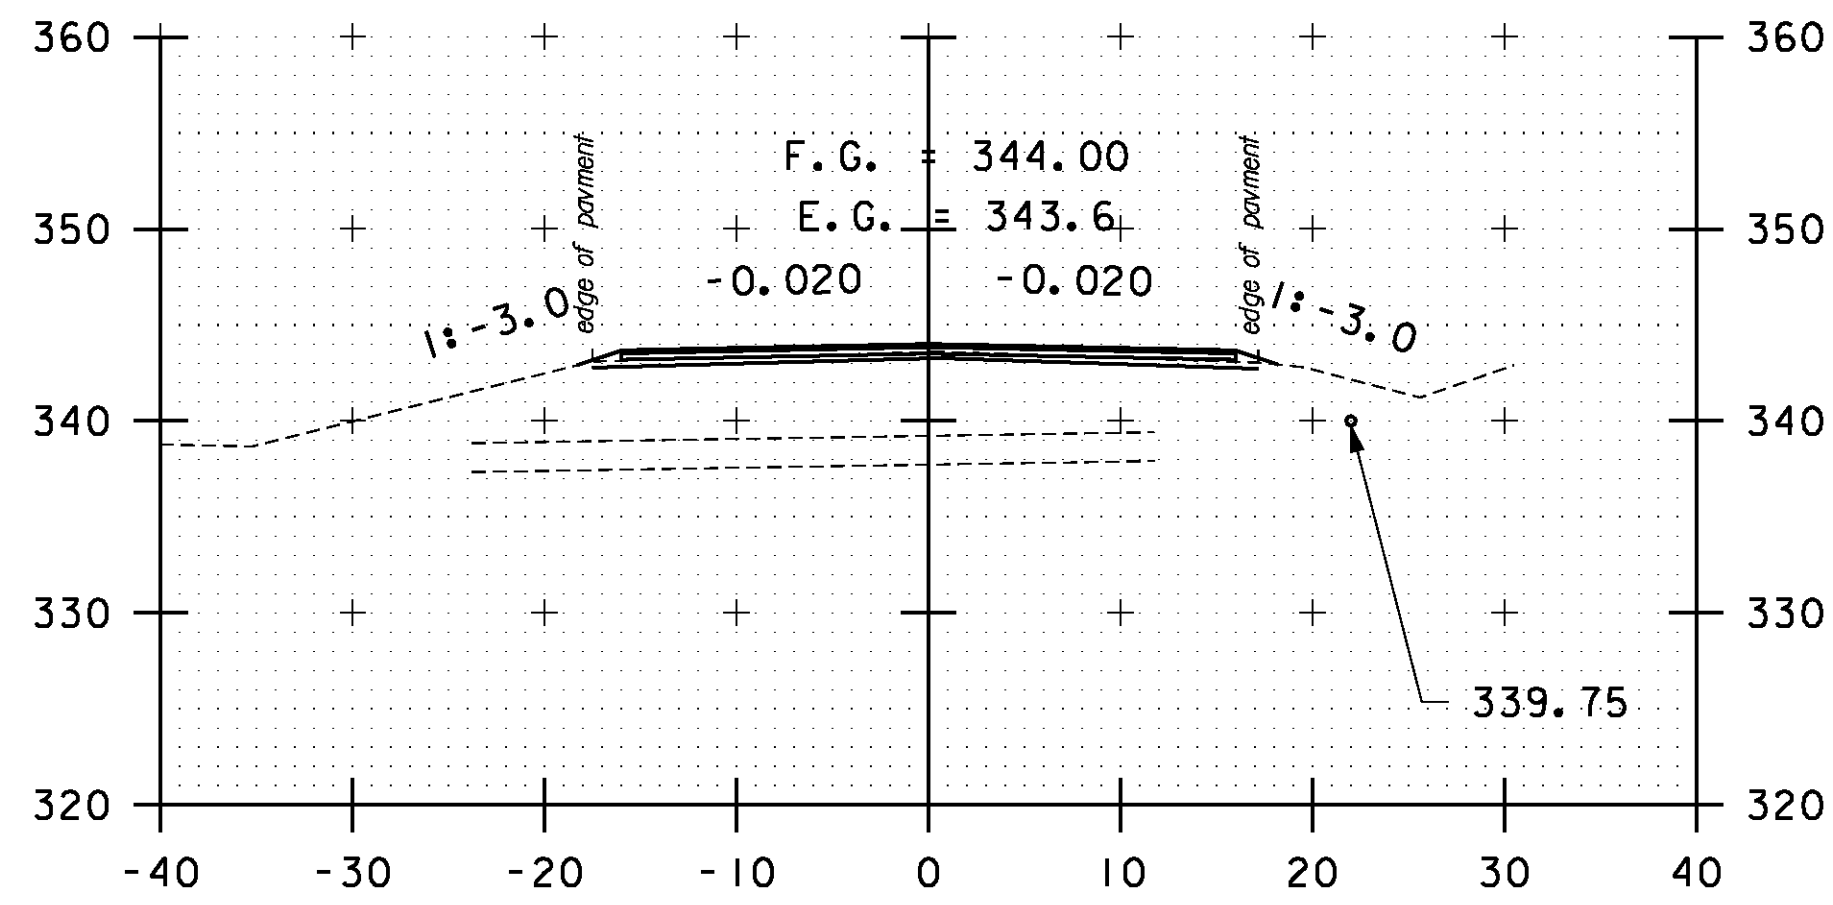


230+50

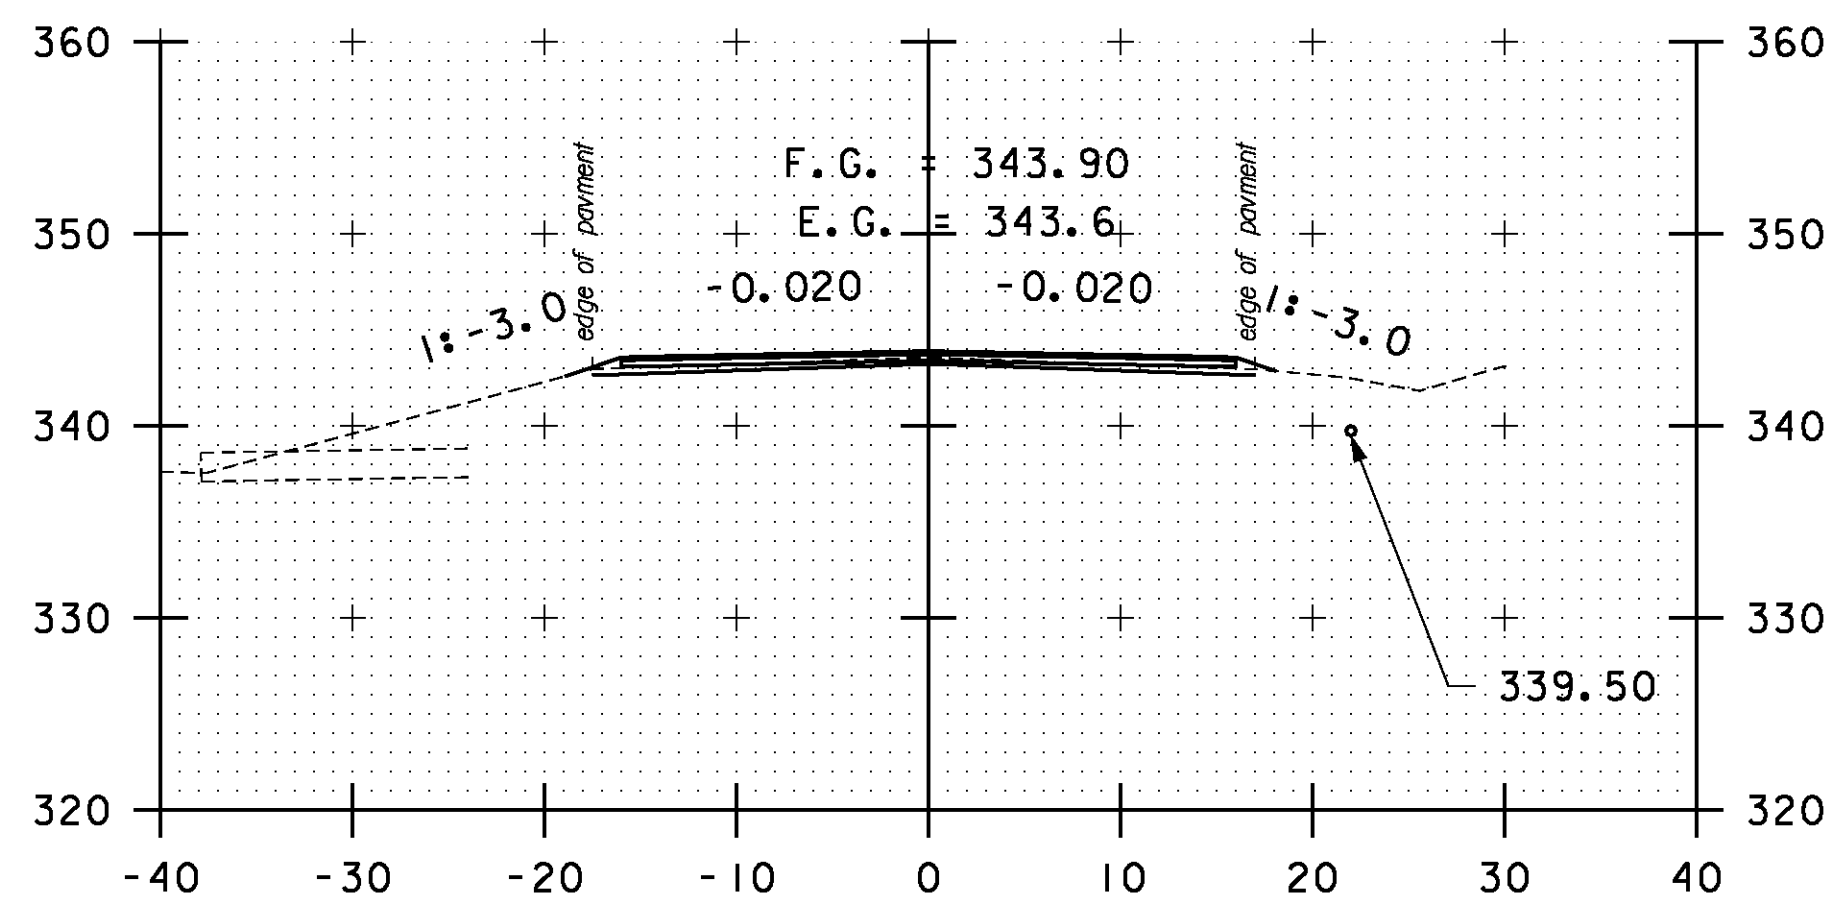


230+00

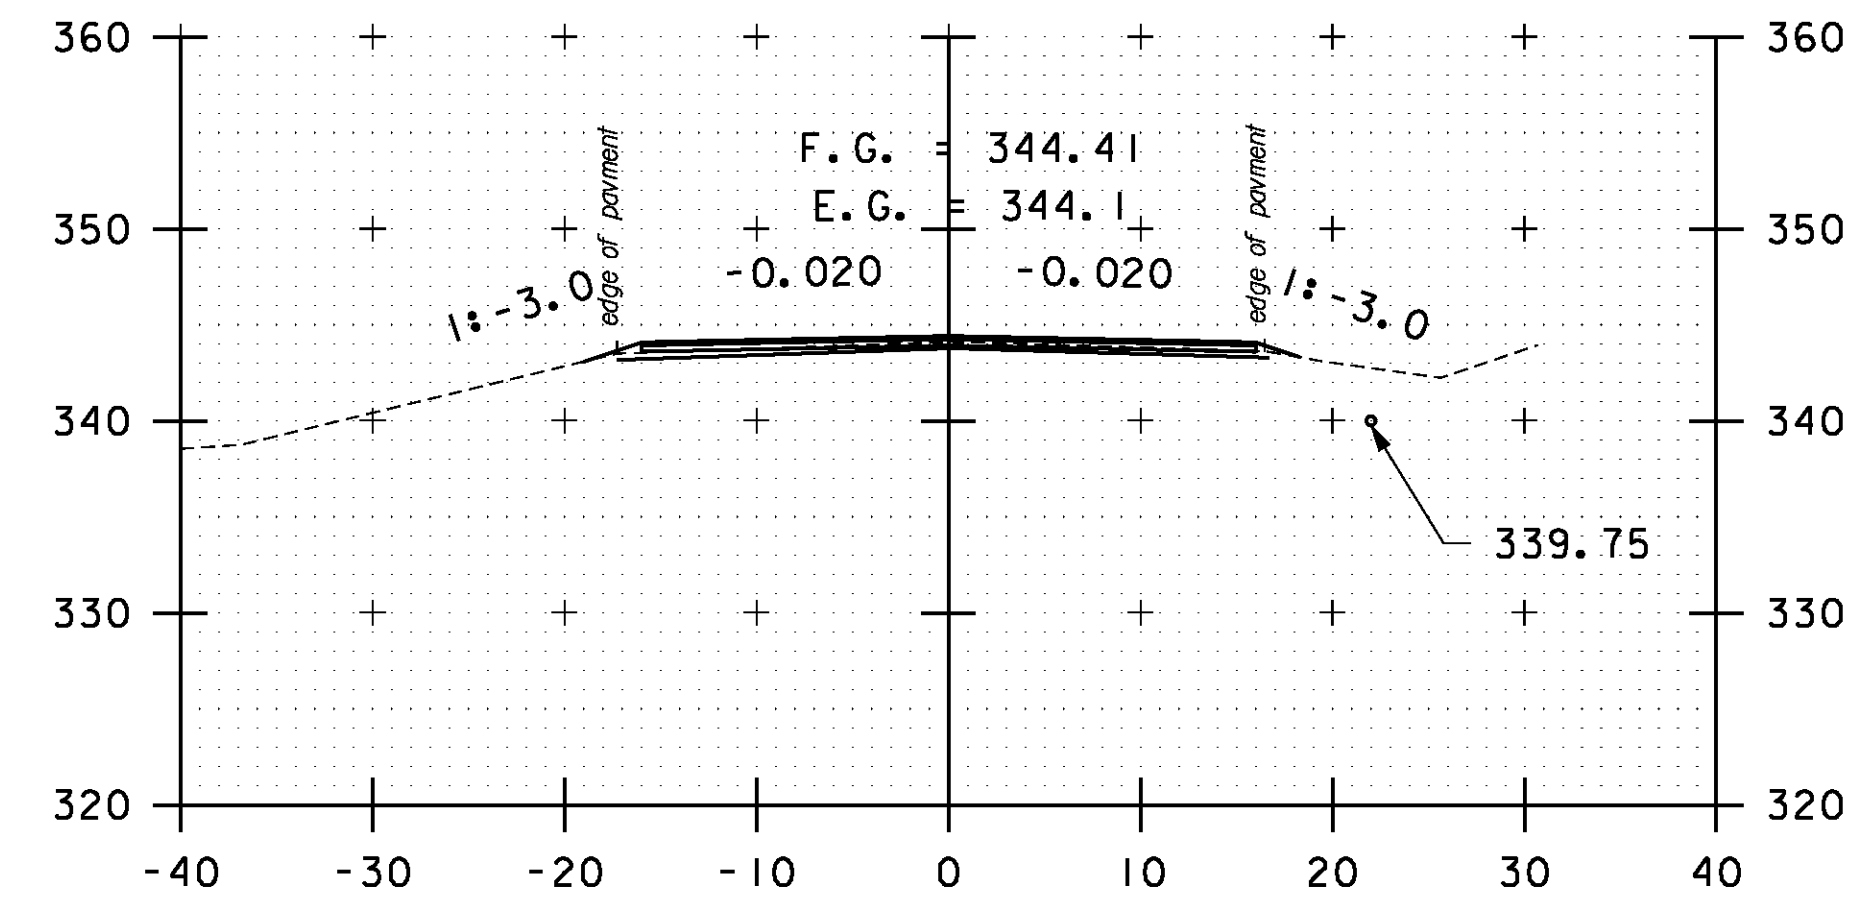

232+50

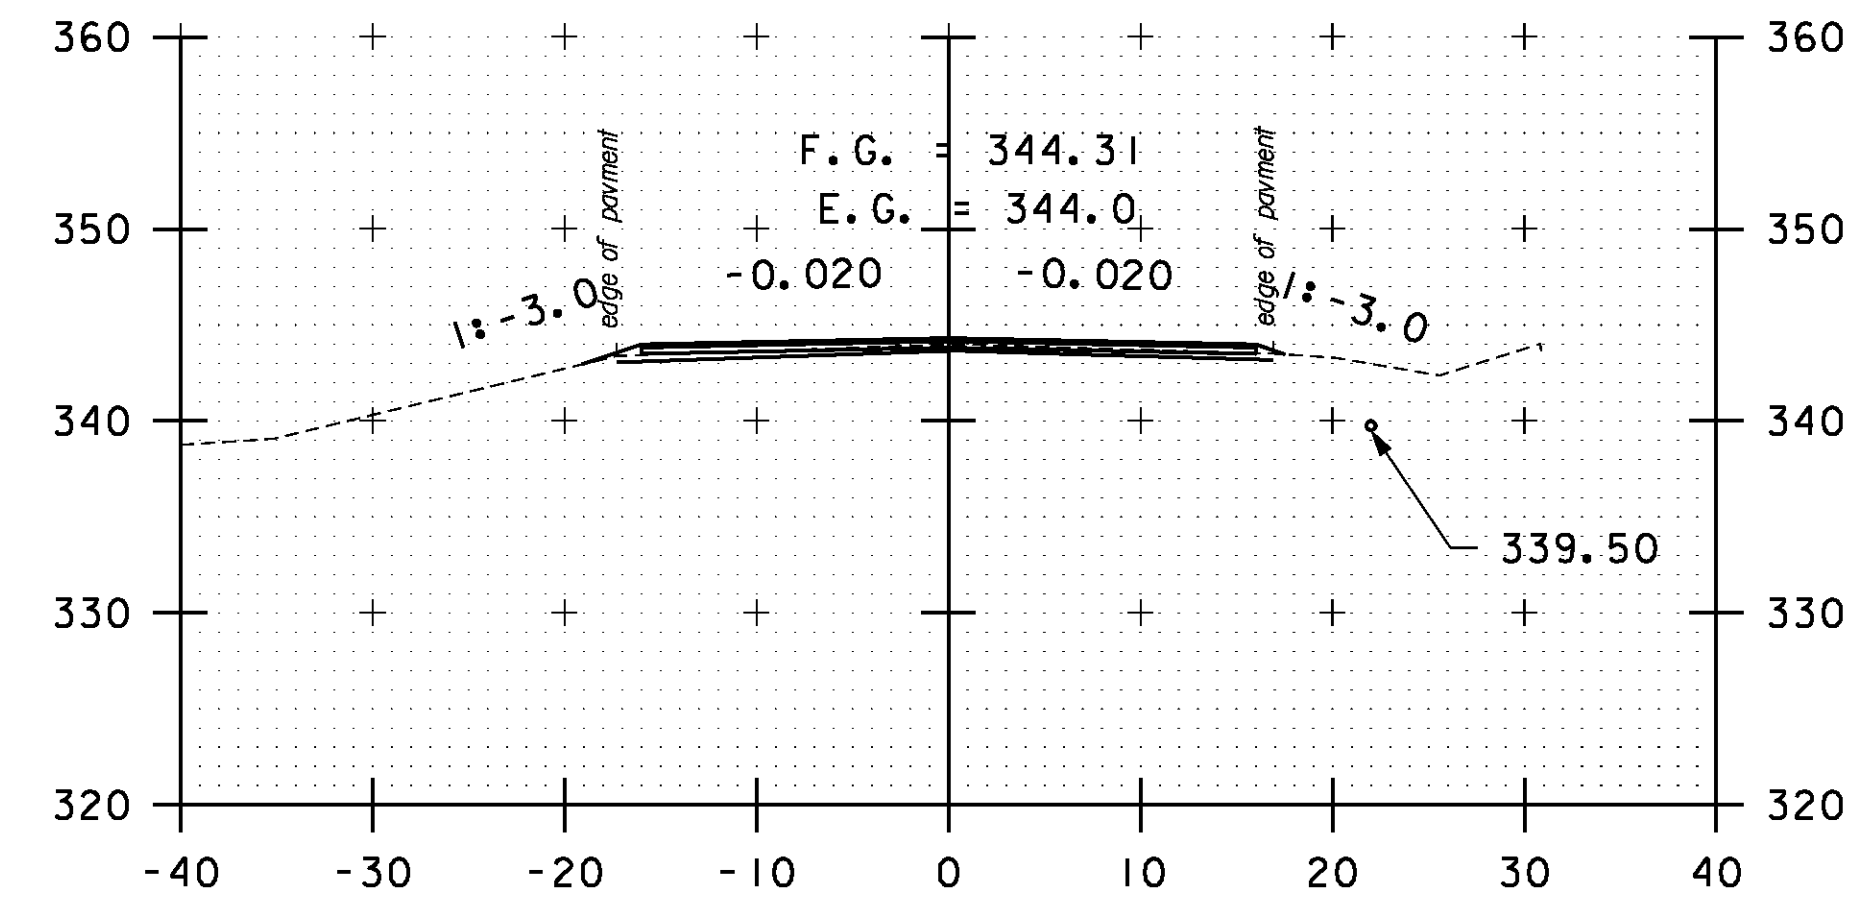

232+00

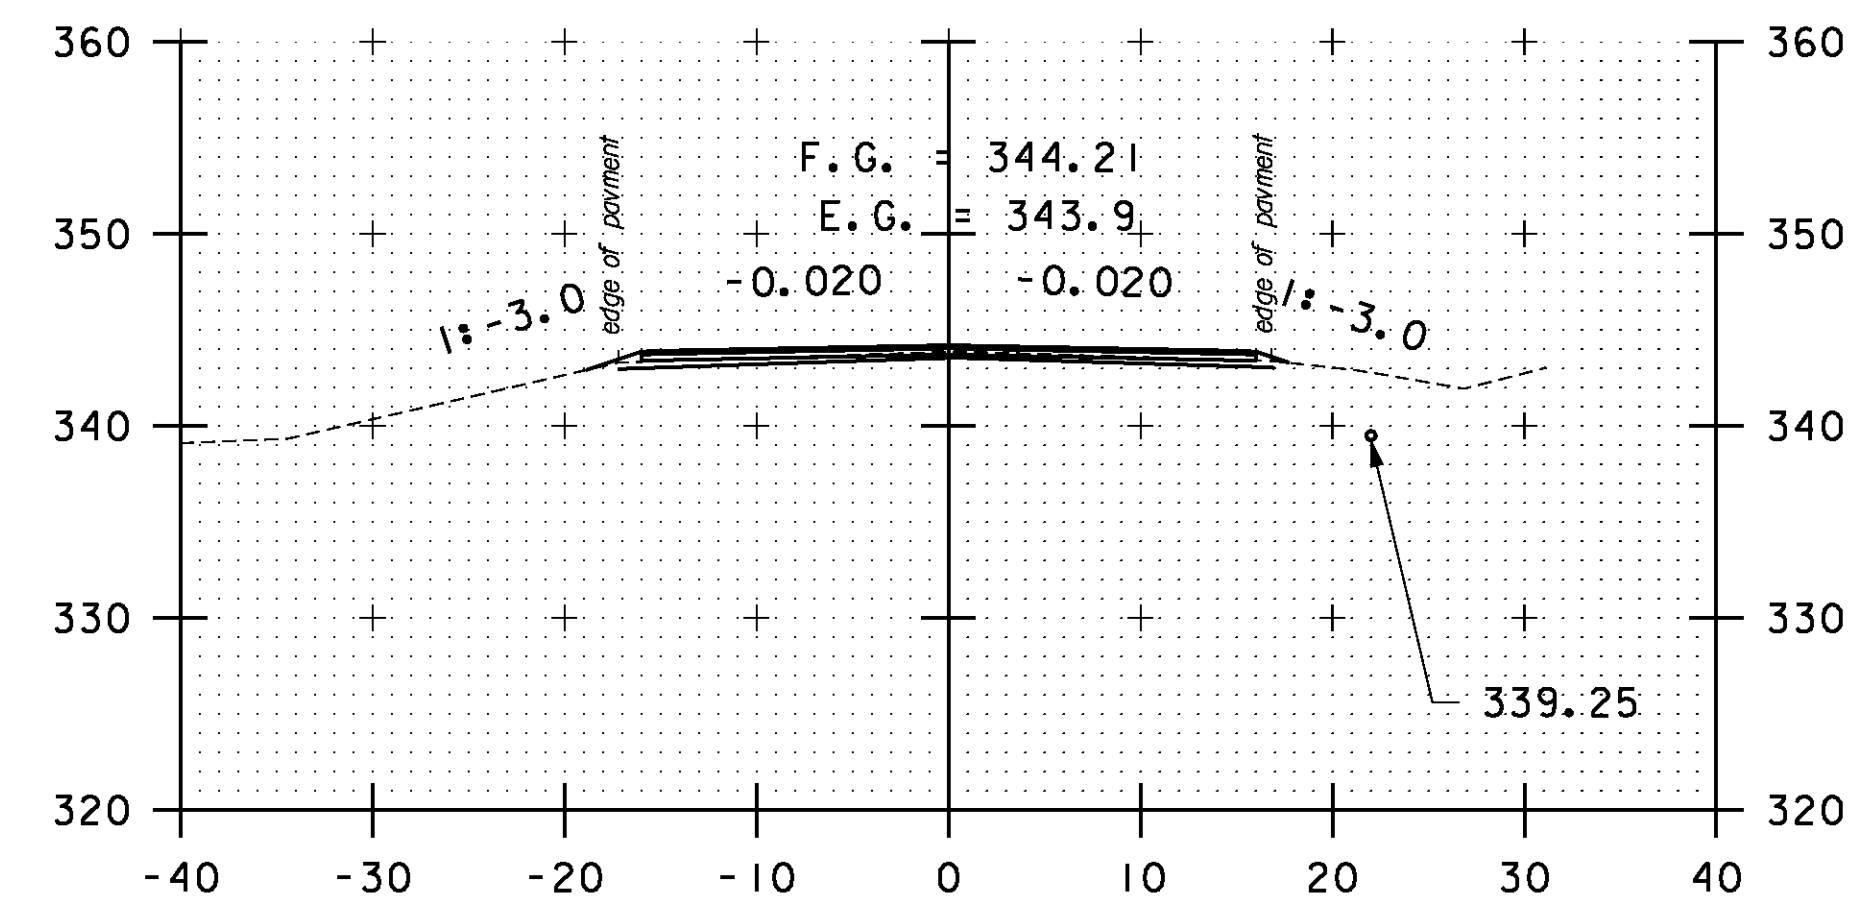

231+50

STA. 228+50 TO STA. 232+50

SCALE 1" = 10'-0"  
0 10

**CROSS SECTION SHEET 31**

PROJECT NAME: BOLTON-WATERBURY

PROJECT NUMBER: STP 2709(I)

FILE NAME: p07C172.dgn

PROJECT LEADER: CDL

DESIGNED BY: BMB

PLOT FILE: p07C172.I57.1

PLOT DATE: 4/16/2013

DRAWN BY: BMB

CHECKED BY: CDL

SHEET 157 OF 217