




234+00

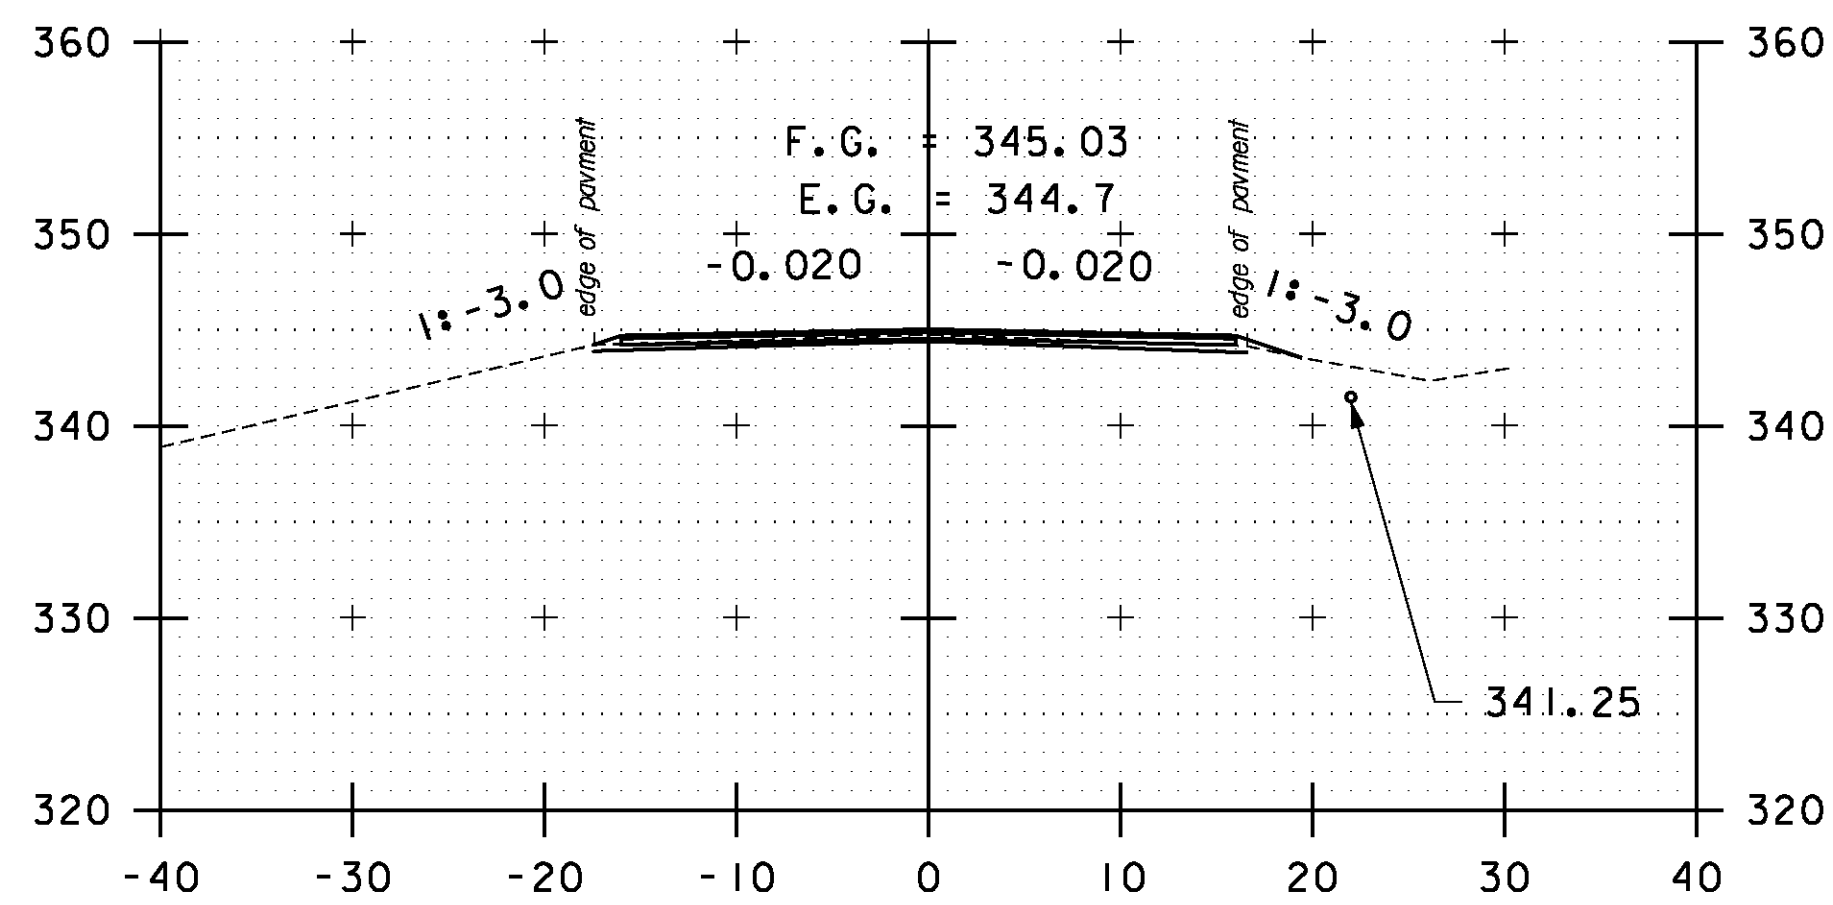


235+50

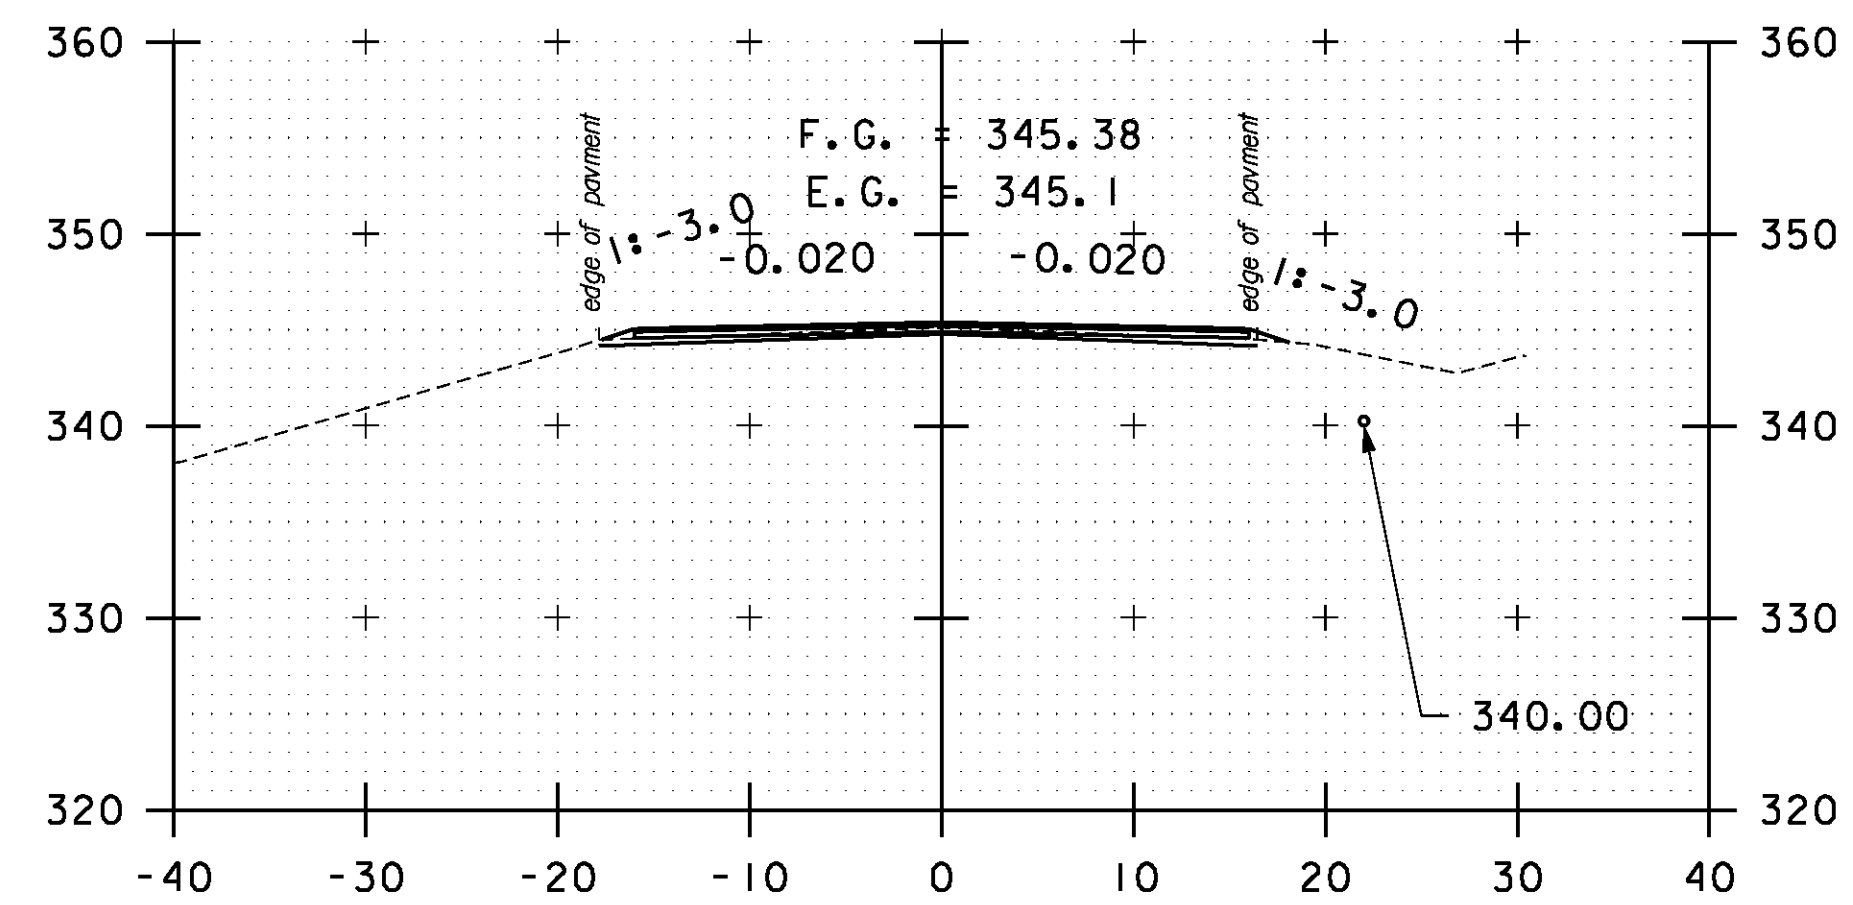


237+00

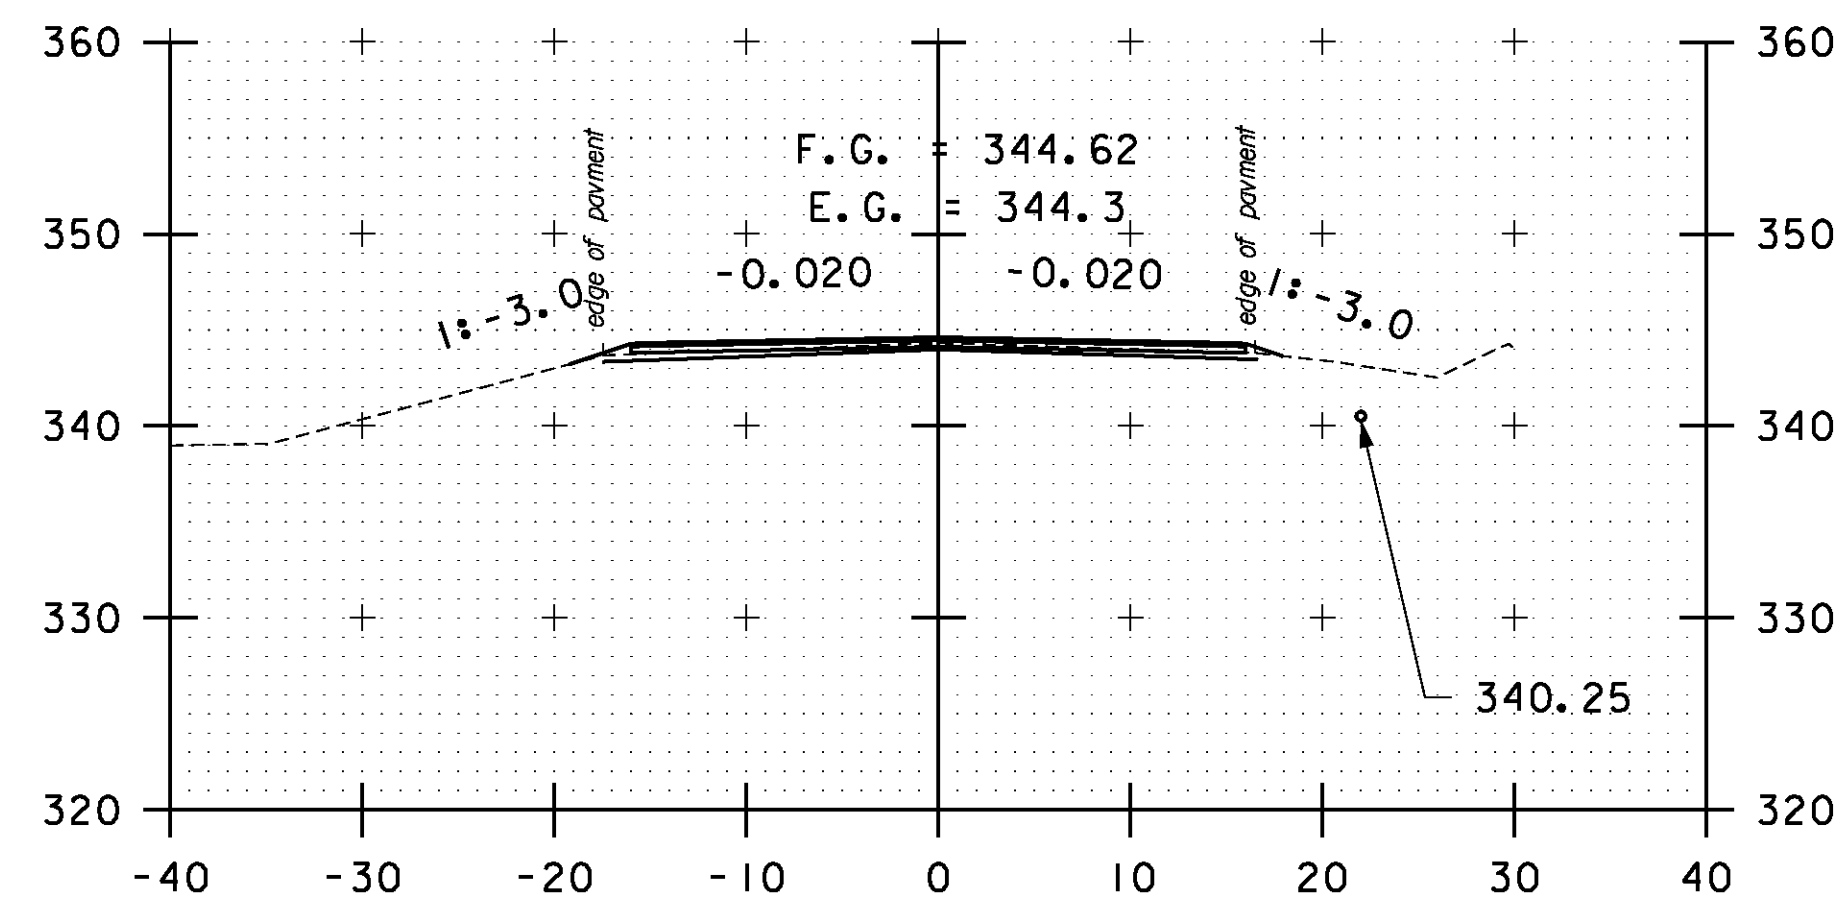


233+50

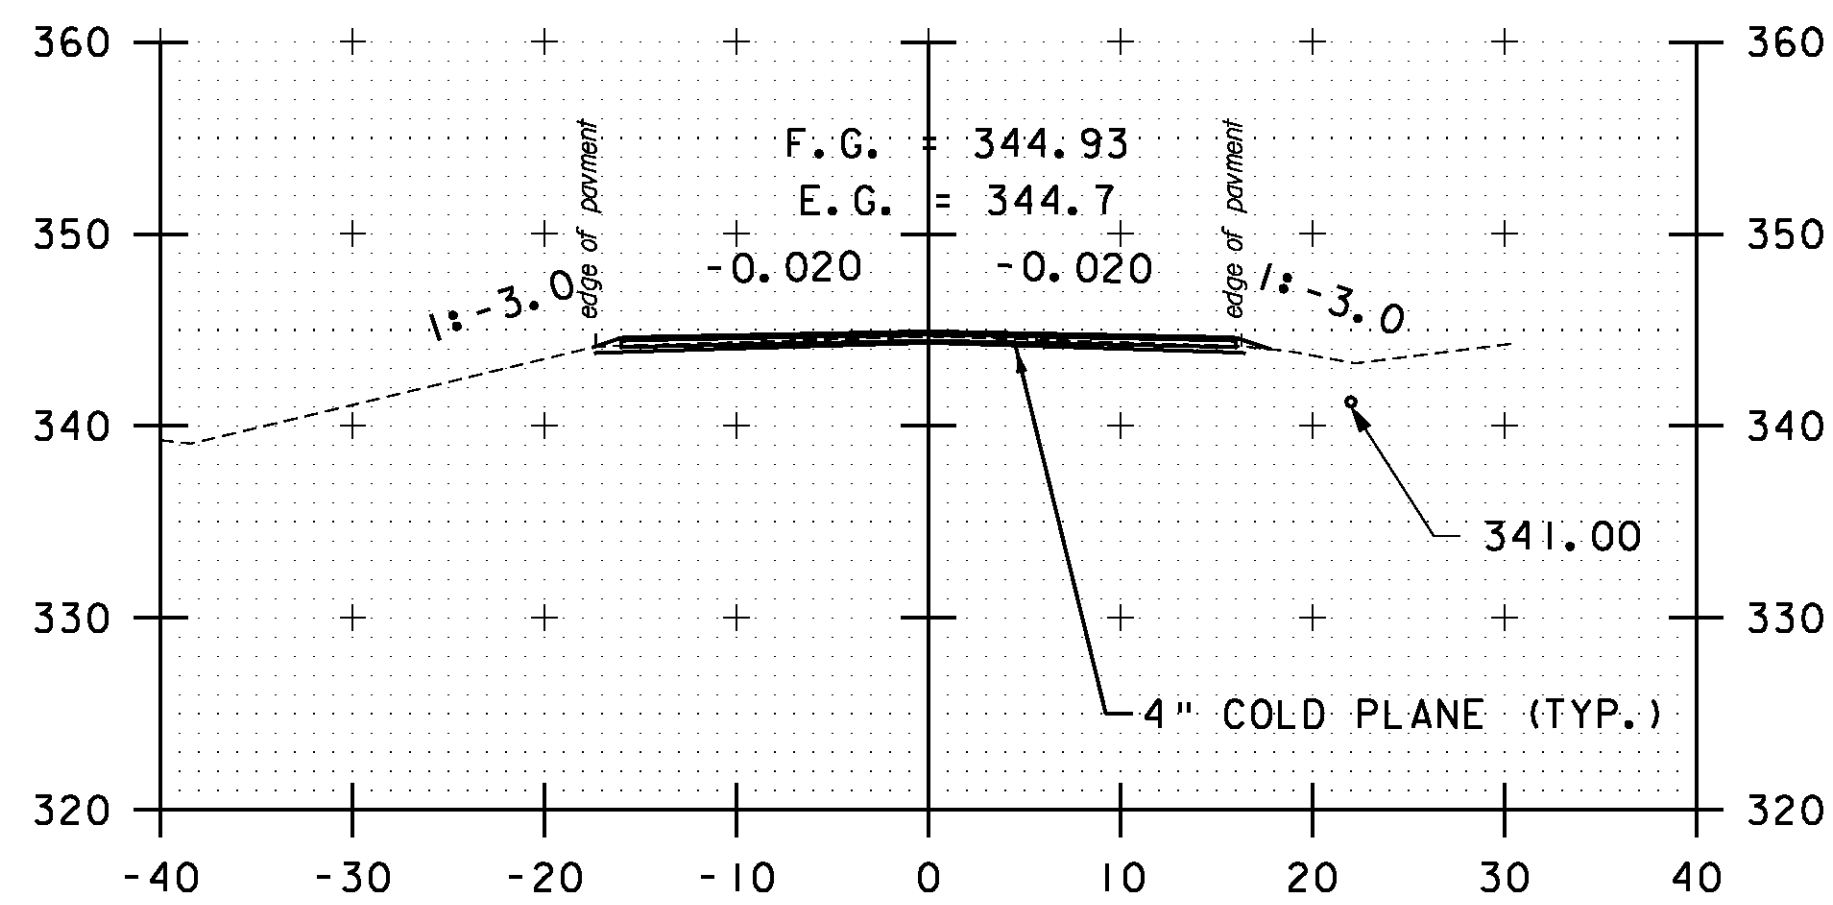


235+00

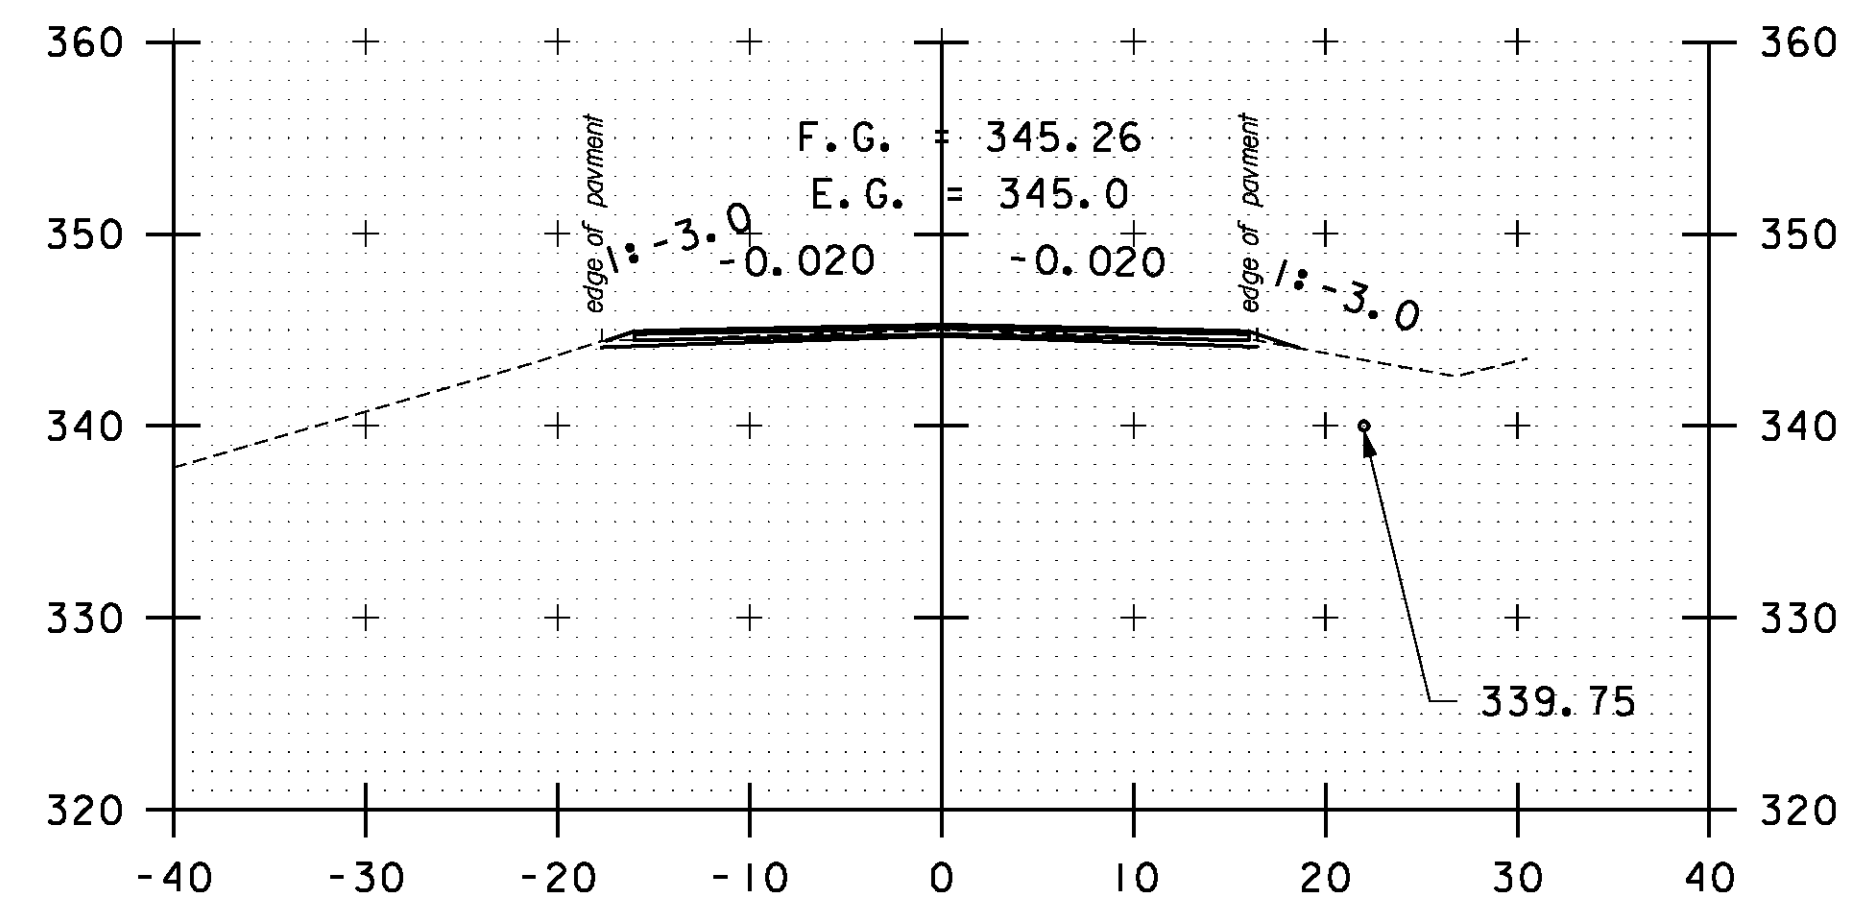


236+50

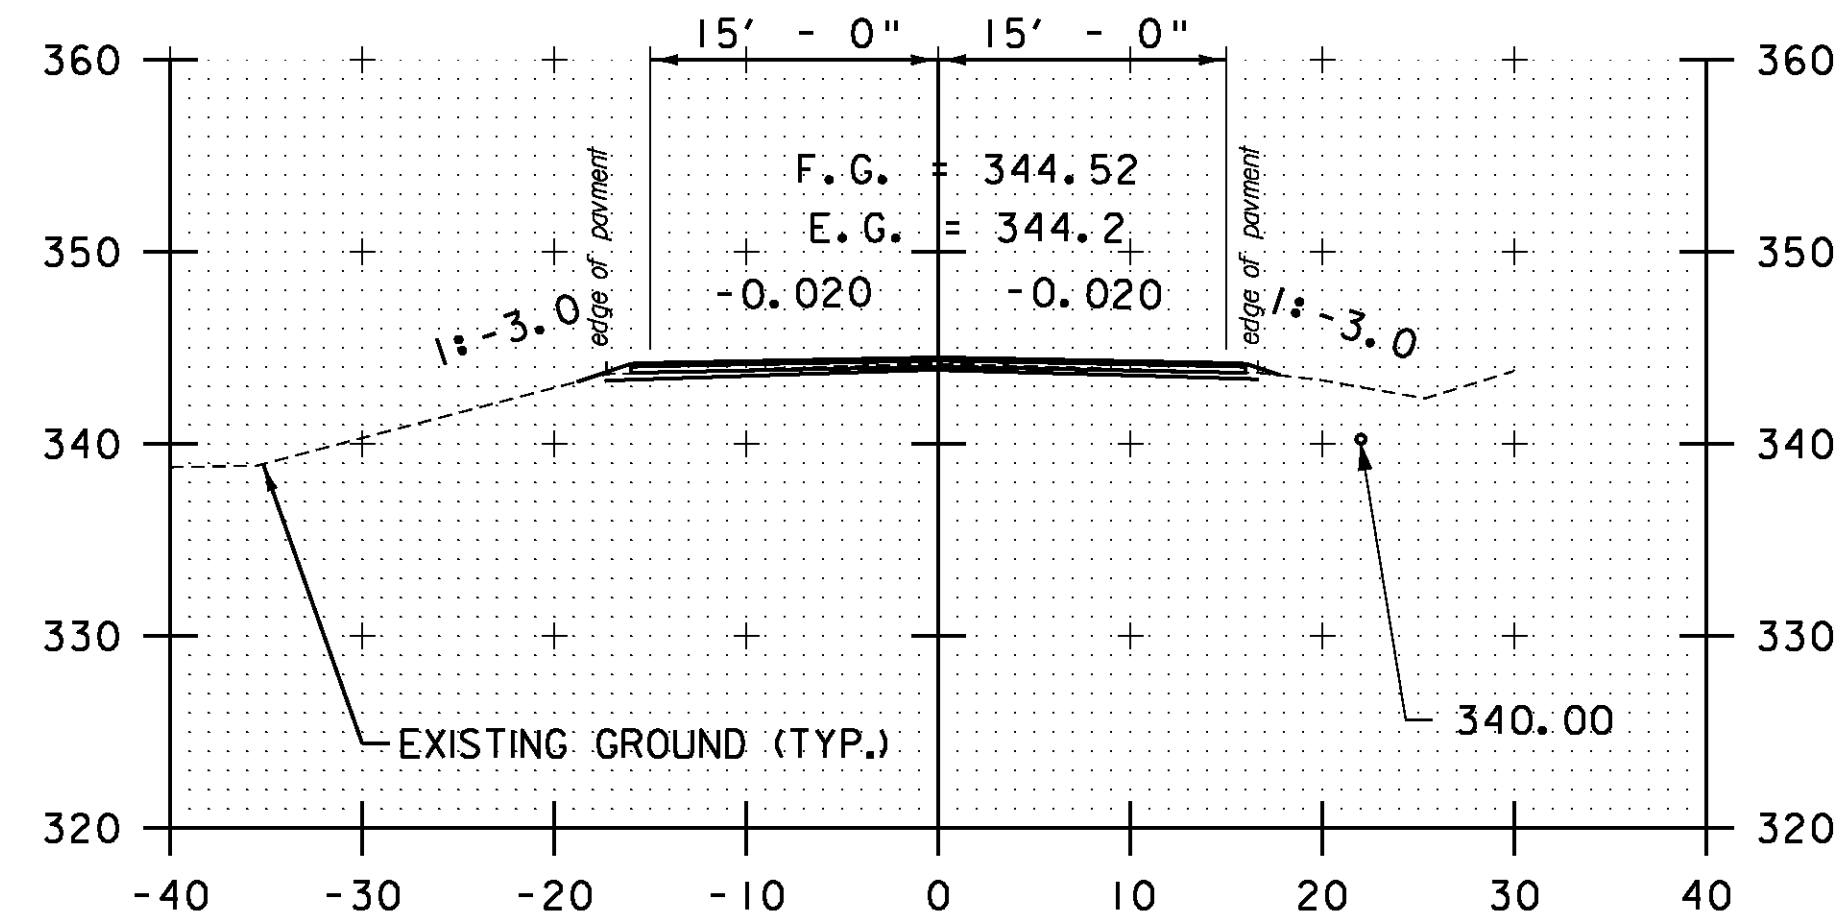

233+00

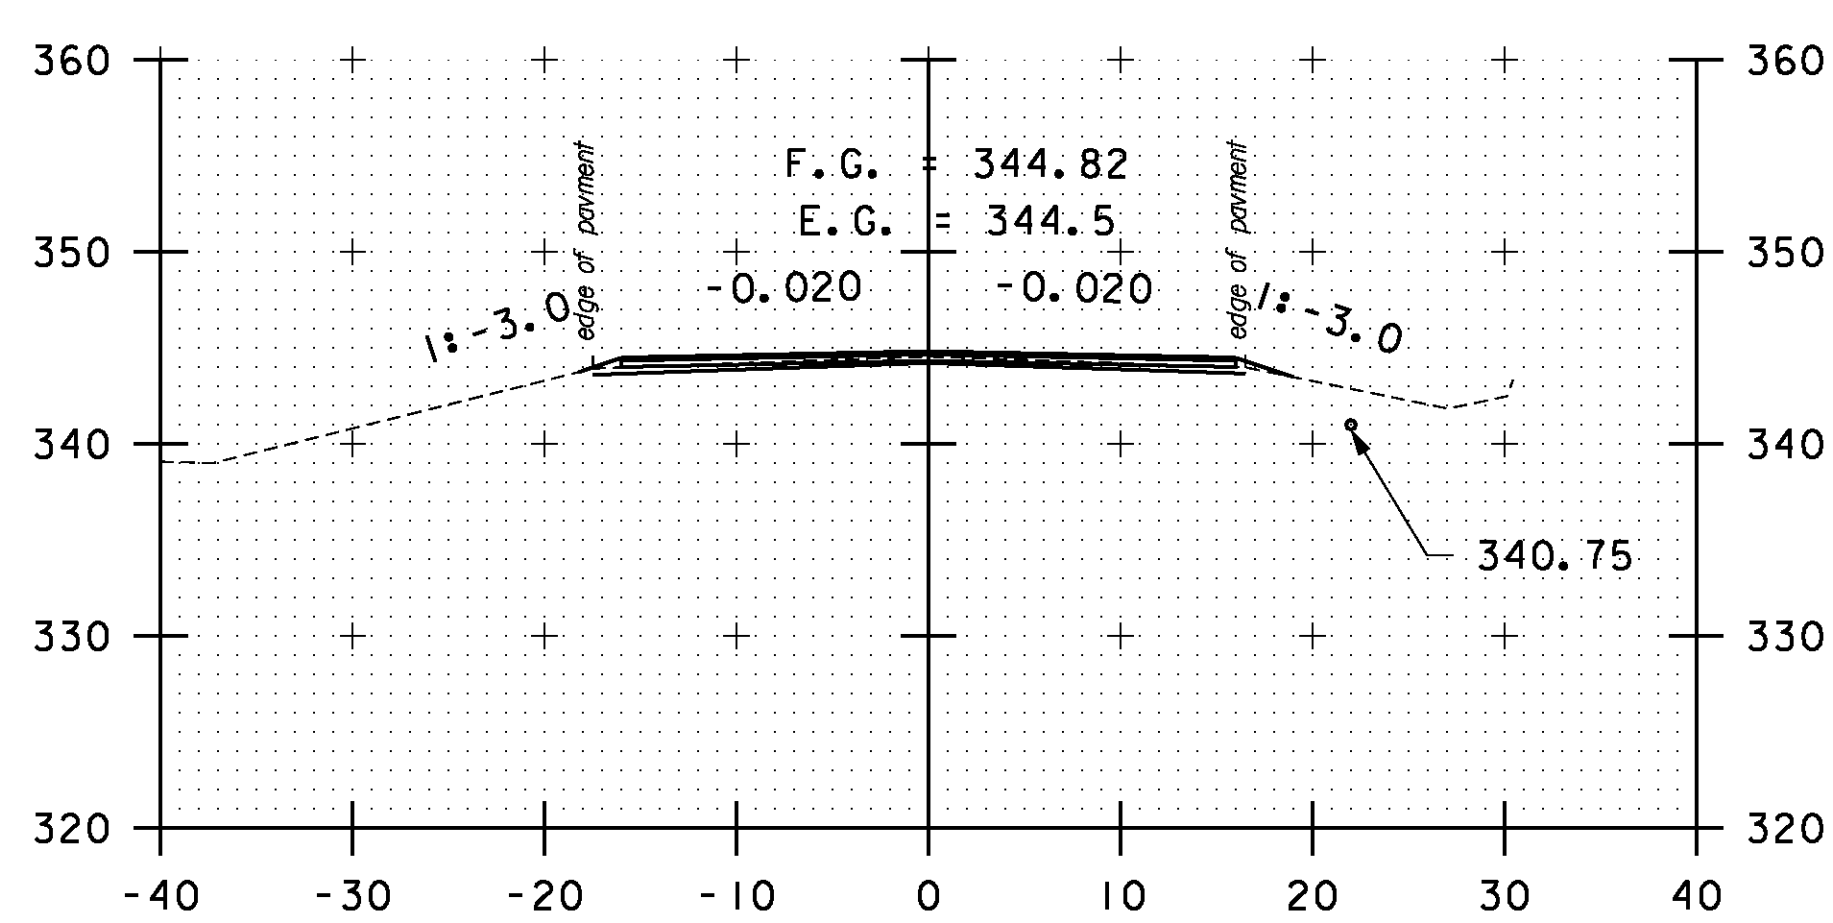

234+50

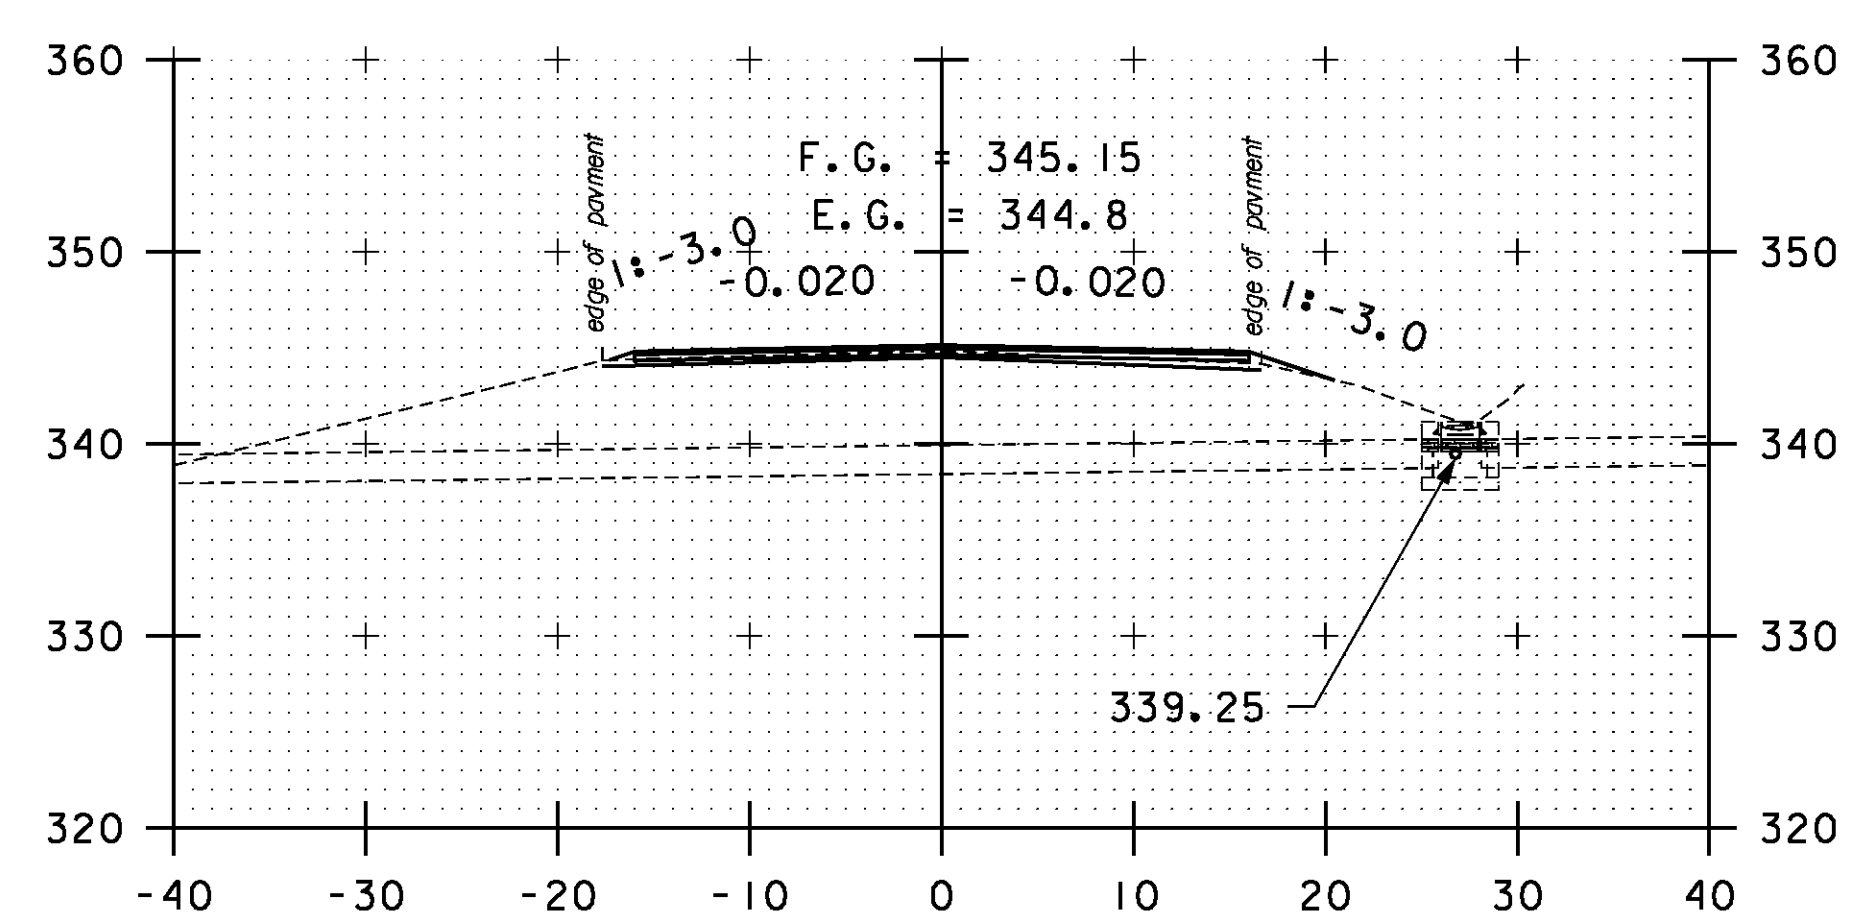

236+00

STA. 233+00 TO STA. 237+00

SCALE 1" = 10'-0"

**CROSS SECTION SHEET 32**

PROJECT NAME: BOLTON-WATERBURY

PROJECT NUMBER: STP 2709(I)

FILE NAME: p07C172.dgn

PROJECT LEADER: CDL

DESIGNED BY: BMB

PLOT FILE: p07C172.158.1

PLOT DATE: 4/16/2013

DRAWN BY: BMB

CHECKED BY: CDL

SHEET 158 OF 217