




DRIVE LT  
243+00

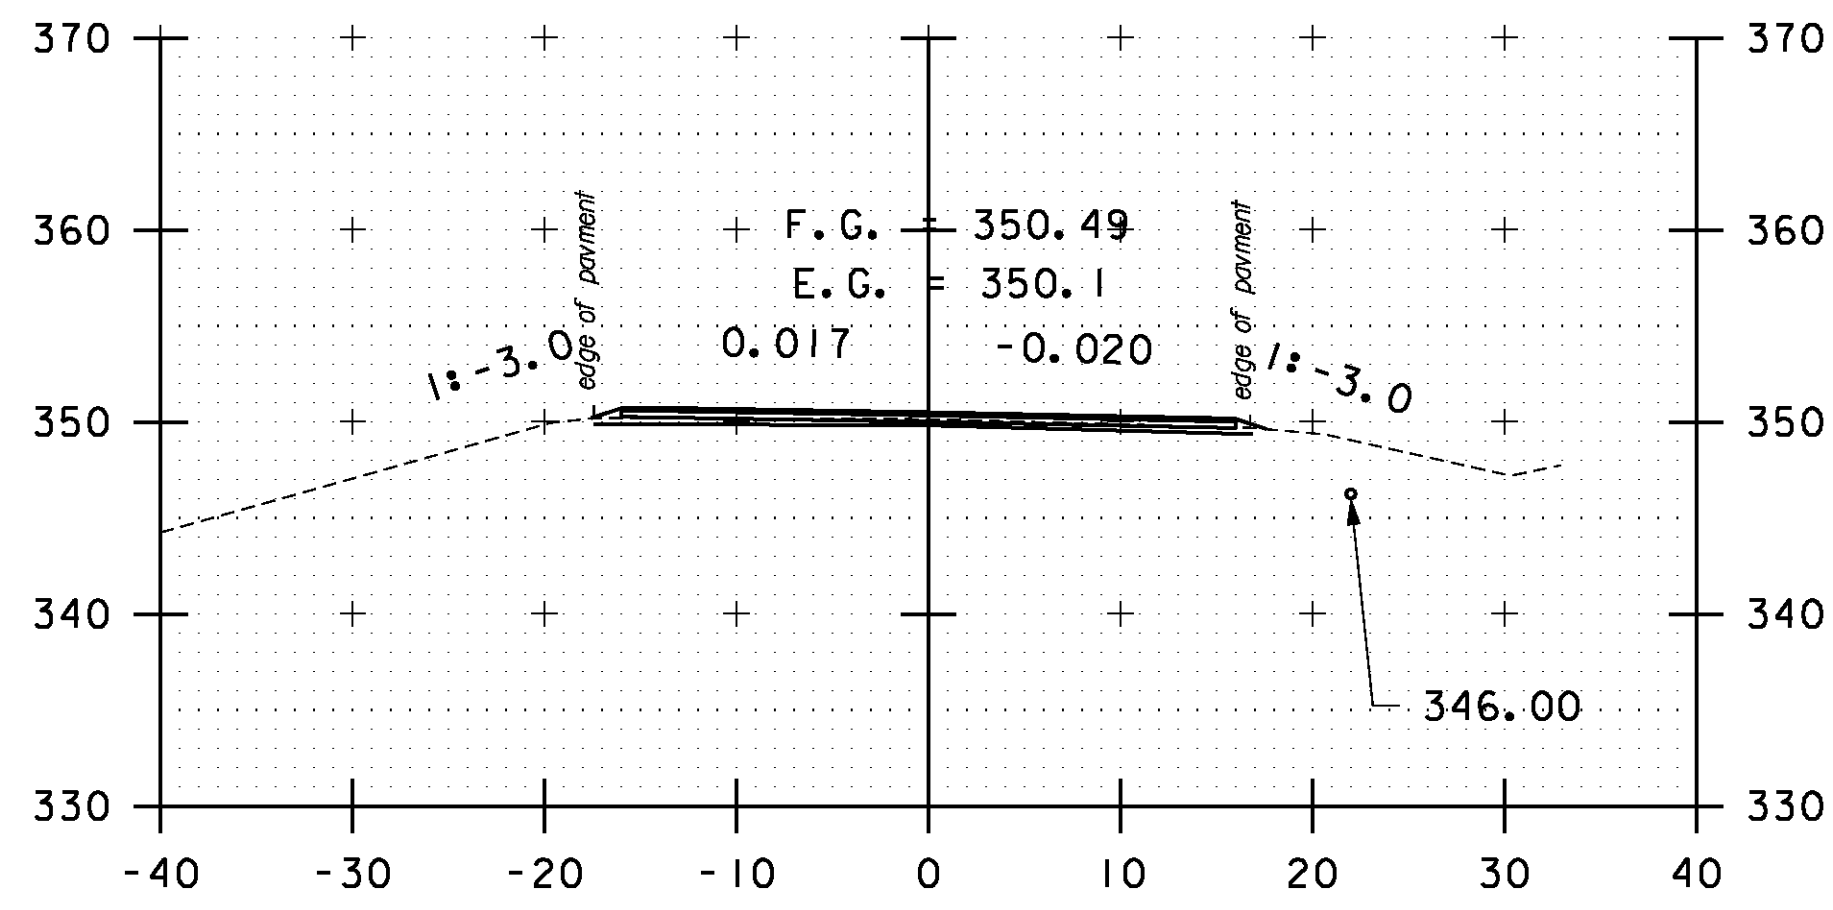


244+50

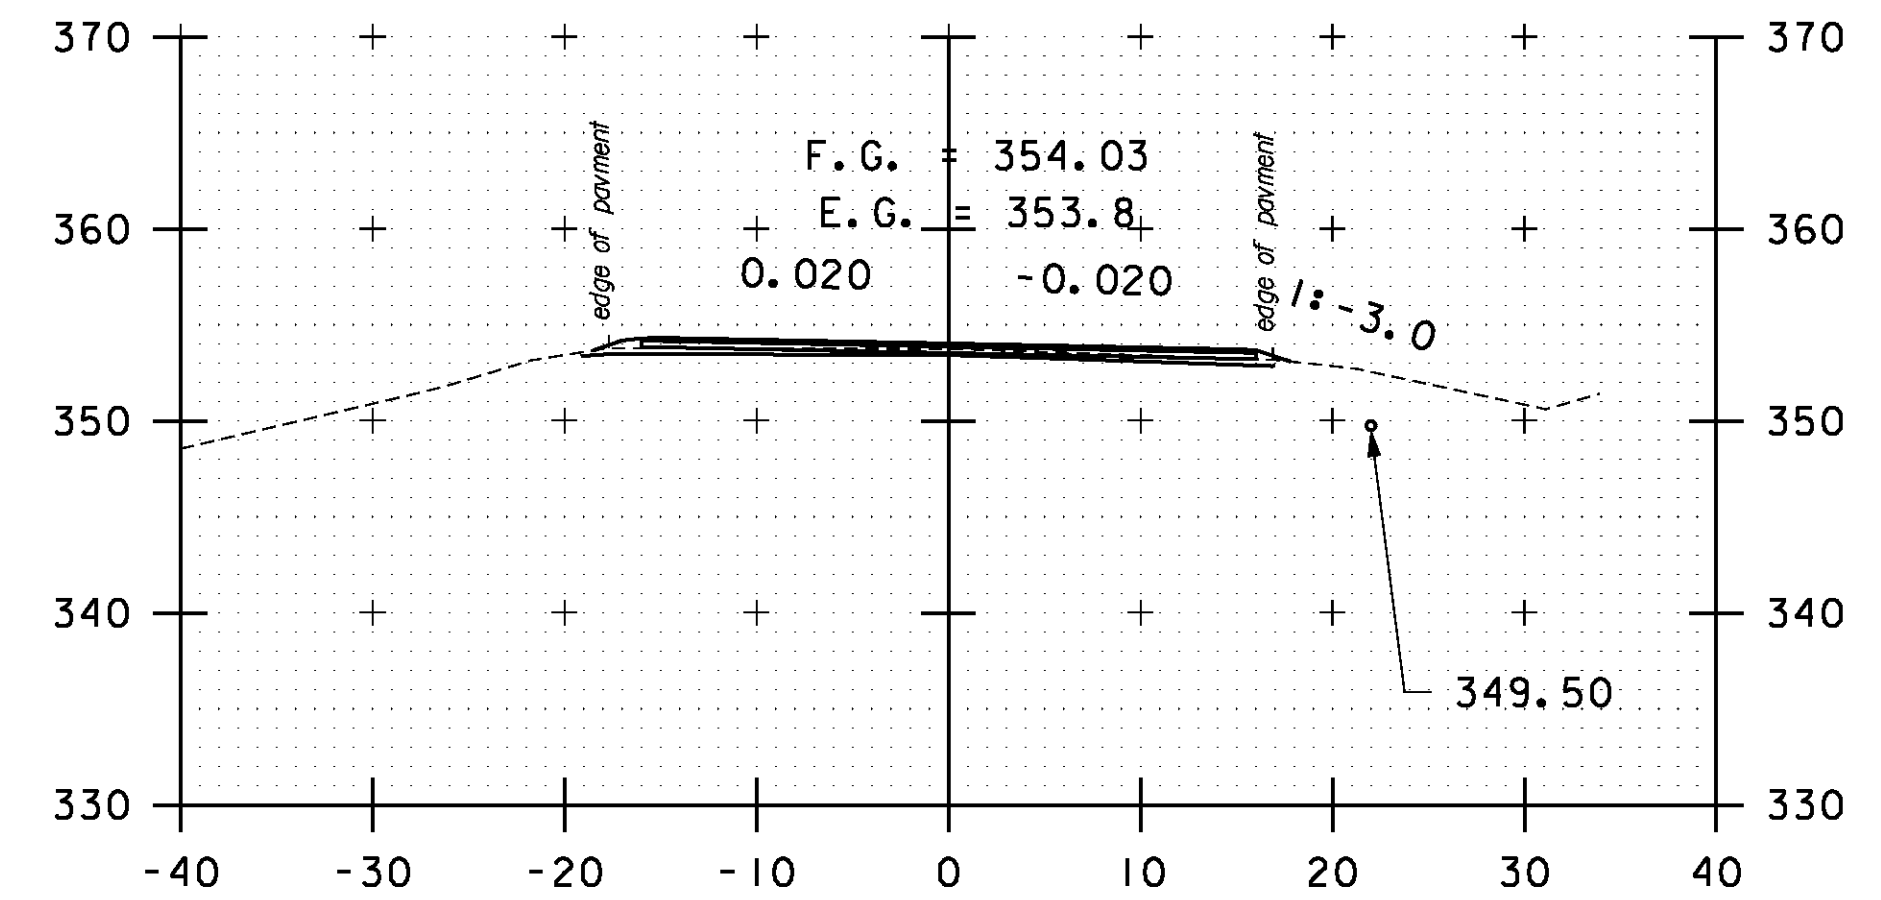


DRIVE LT  
246+00

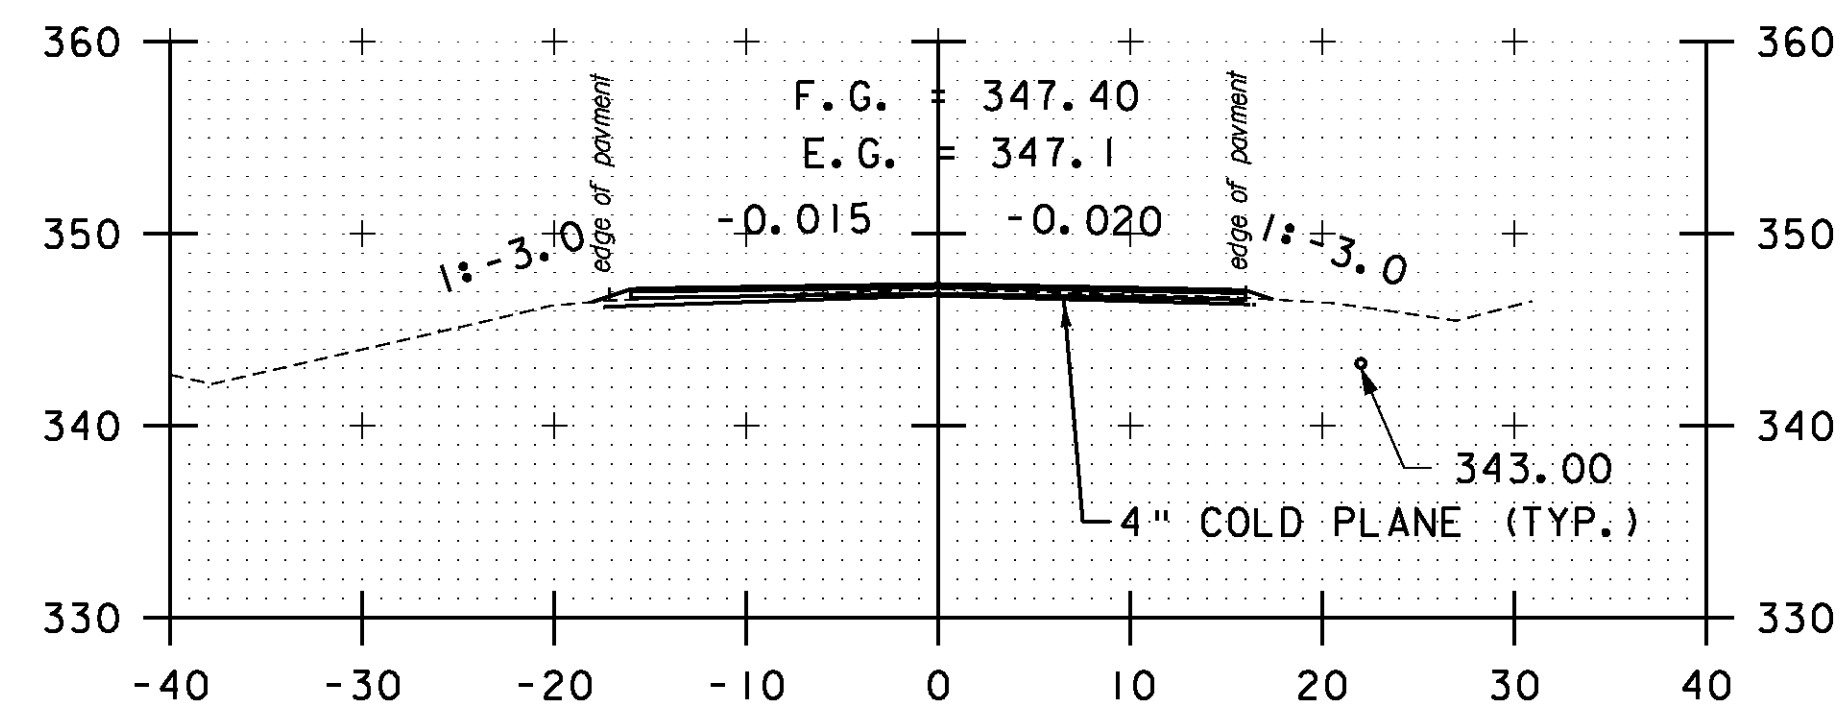


242+50

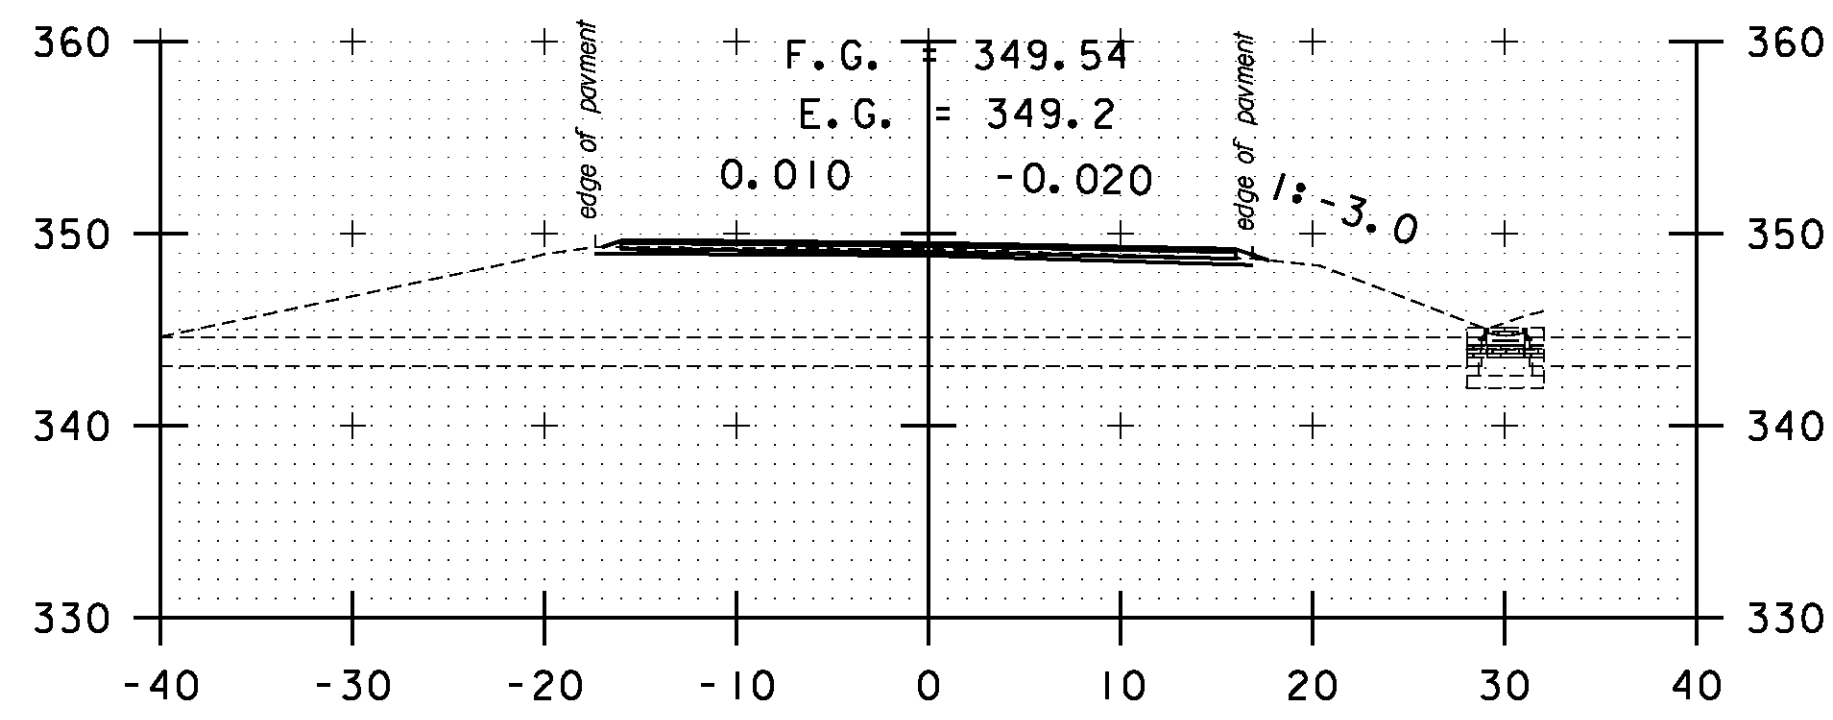


244+00

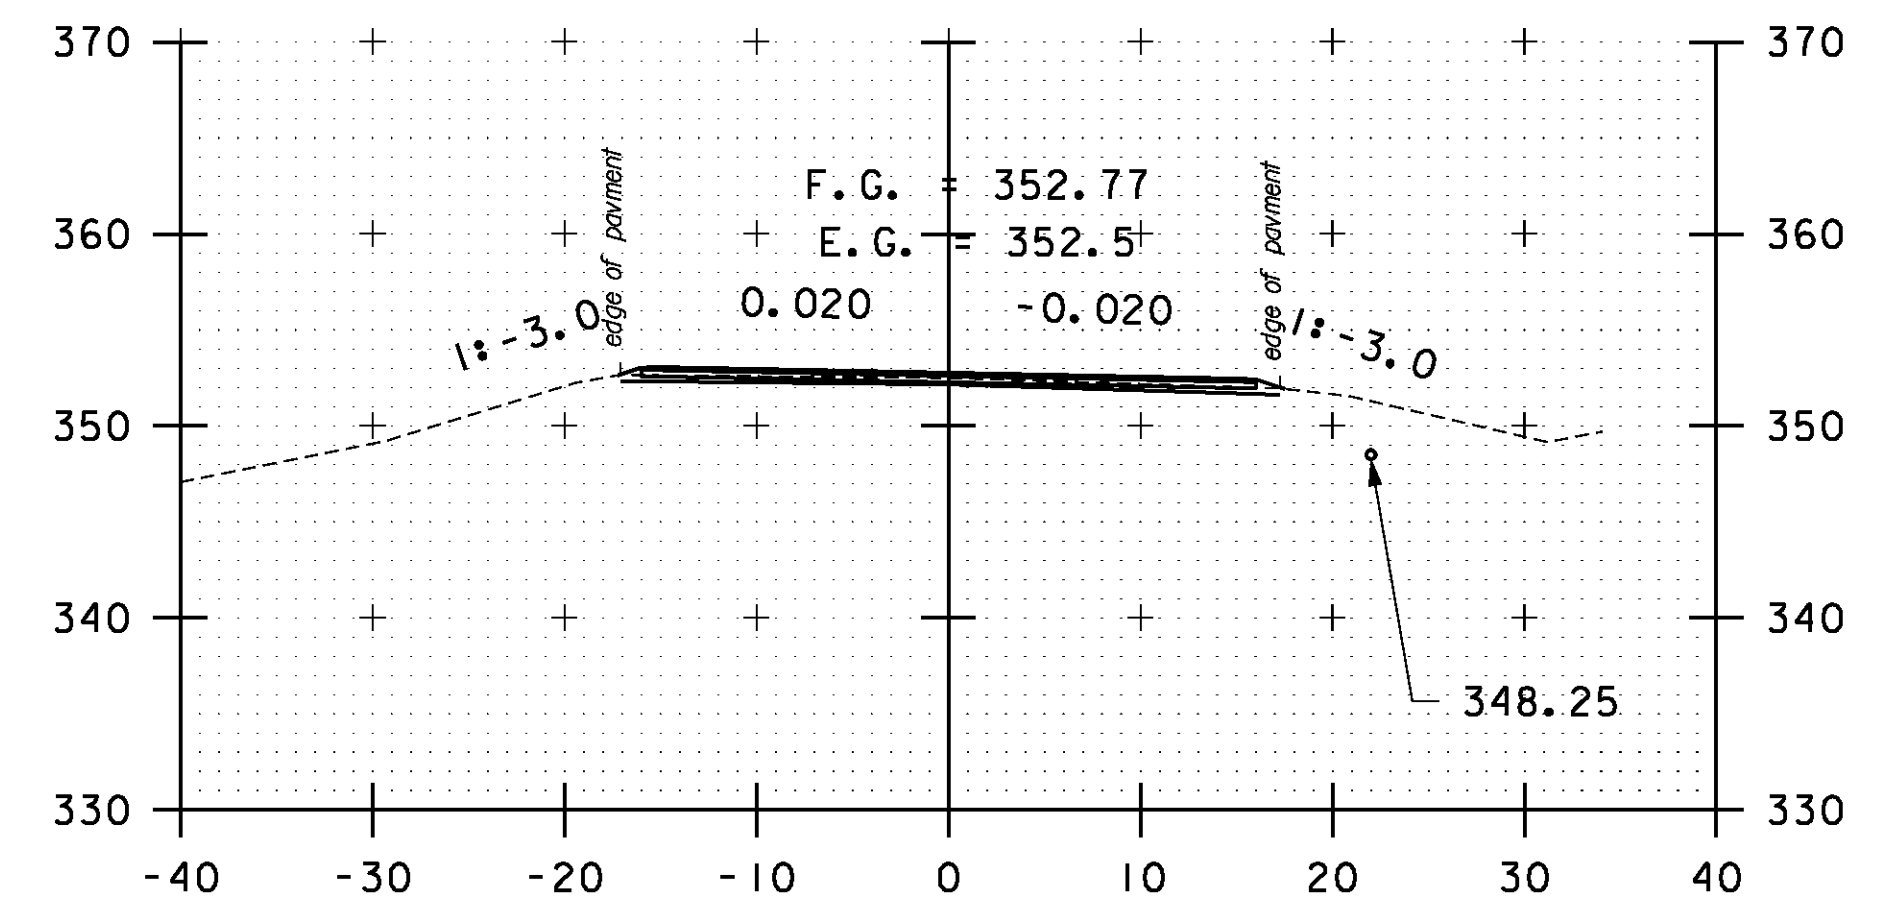


245+50

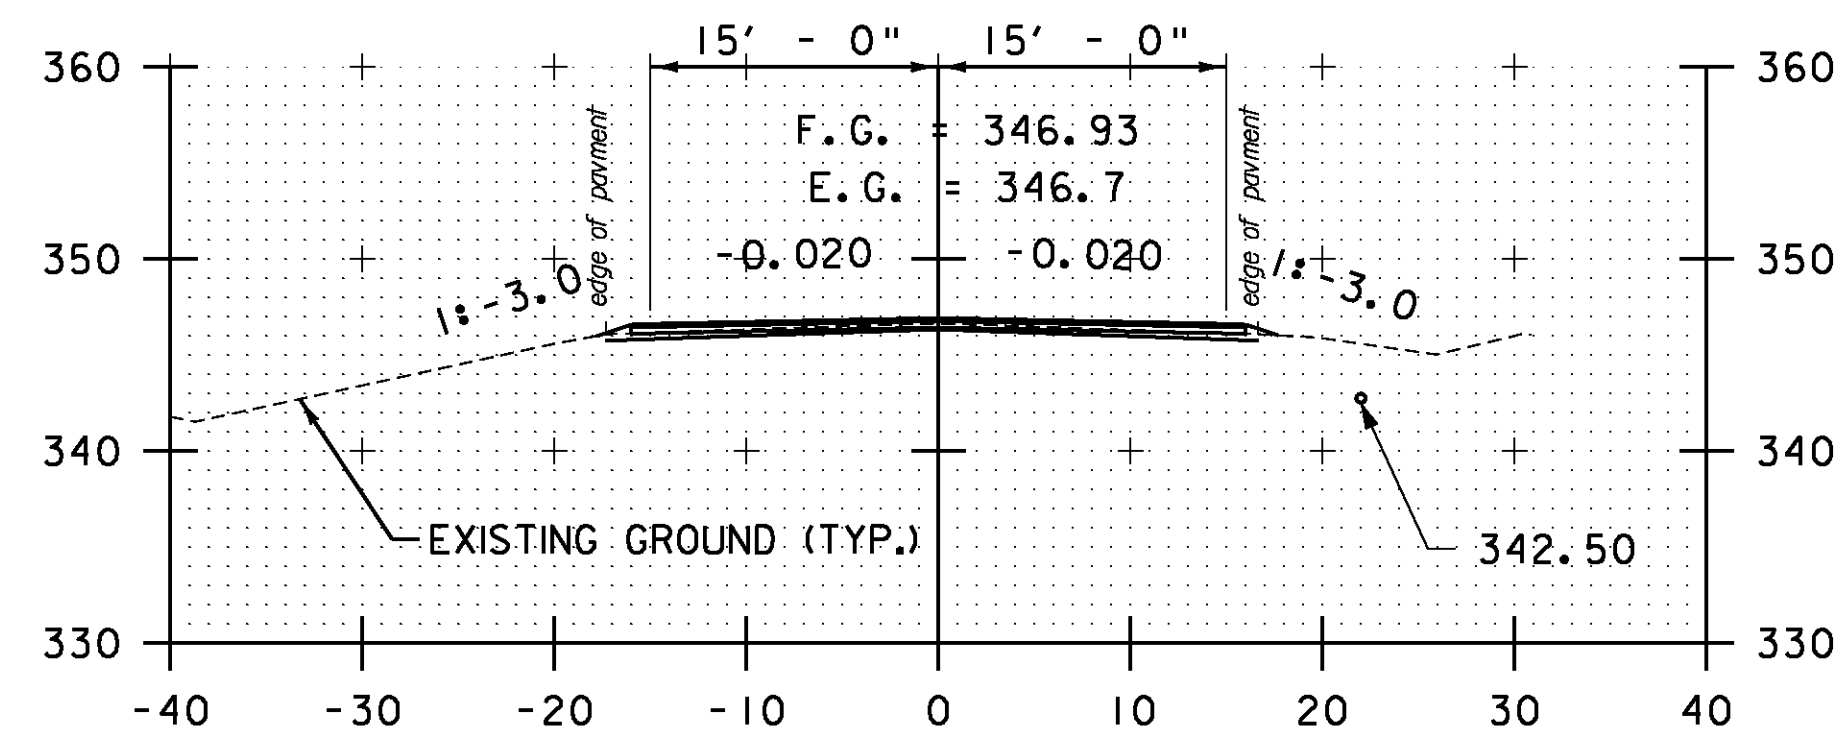

242+00

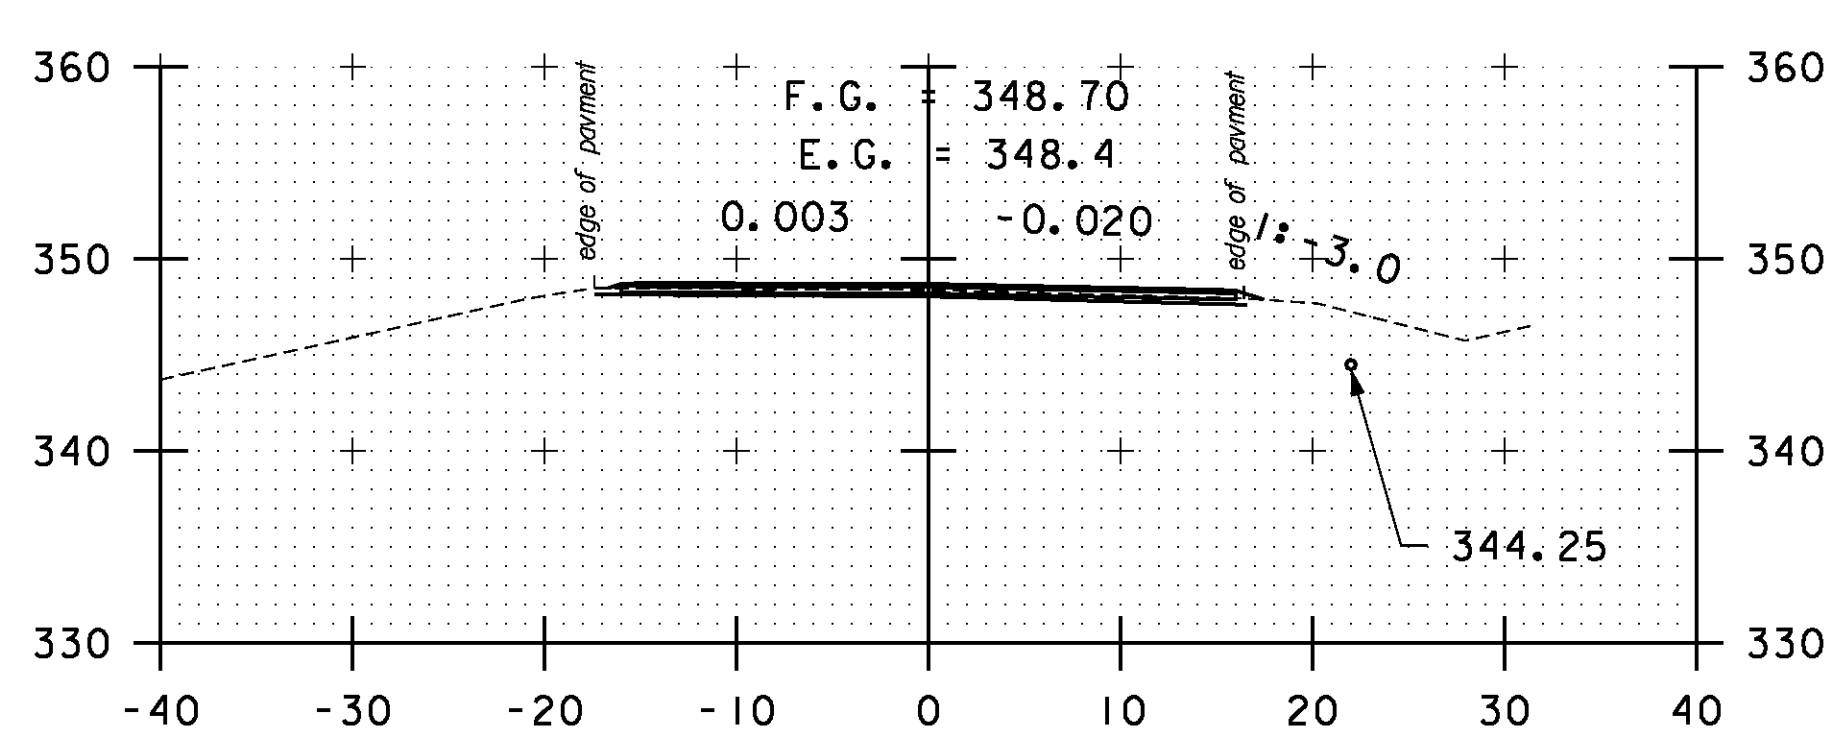

243+50

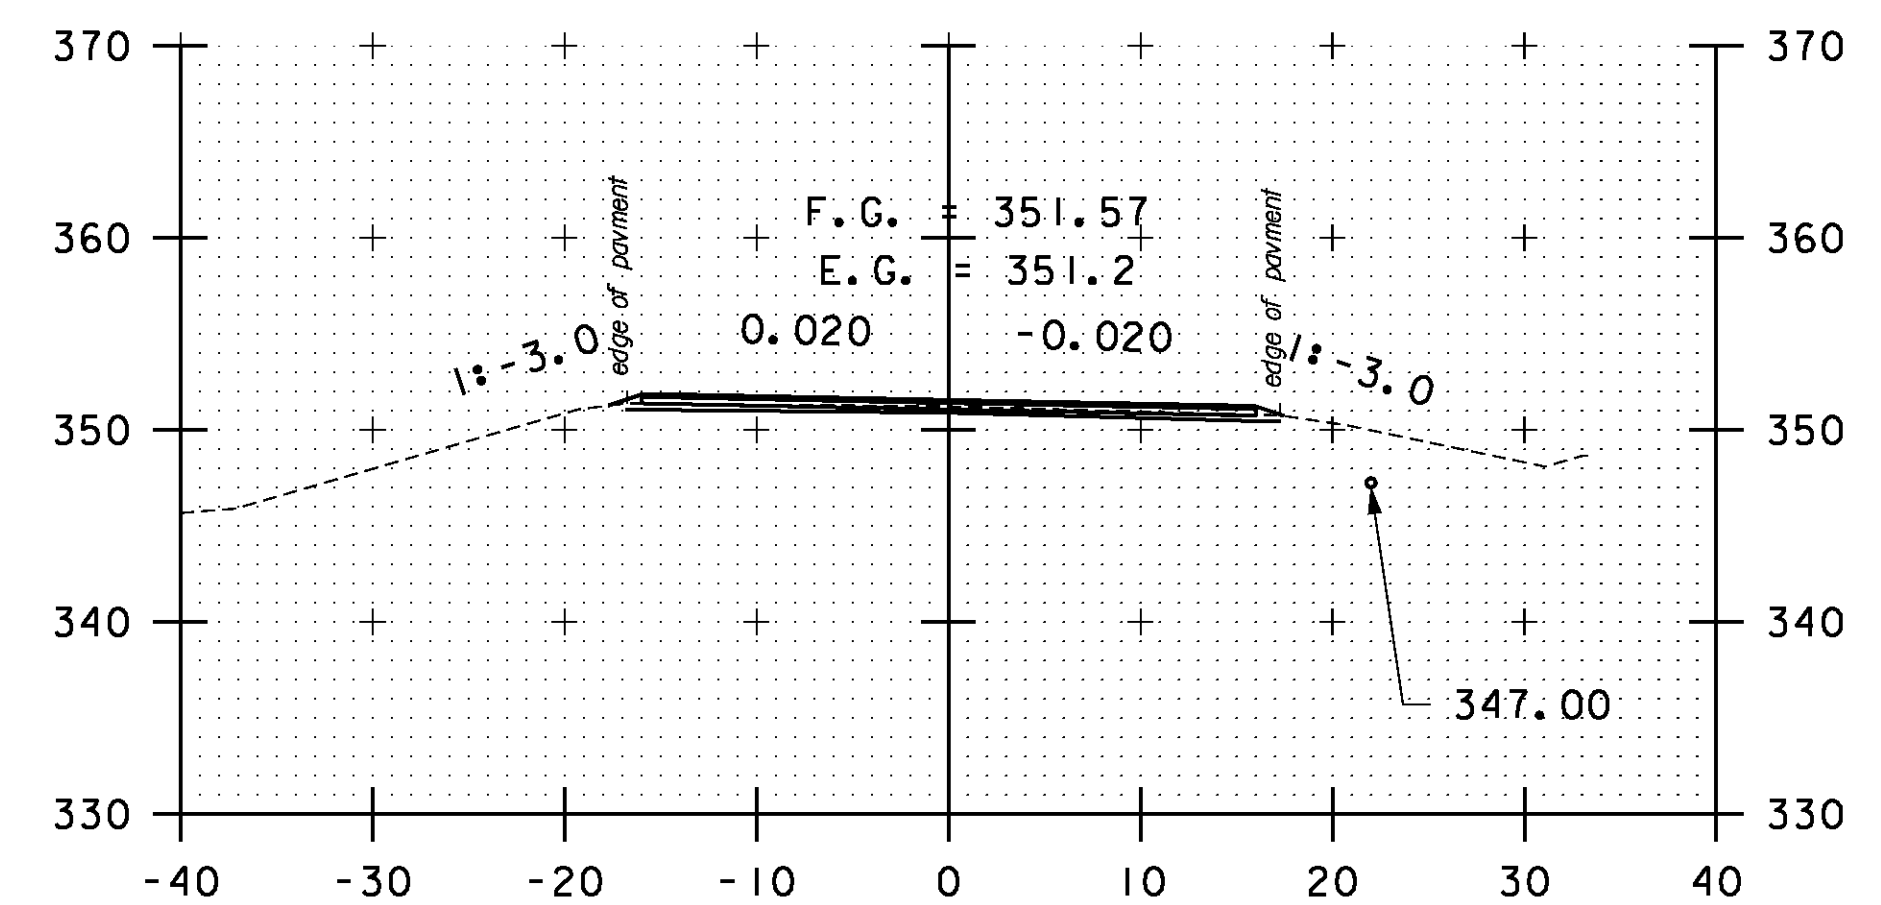

245+00

STA. 242+00 TO STA. 246+00

SCALE 1" = 10'-0"  
0 10

**CROSS SECTION SHEET 34**

PROJECT NAME: BOLTON-WATERBURY

PROJECT NUMBER: STP 2709(I)

FILE NAME: p07C172.dgn

PROJECT LEADER: CDL

DESIGNED BY: BMB

PLOT FILE: p07C172.160.1

PLOT DATE: 4/16/2013

DRAWN BY: BMB

CHECKED BY: CDL

SHEET 160 OF 217