




TH#6 LT
247+50

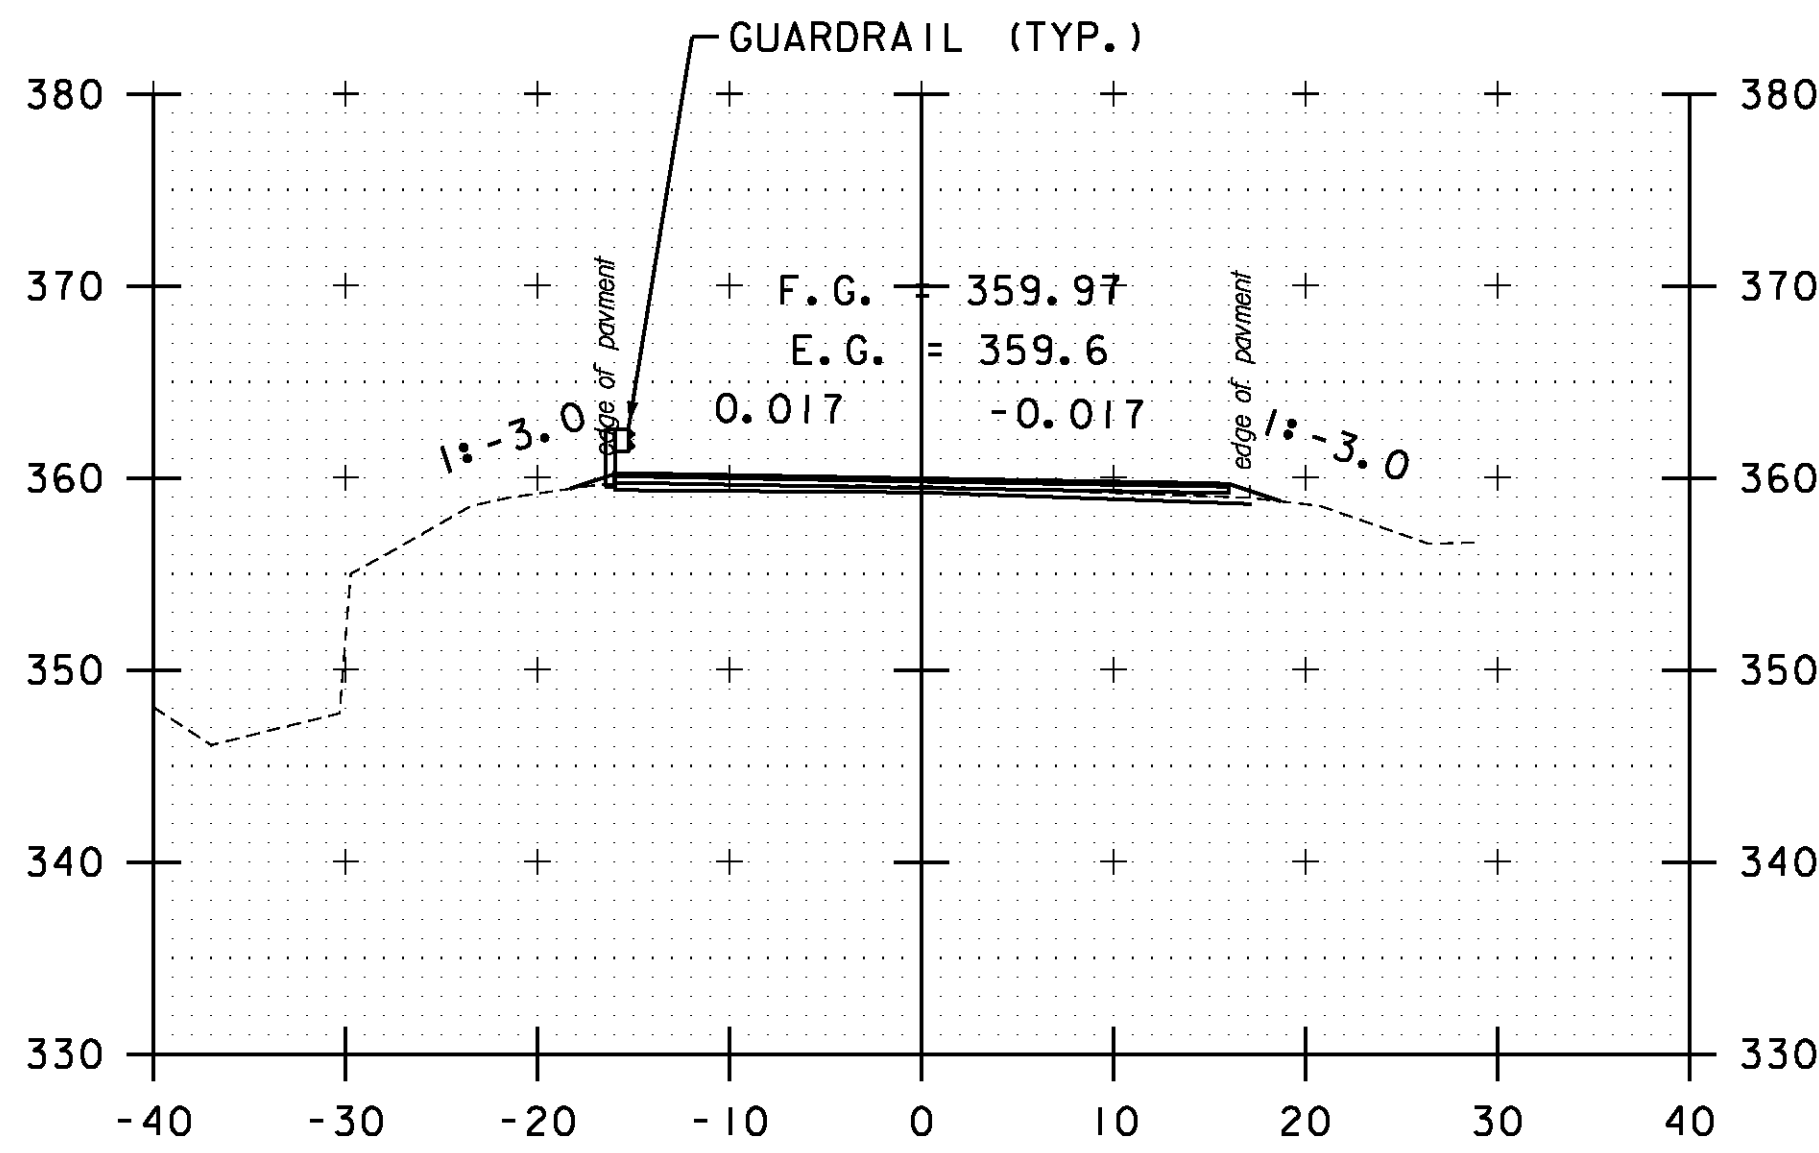


248+50

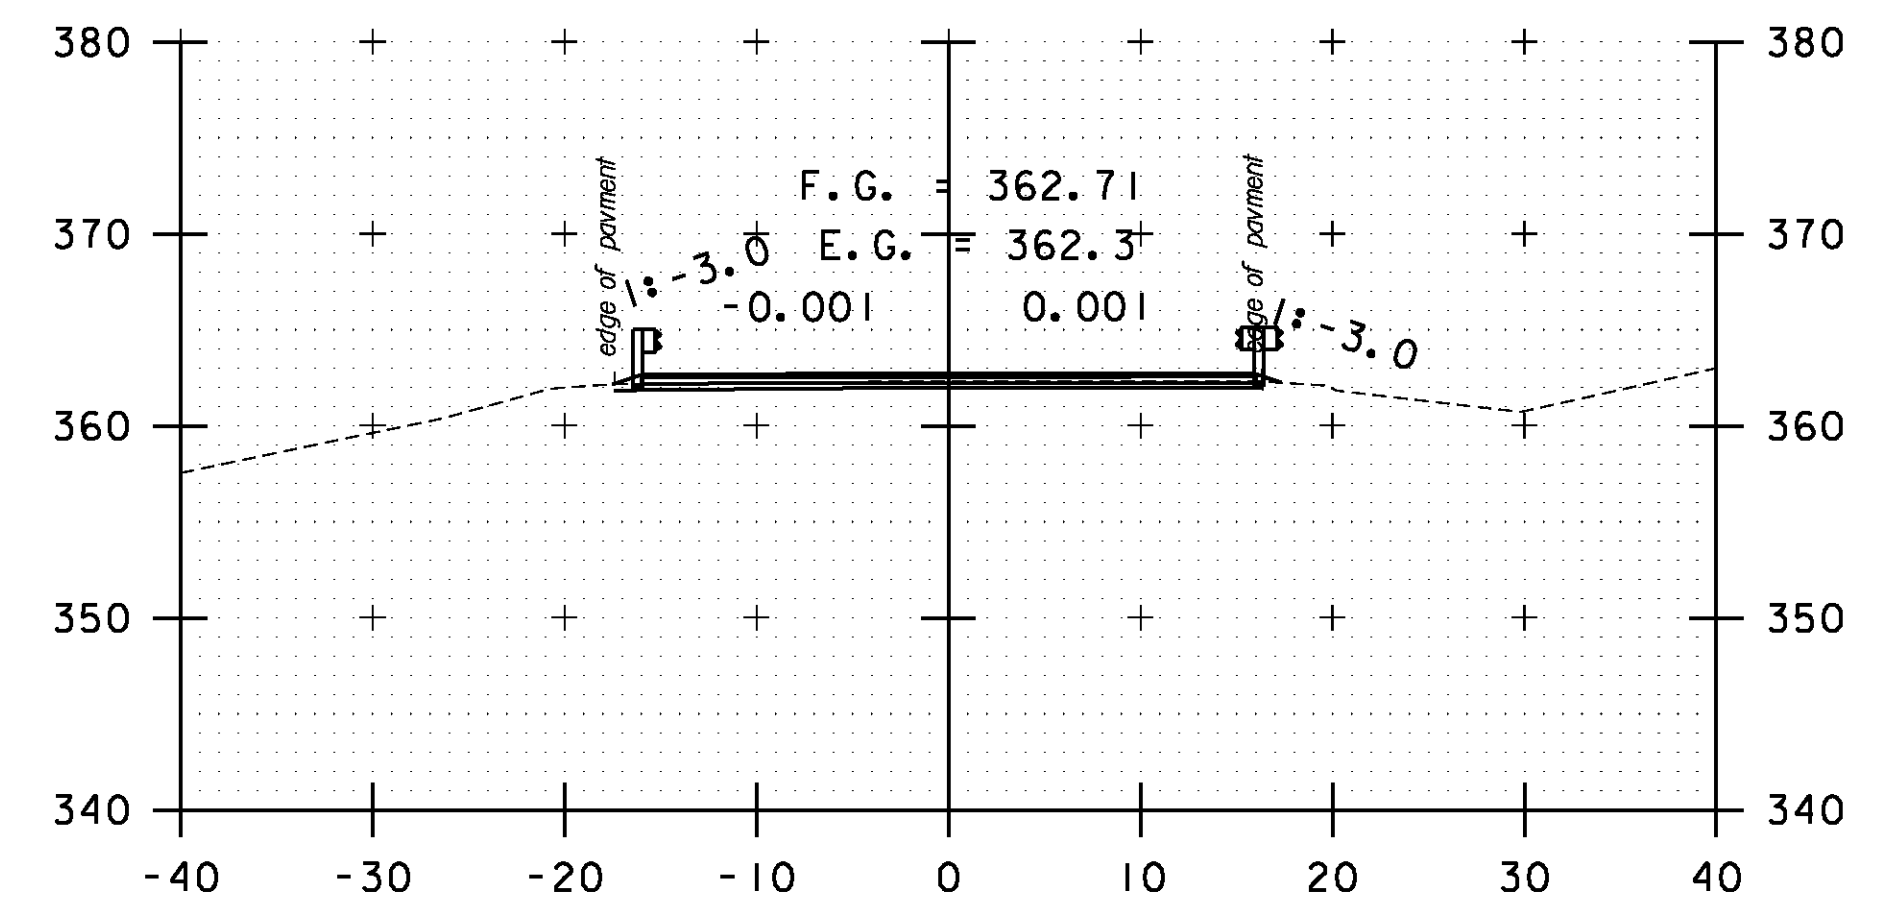


250+00

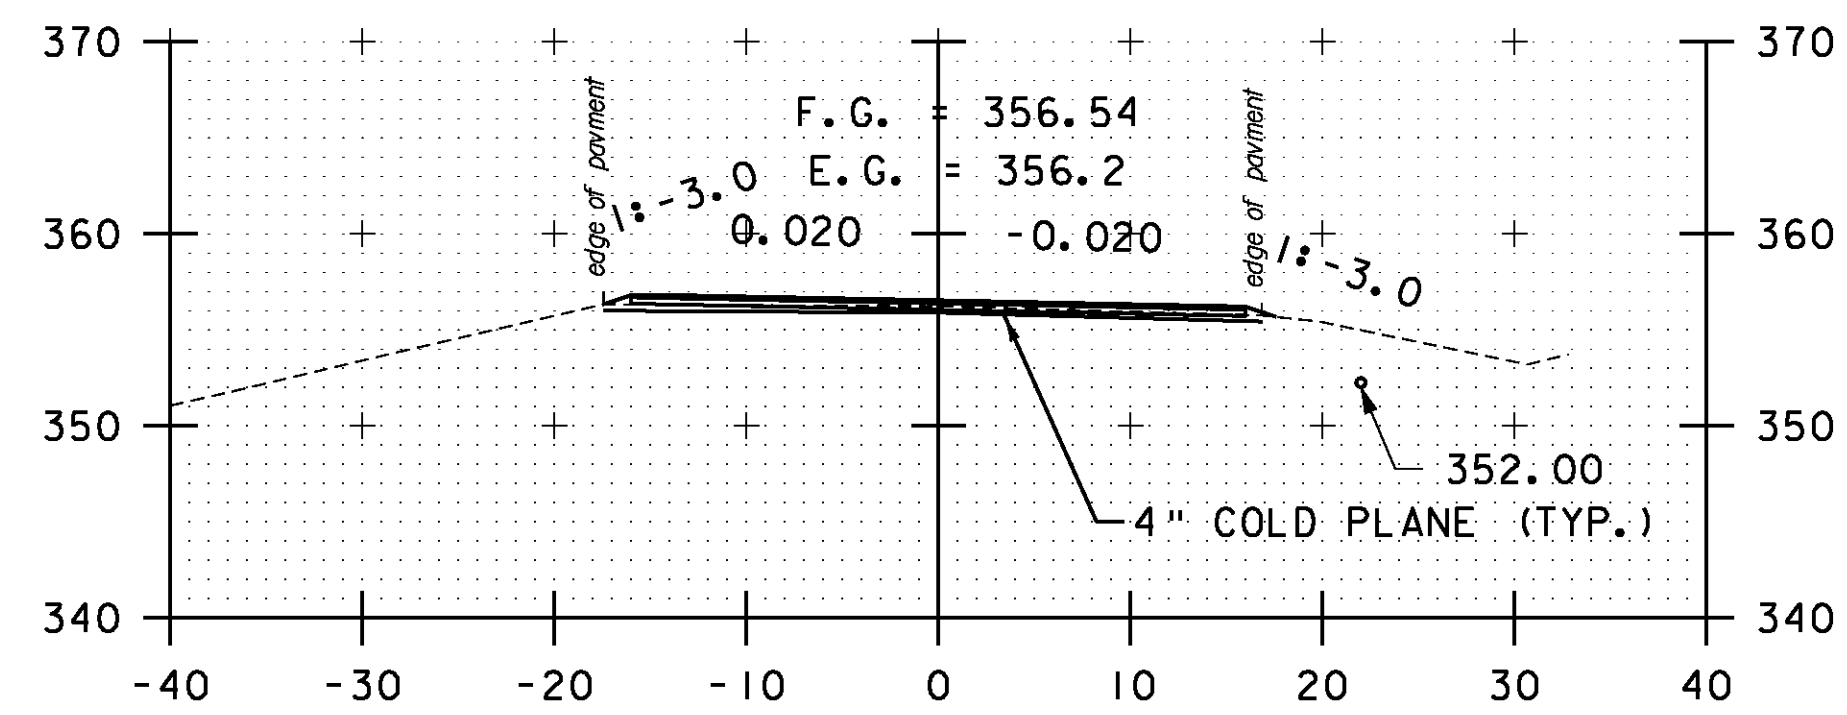


247+00

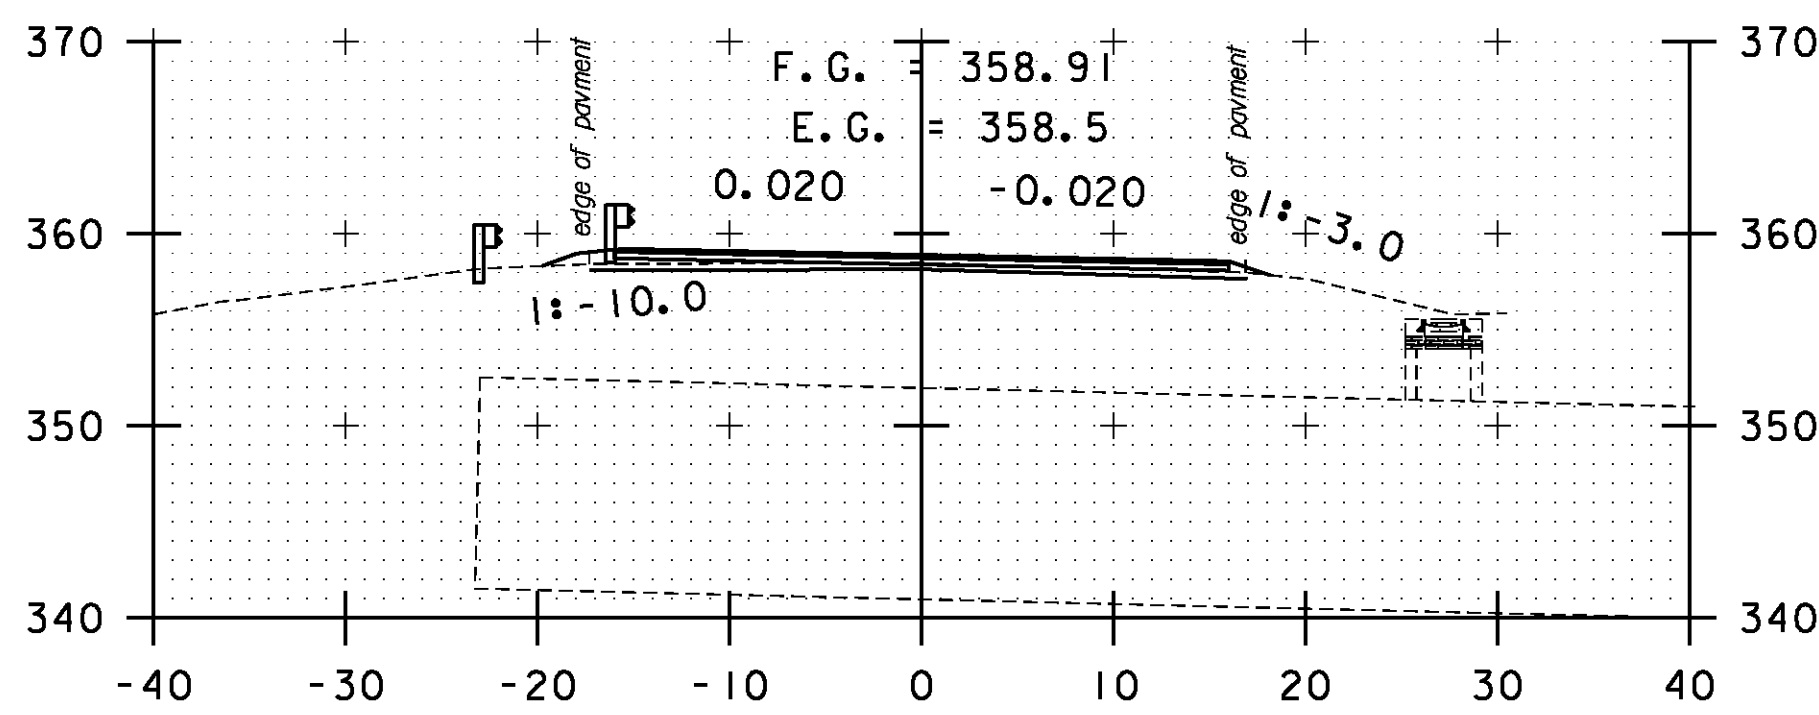


TH#6 LT
248+00

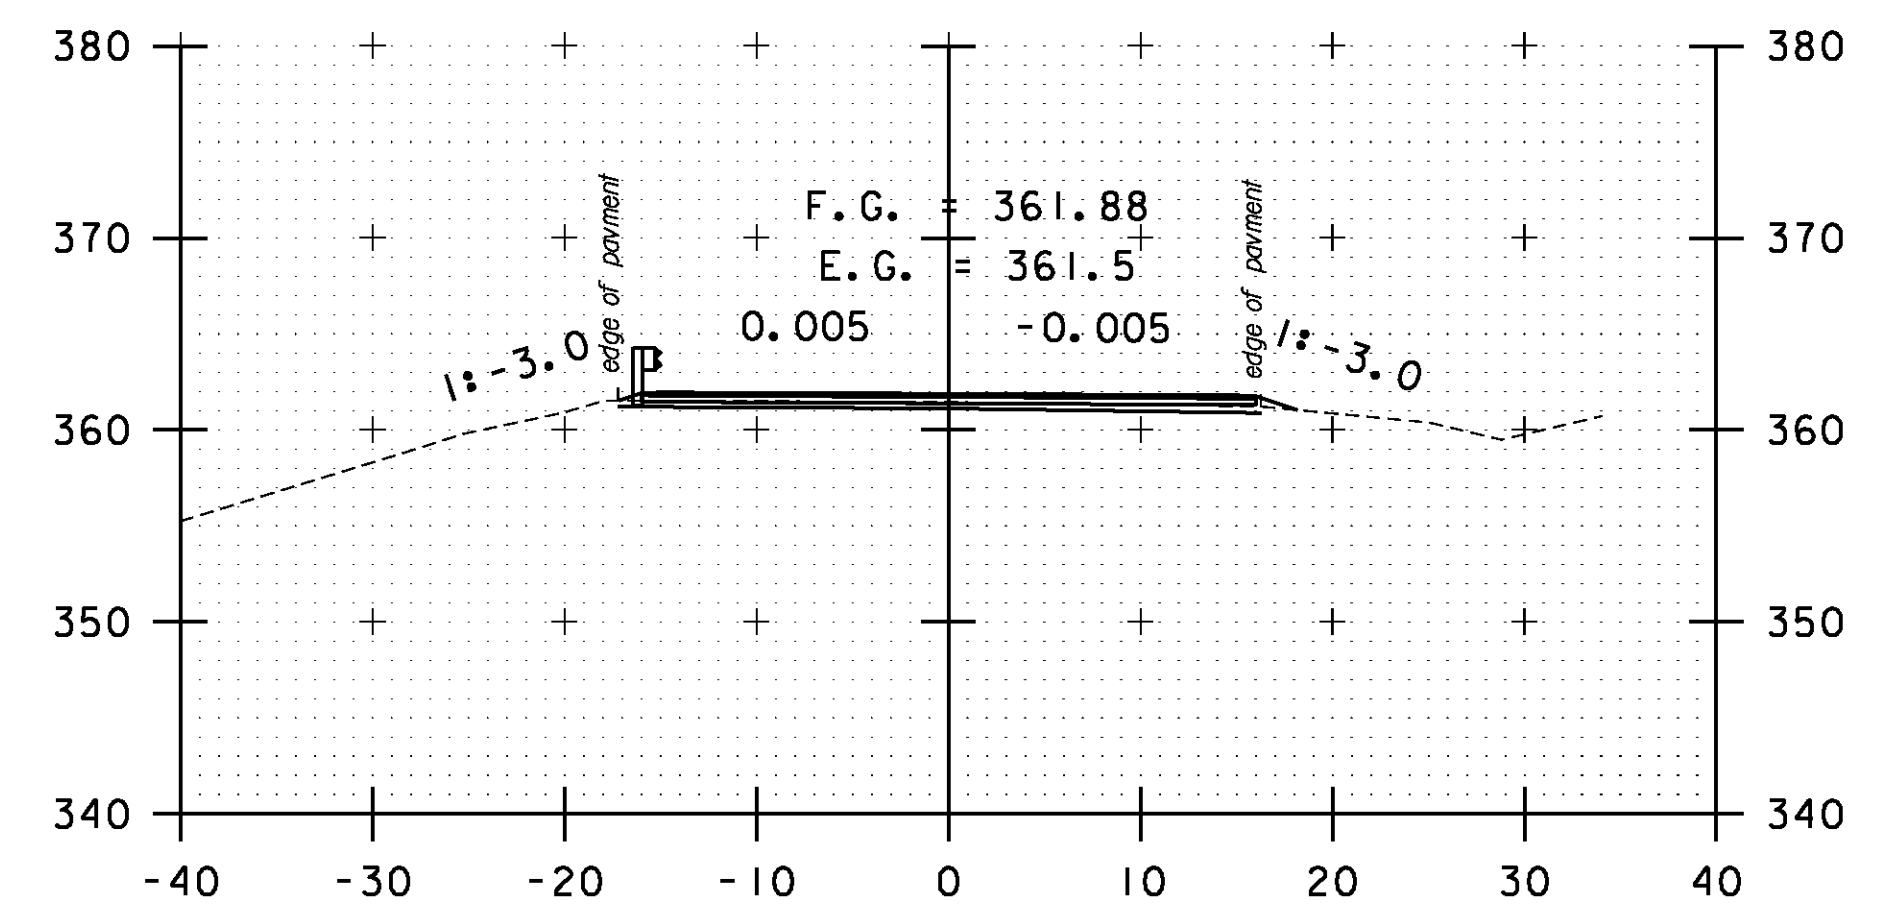


249+50

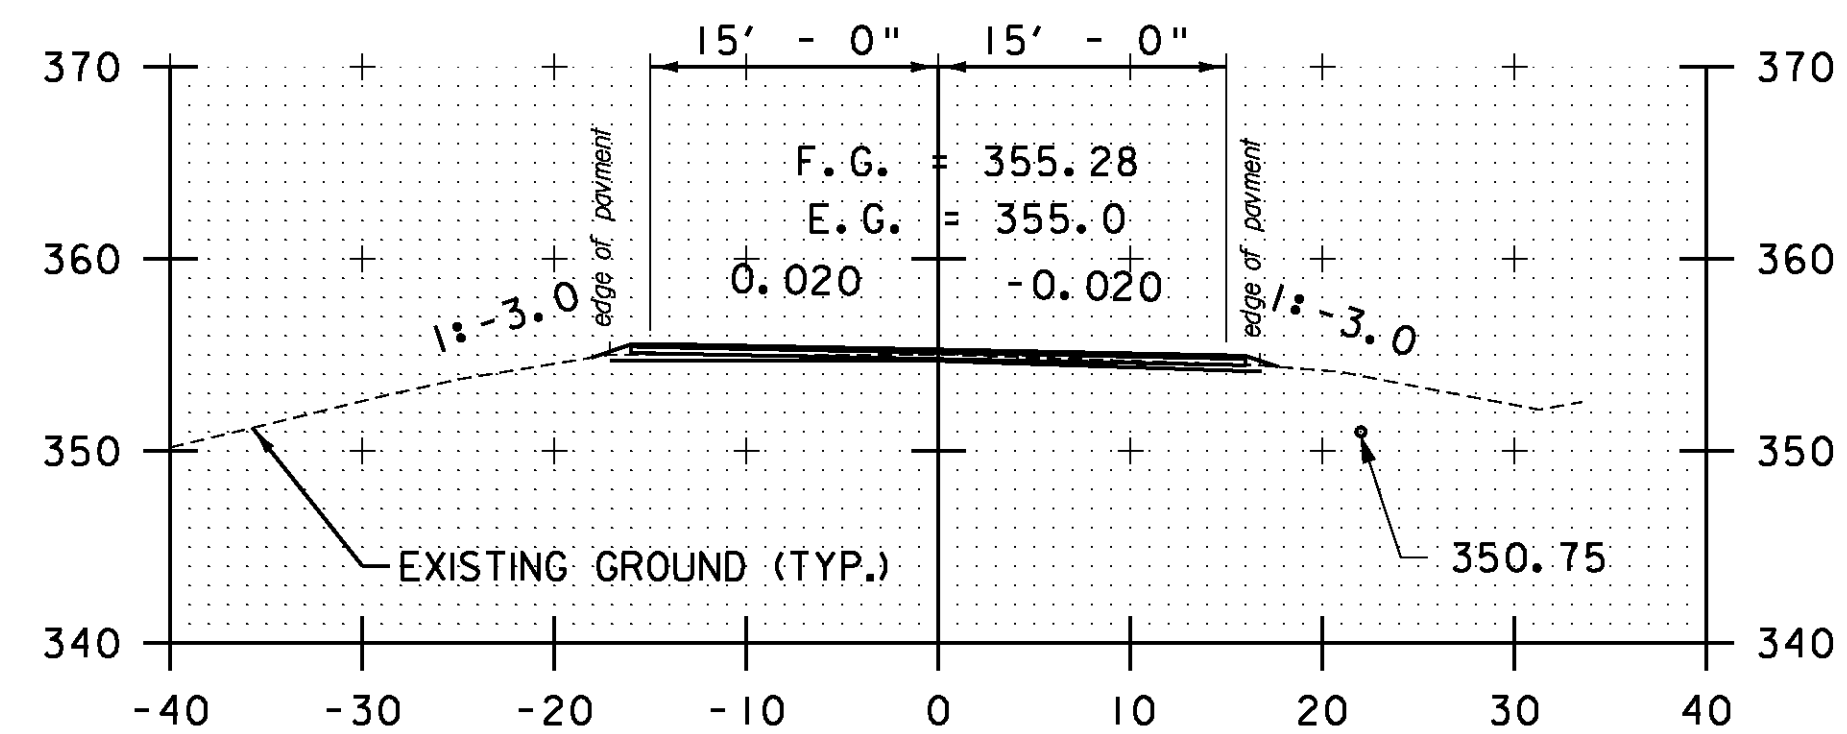

246+50

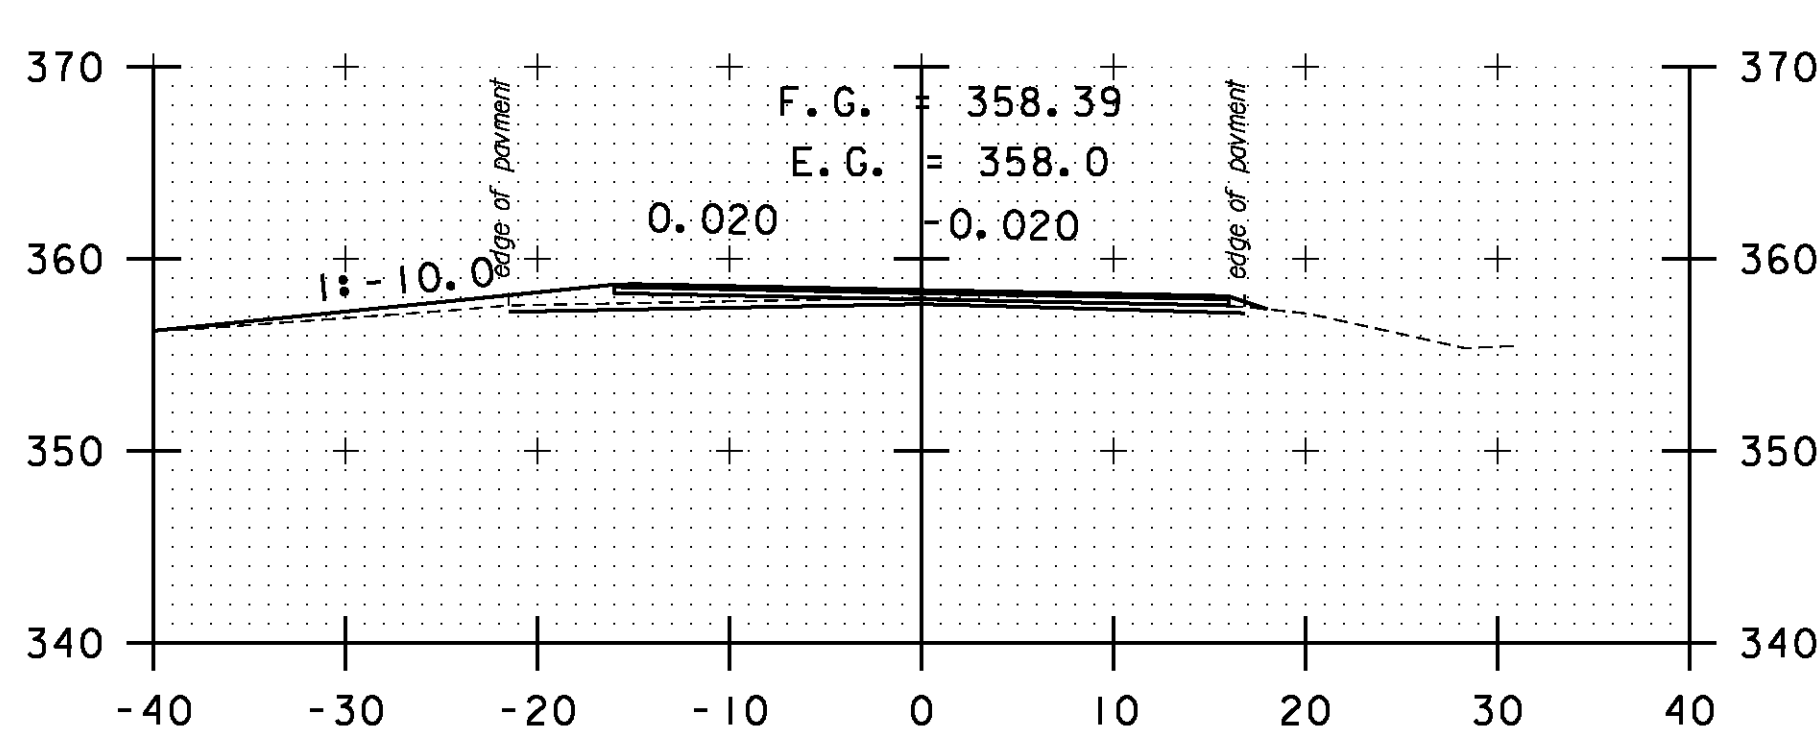

TH#6 LT
247+77

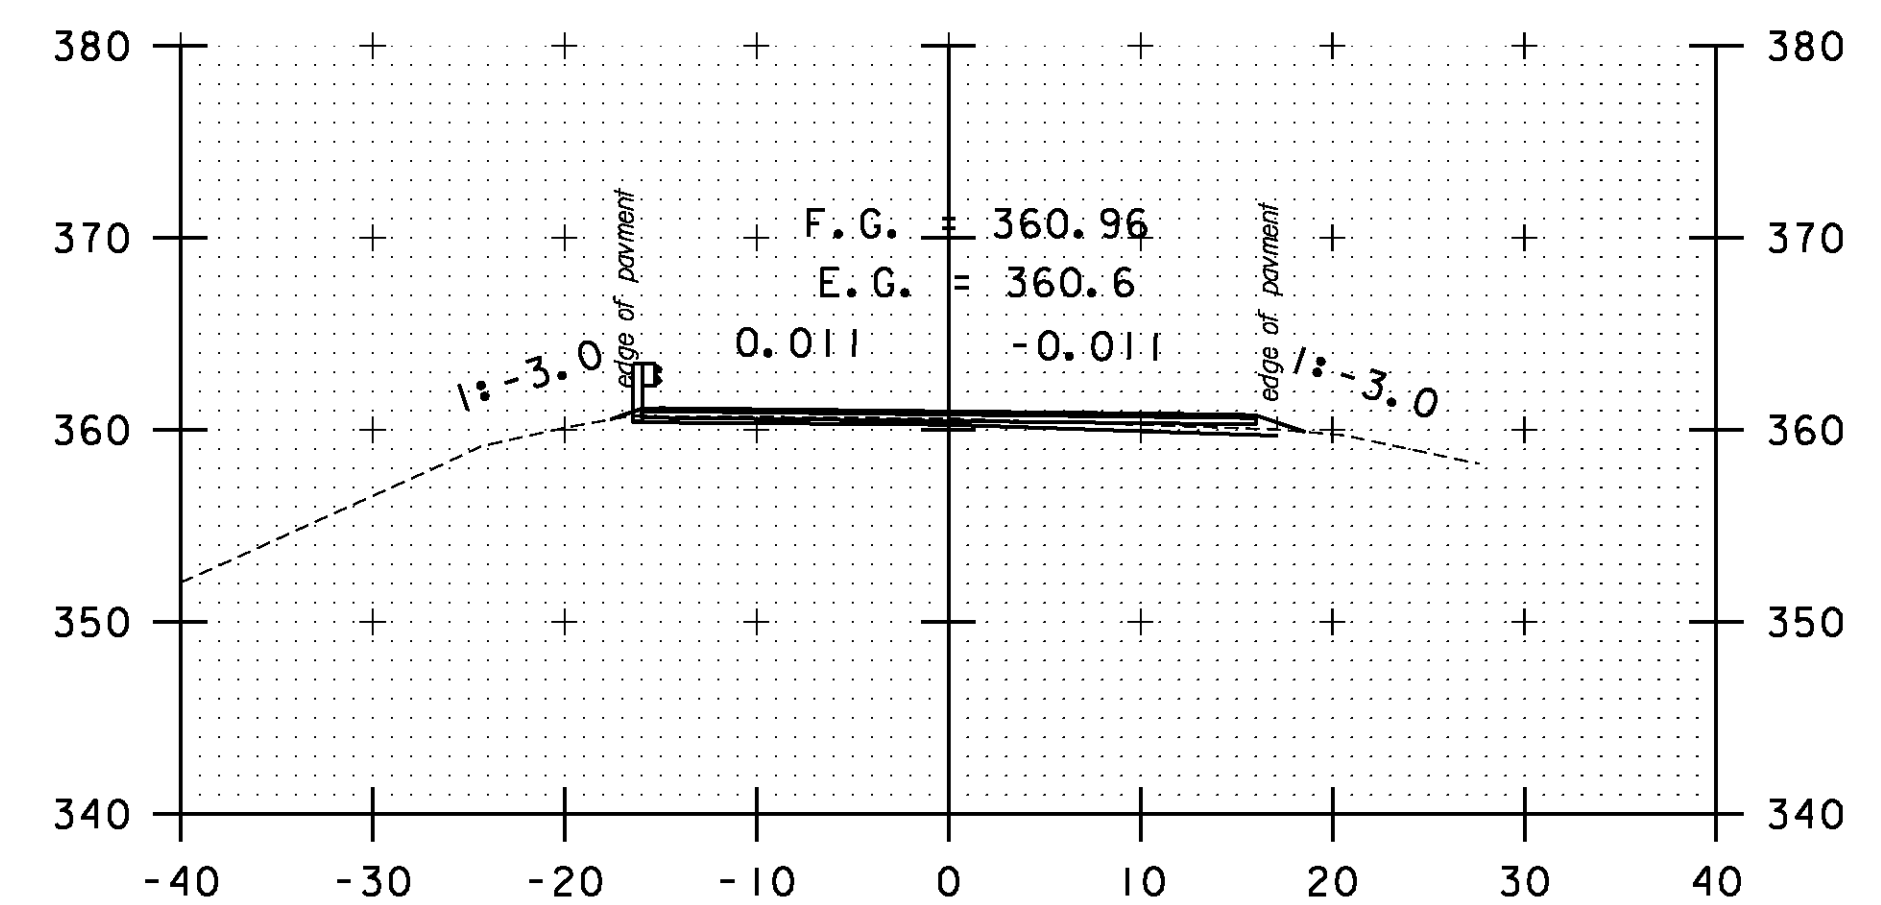

249+00

STA. 246+50 TO STA. 250+00

SCALE 1" = 10'-0"

CROSS SECTION SHEET 35

PROJECT NAME: BOLTON-WATERBURY

PROJECT NUMBER: STP 2709(I)

FILE NAME: p07C172.dgn

PROJECT LEADER: CDL

DESIGNED BY: BMB

PLOT FILE: p07C172_161.i

PLOT DATE: 4/16/2013

DRAWN BY: BMB

CHECKED BY: CDL

SHEET 161 OF 217