




251+50

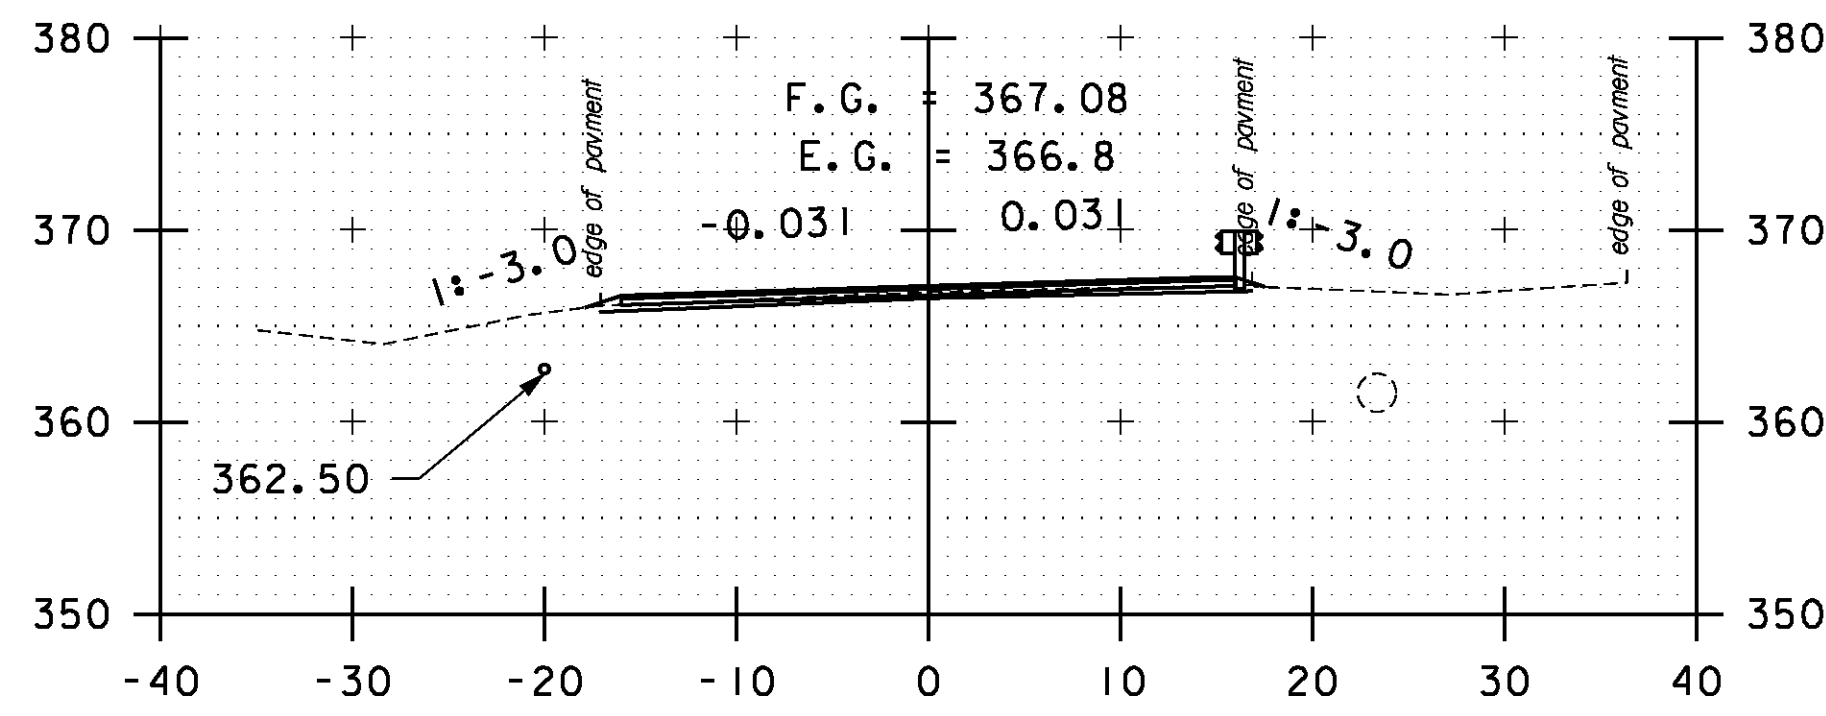


253+00

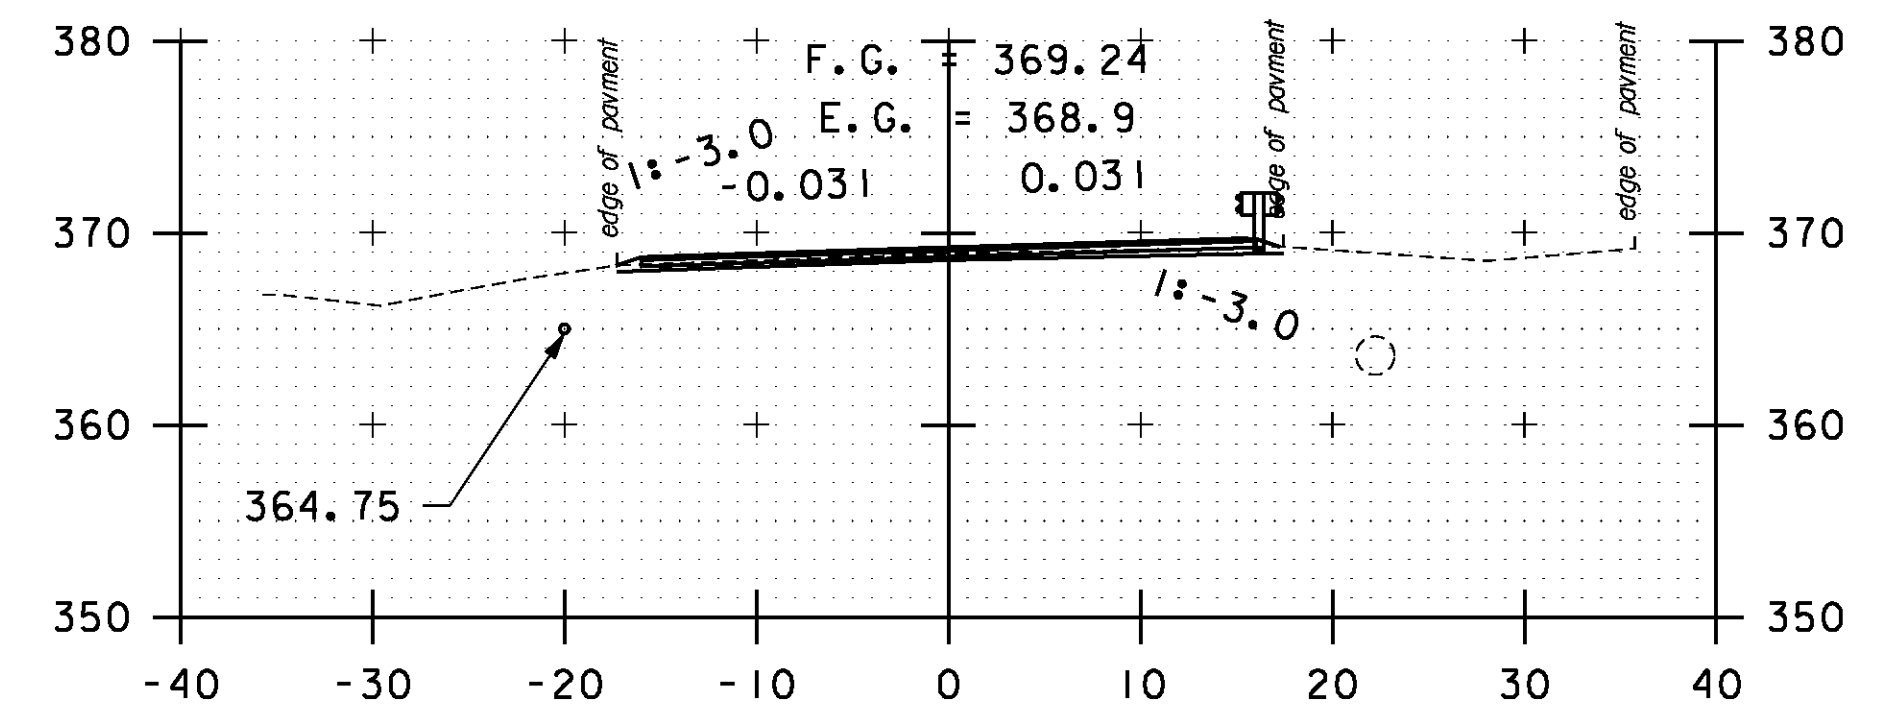


254+50

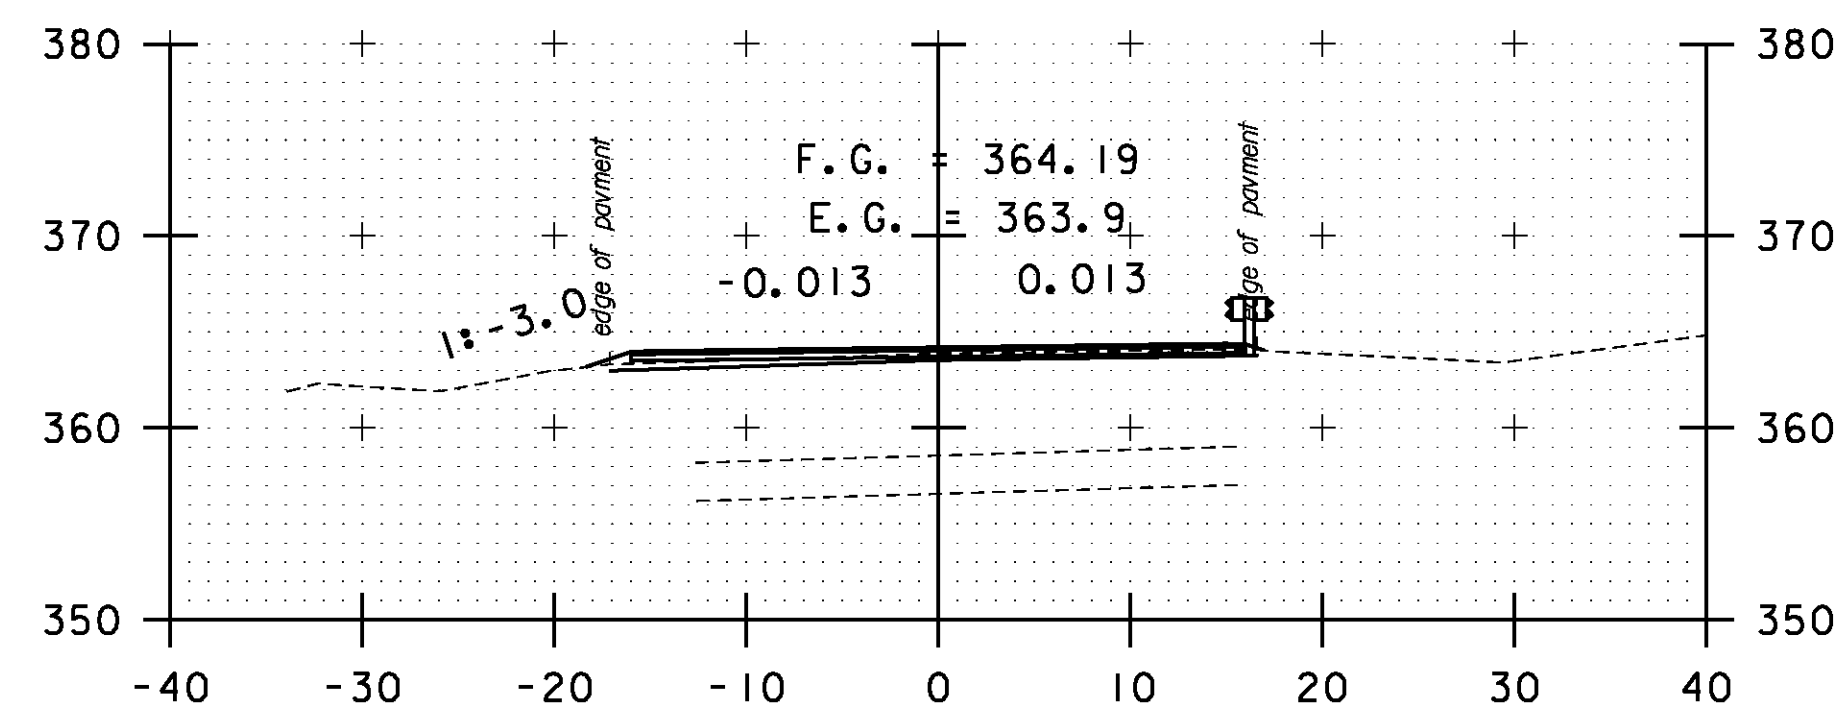


251+00

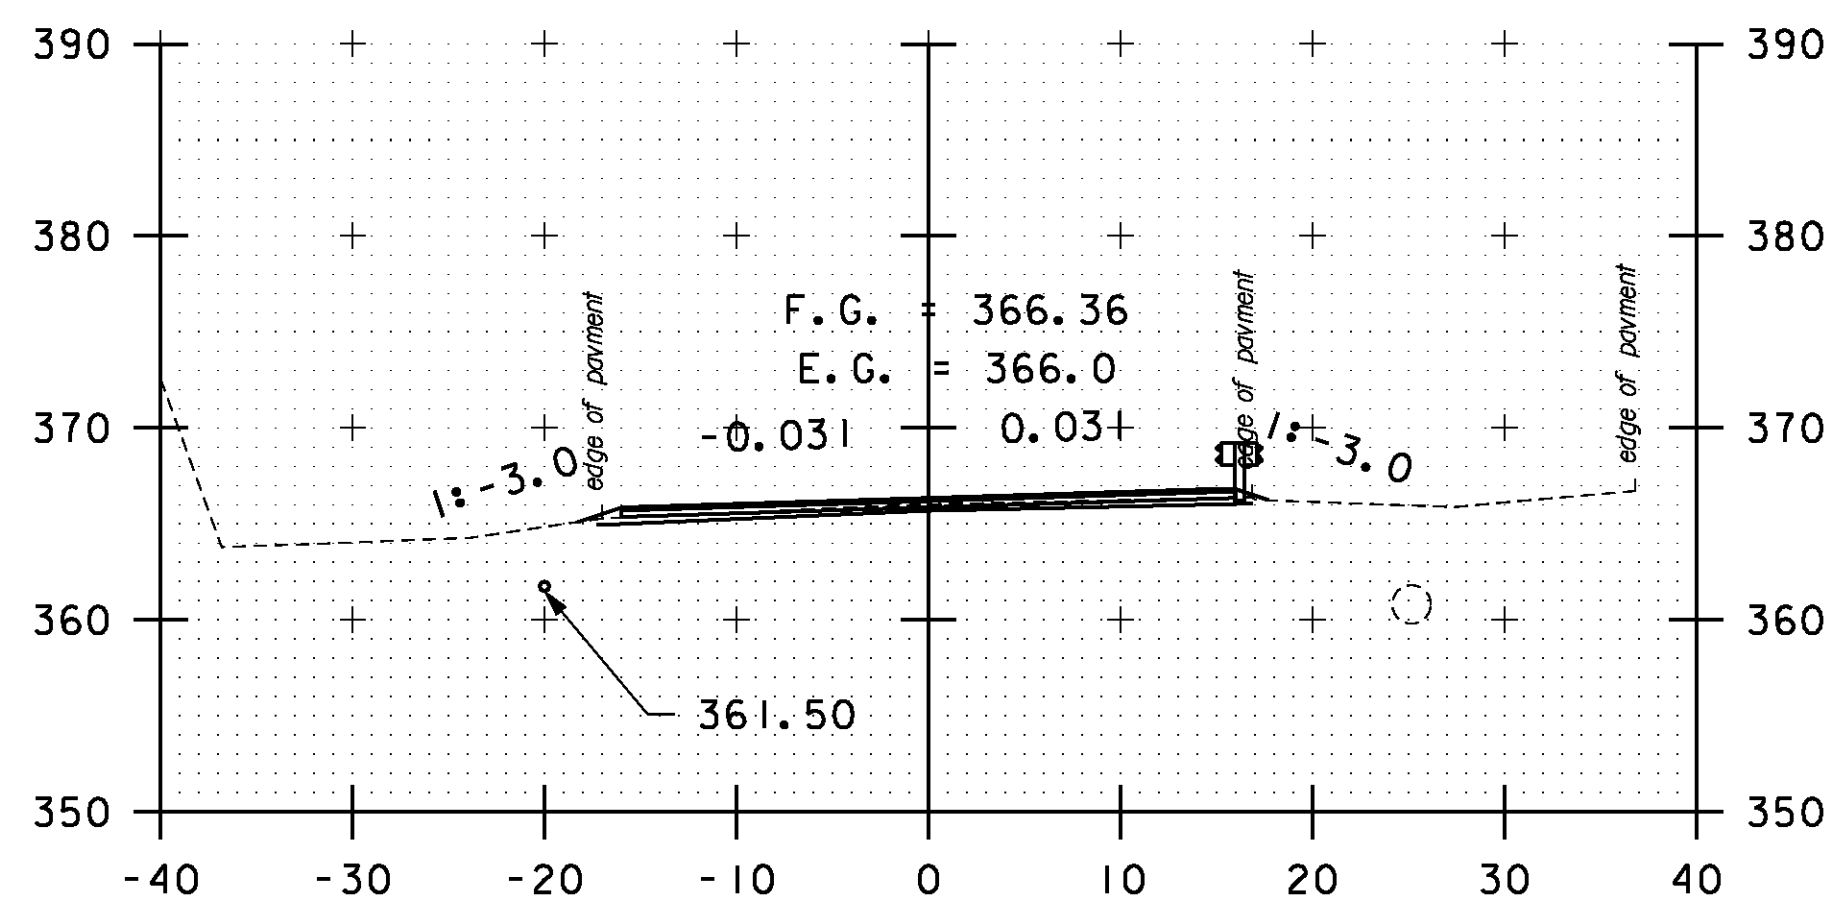


252+50

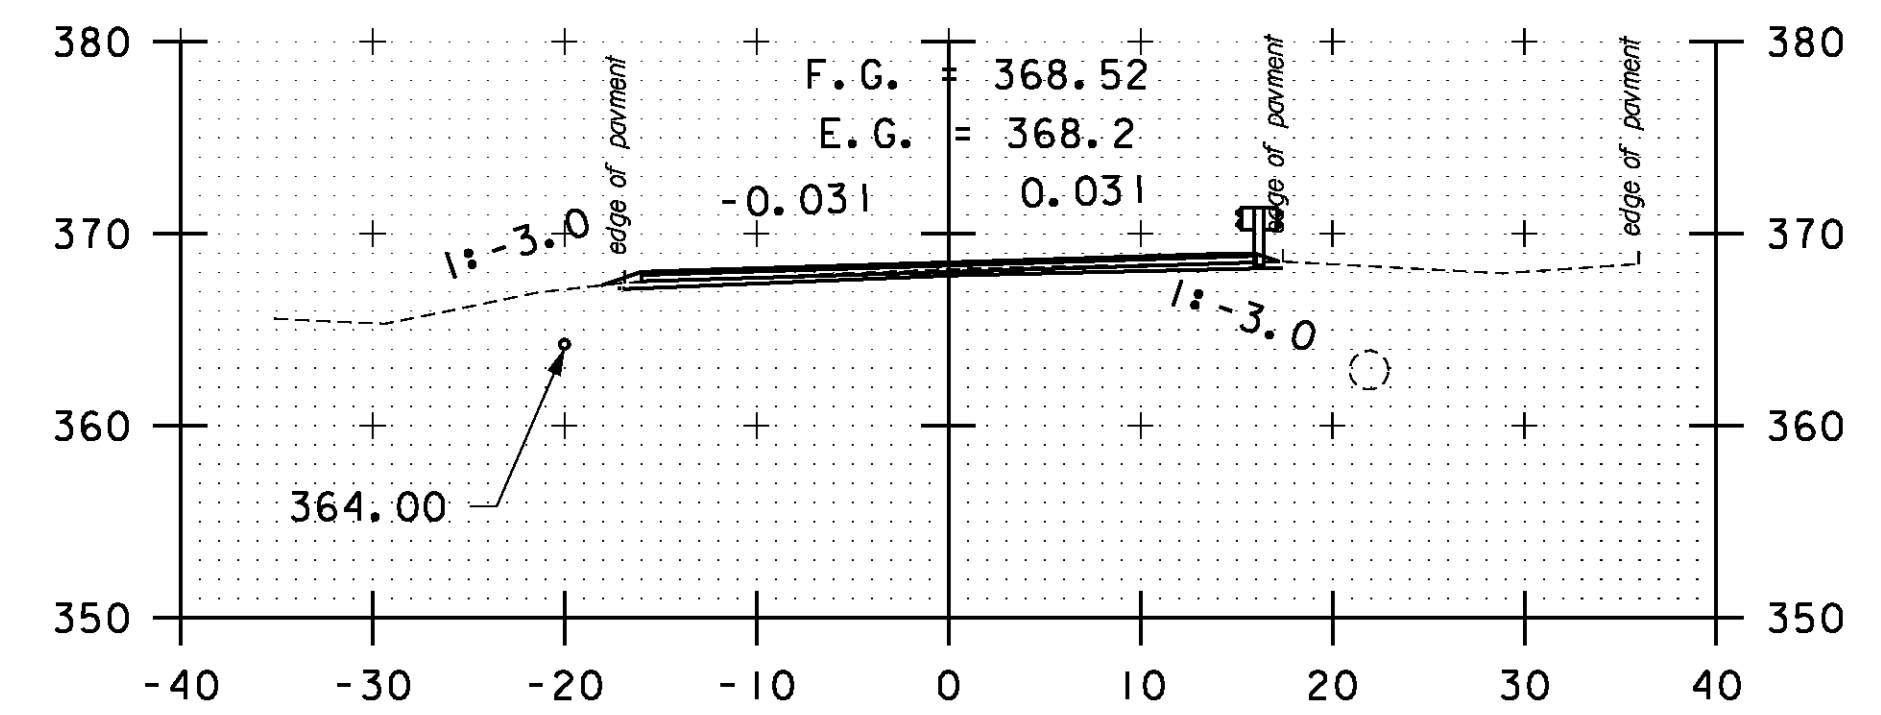


254+00

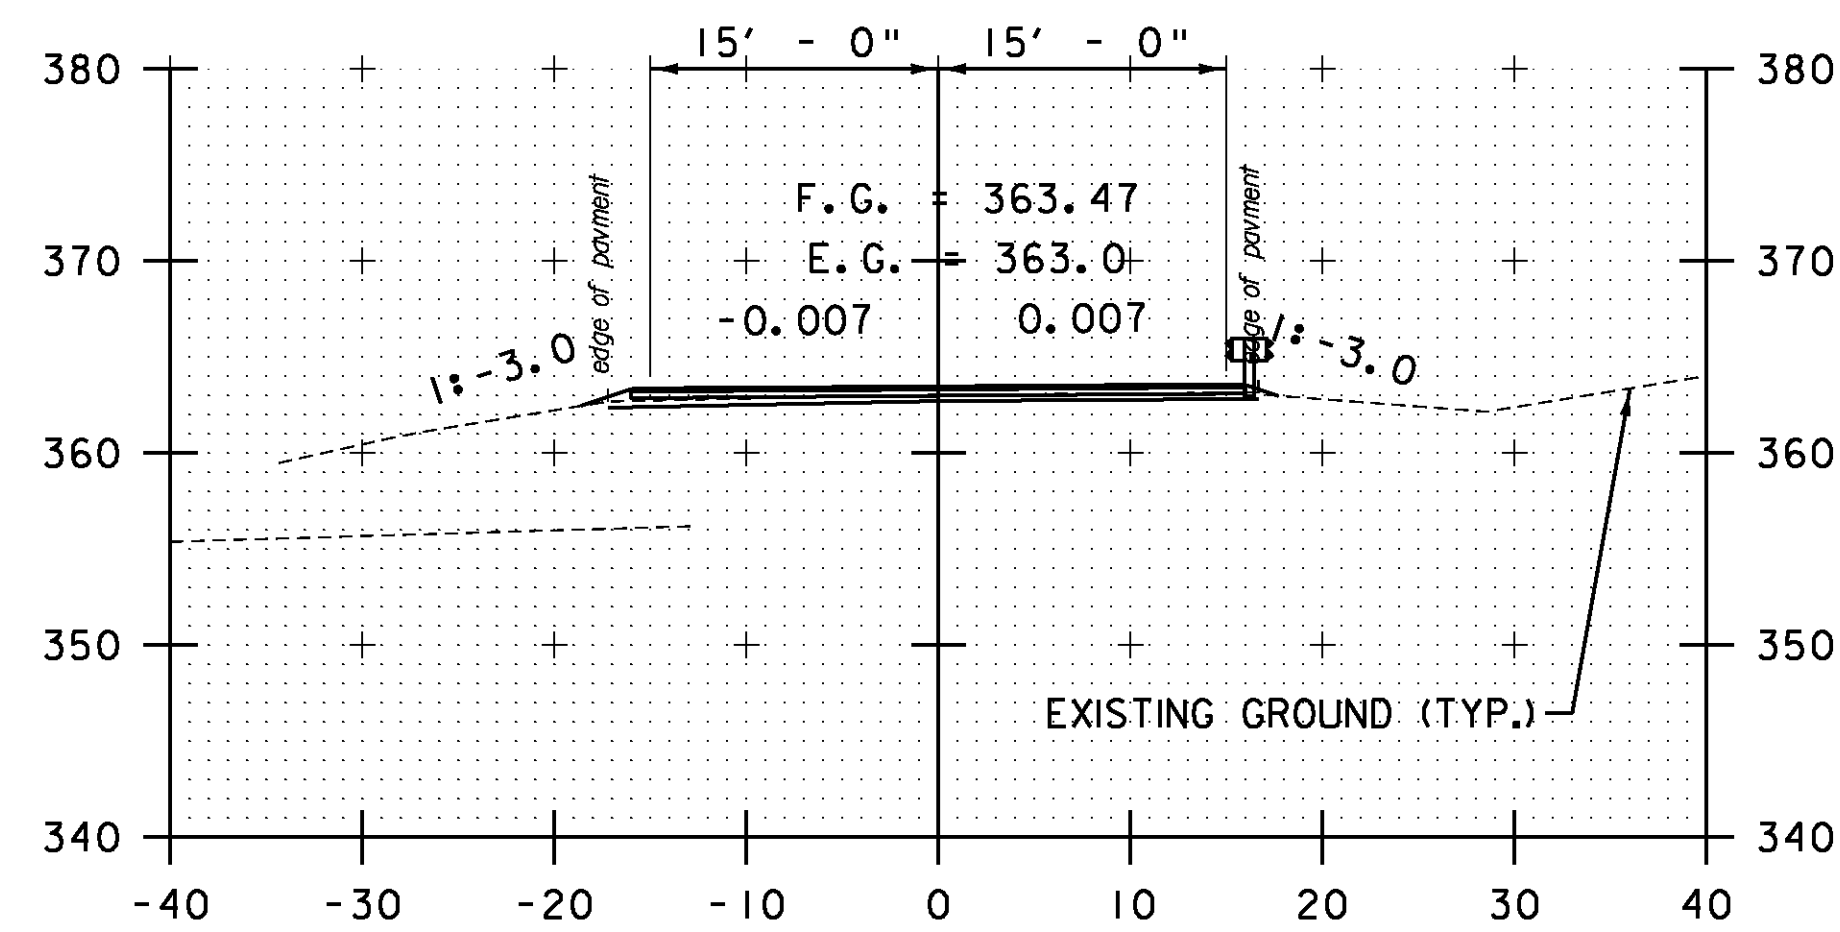

250+50

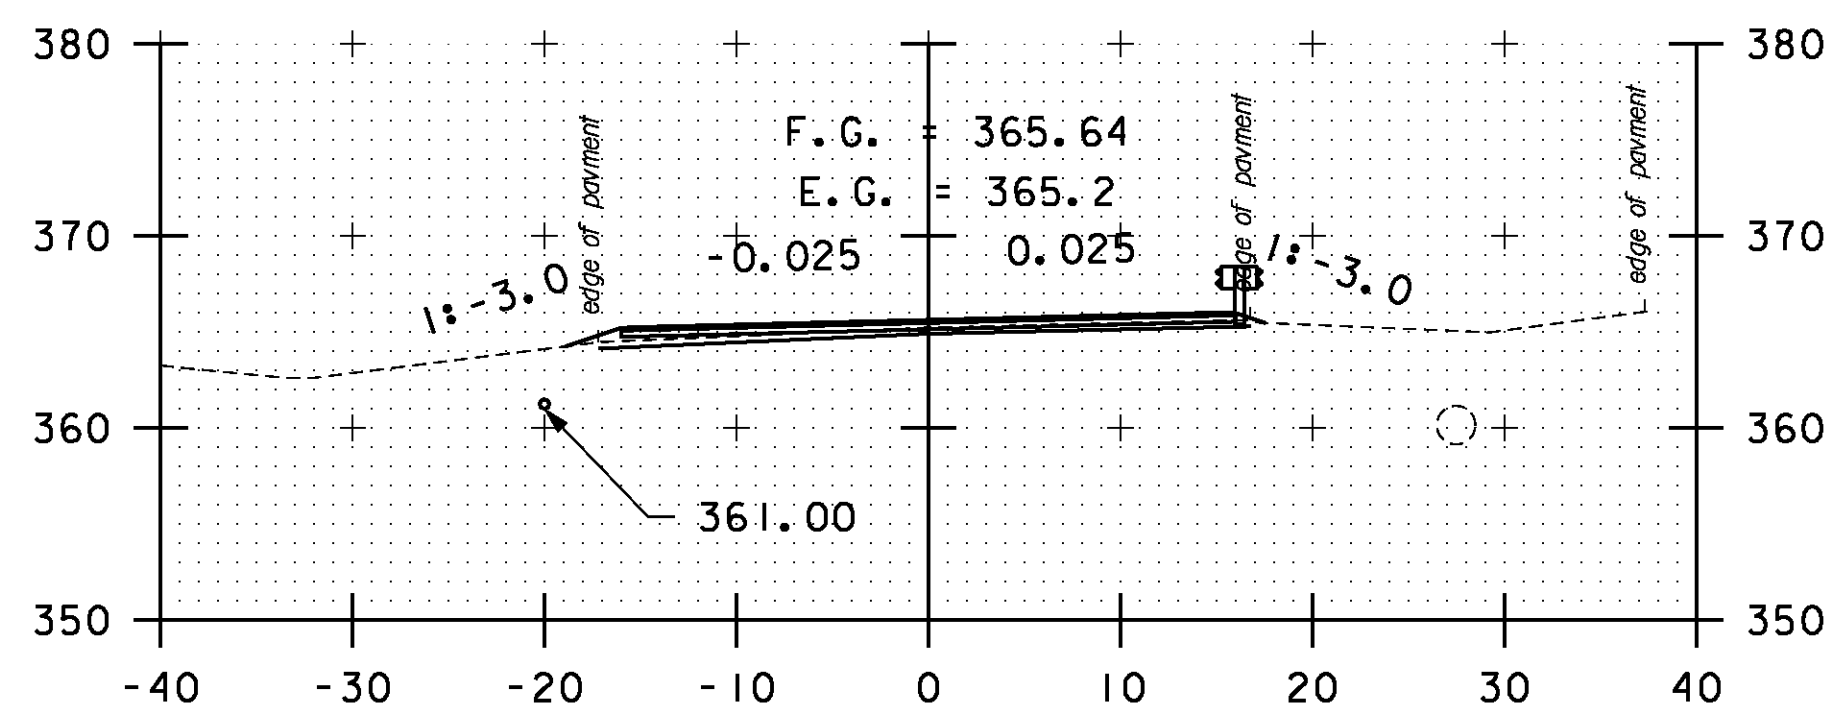

252+00

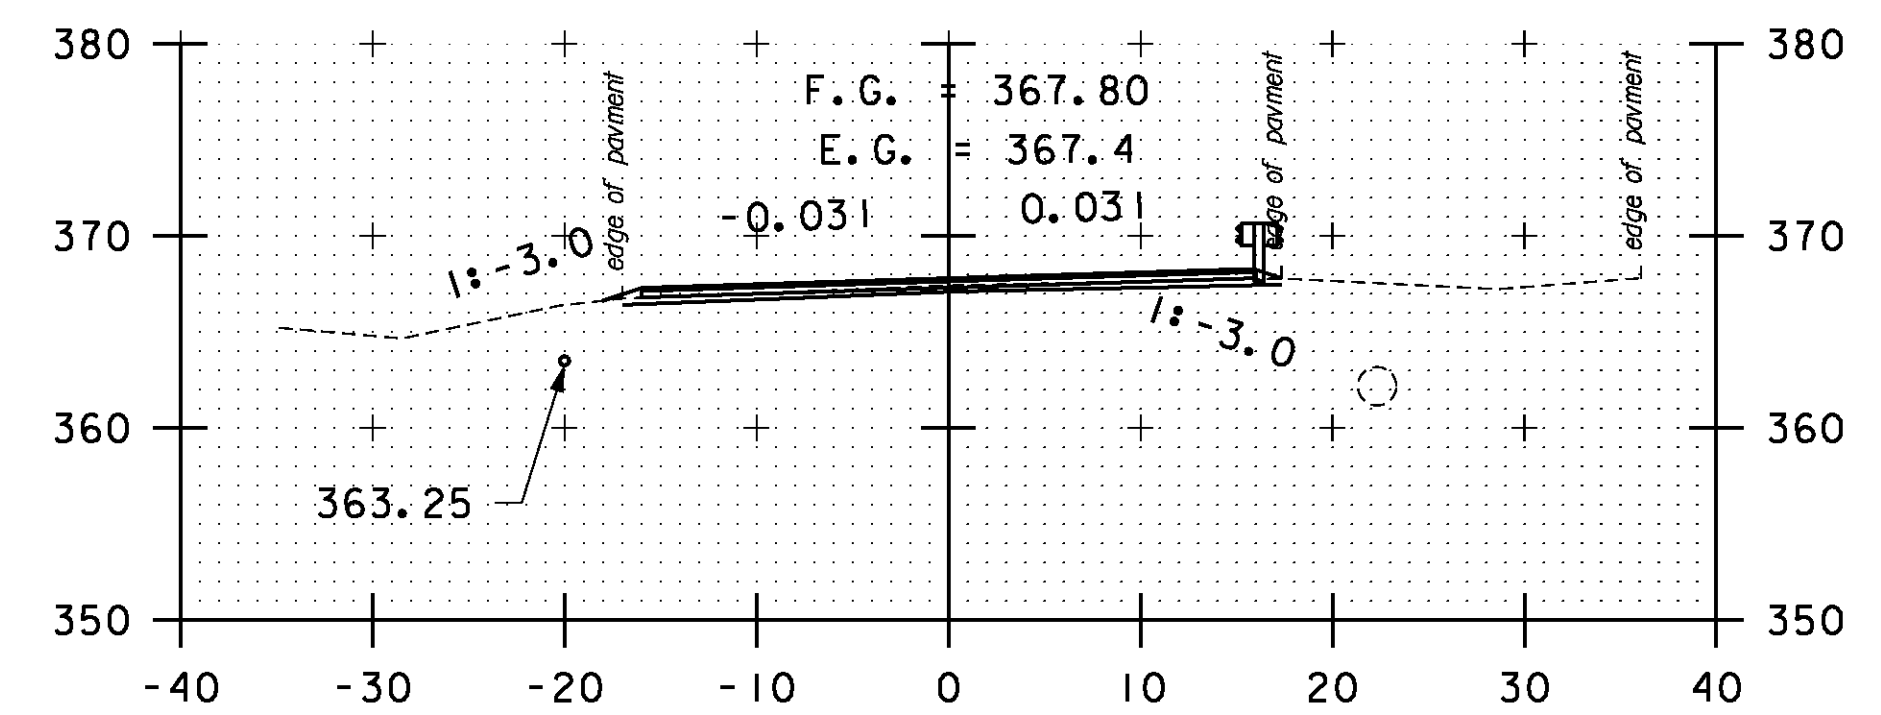

253+50

STA. 250+50 TO STA. 254+50

SCALE 1" = 10'-0"
0 10

CROSS SECTION SHEET 36

PROJECT NAME: BOLTON-WATERBURY

PROJECT NUMBER: STP 2709(1)

FILE NAME: p07C172.dgn

PROJECT LEADER: CDL

DESIGNED BY: BMB

PLOT FILE: p07C172_162.1

PLOT DATE: 4/16/2013

DRAWN BY: BMB

CHECKED BY: CDL

SHEET 162 OF 217