




256+00

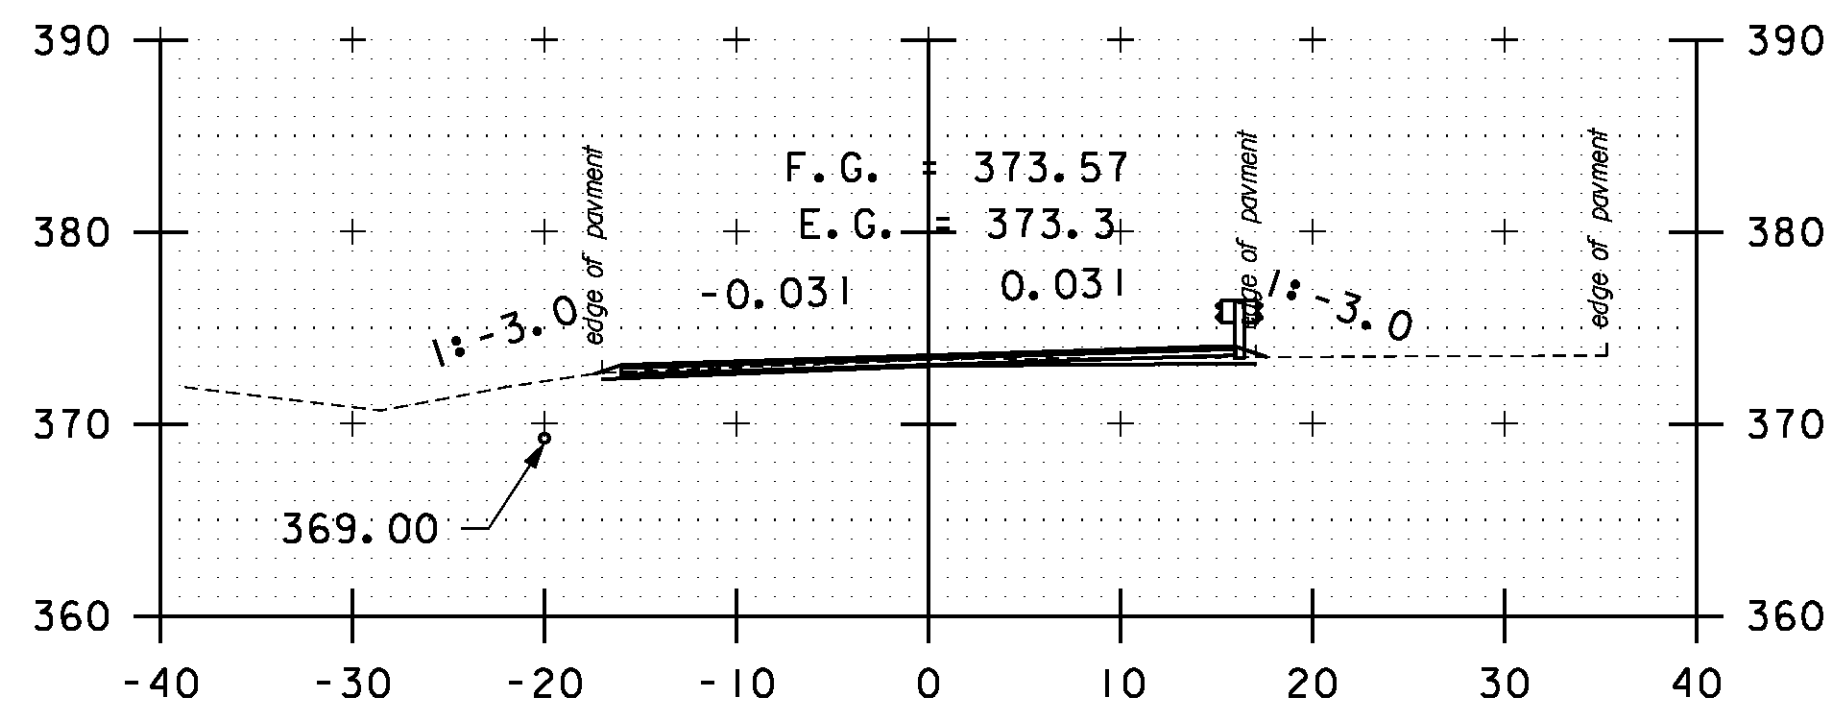


257+50

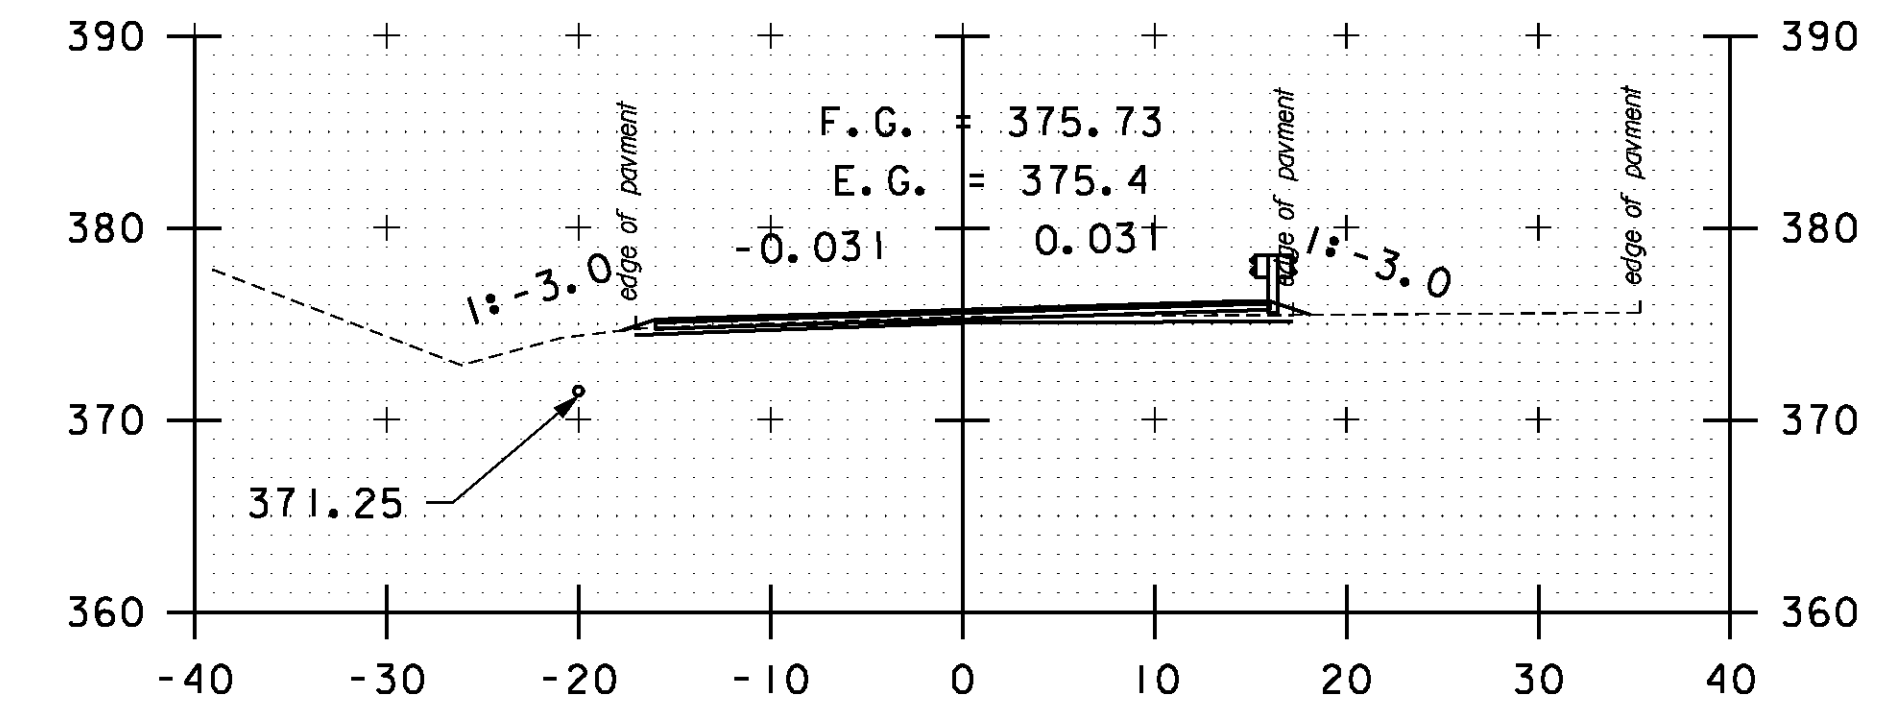


259+00

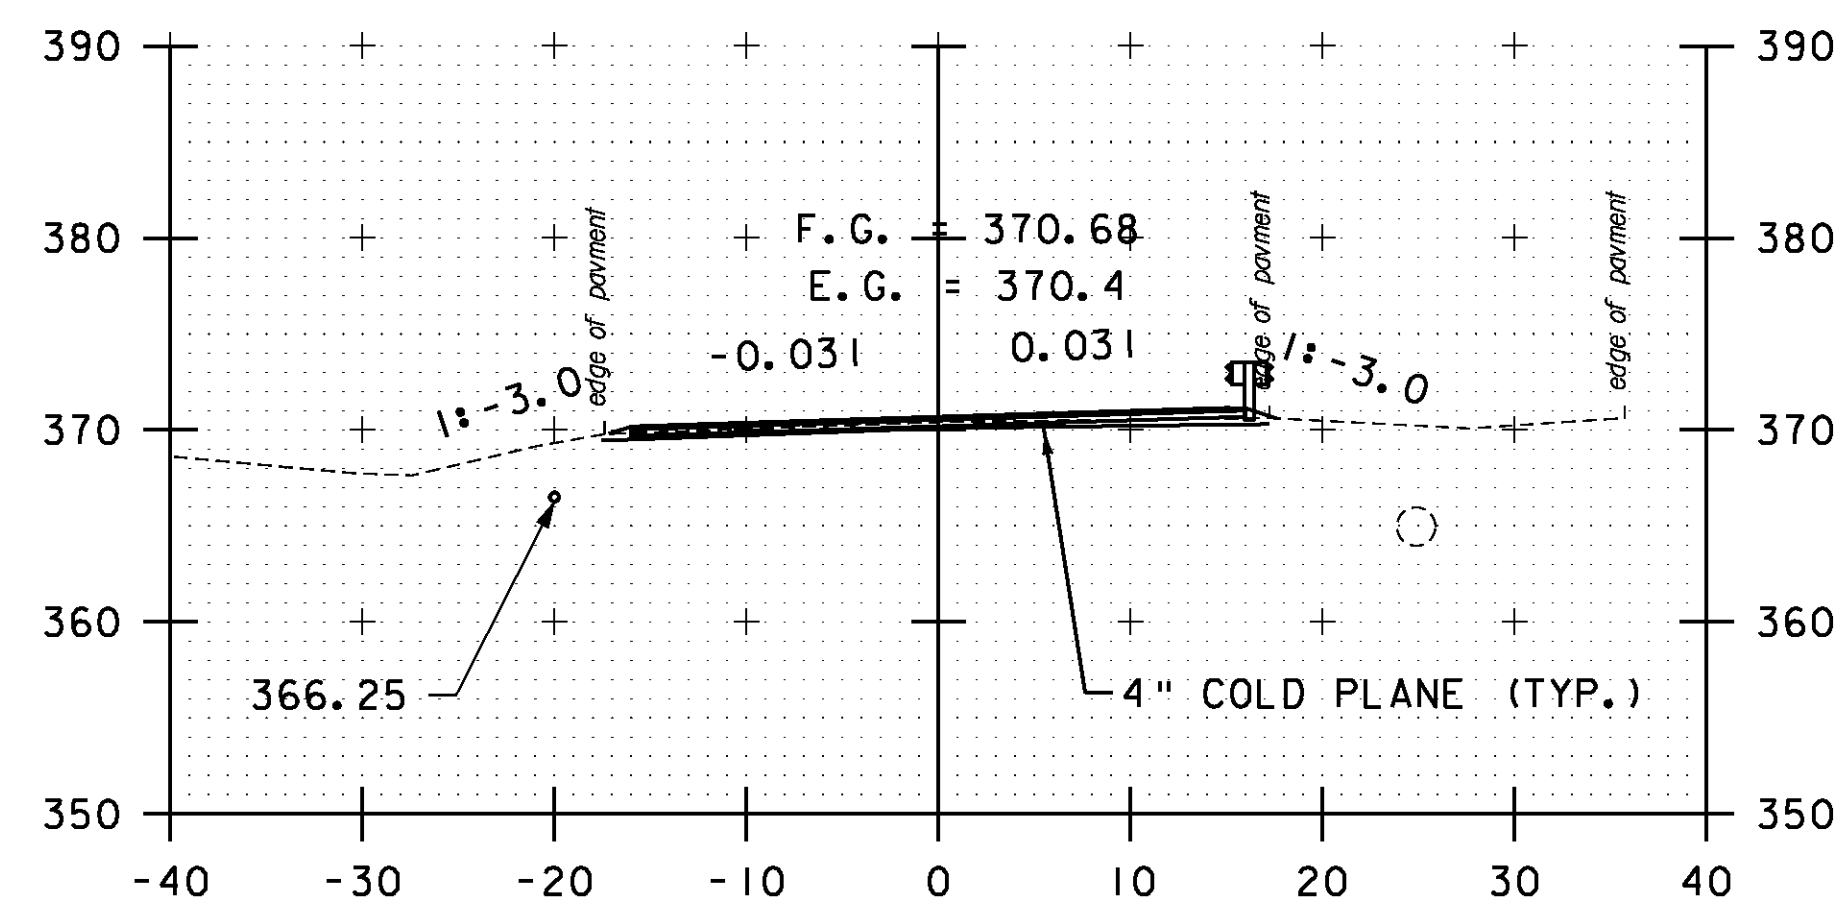


255+50

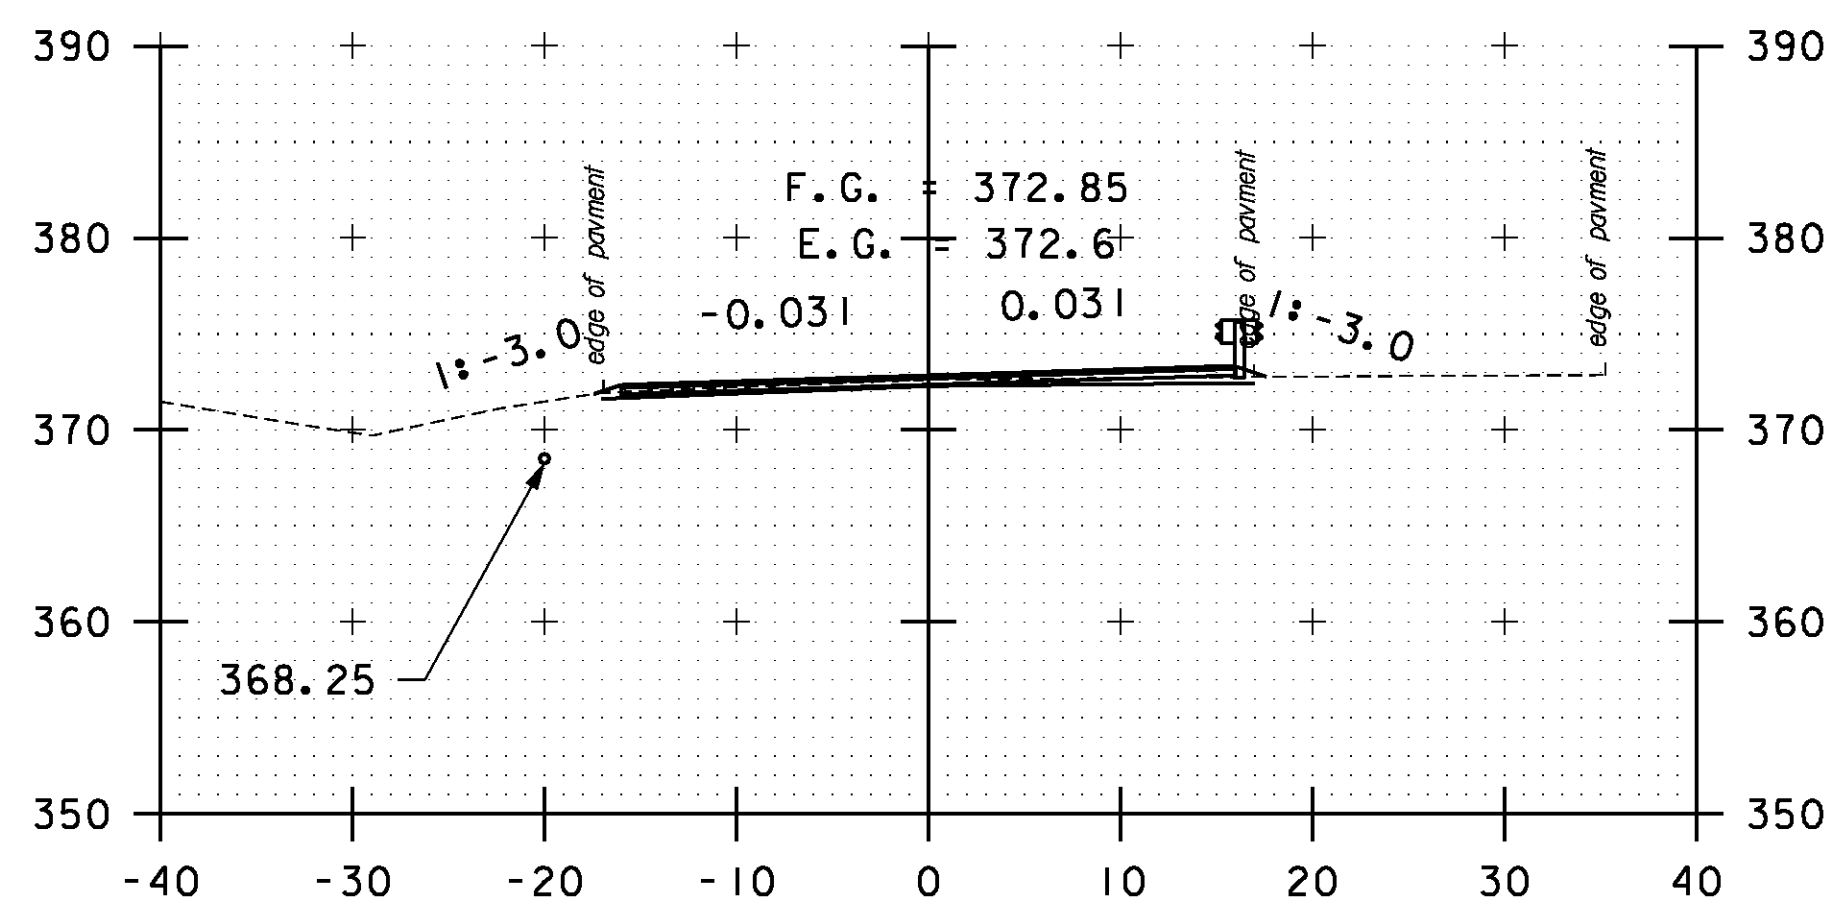


257+00

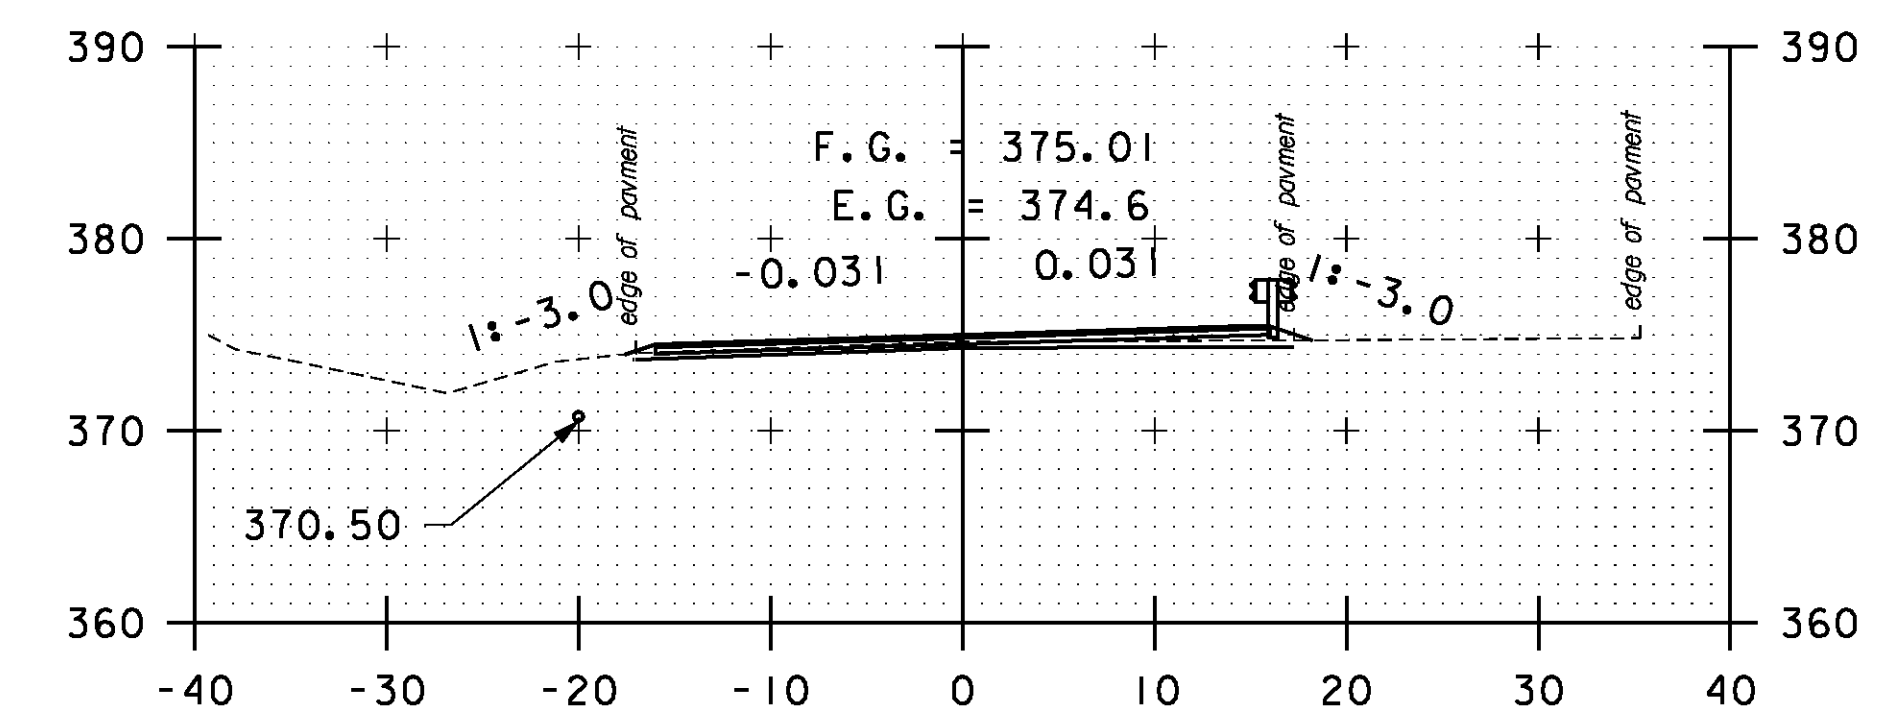


258+50

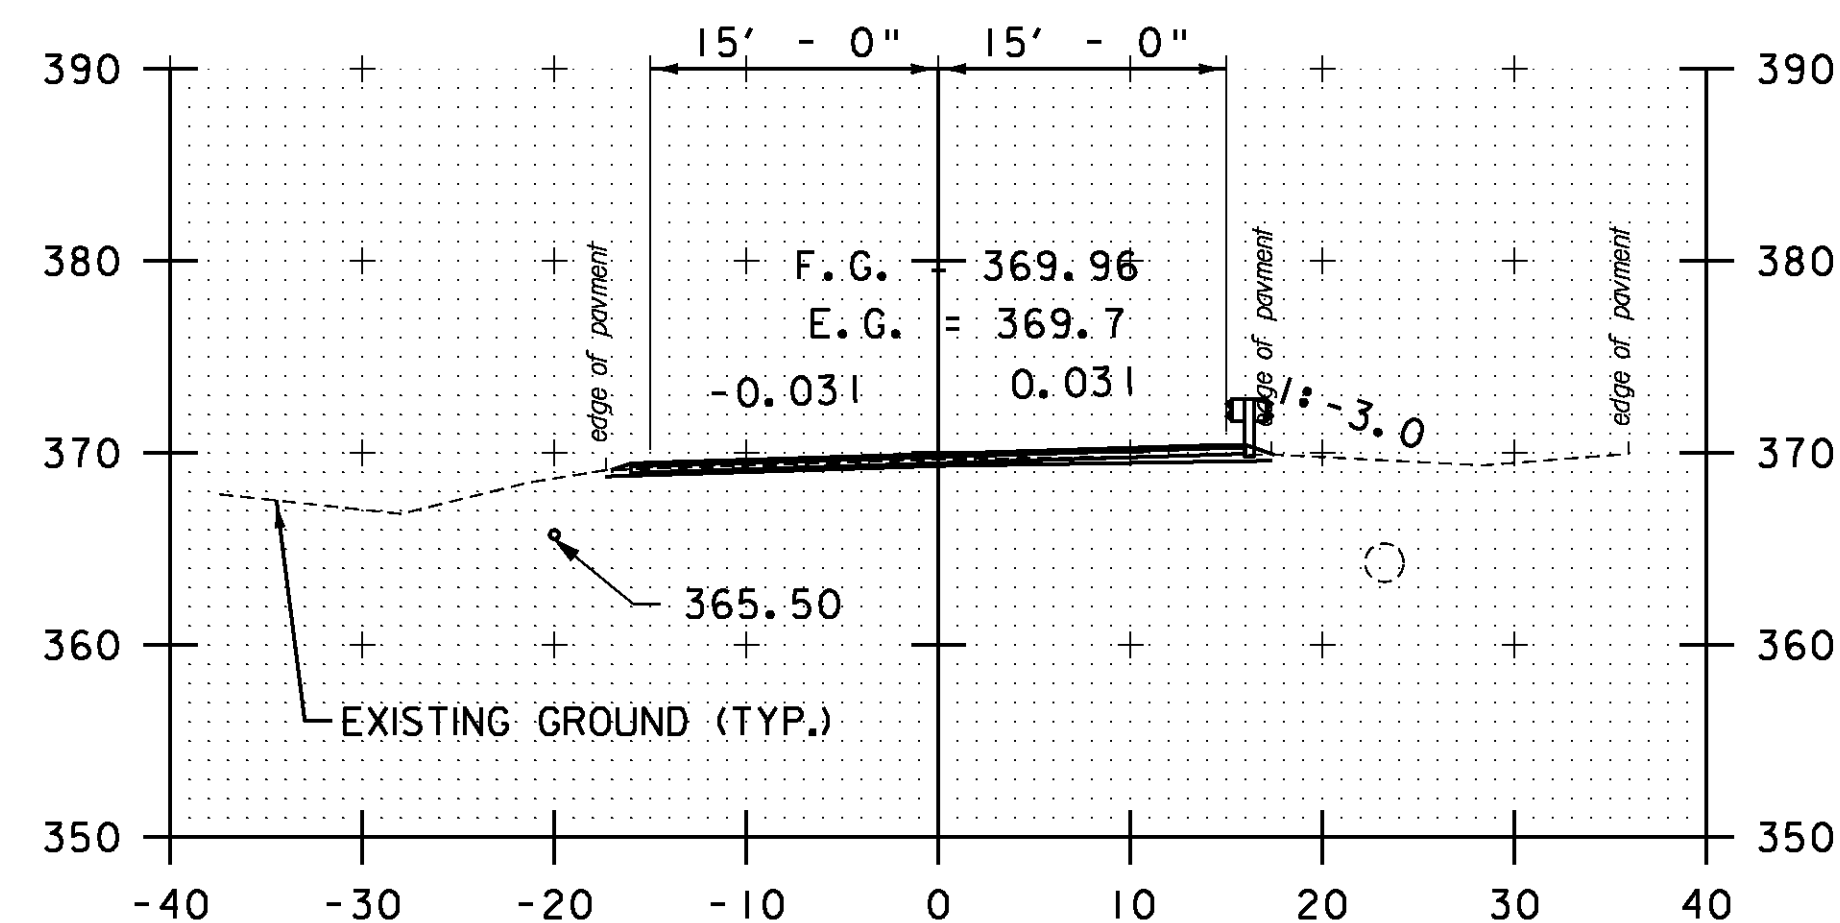

255+00

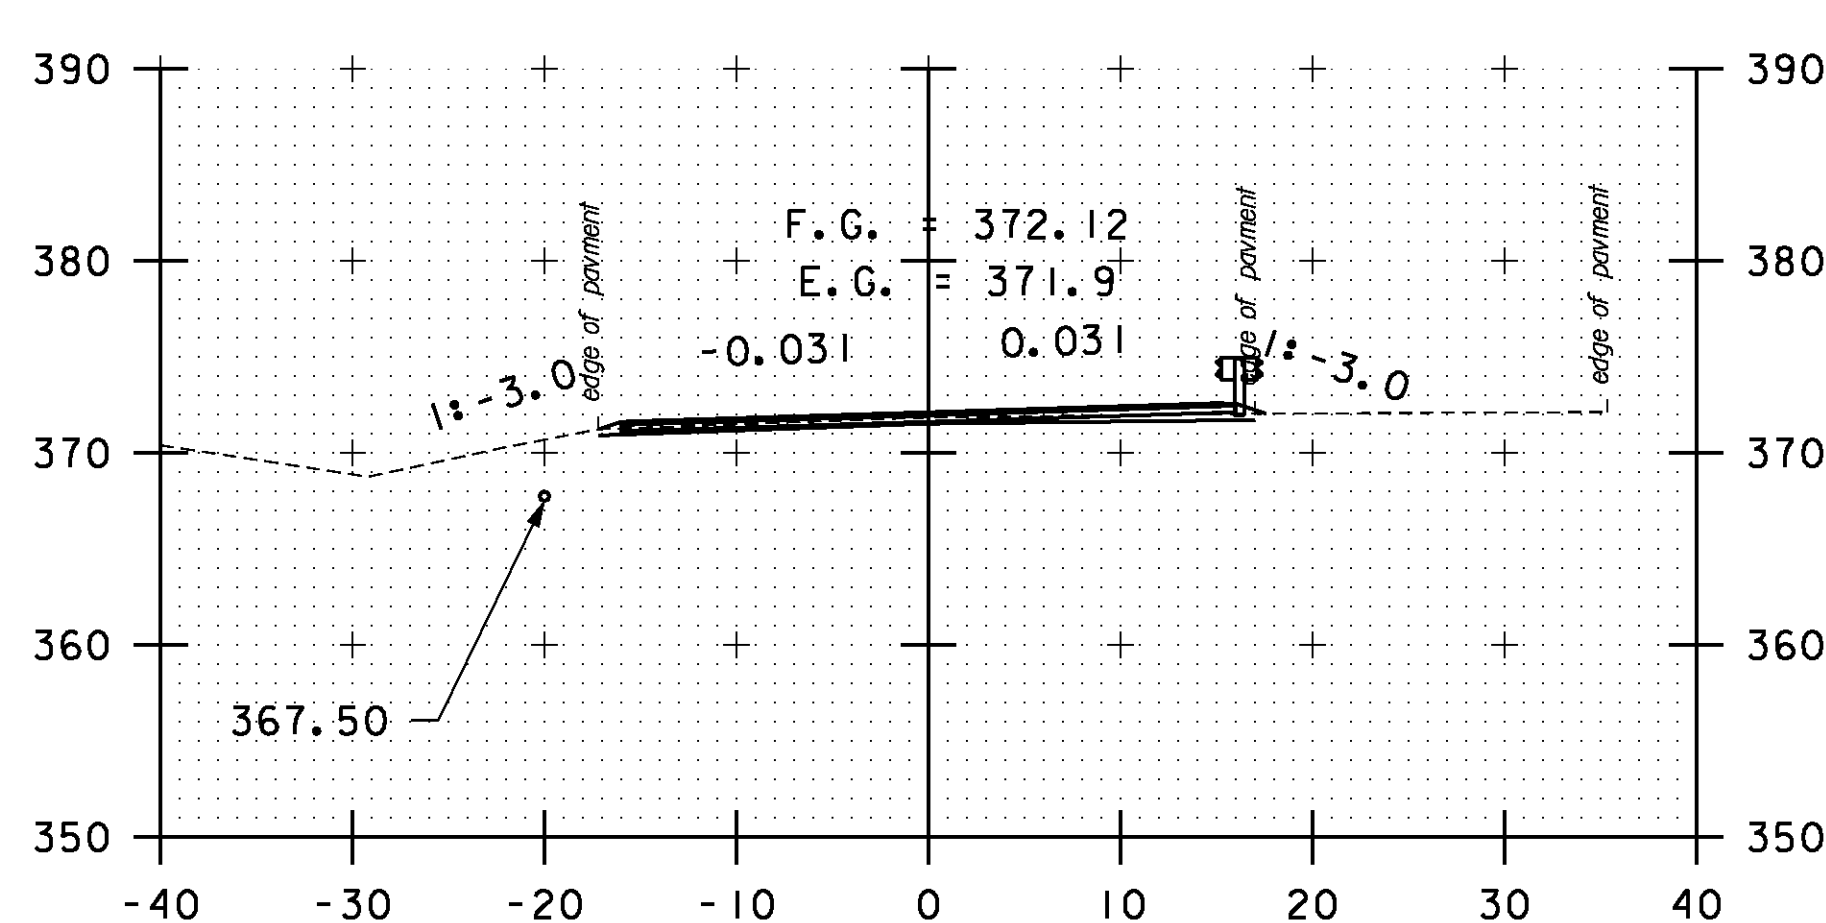


256+50

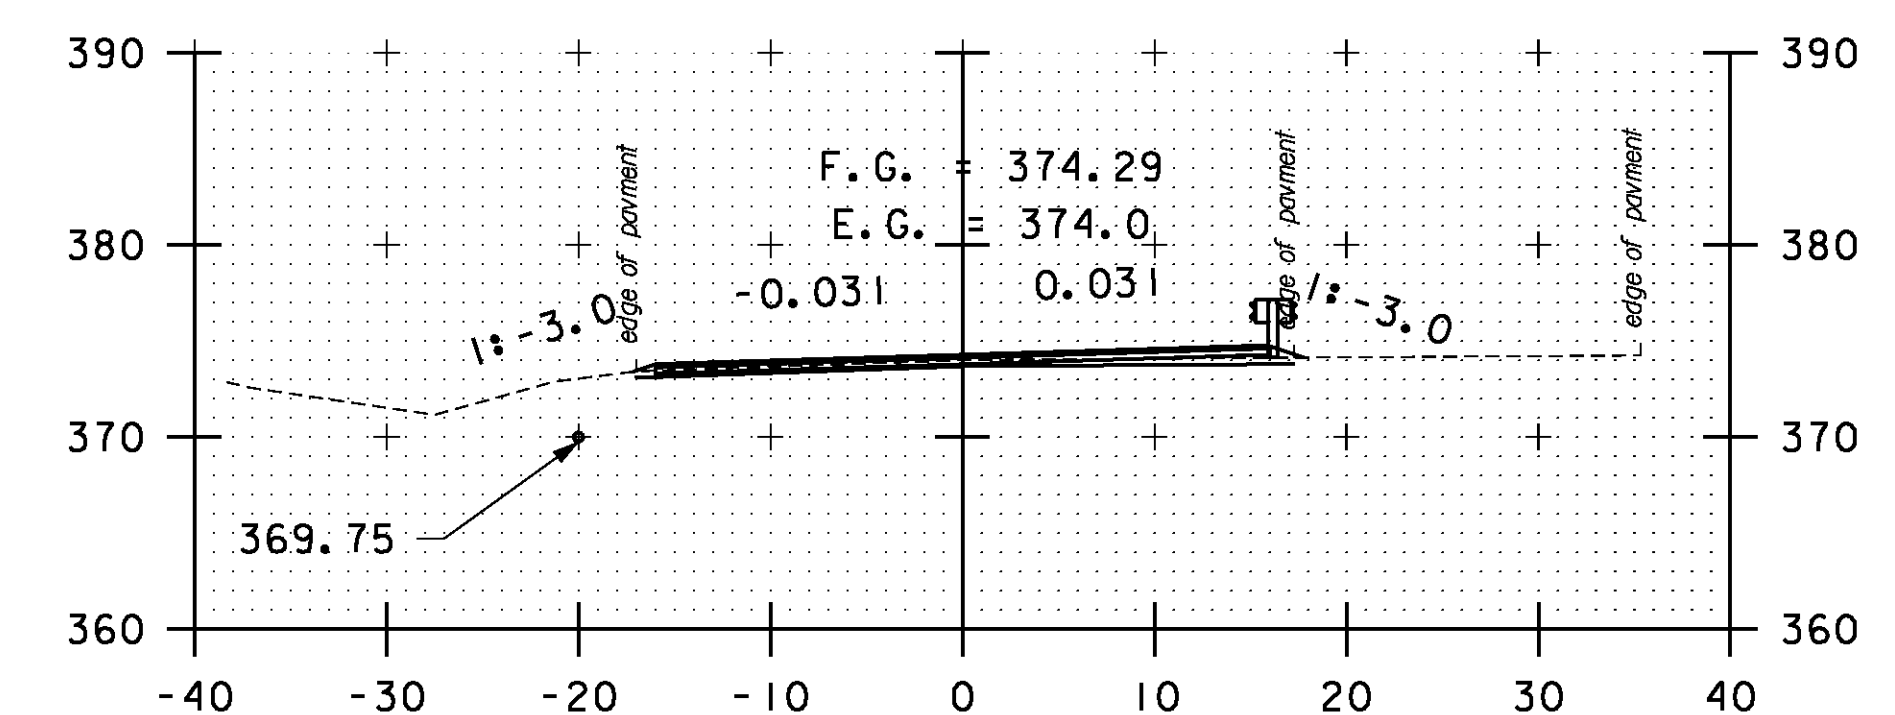

258+00

STA. 255+00 TO STA. 259+00

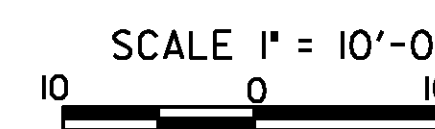

CROSS SECTION SHEET 37

PROJECT NAME: BOLTON-WATERBURY

PROJECT NUMBER: STP 2709(1)

FILE NAME: p07C172.dgn

PROJECT LEADER: CDL

DESIGNED BY: BMB

PLOT FILE: p07C172.163.1

PLOT DATE: 4/16/2013

DRAWN BY: BMB

CHECKED BY: CDL

SHEET 163 OF 217