




260+50

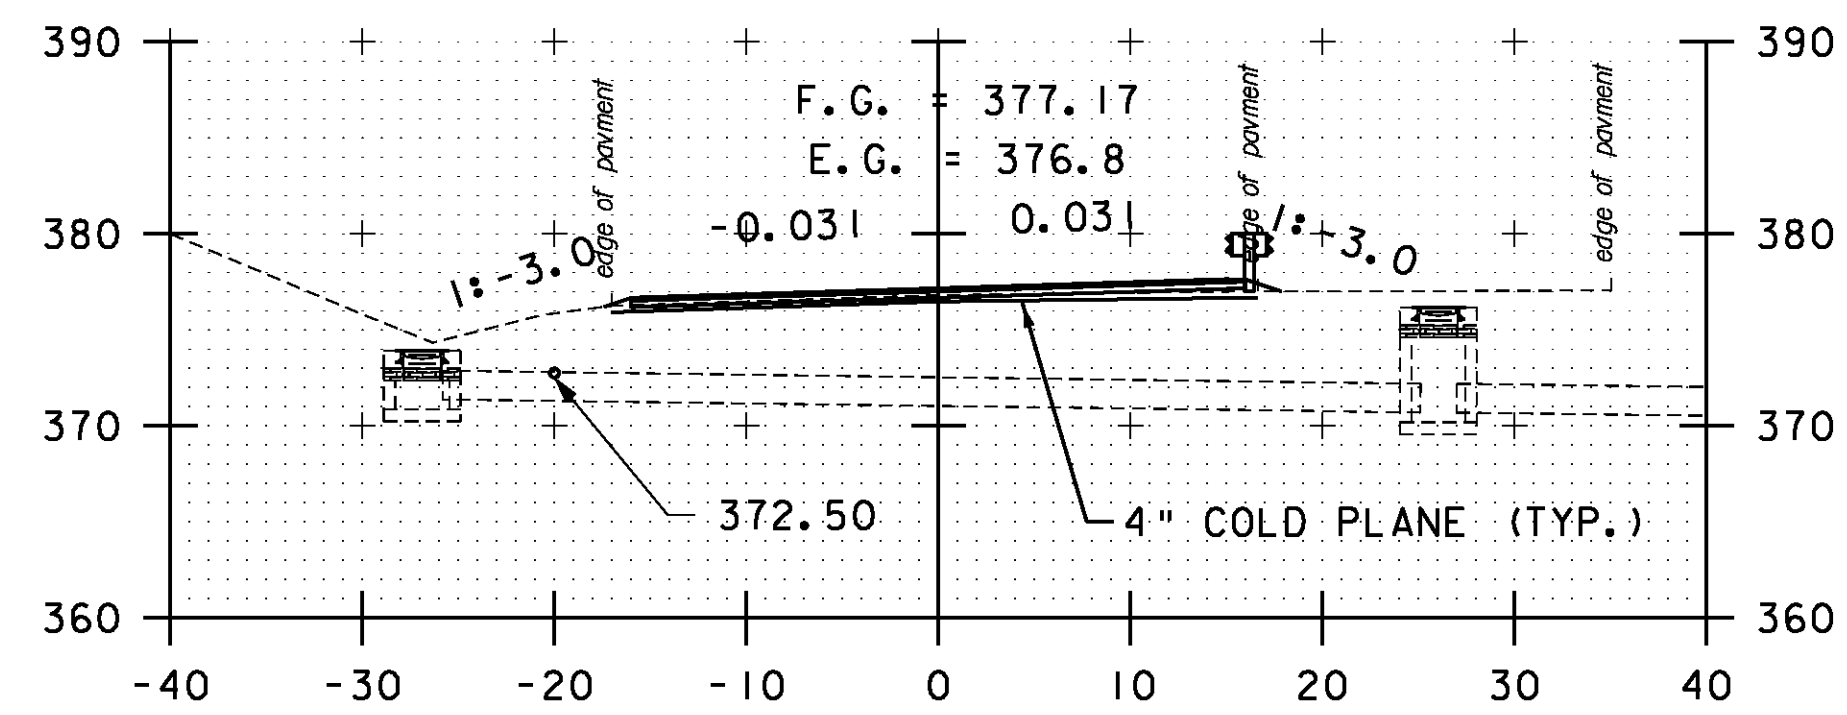


260+00

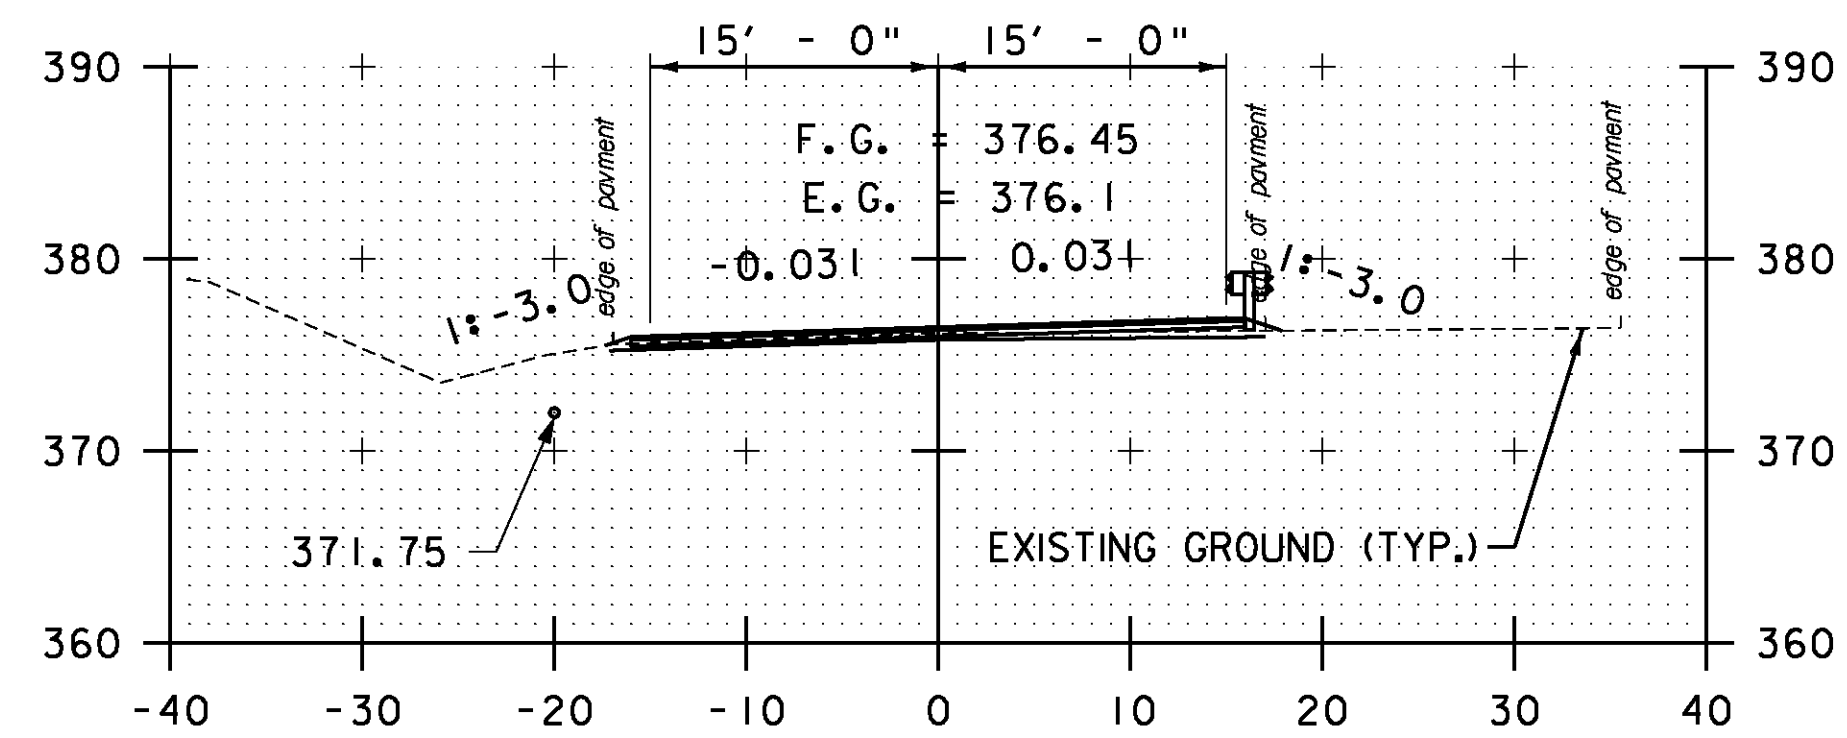


259+50

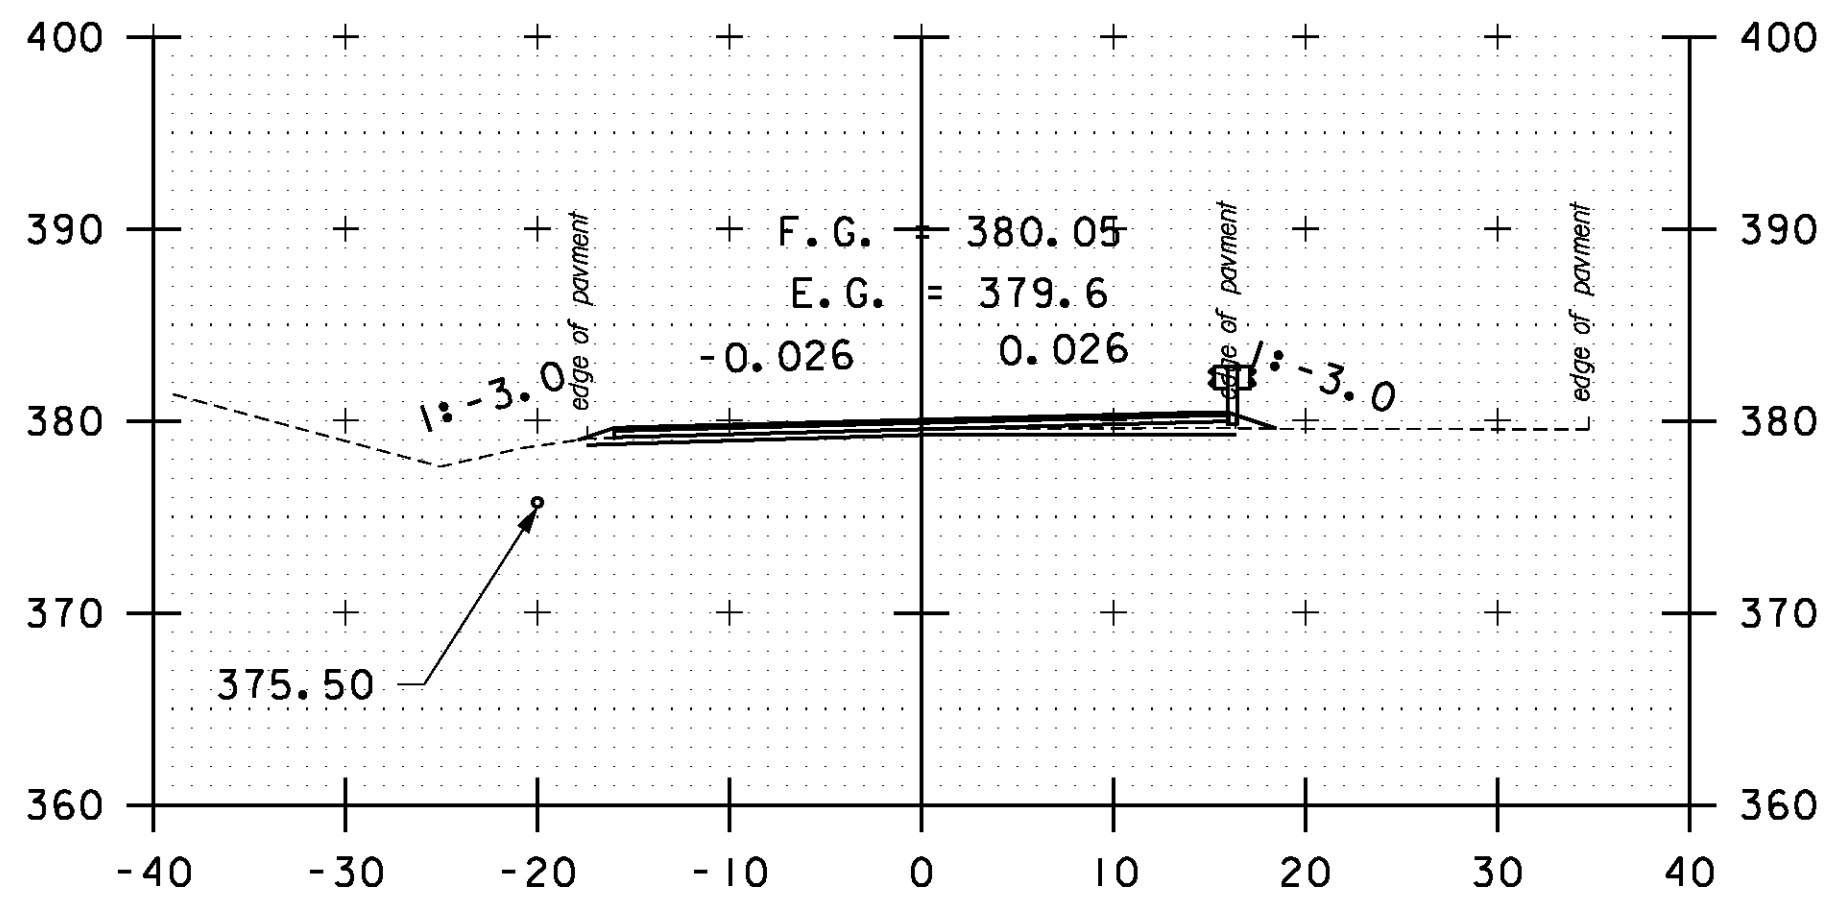


262+00

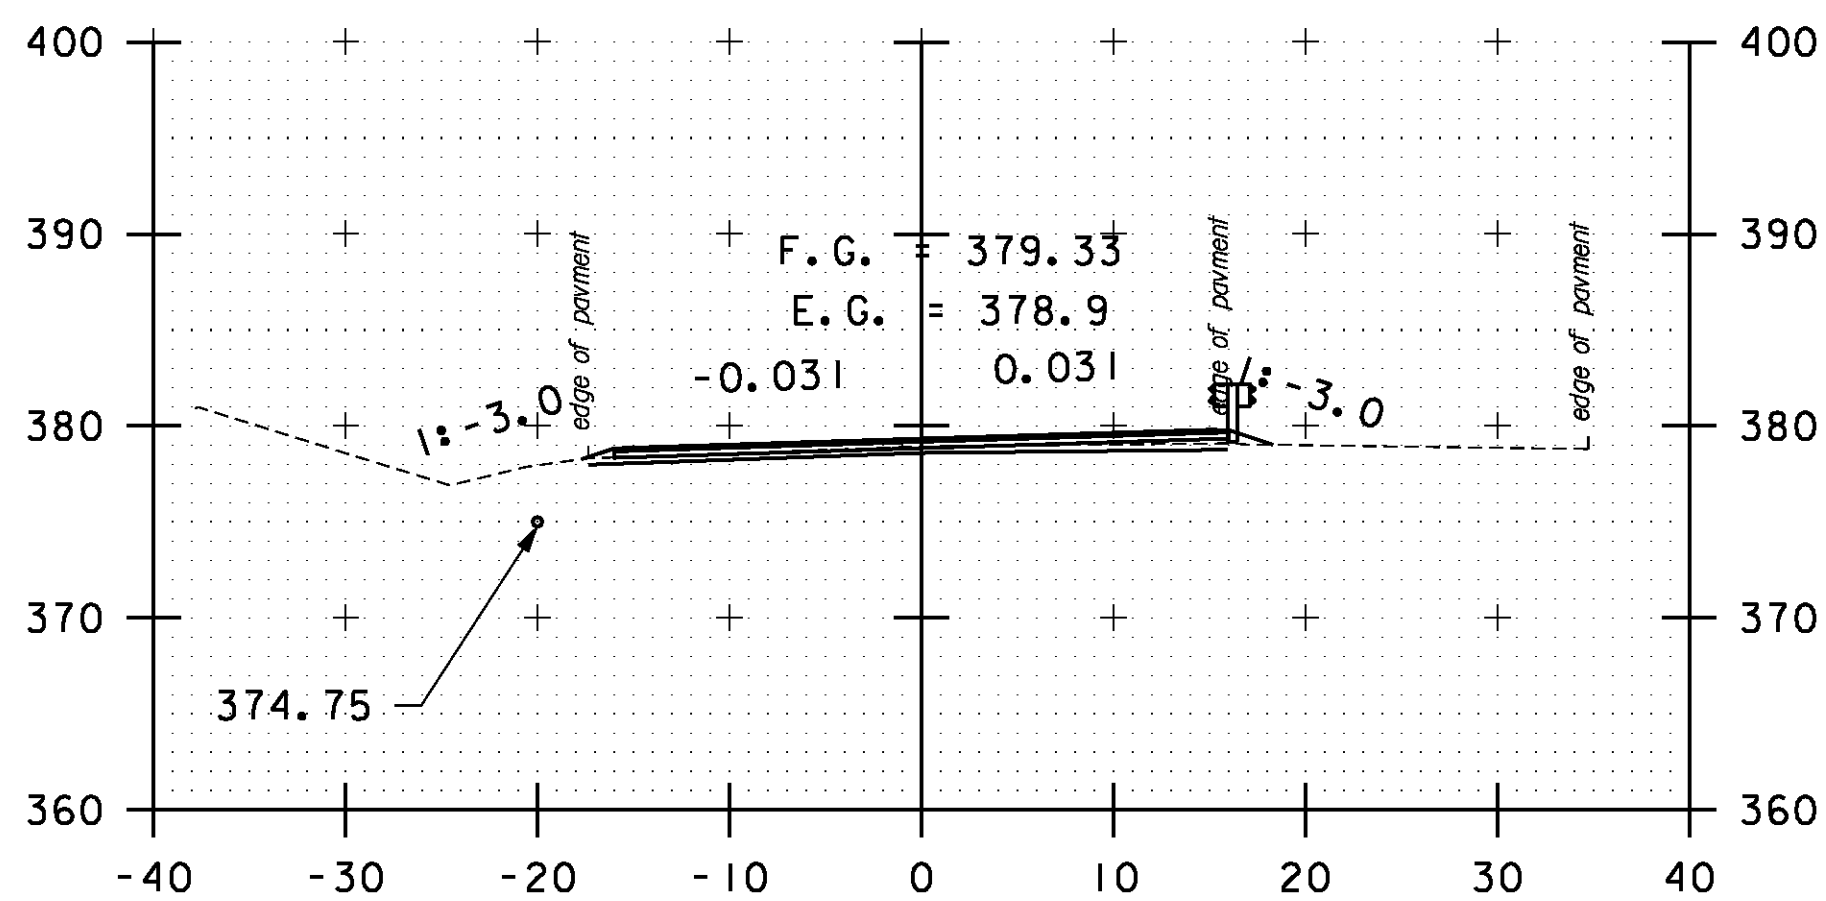


261+50

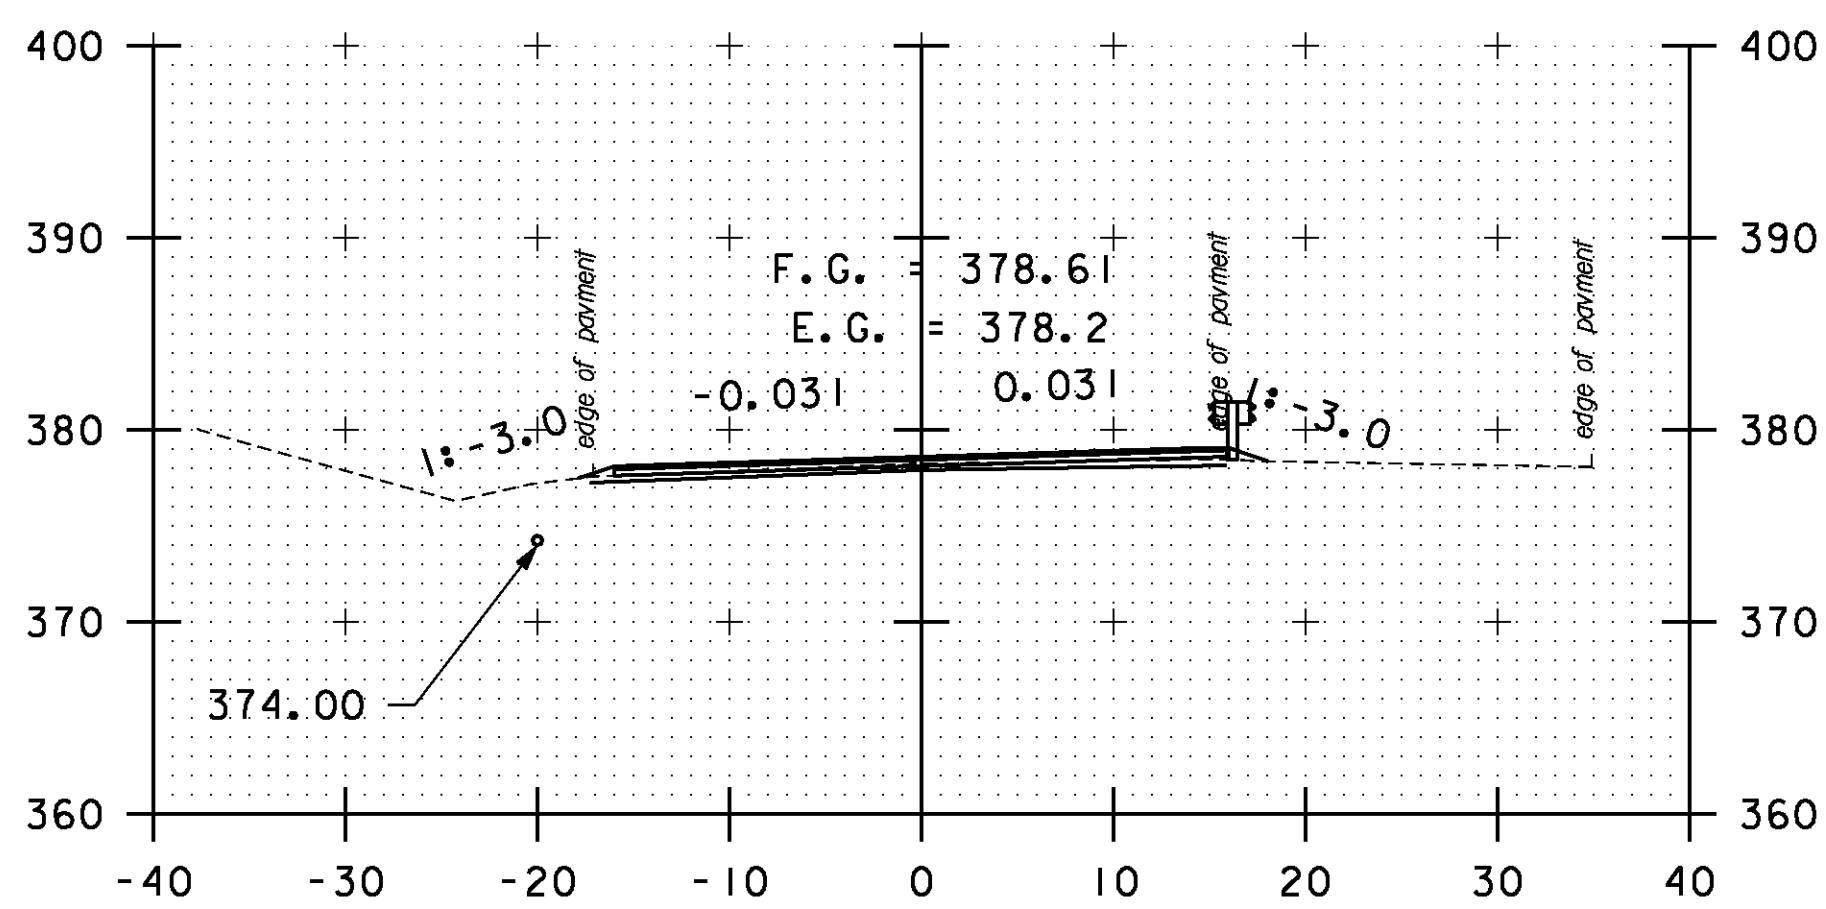


261+00

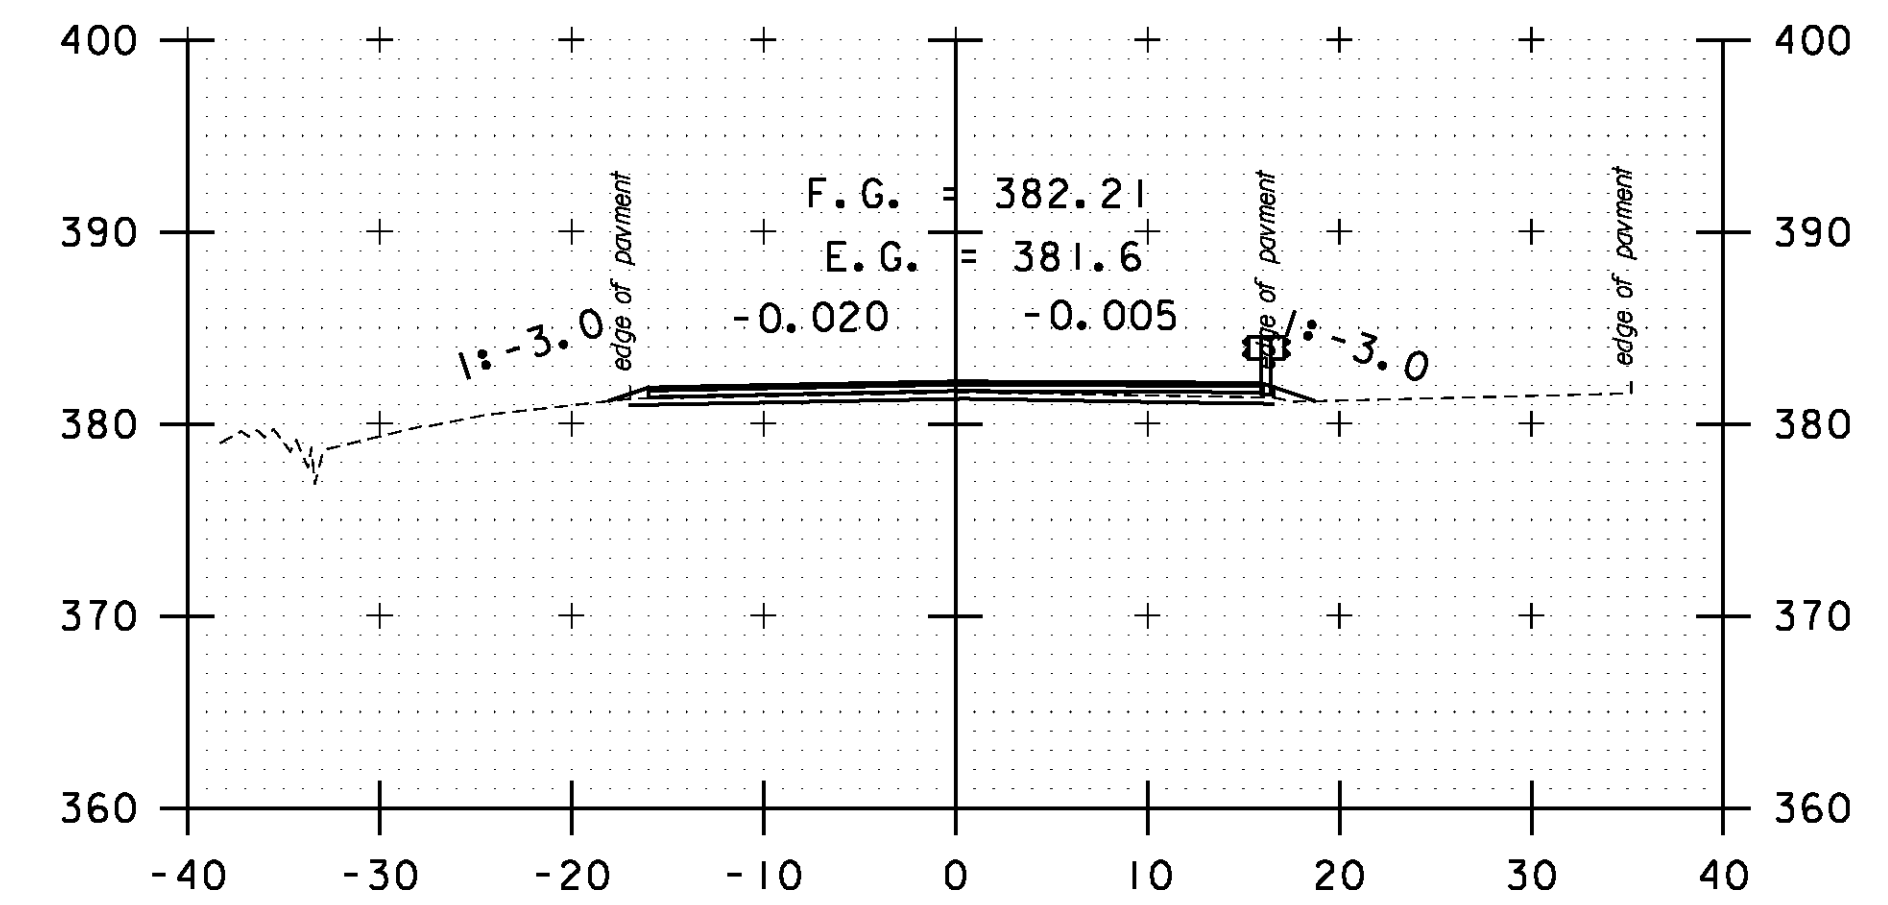

263+50

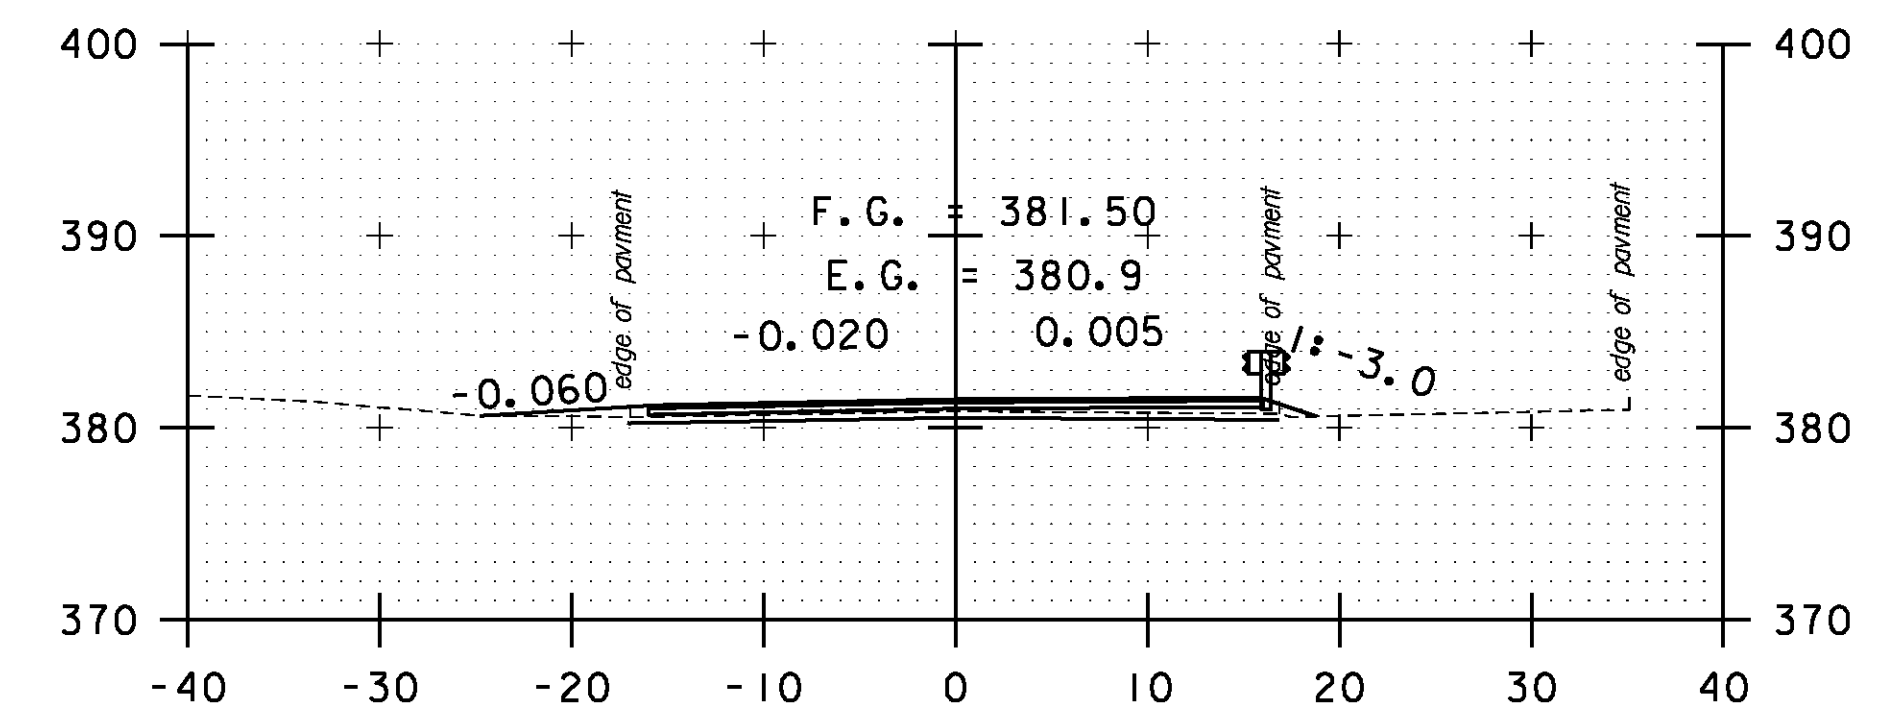

DRIVE LT
263+00

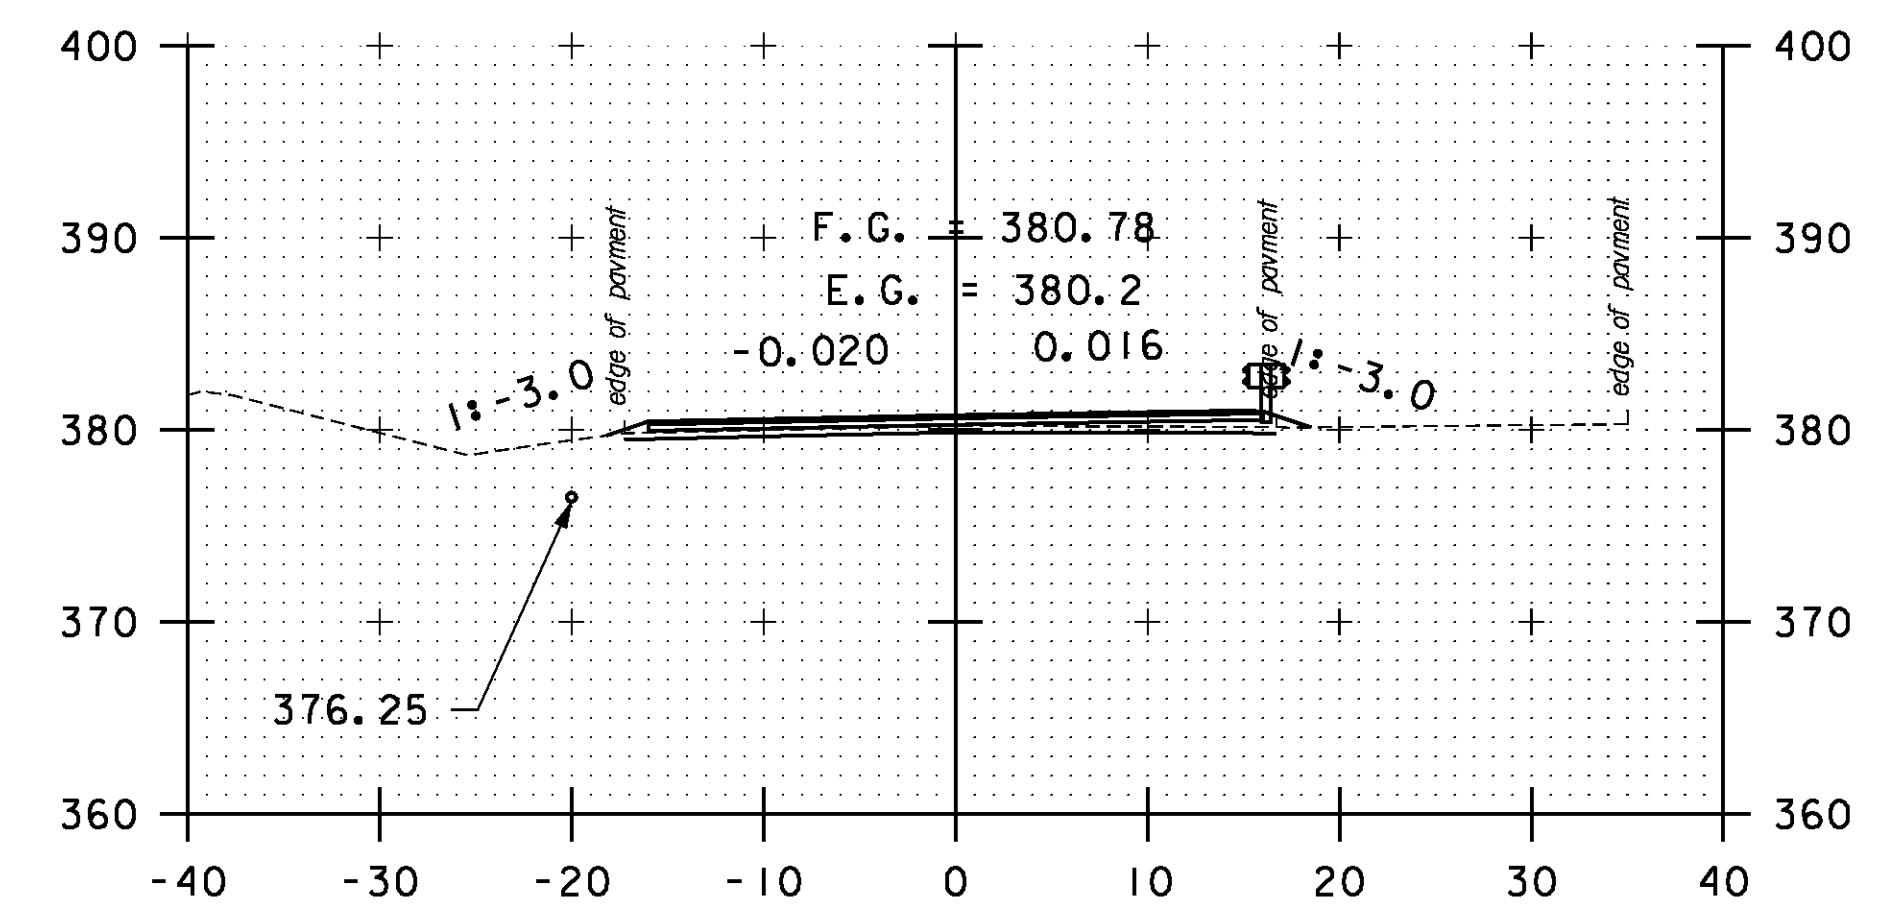

262+50

STA. 259+50 TO STA. 263+50

SCALE 1" = 10'-0"
10 0 10

CROSS SECTION SHEET 38

PROJECT NAME: BOLTON-WATERBURY

PROJECT NUMBER: STP 2709(I)

FILE NAME: p07C172.dgn

PROJECT LEADER: CDL

DESIGNED BY: BMB

PLOT FILE: p07C172.164.1

PLOT DATE: 4/16/2013

DRAWN BY: BMB

CHECKED BY: CDL

SHEET 164 OF 217