




265+00

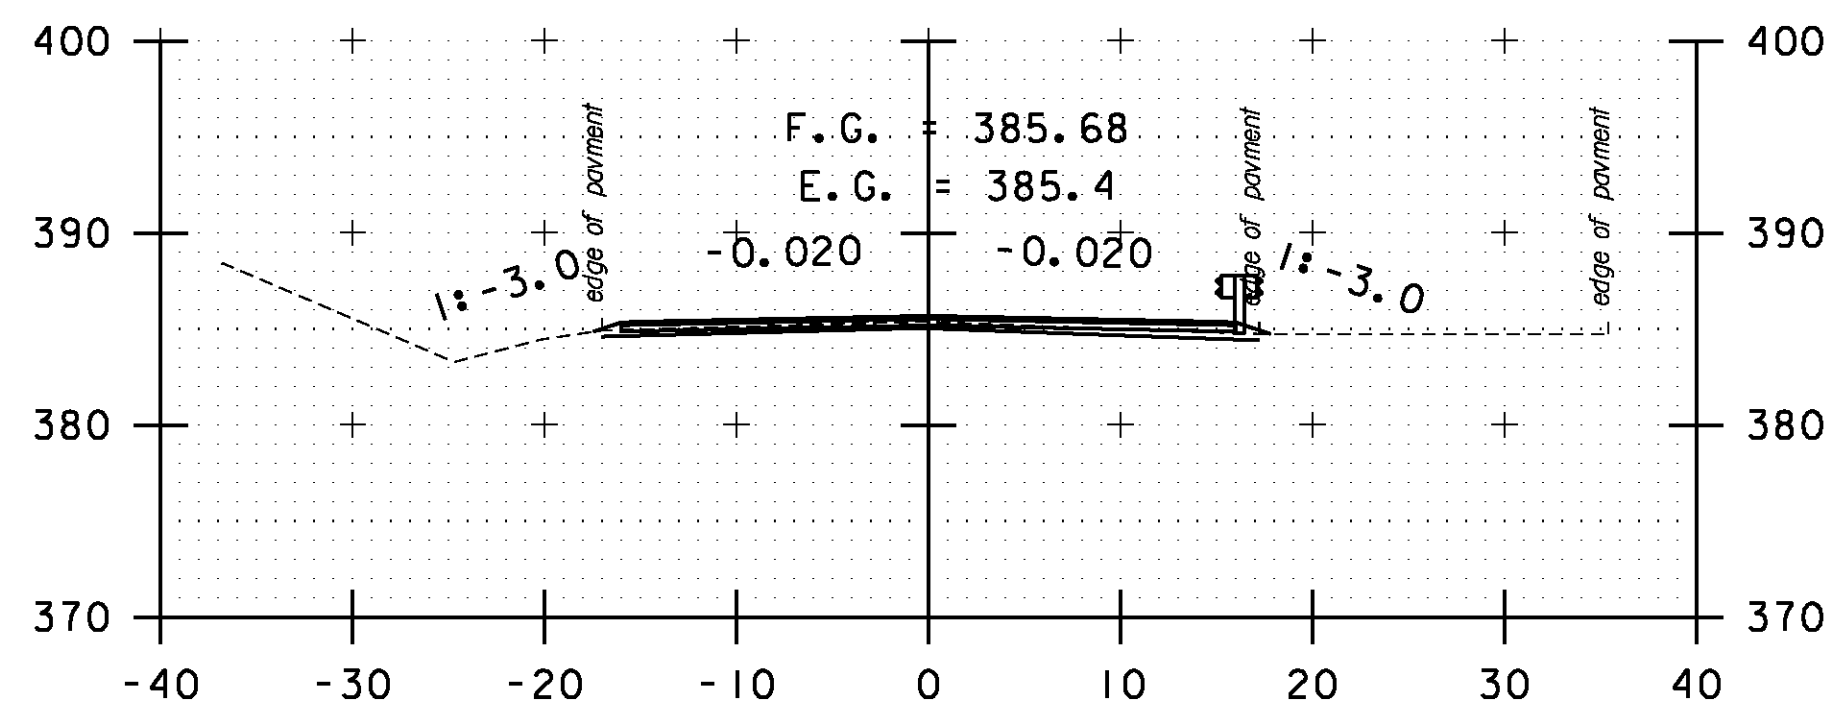


266+50

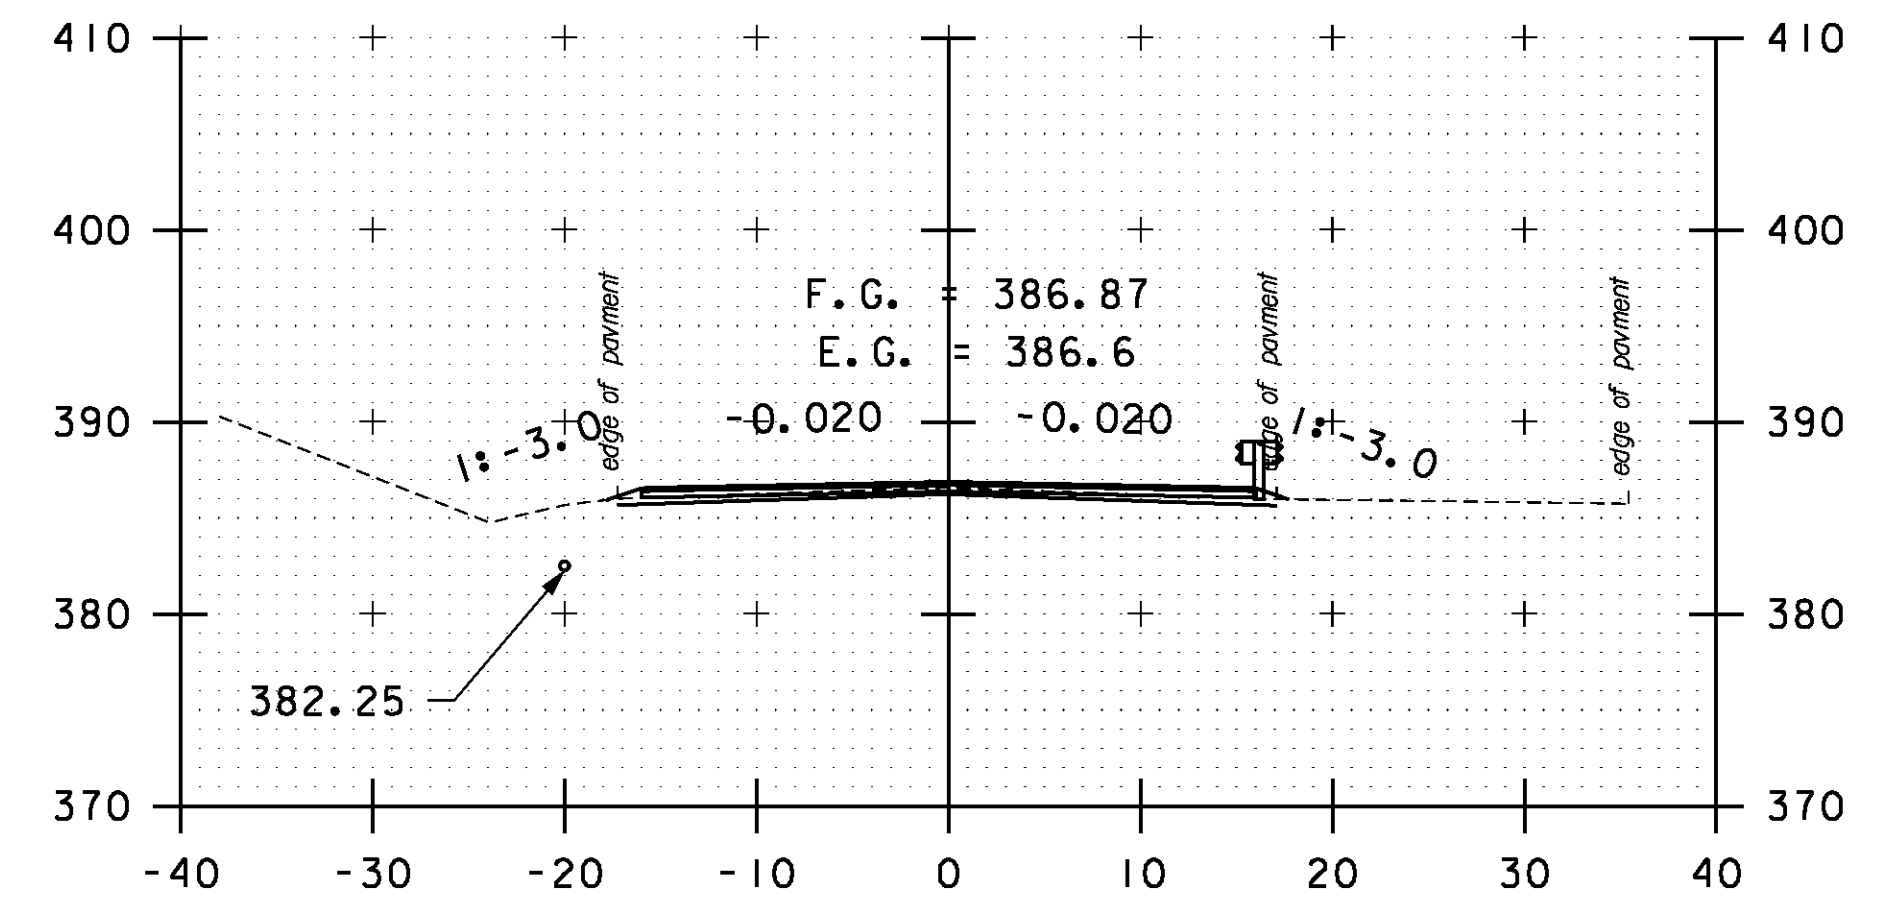


268+00

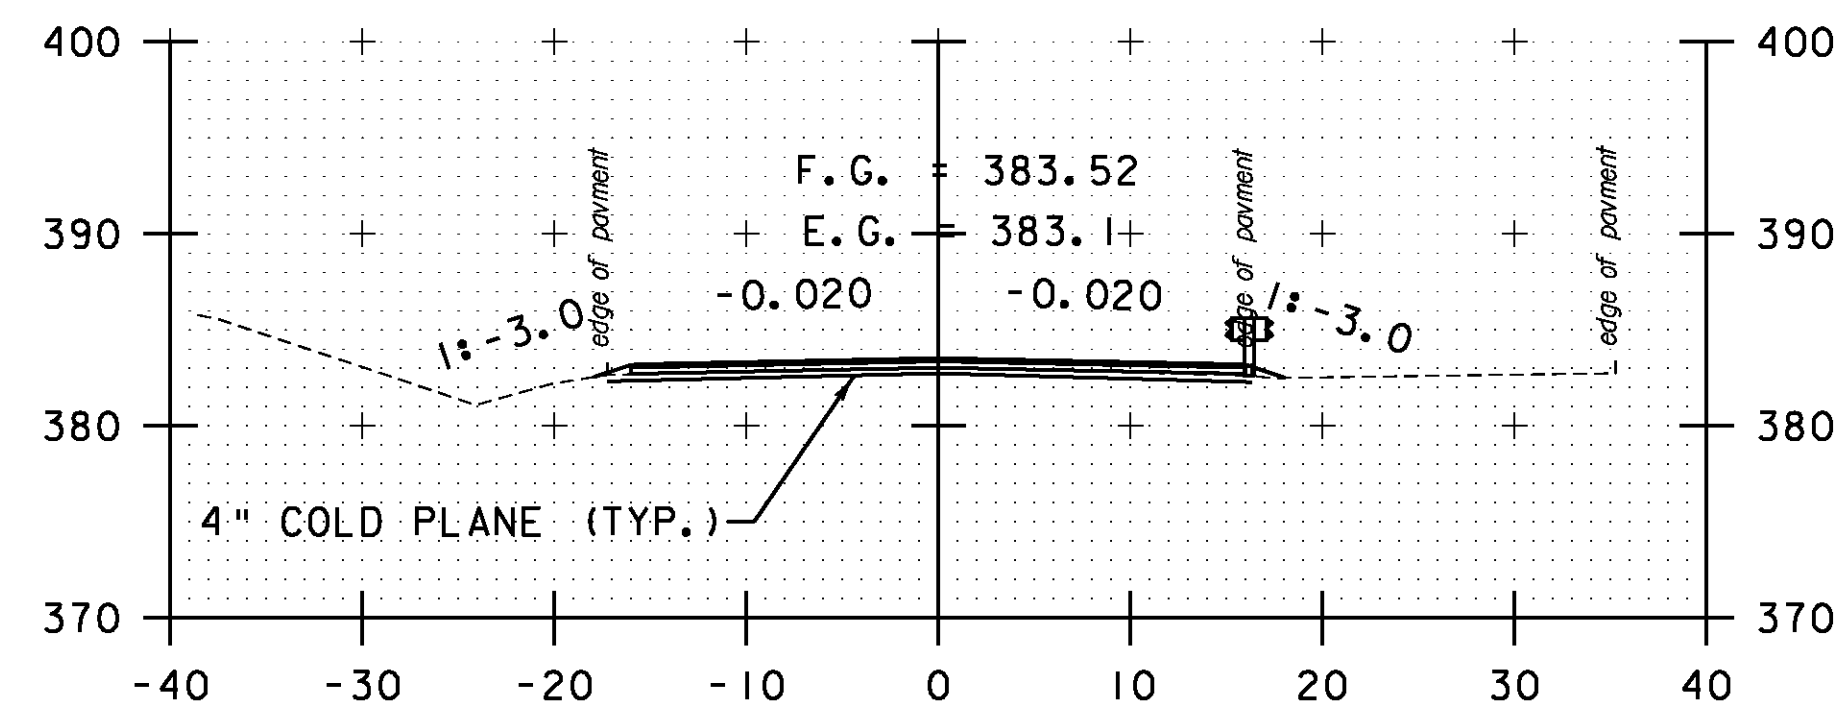


264+50

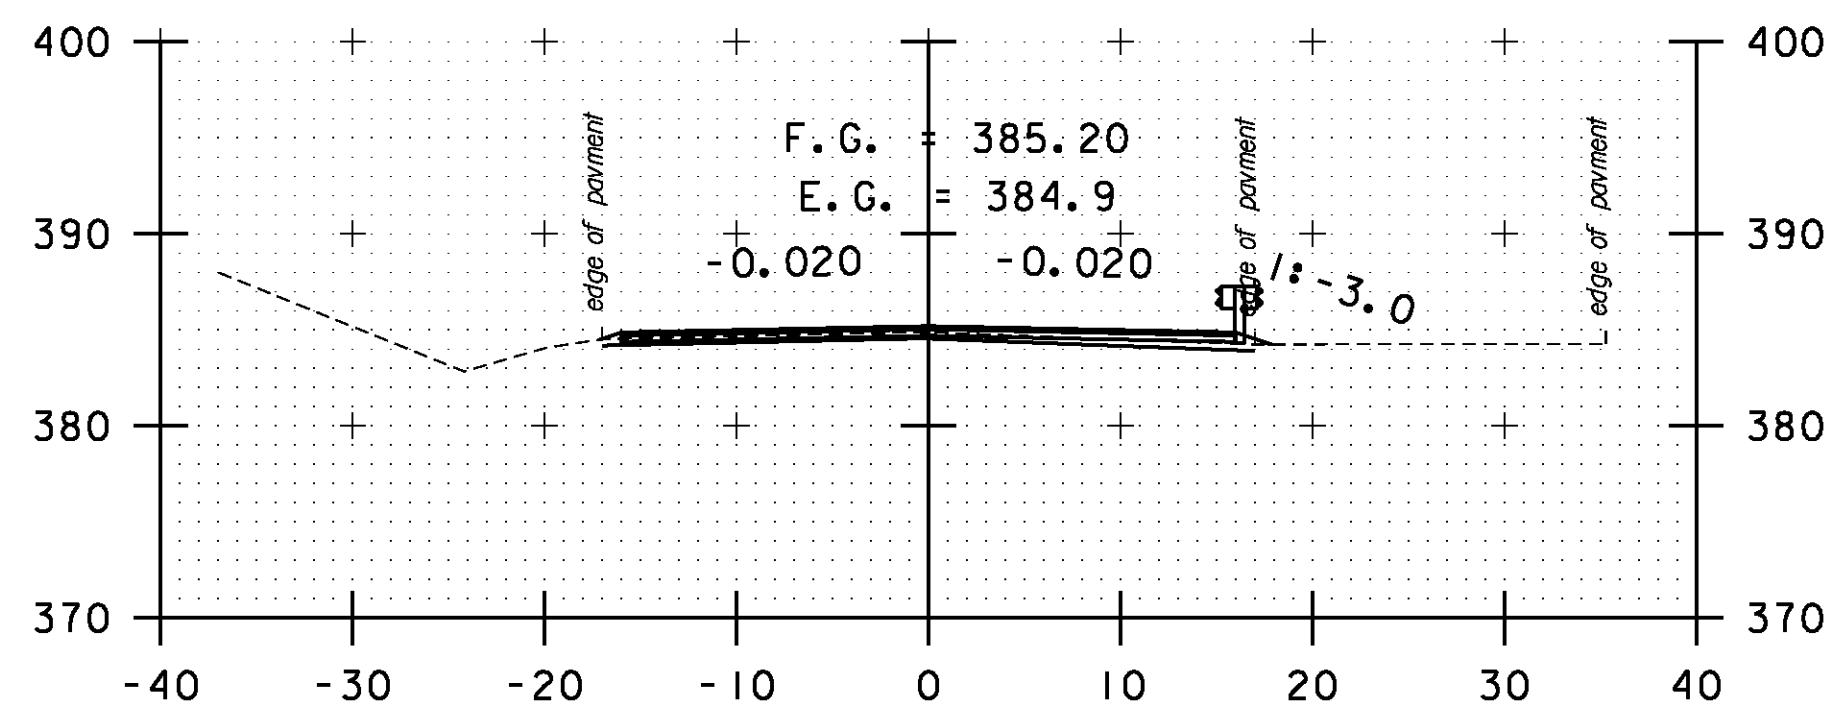


266+00

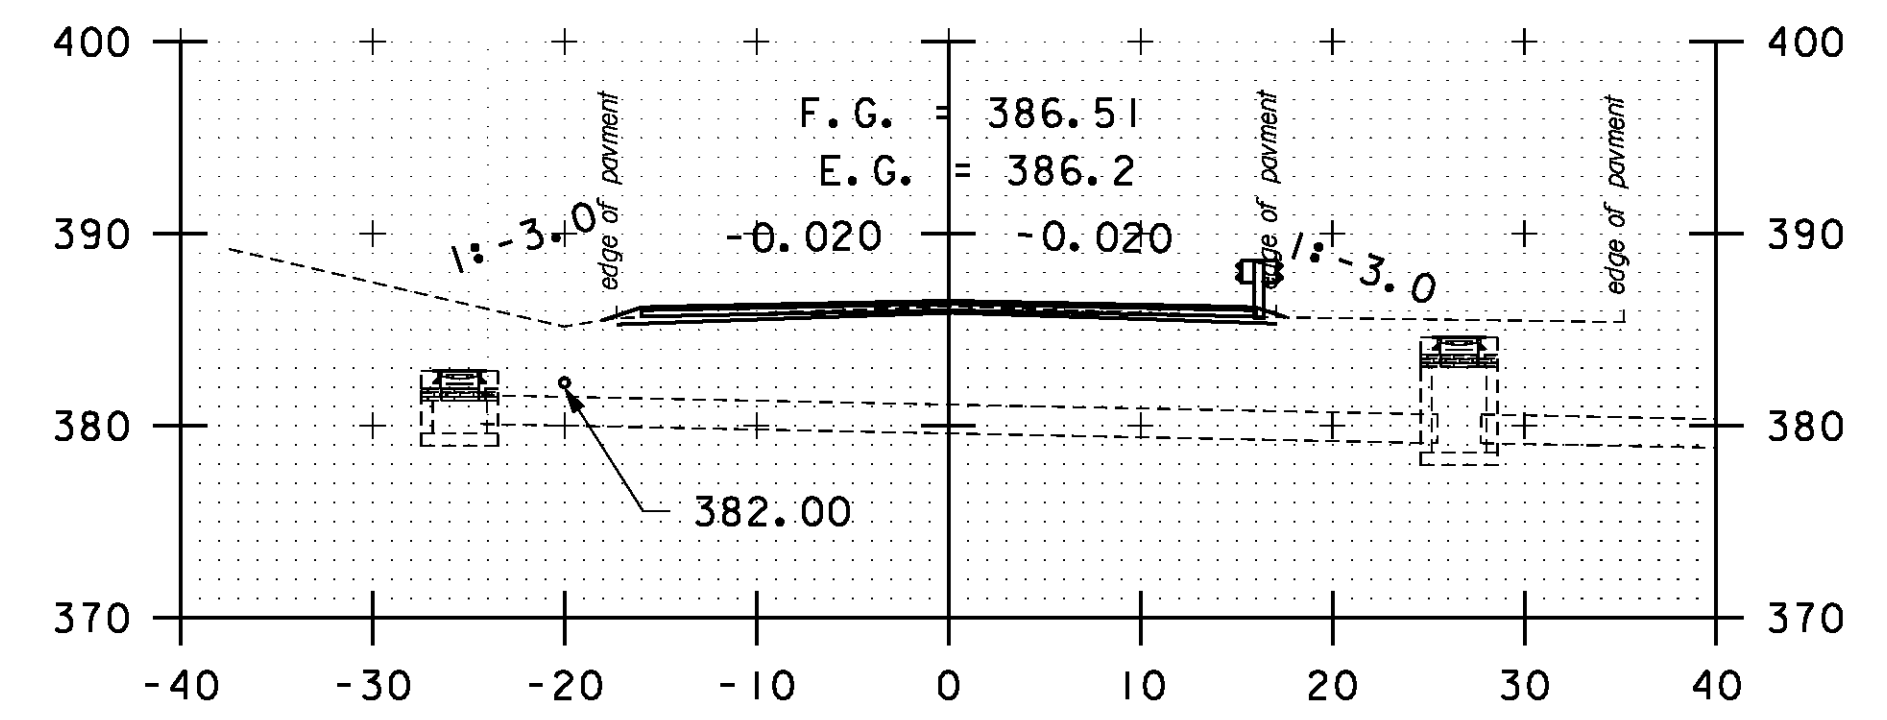


267+50

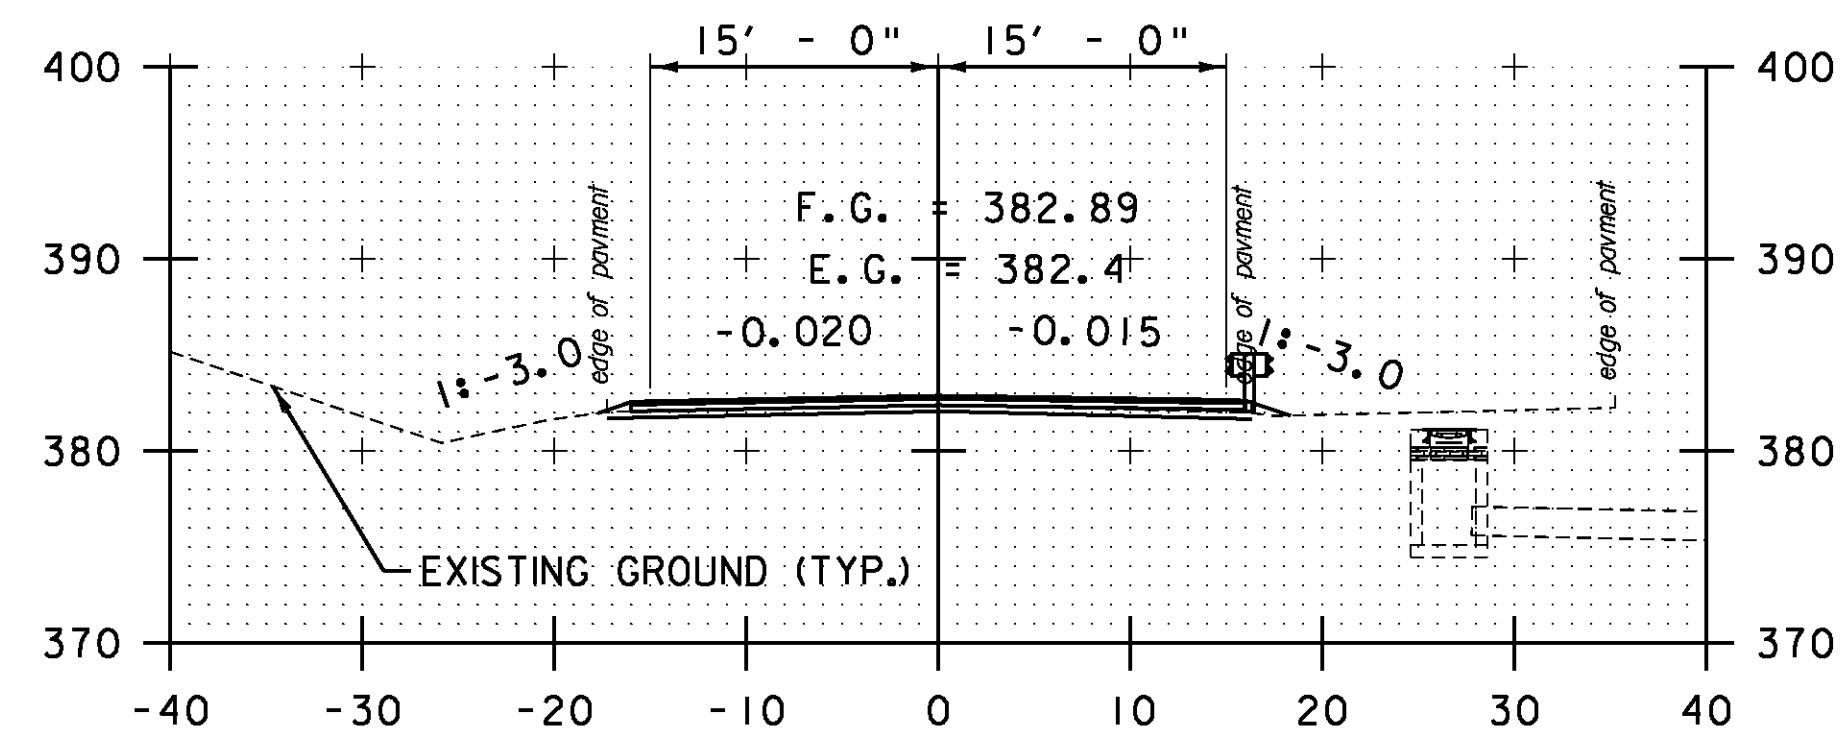

264+00

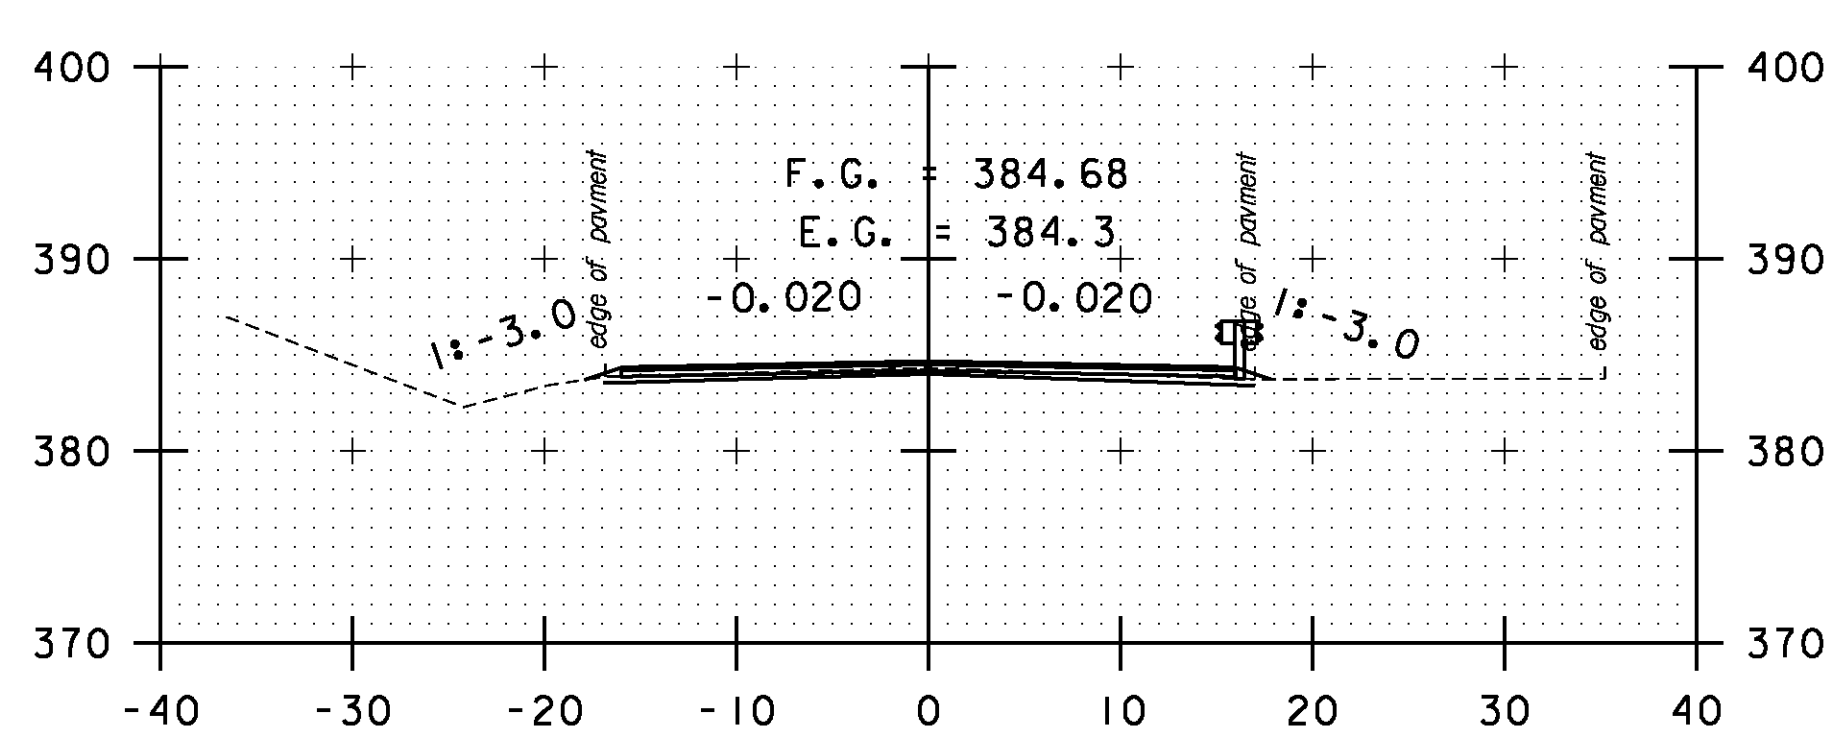

265+50

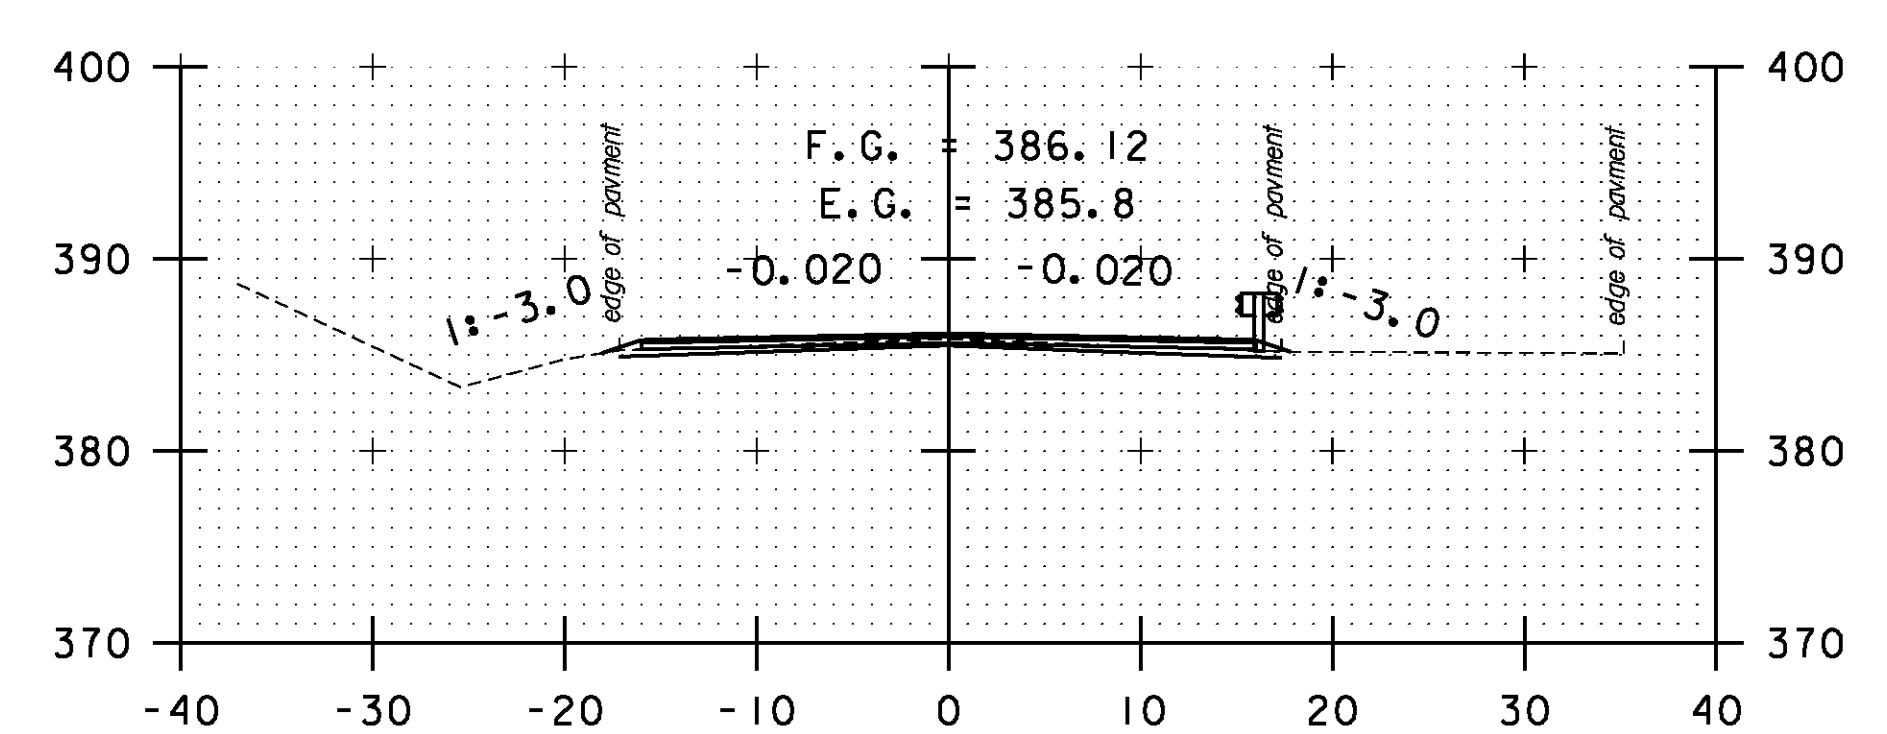

267+00

STA. 264+00 TO STA. 268+00

SCALE 1" = 10'-0"

**CROSS SECTION SHEET 39**

PROJECT NAME: BOLTON-WATERBURY

PROJECT NUMBER: STP 2709(1)

FILE NAME: p07C172.dgn

PROJECT LEADER: CDL

DESIGNED BY: BMB

PLOT FILE: p07C172.165.1

PLOT DATE: 4/16/2013

DRAWN BY: BMB

CHECKED BY: CDL

SHEET 165 OF 217