




274+00

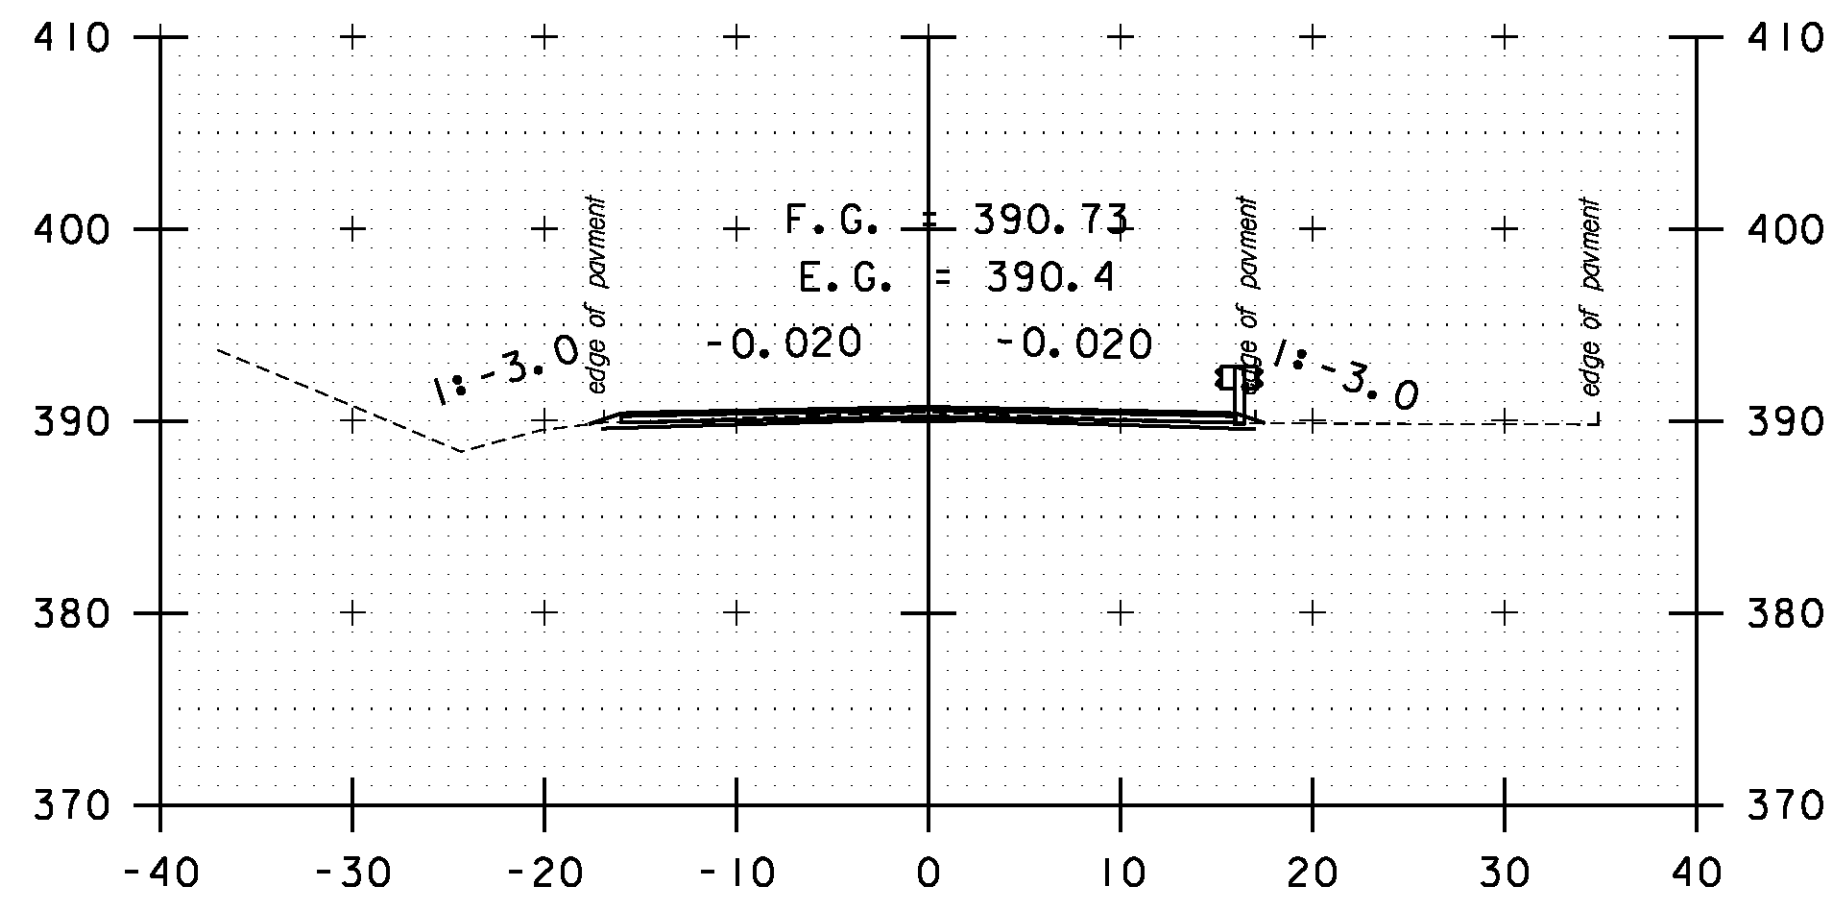


275+50

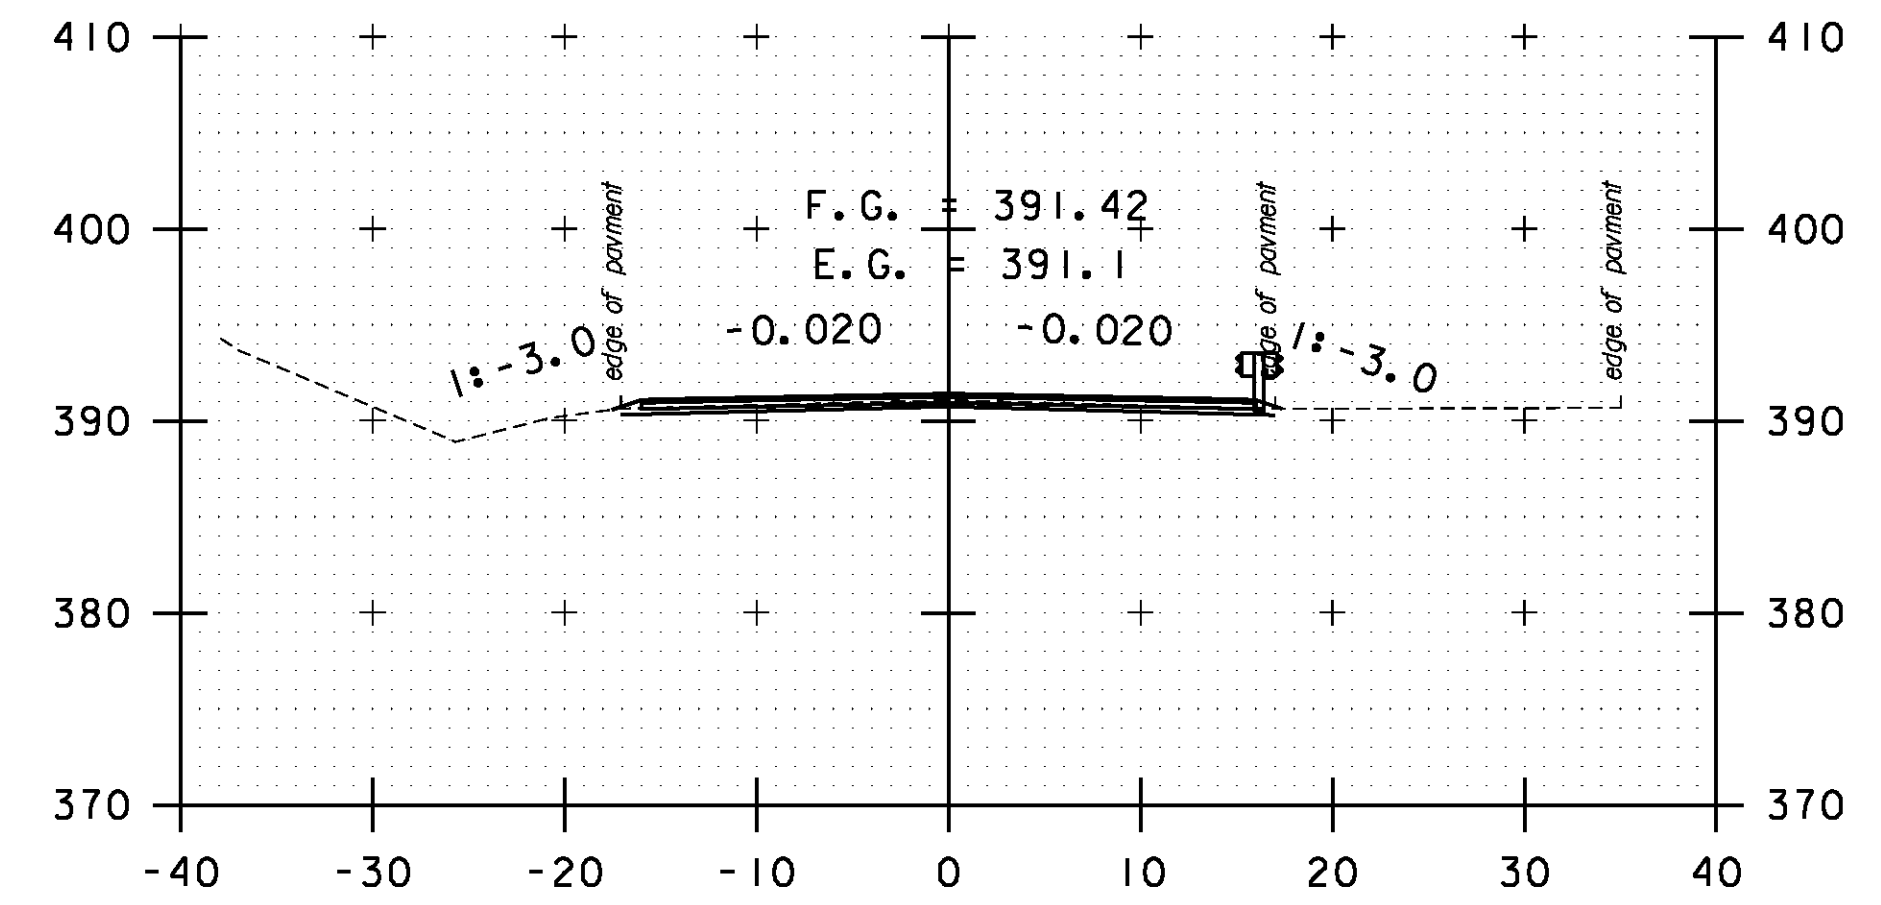


277+00

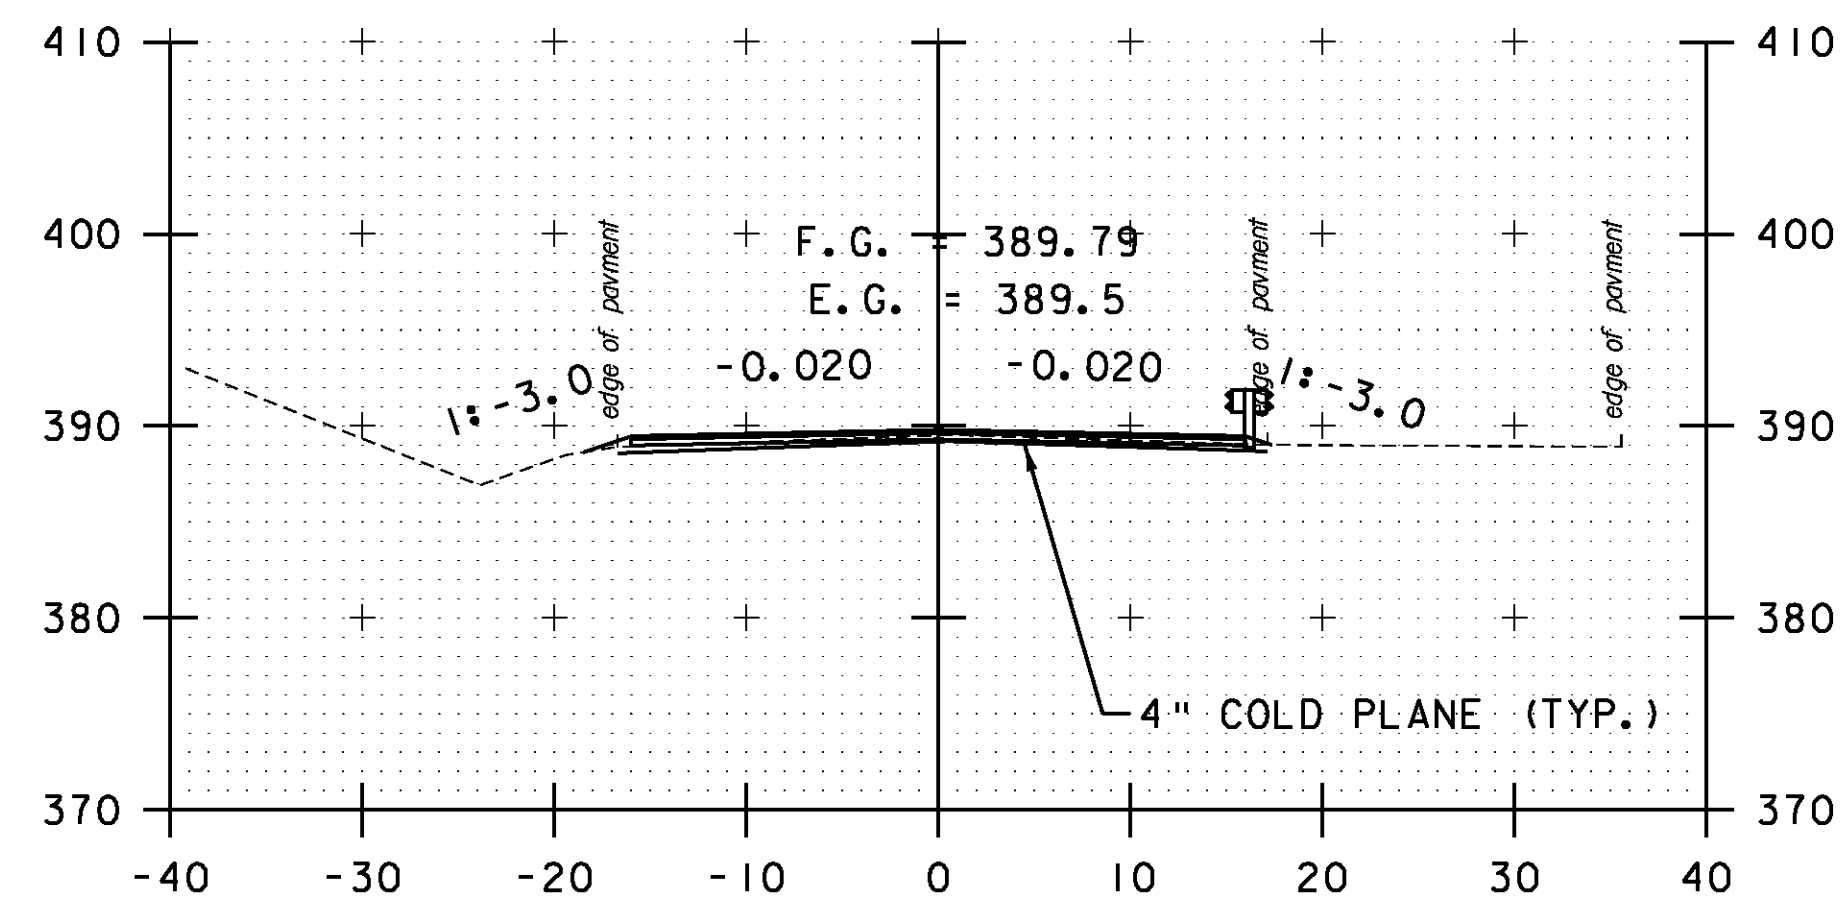


273+50

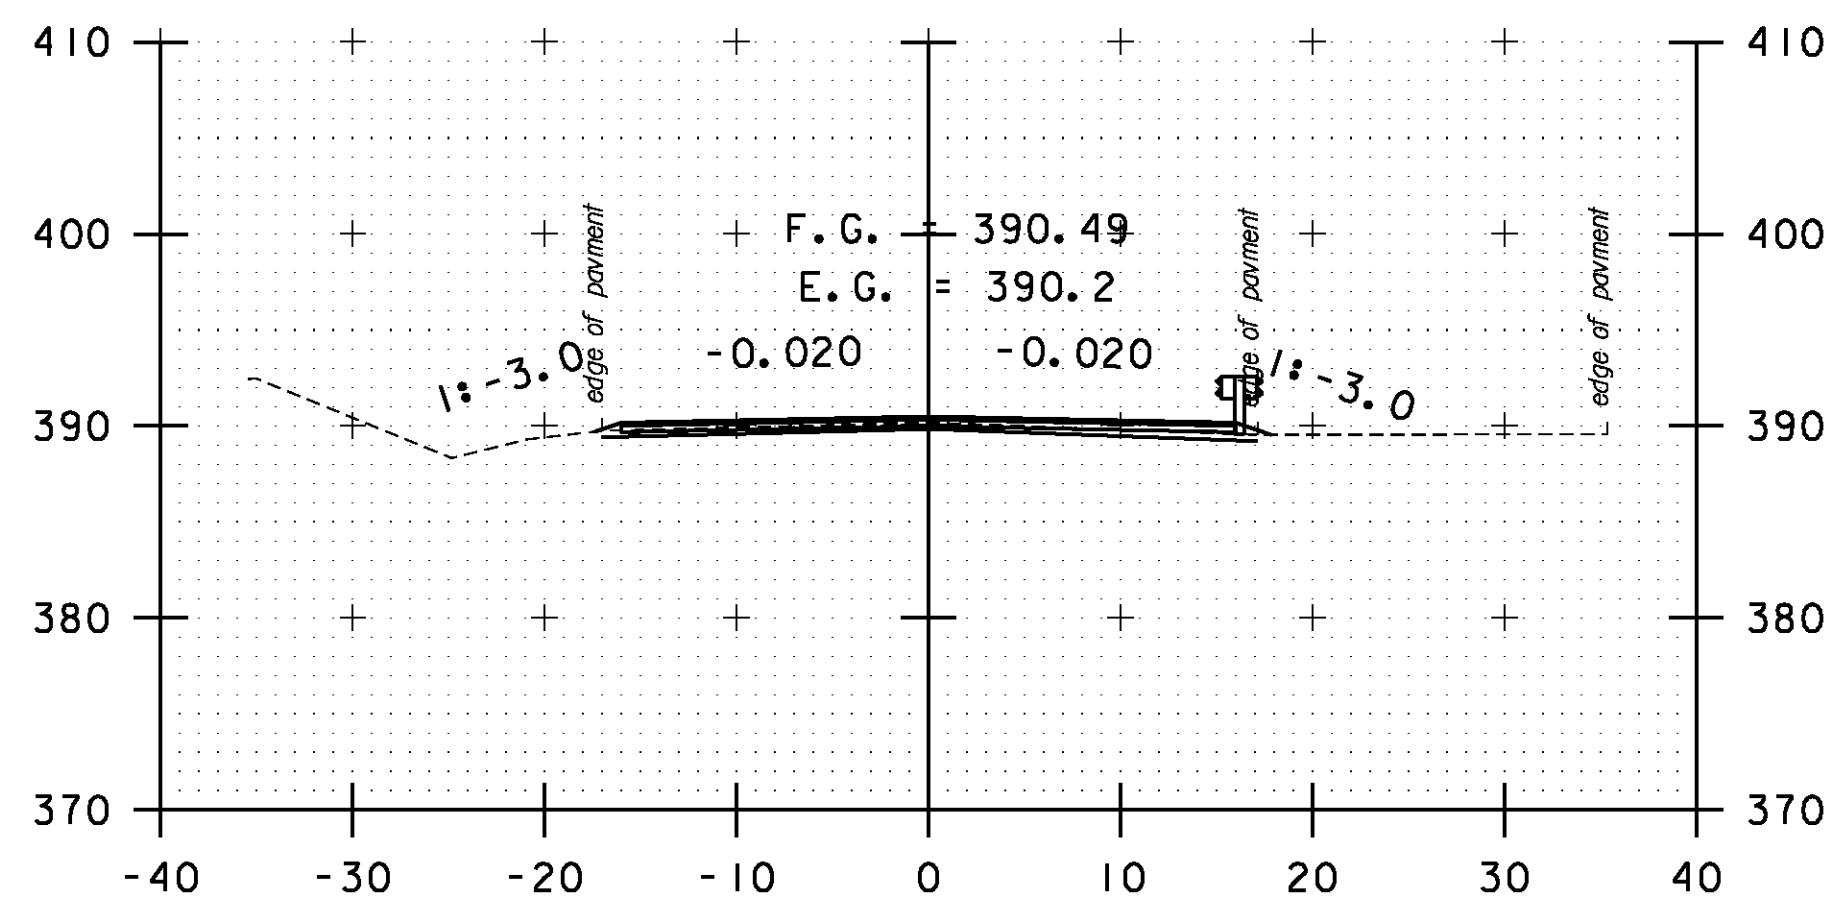


275+00

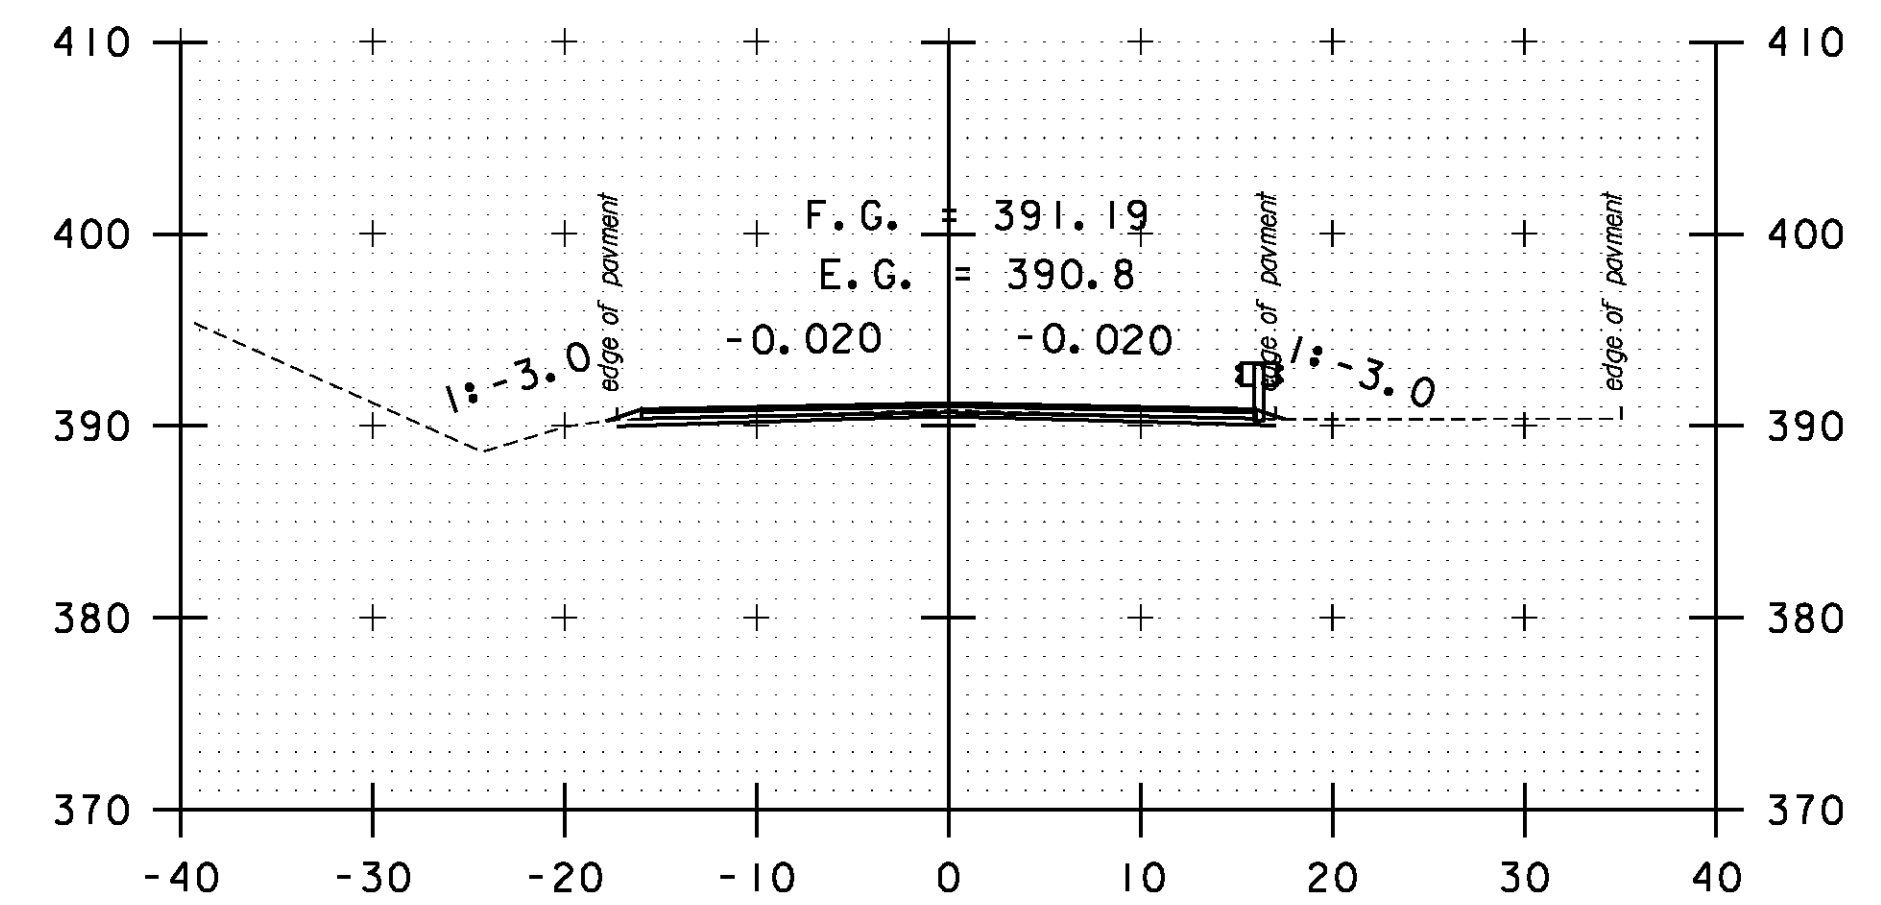


276+50

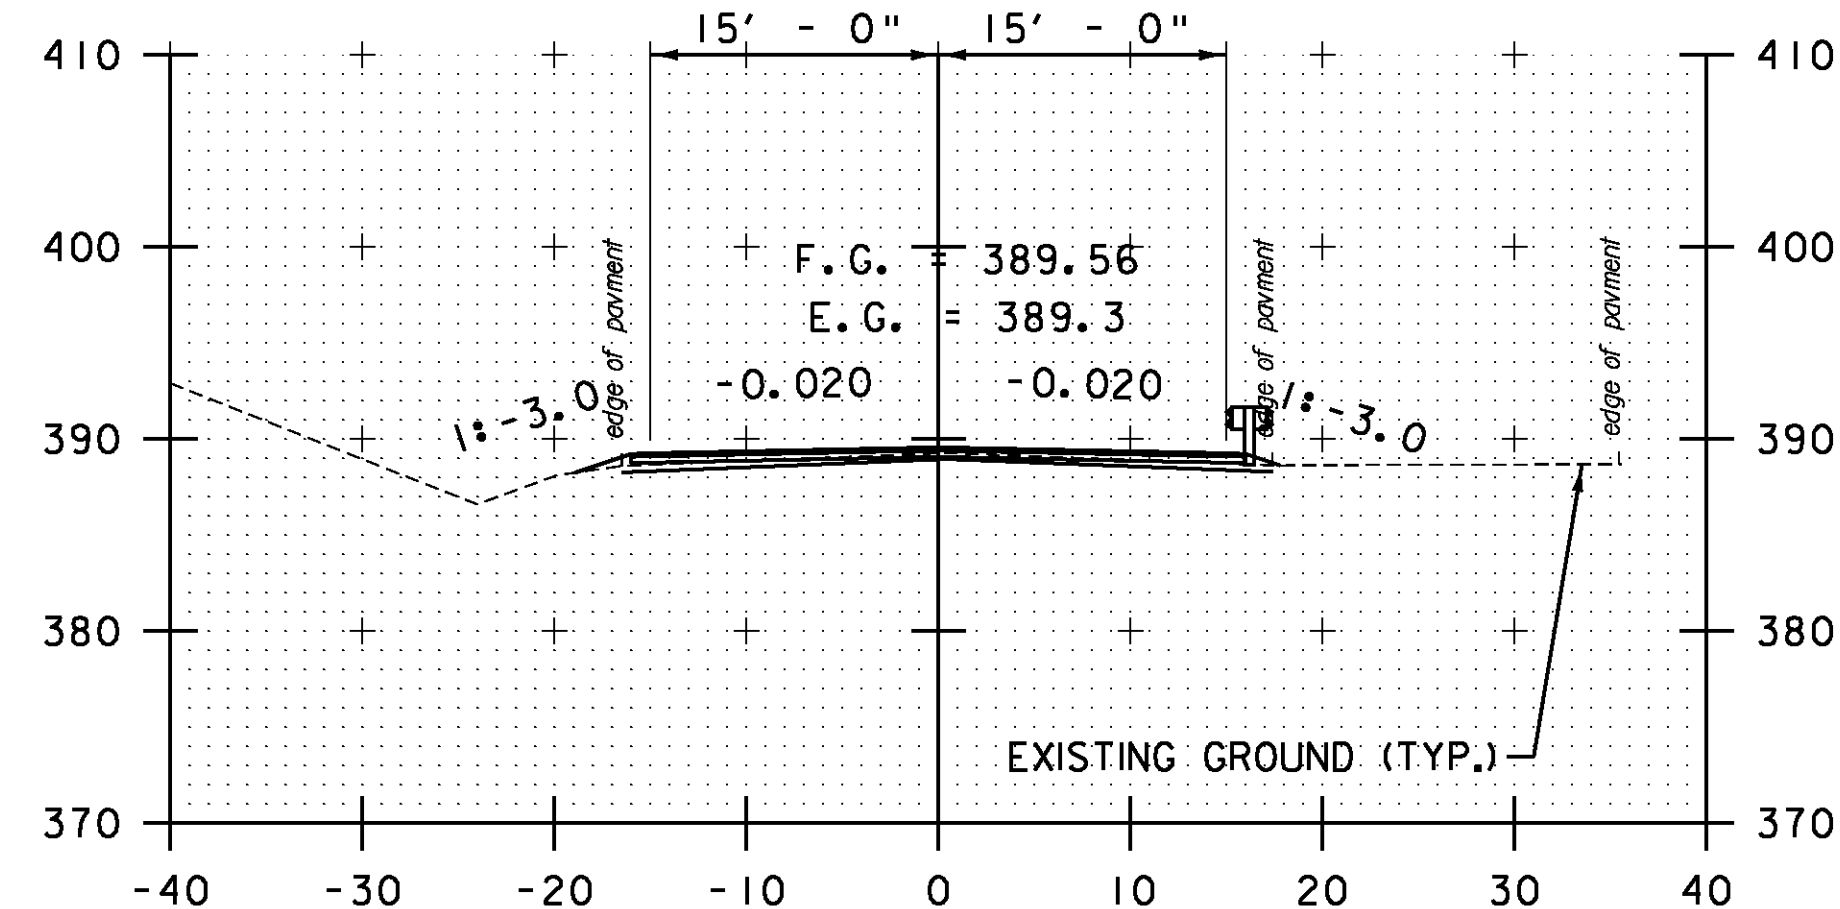

273+00

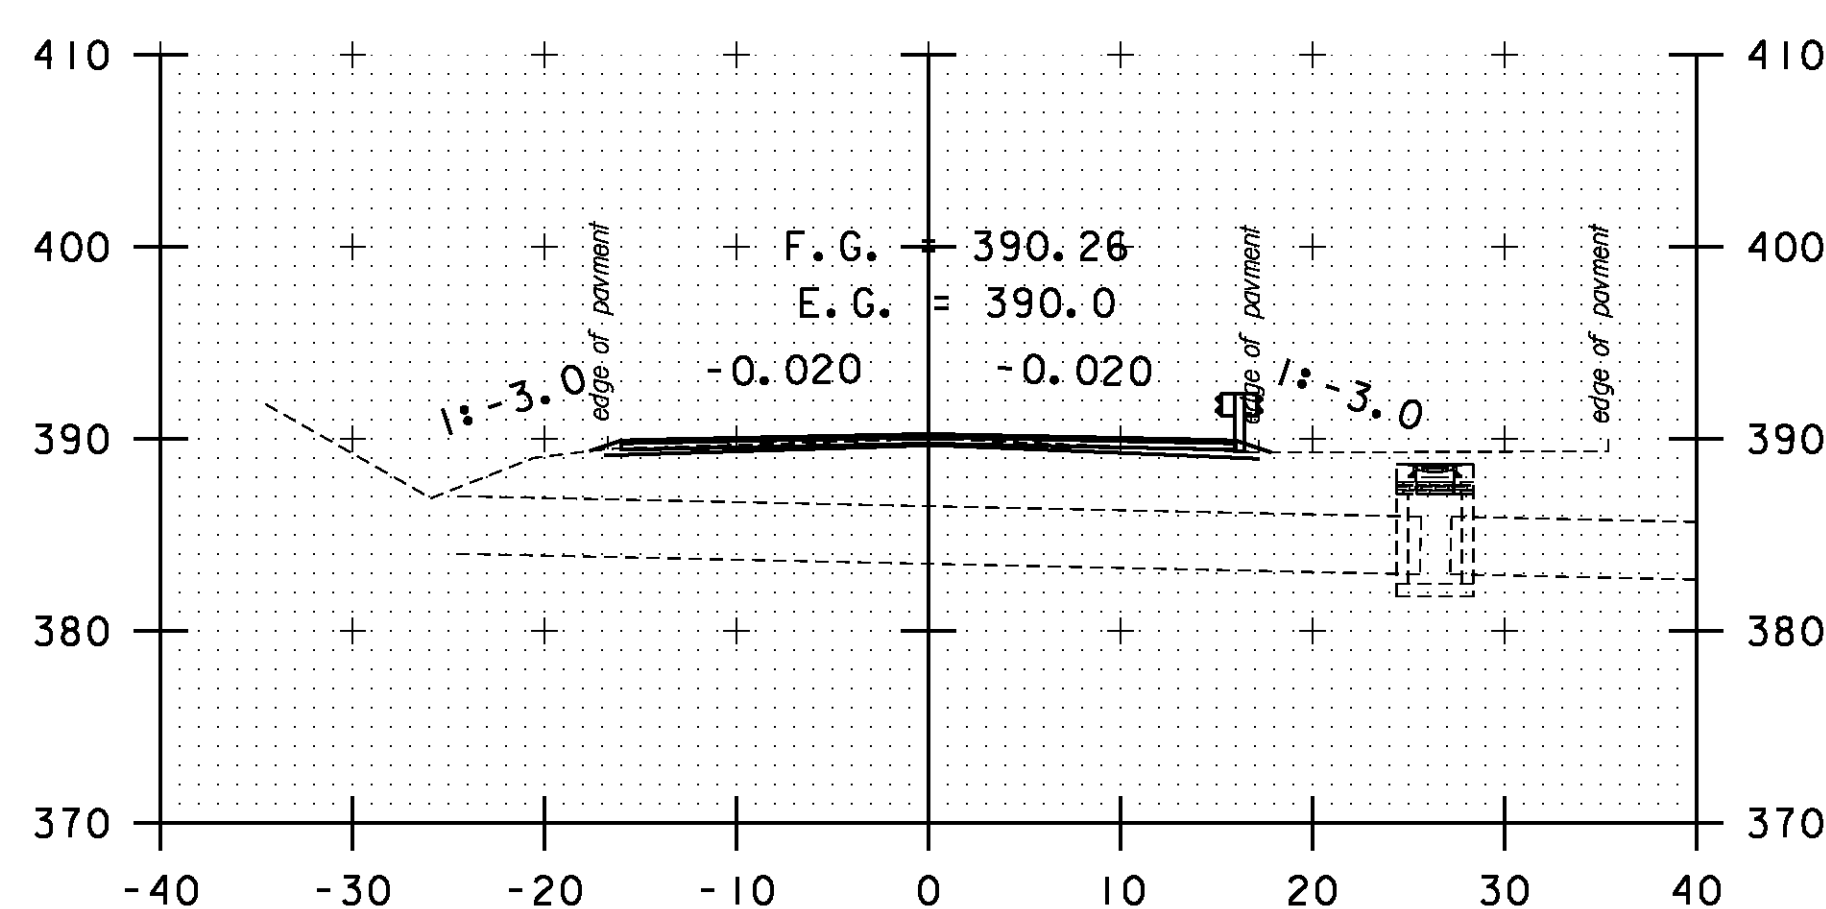

274+50

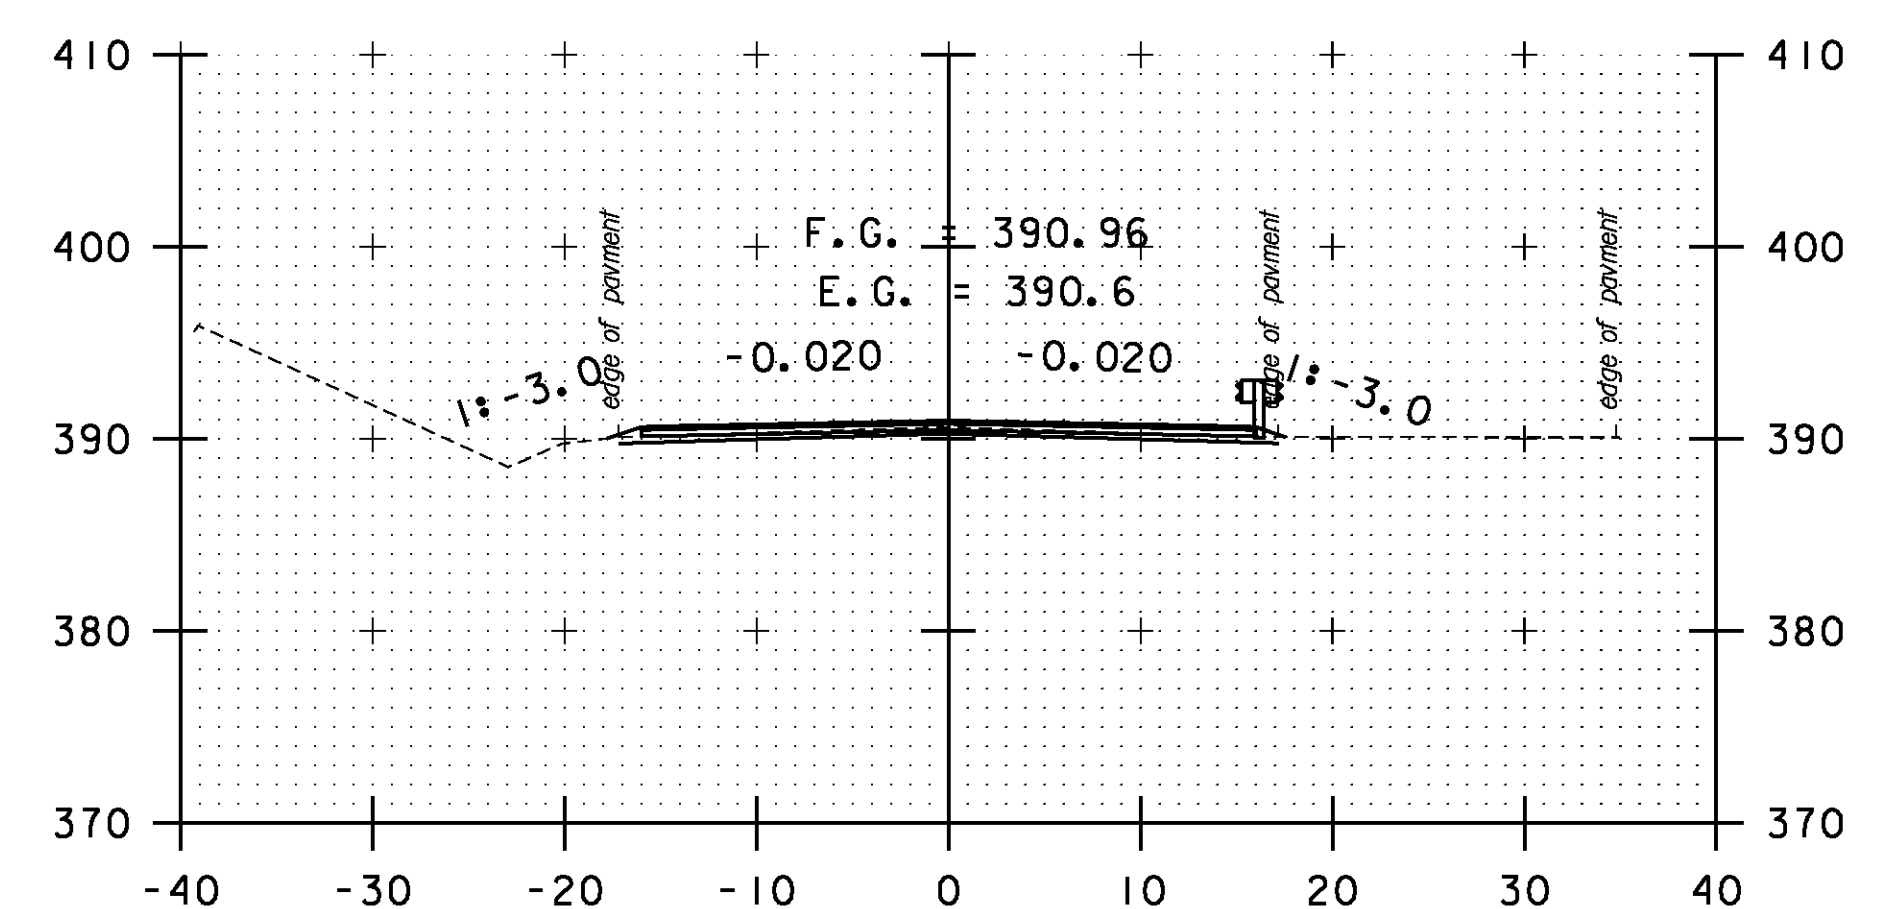

276+00

STA. 273+00 TO STA. 277+00

SCALE 1" = 10'-0"

CROSS SECTION SHEET 41

PROJECT NAME: BOLTON-WATERBURY

PROJECT NUMBER: STP 2709(1)

FILE NAME: p07C172.dgn

PROJECT LEADER: CDL

DESIGNED BY: BMB

PLOT FILE: p07C172_167.1

PLOT DATE: 4/16/2013

DRAWN BY: BMB

CHECKED BY: CDL

SHEET 167 OF 217