




278+50

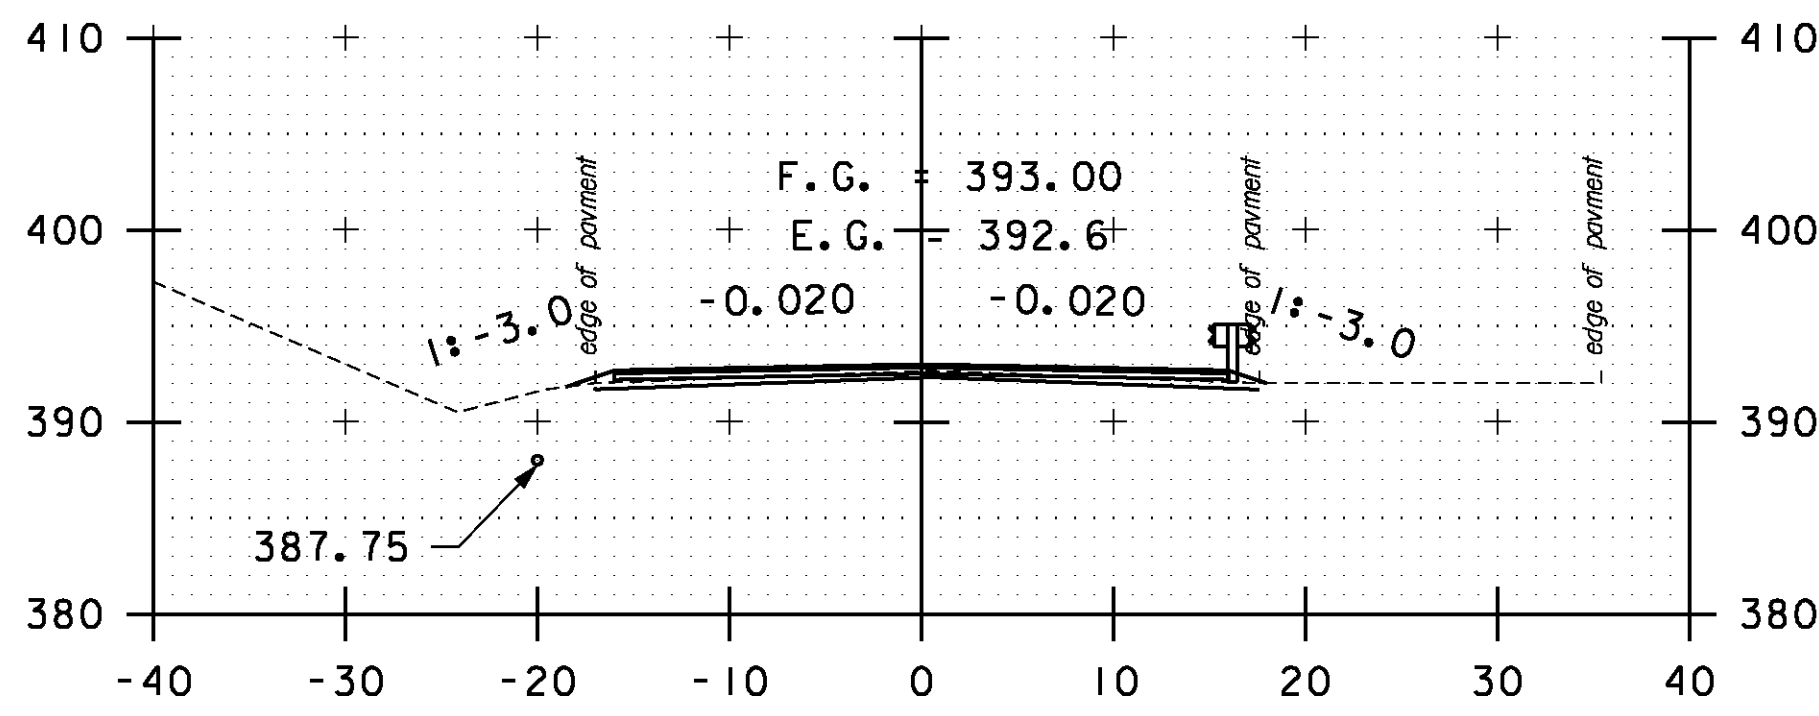


280+00

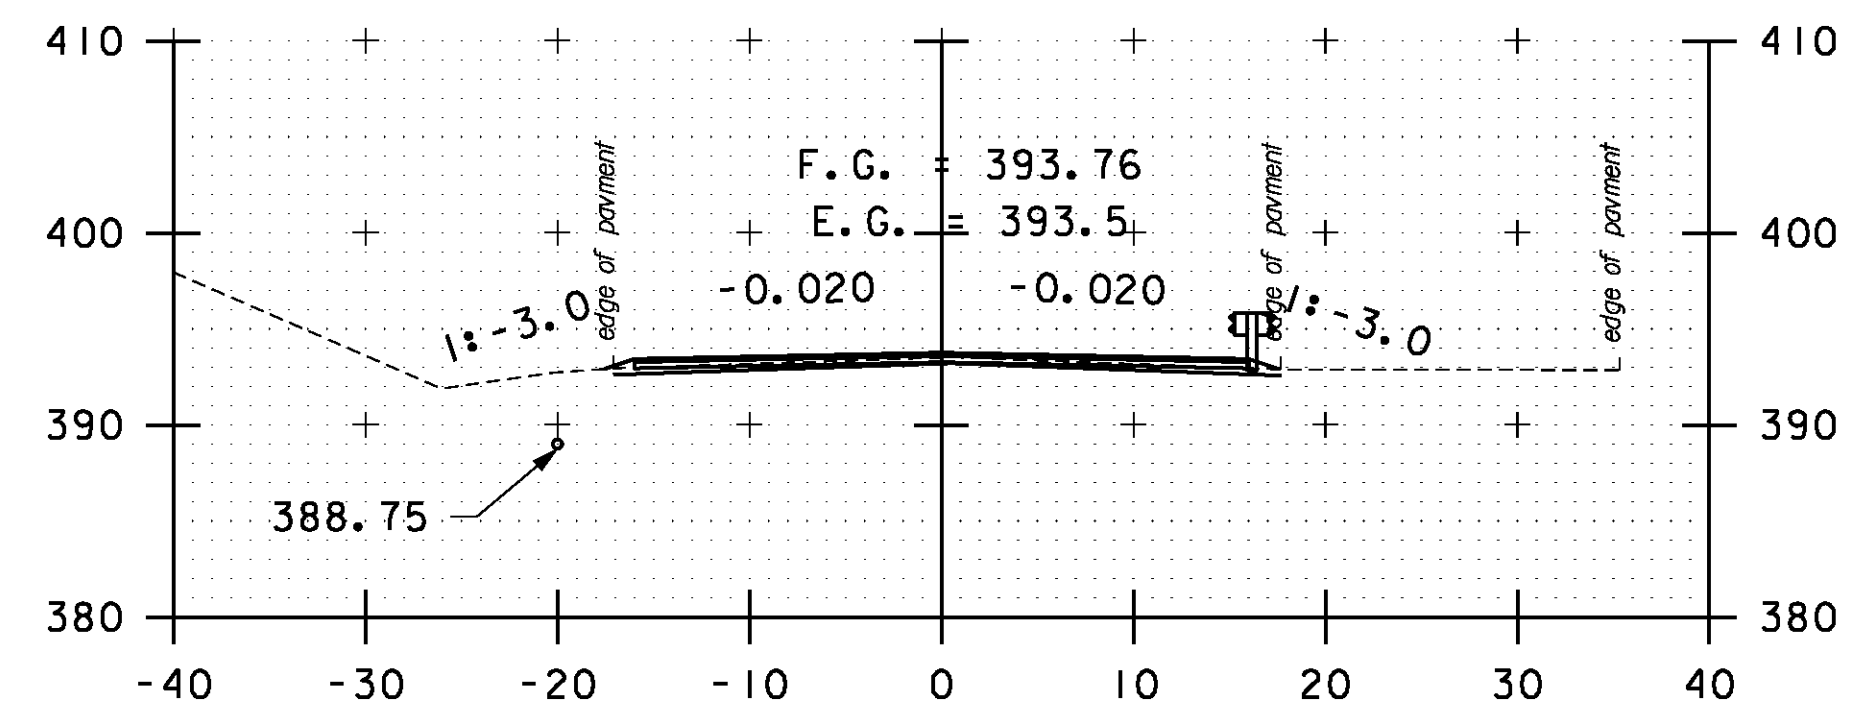


281+50

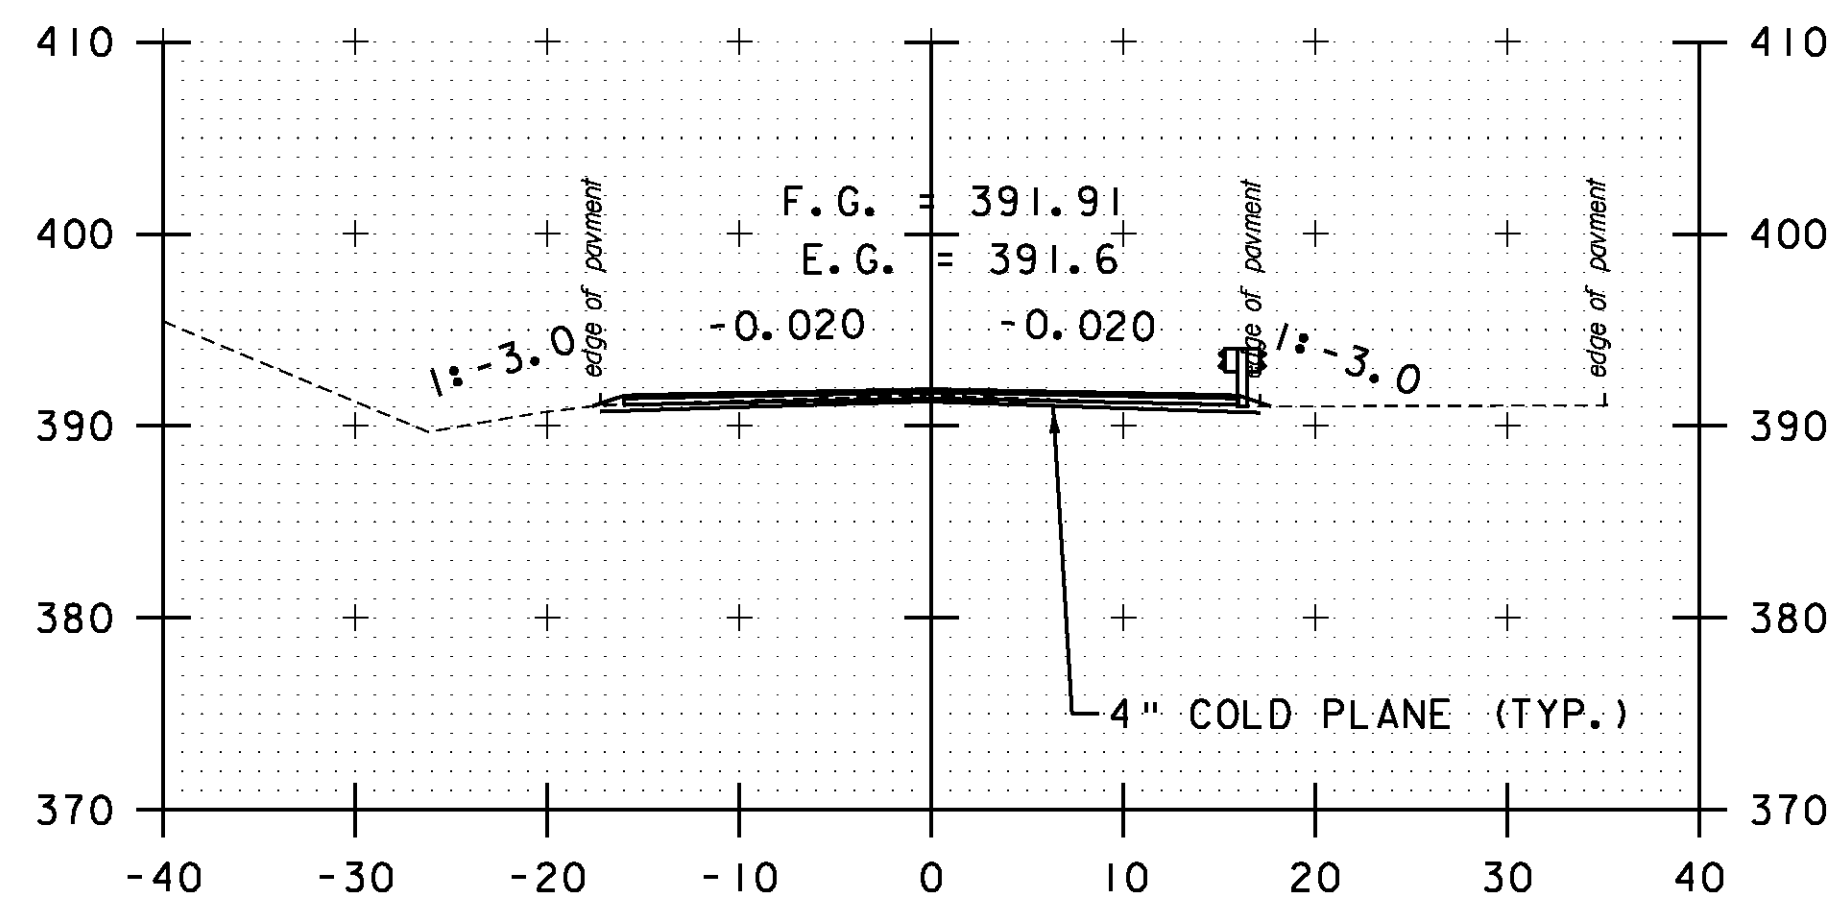


278+00

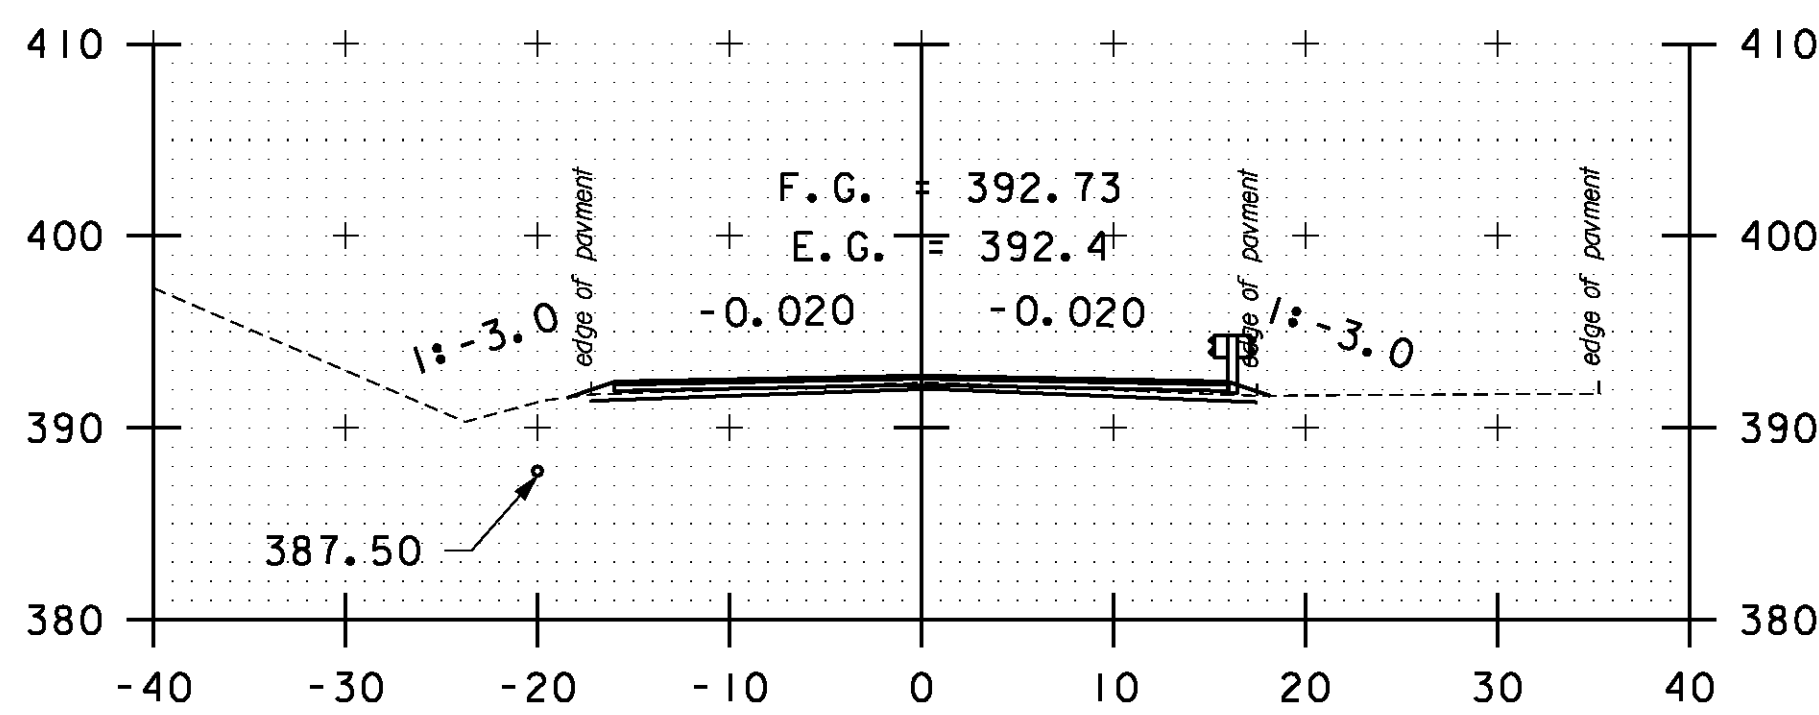


279+50

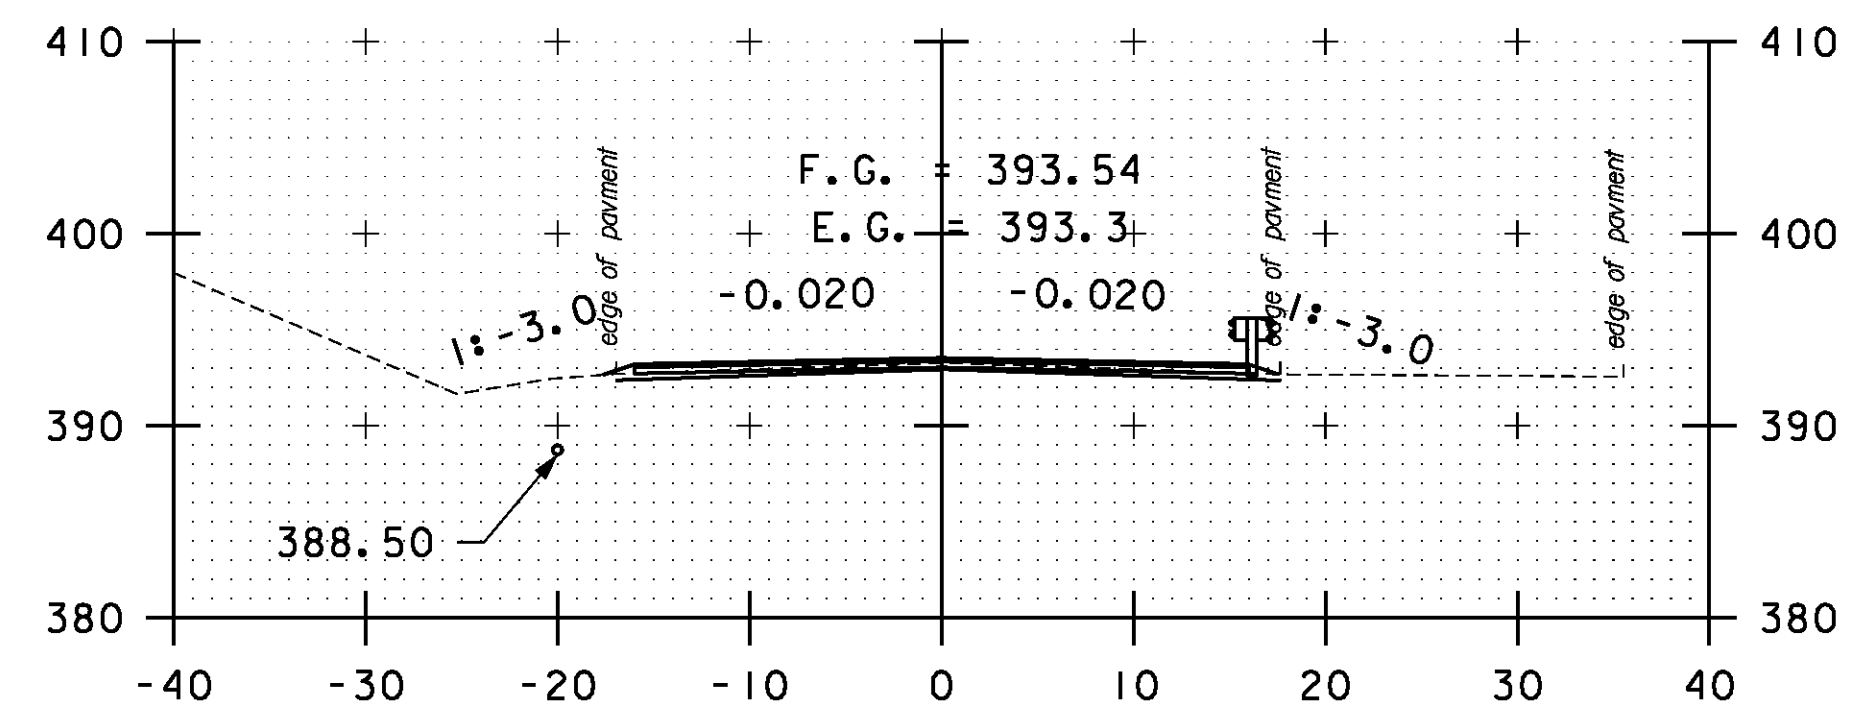


281+00

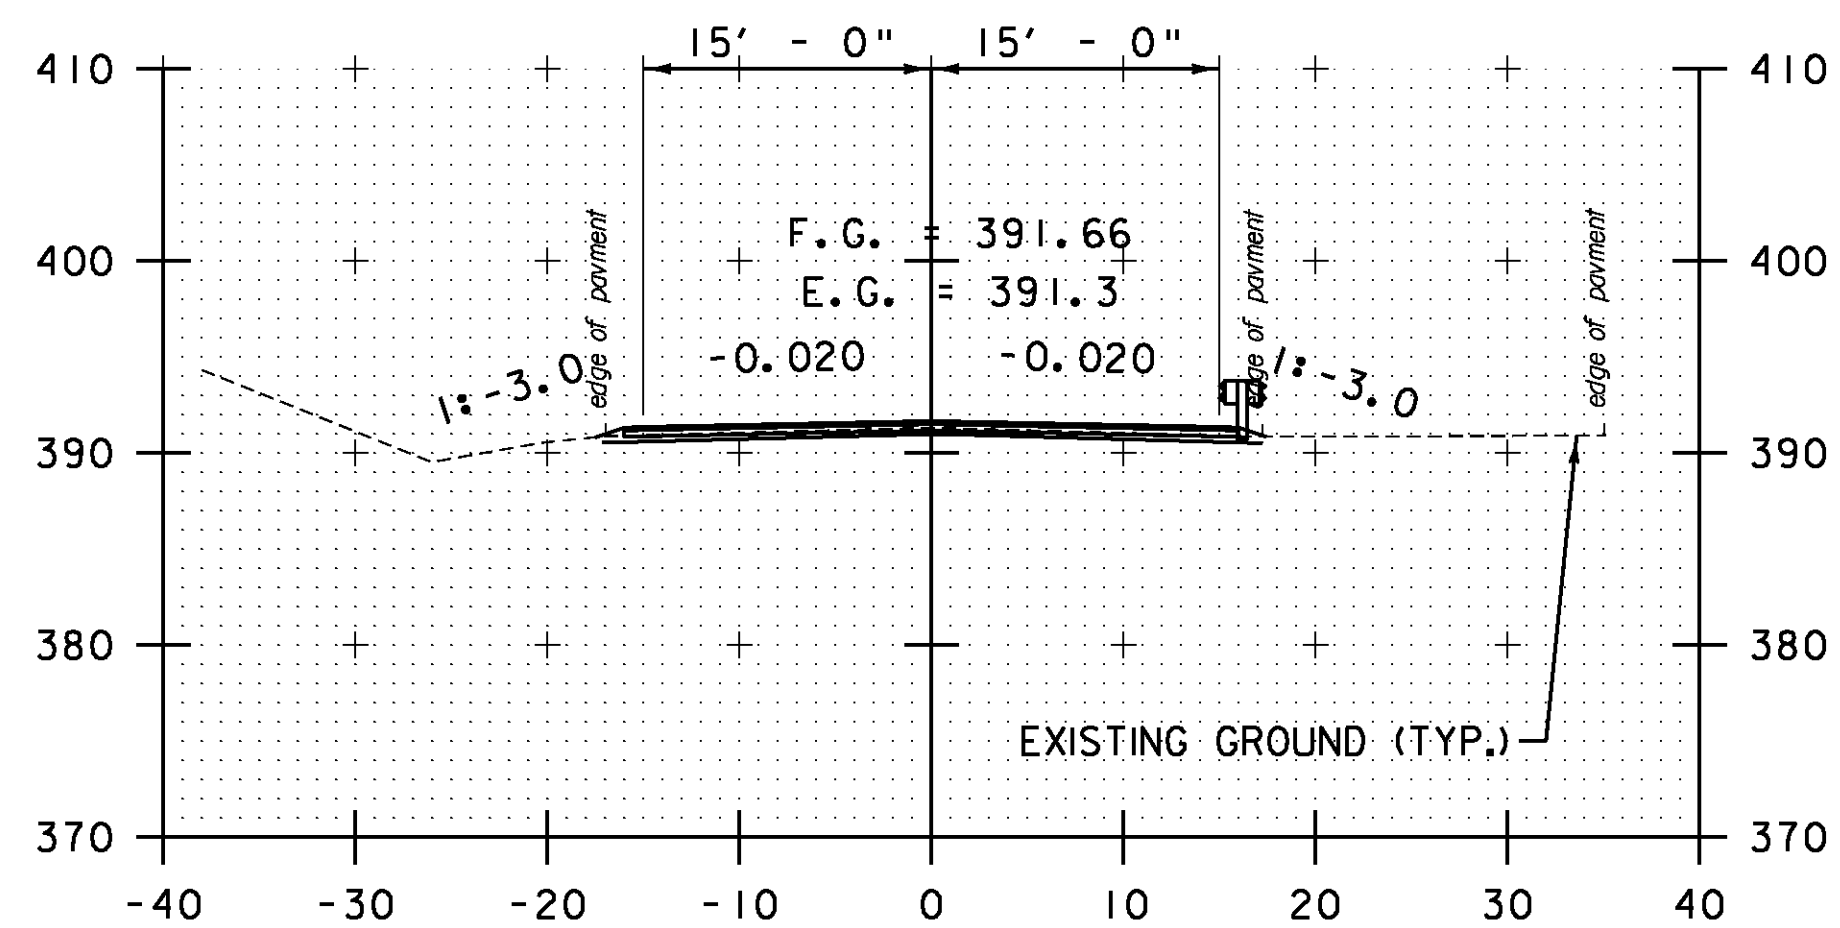

277+50

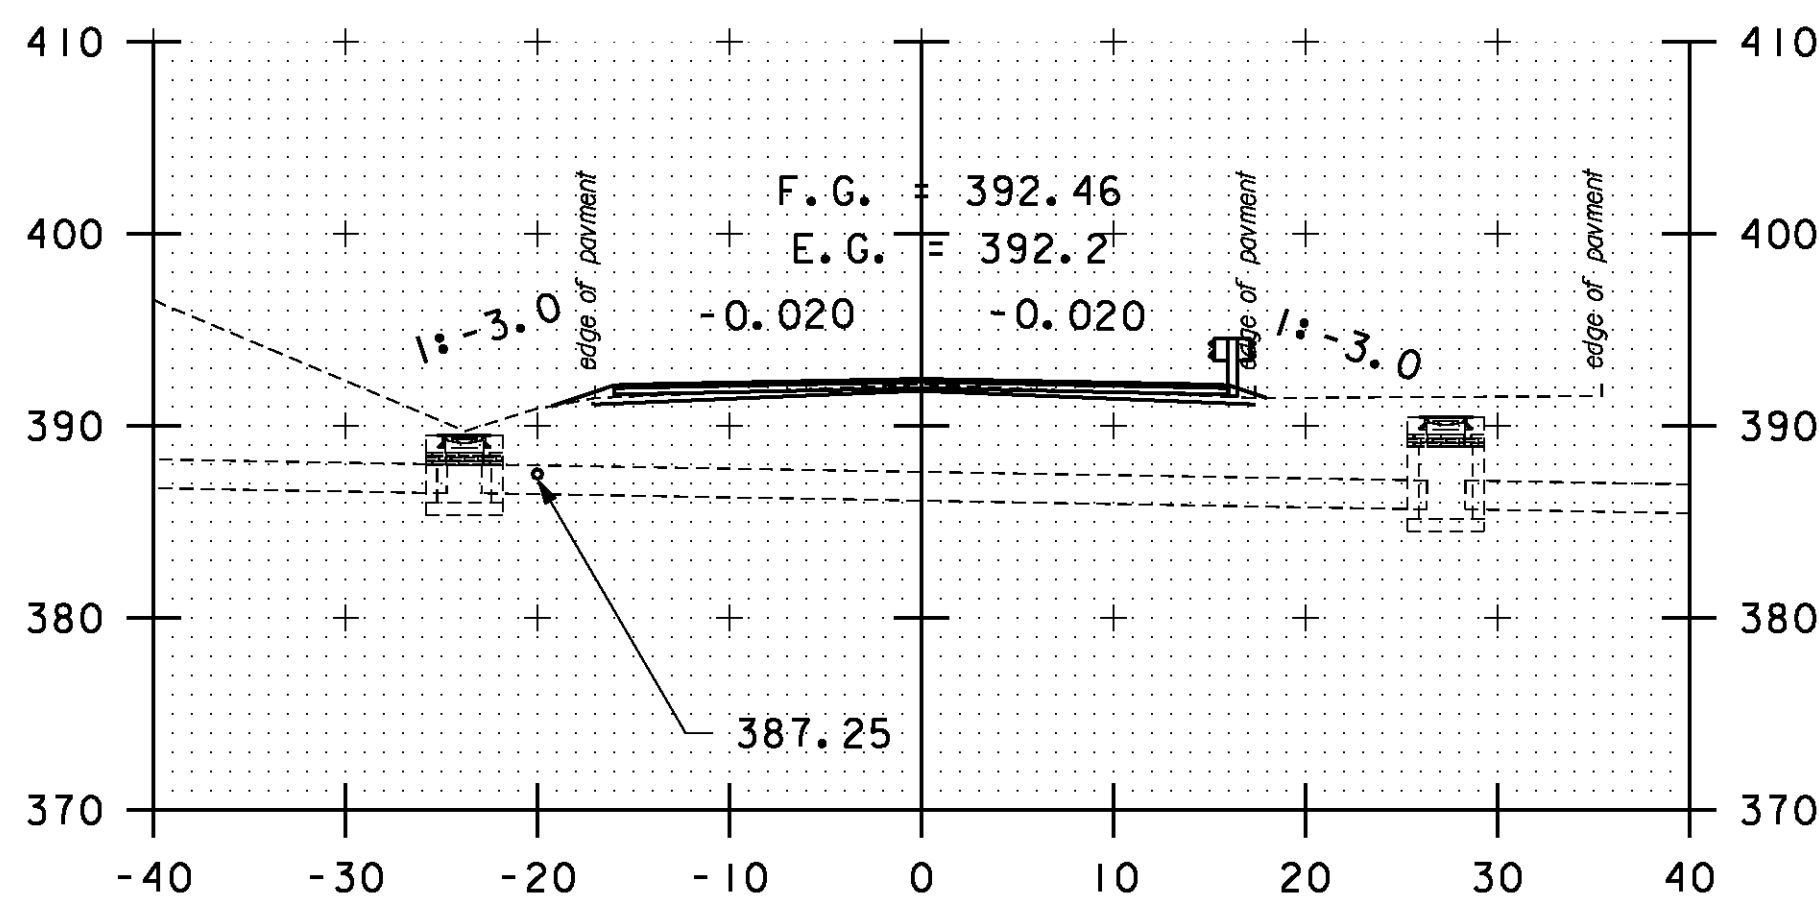

279+00

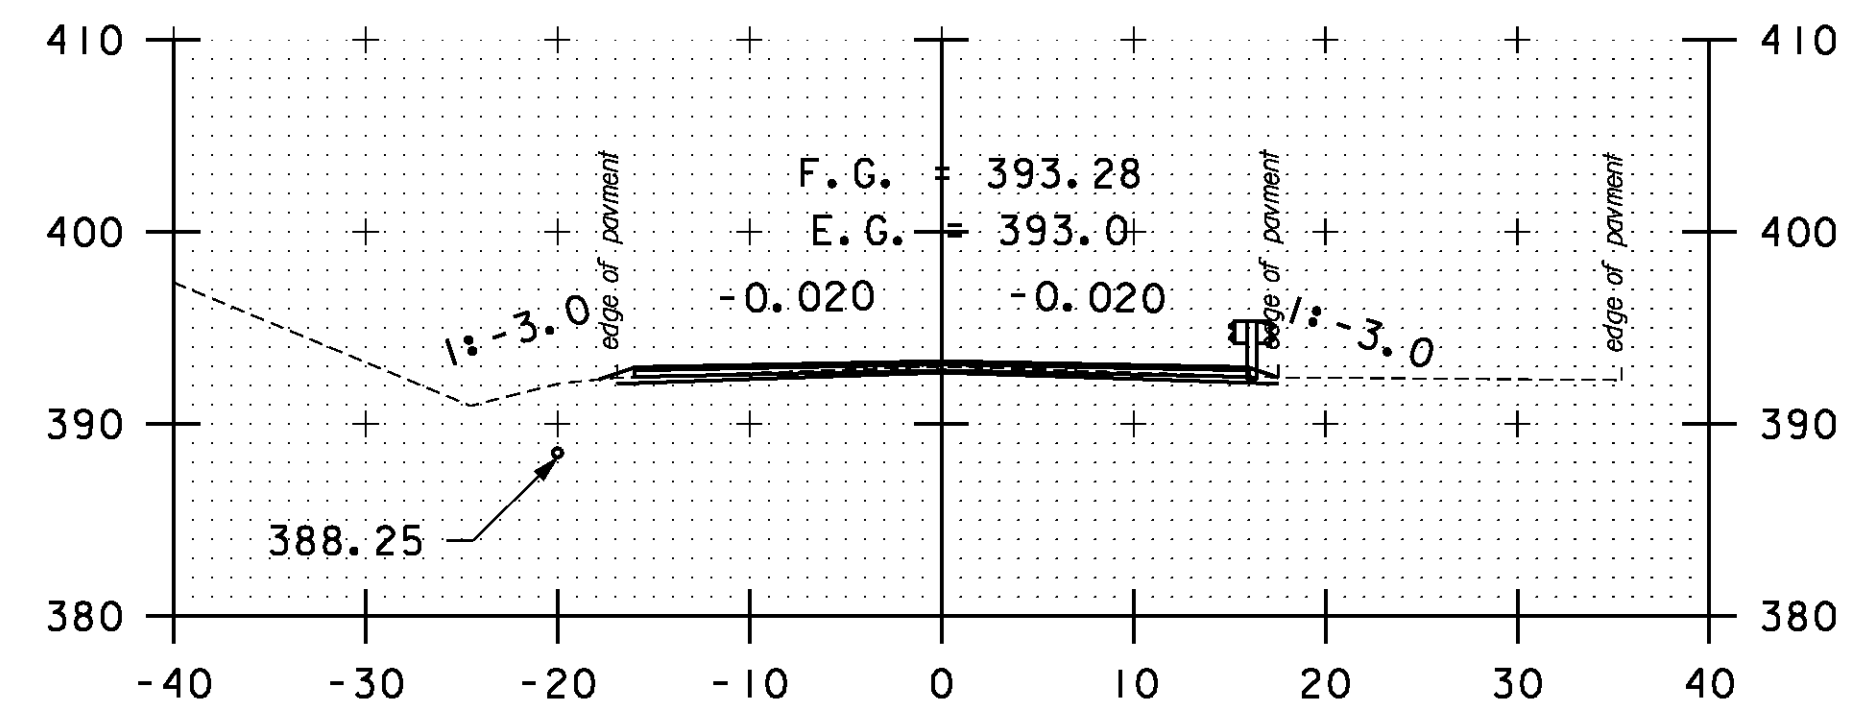

280+50

STA. 277+50 TO STA. 281+50

SCALE 1" = 10'-0"

**CROSS SECTION SHEET 42**

PROJECT NAME: BOLTON-WATERBURY

PROJECT NUMBER: STP 2709(I)

FILE NAME: p07C172.dgn

PROJECT LEADER: CDL

DESIGNED BY: BMB

PLOT FILE: p07C172\_168.1

PLOT DATE: 4/16/2013

DRAWN BY: BMB

CHECKED BY: CDL

SHEET 168 OF 217