




283+00

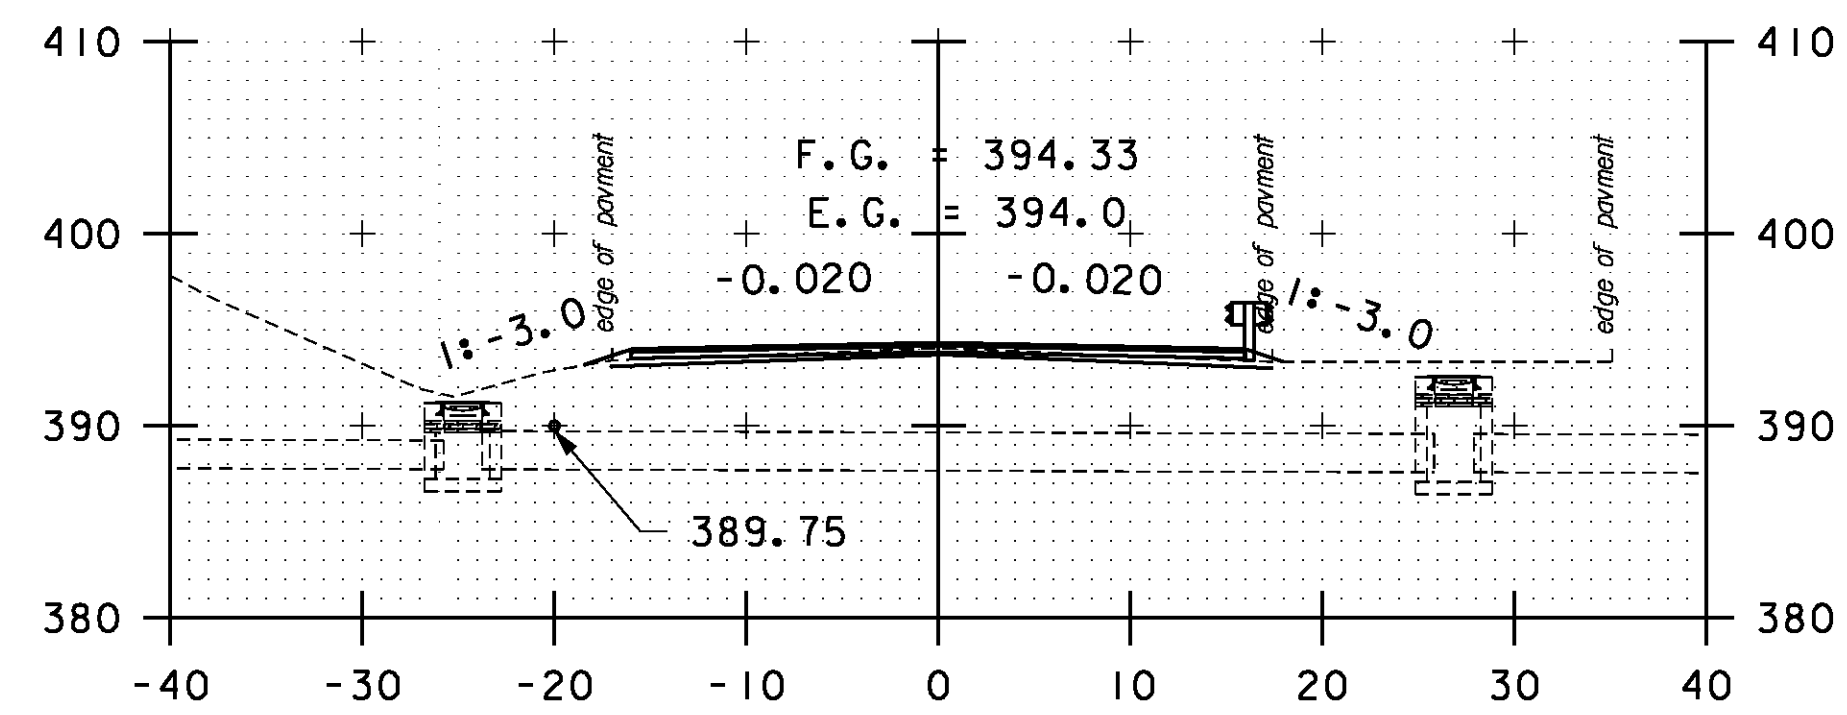


282+50

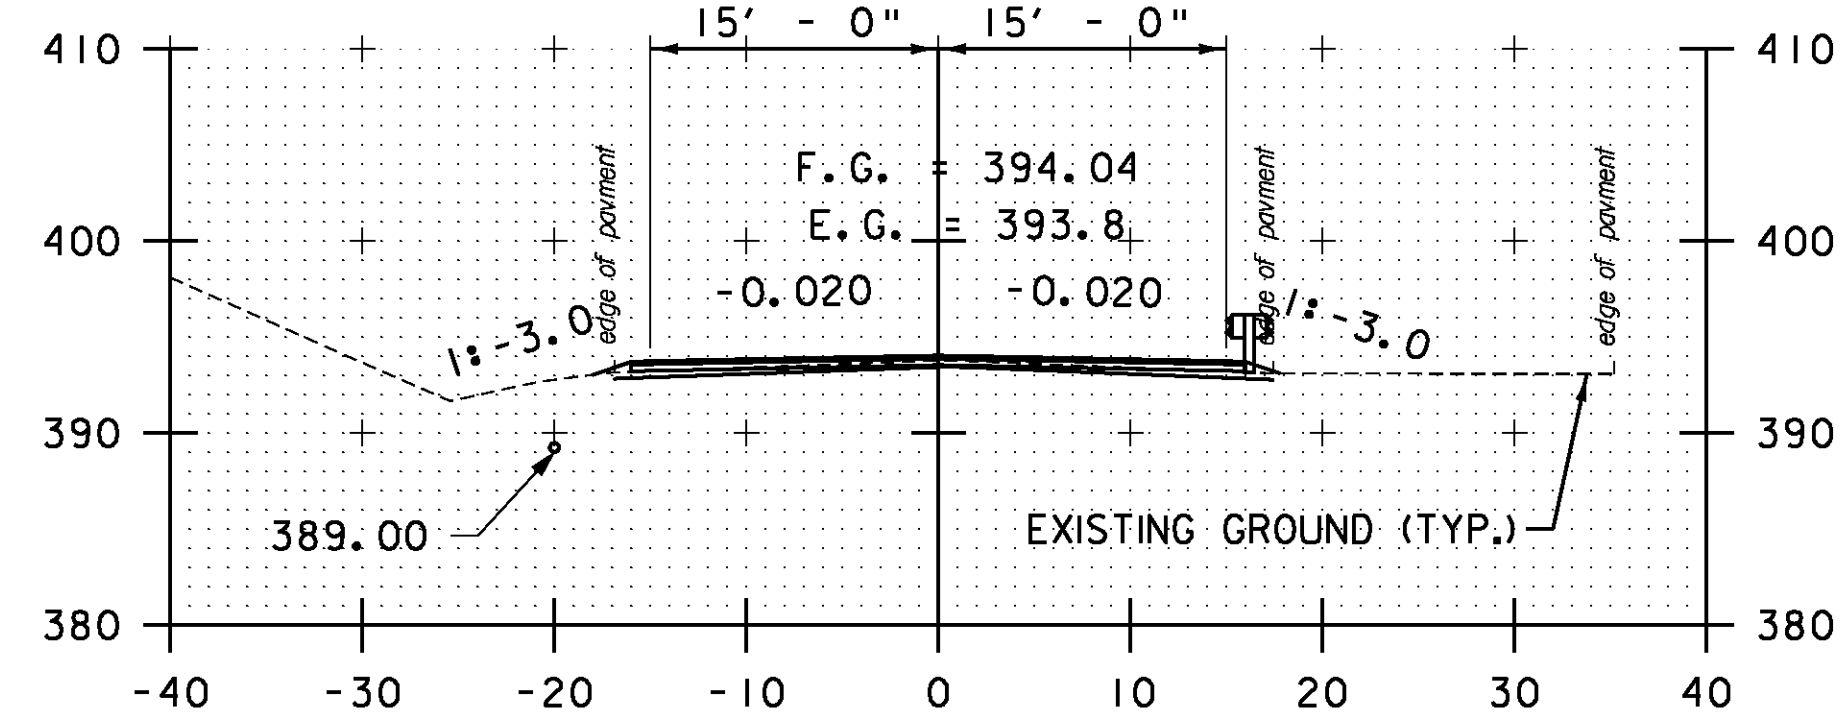


282+00

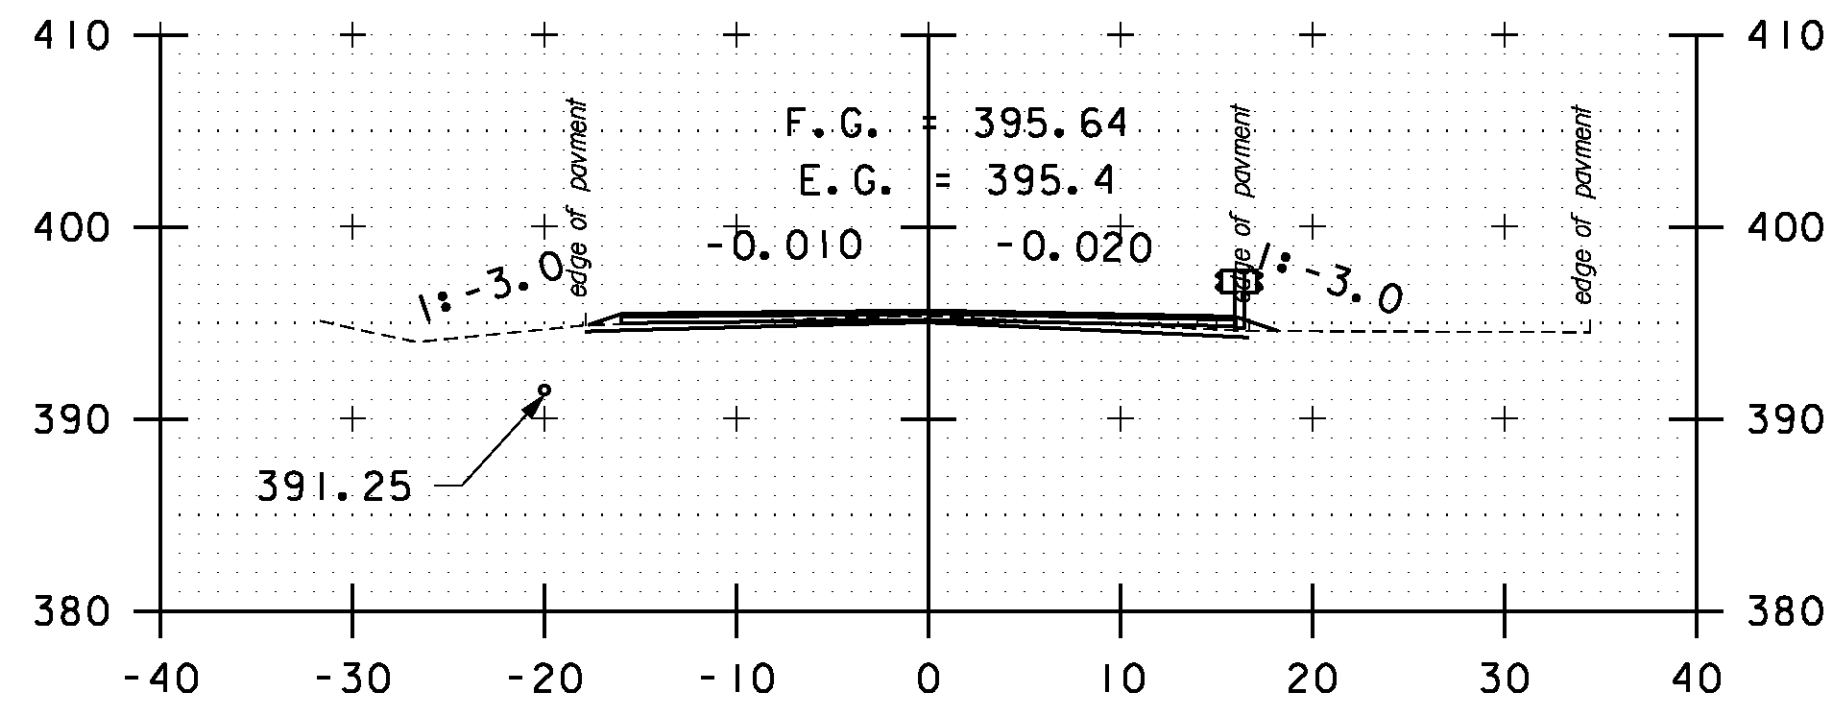


284+50

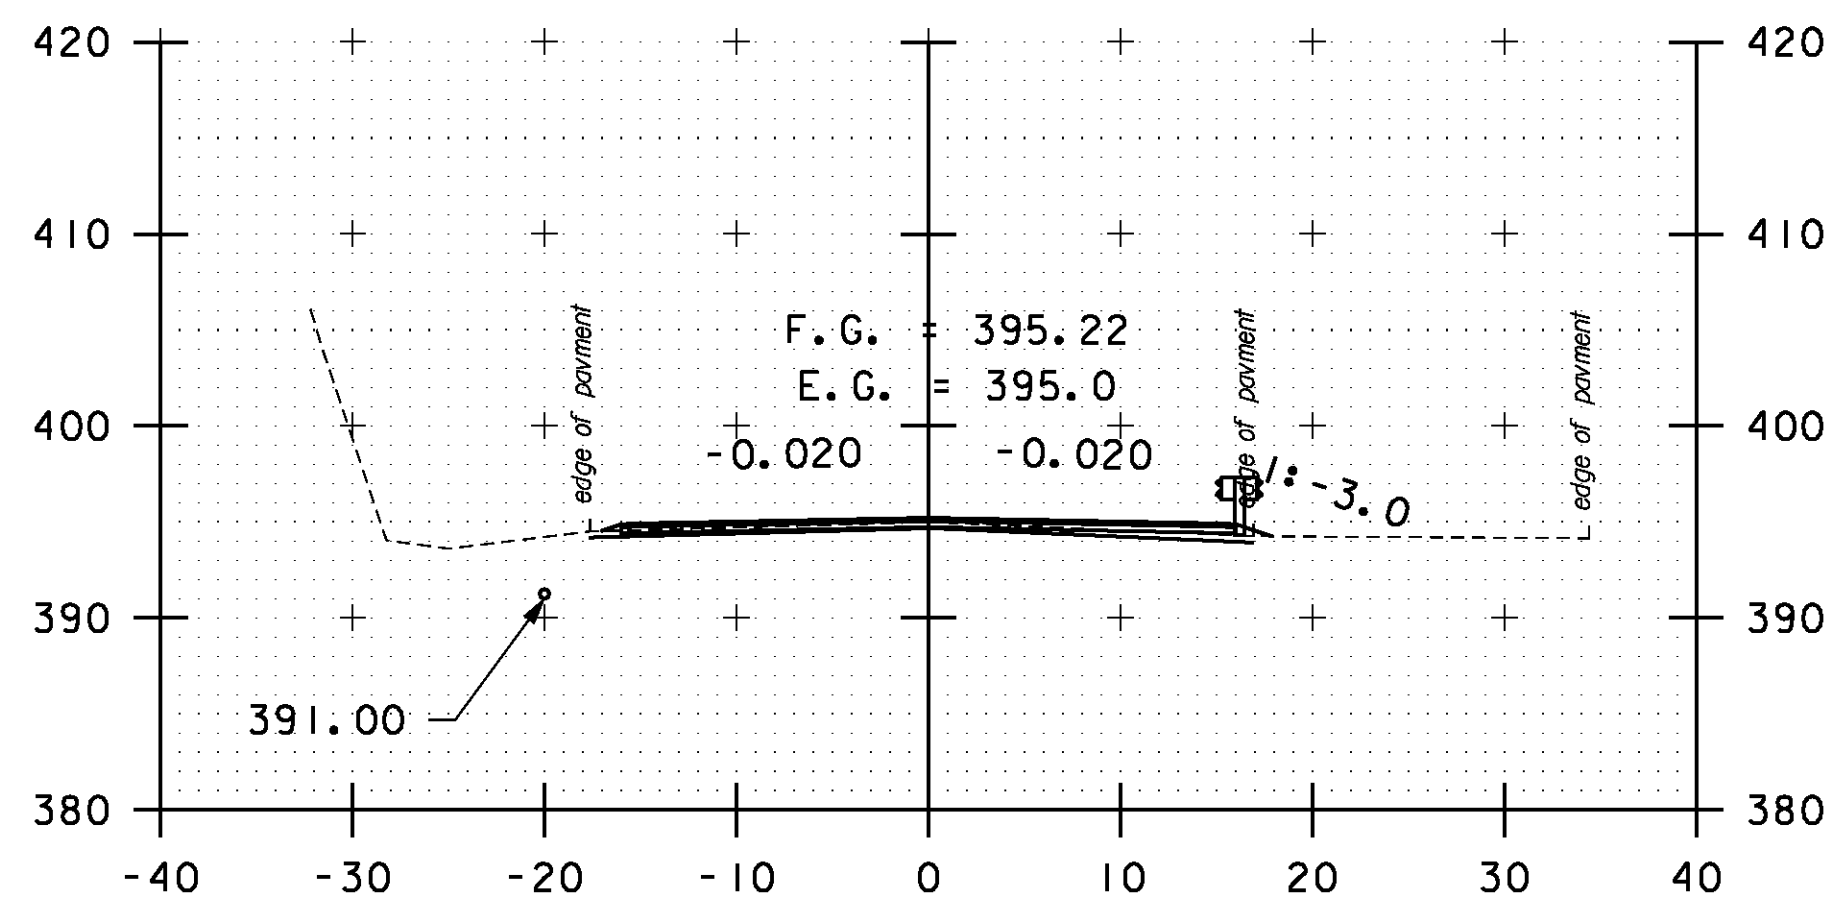


284+00

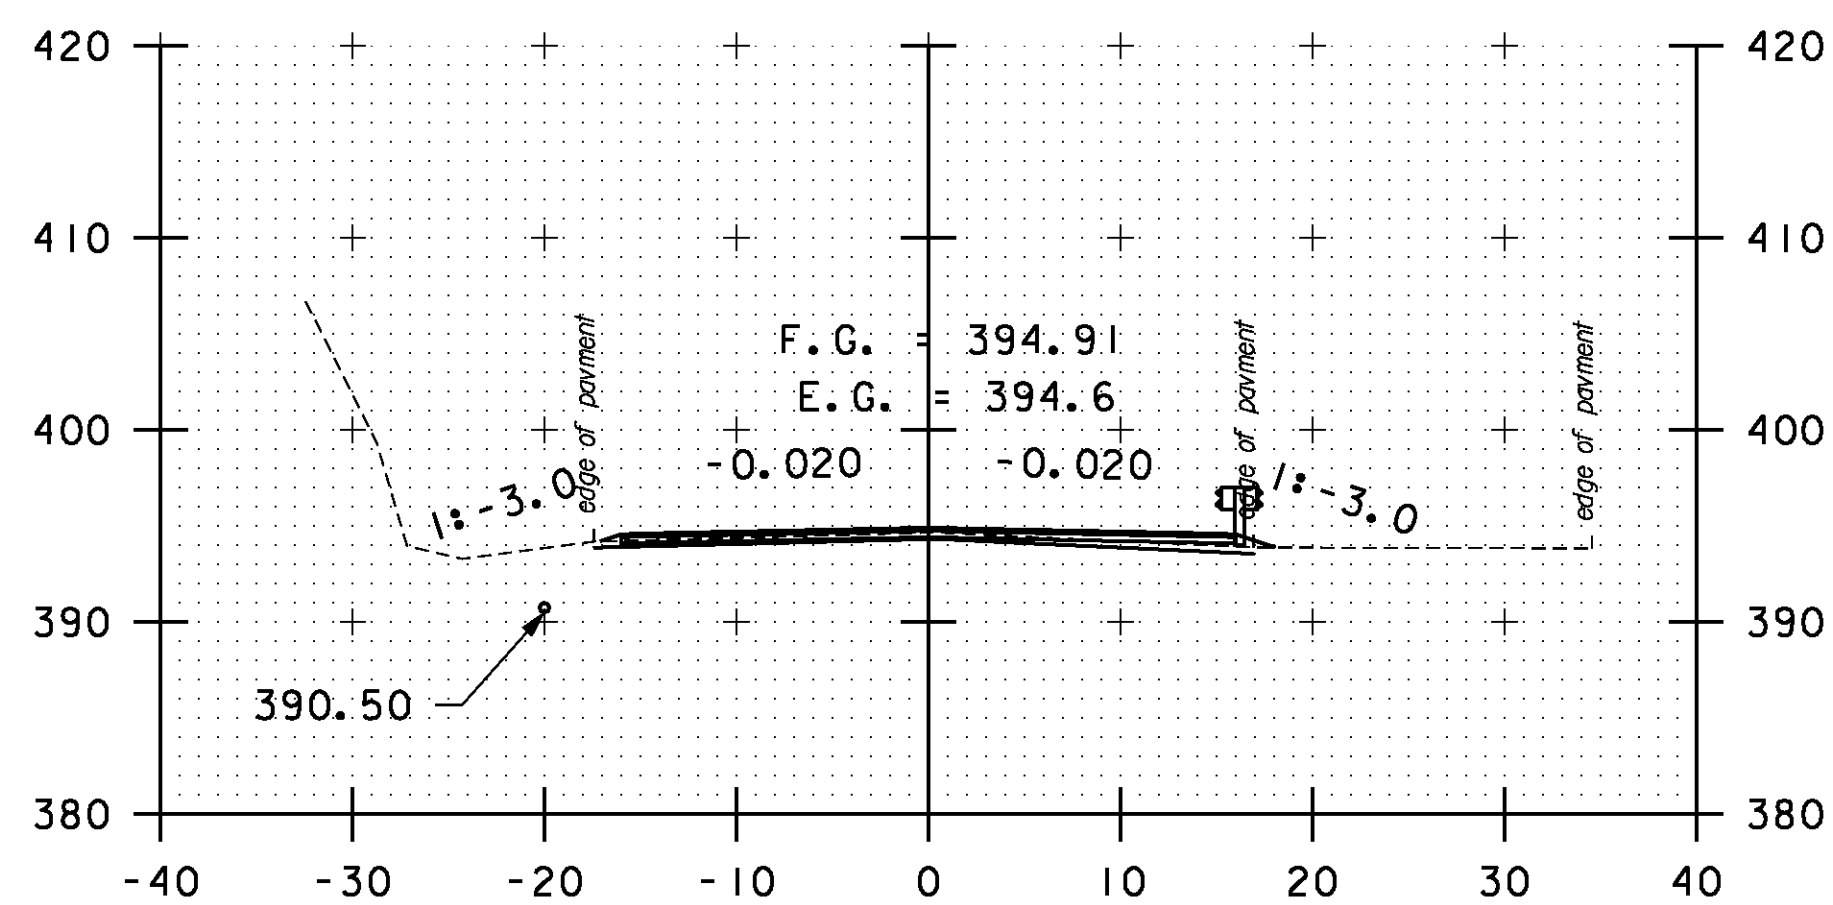


283+50

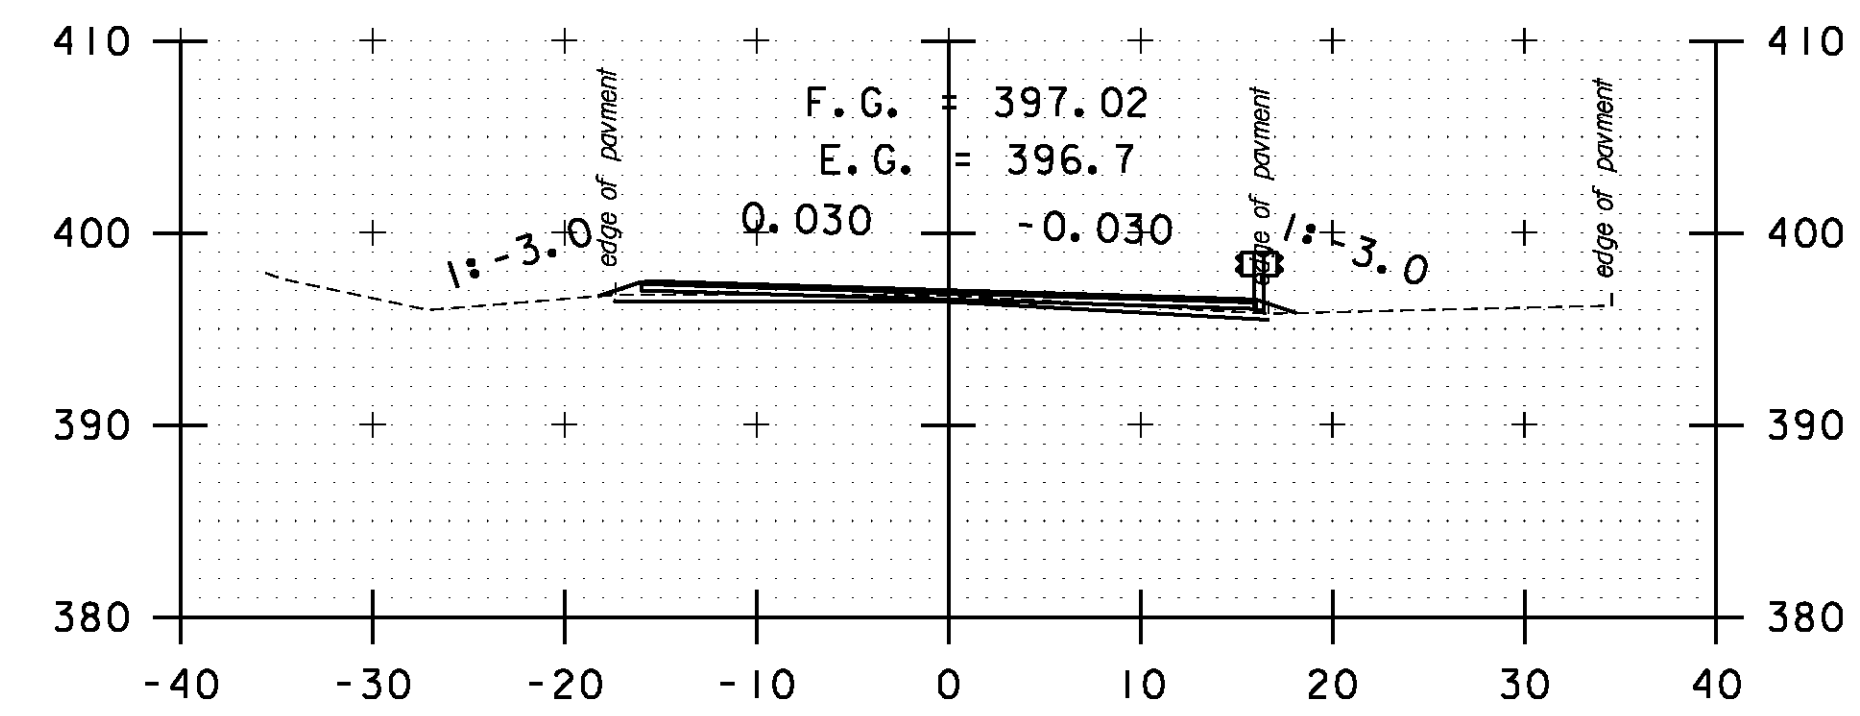

286+00

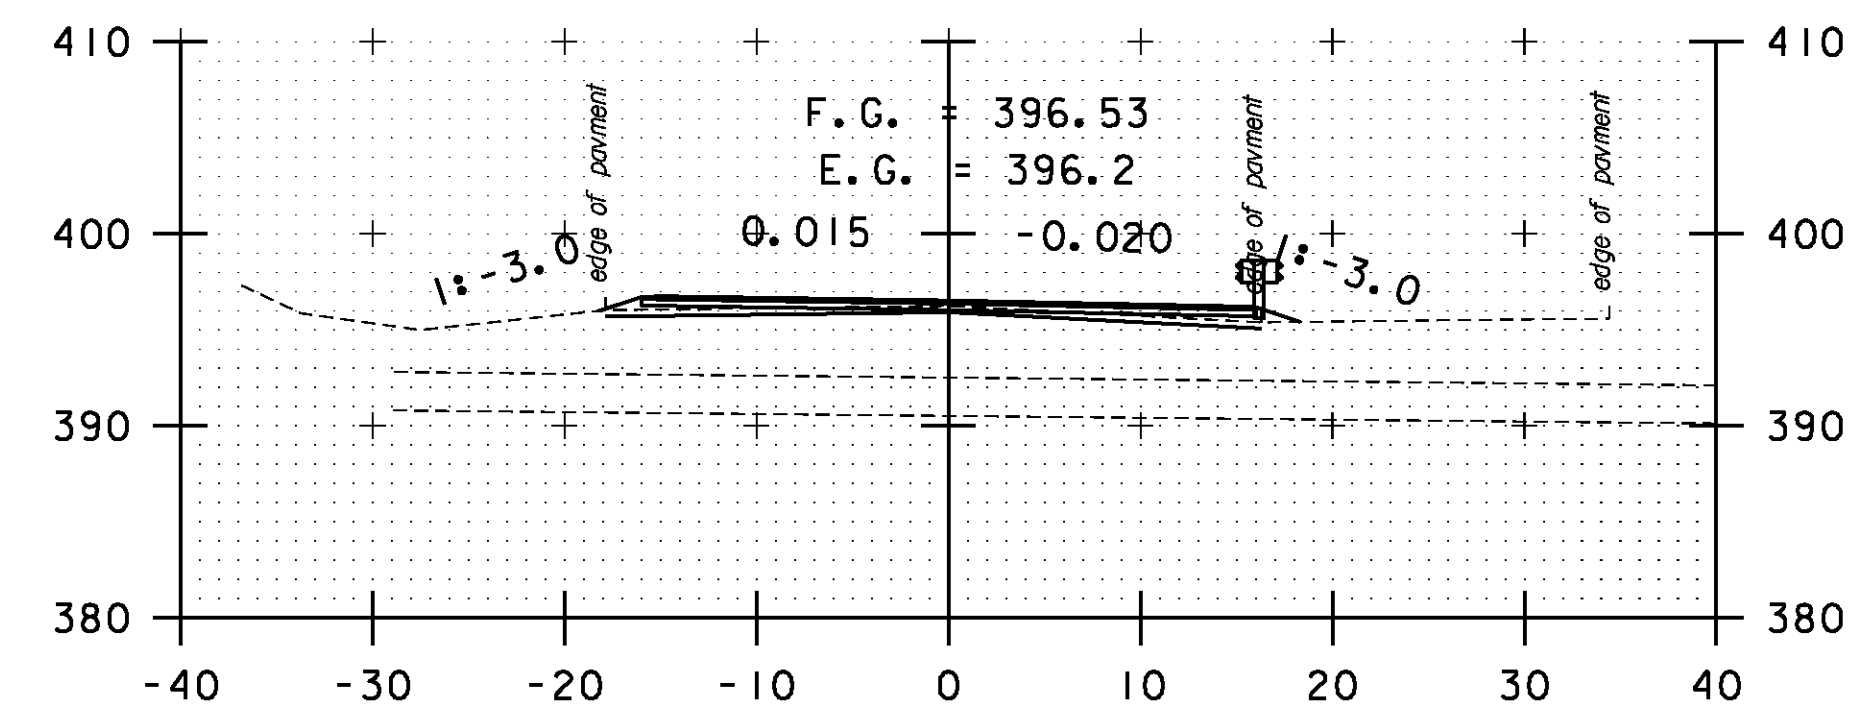

285+50

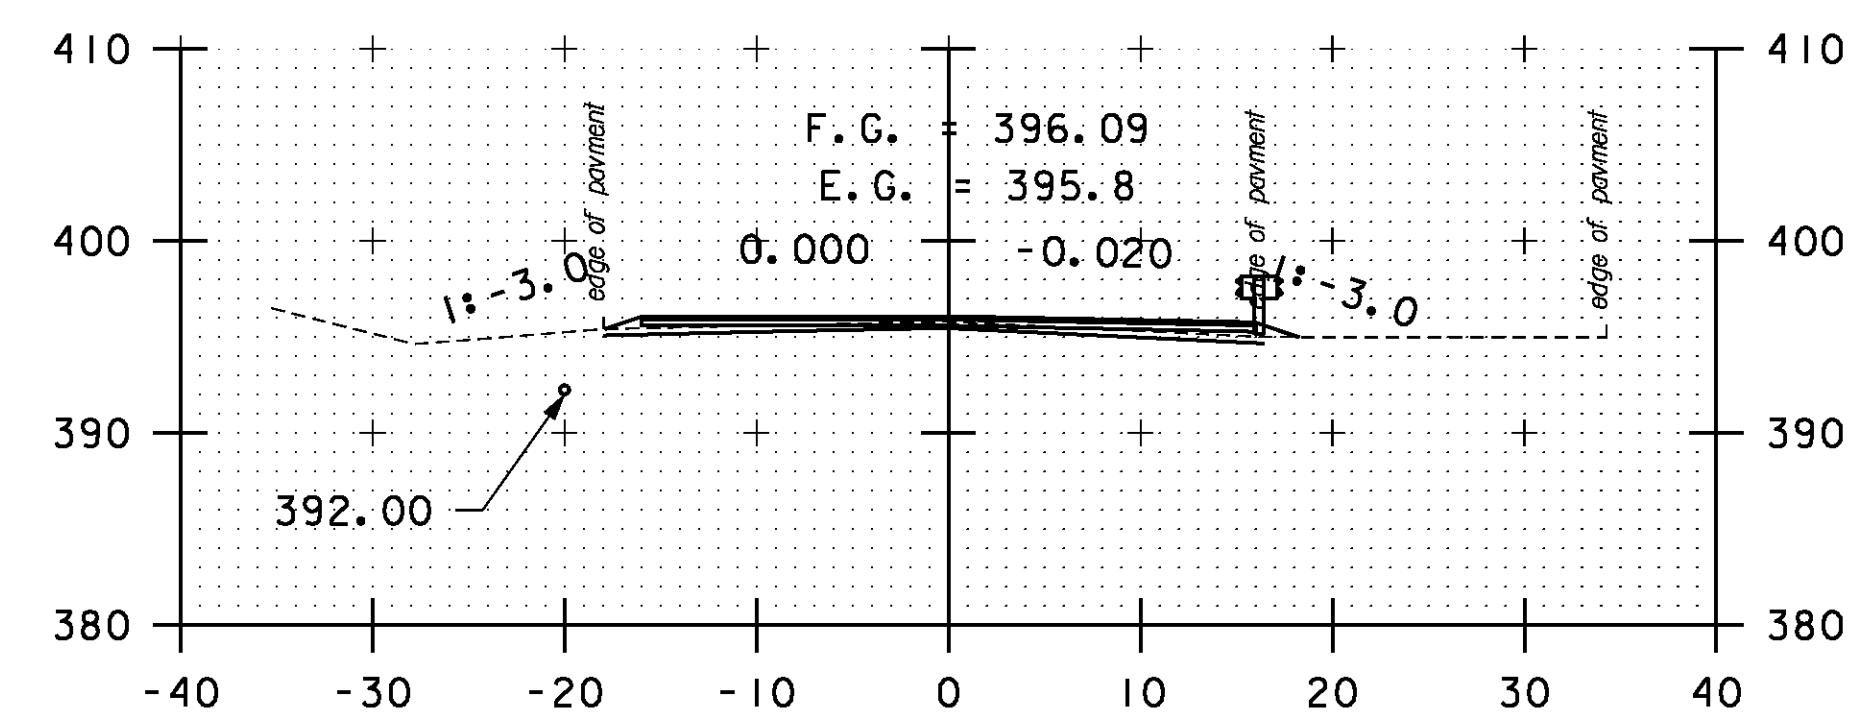

285+00

STA. 282+00 TO STA. 286+00

SCALE 1" = 10'-0"

CROSS SECTION SHEET 43

PROJECT NAME: BOLTON-WATERBURY

PROJECT NUMBER: STP 2709(1)

FILE NAME: p07C172.dgn

PROJECT LEADER: CDL

DESIGNED BY: BMB

PLOT FILE: p07C172.169.1

PLOT DATE: 4/16/2013

DRAWN BY: BMB

CHECKED BY: CDL

SHEET 169 OF 217