




287+50

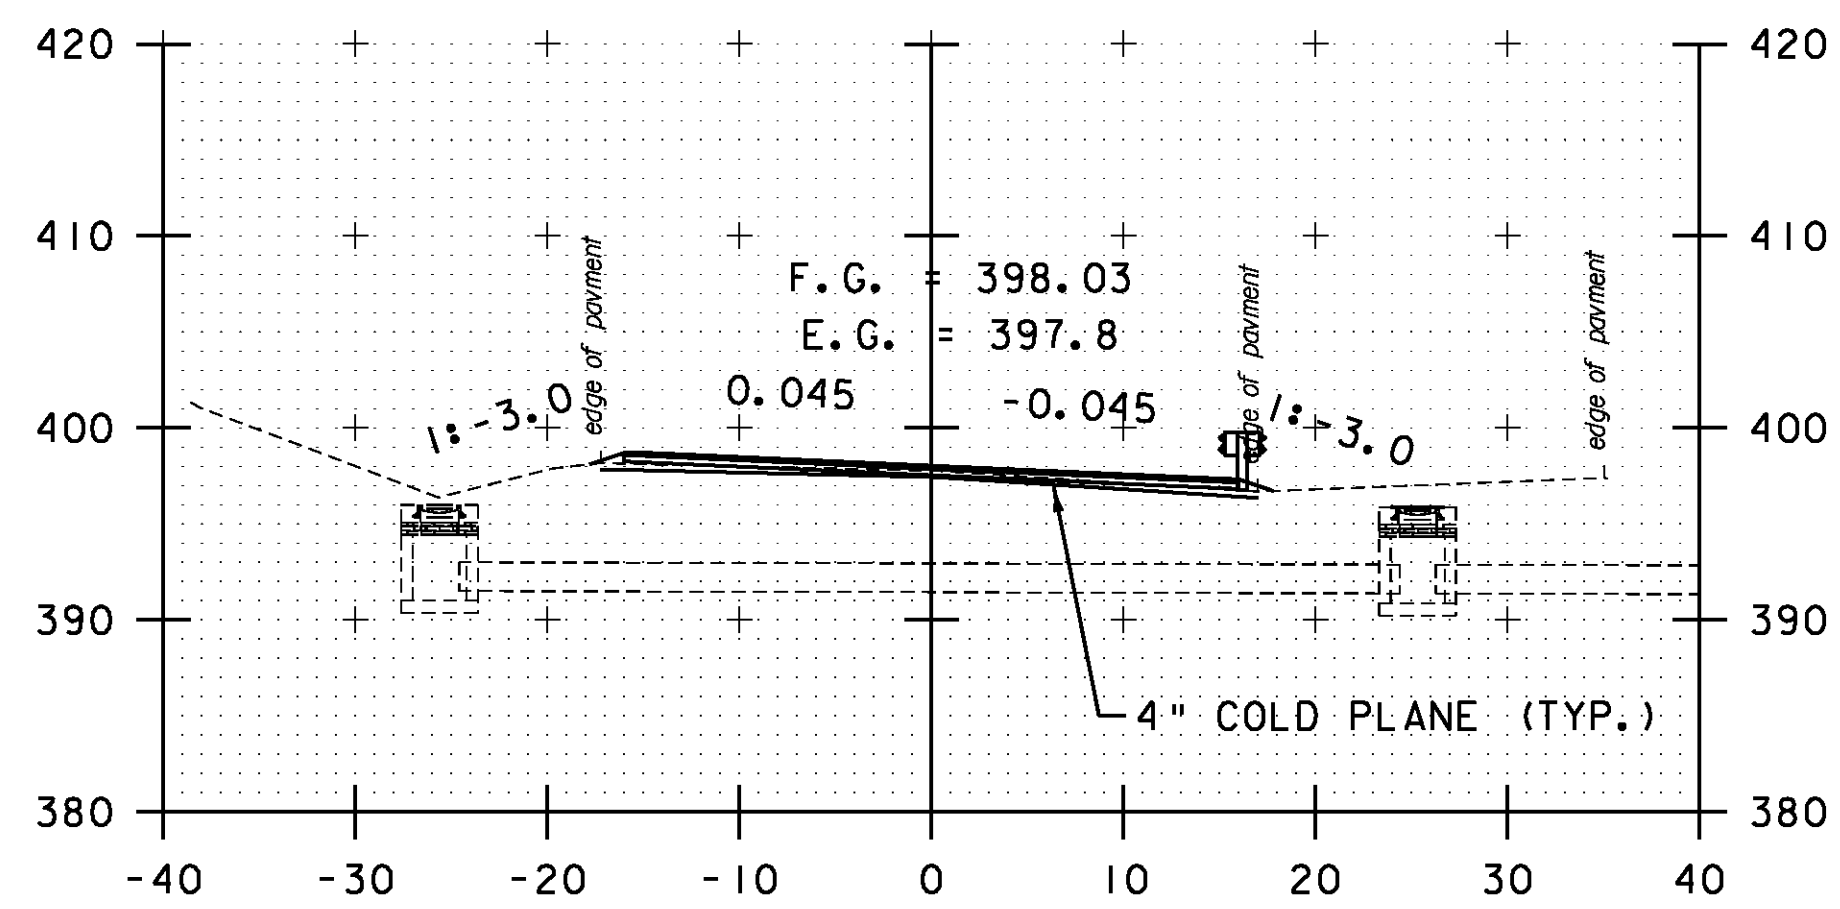


287+00

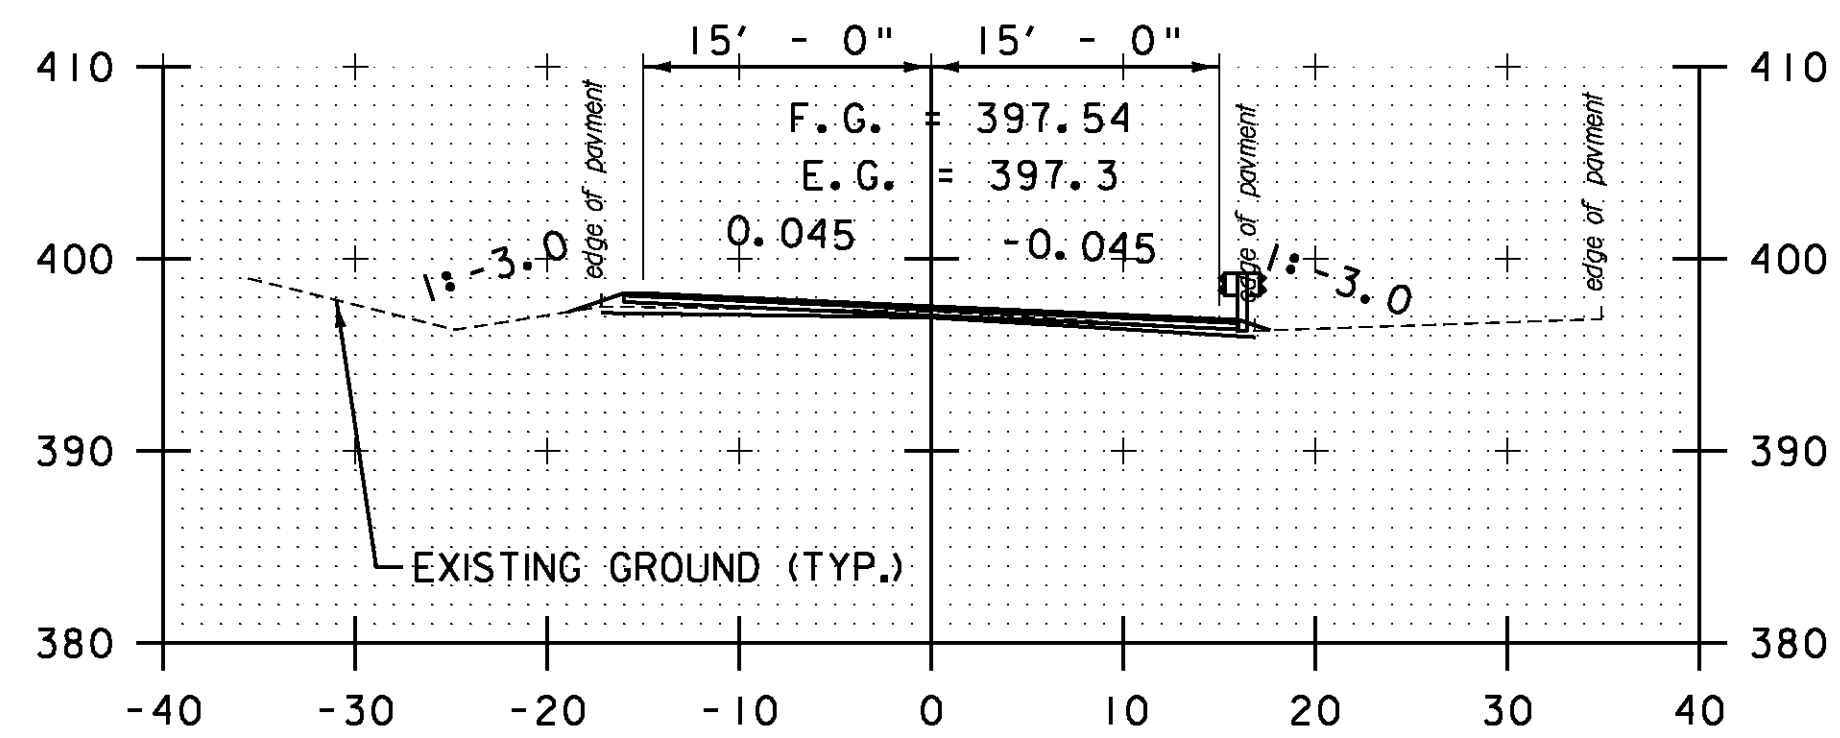


286+50

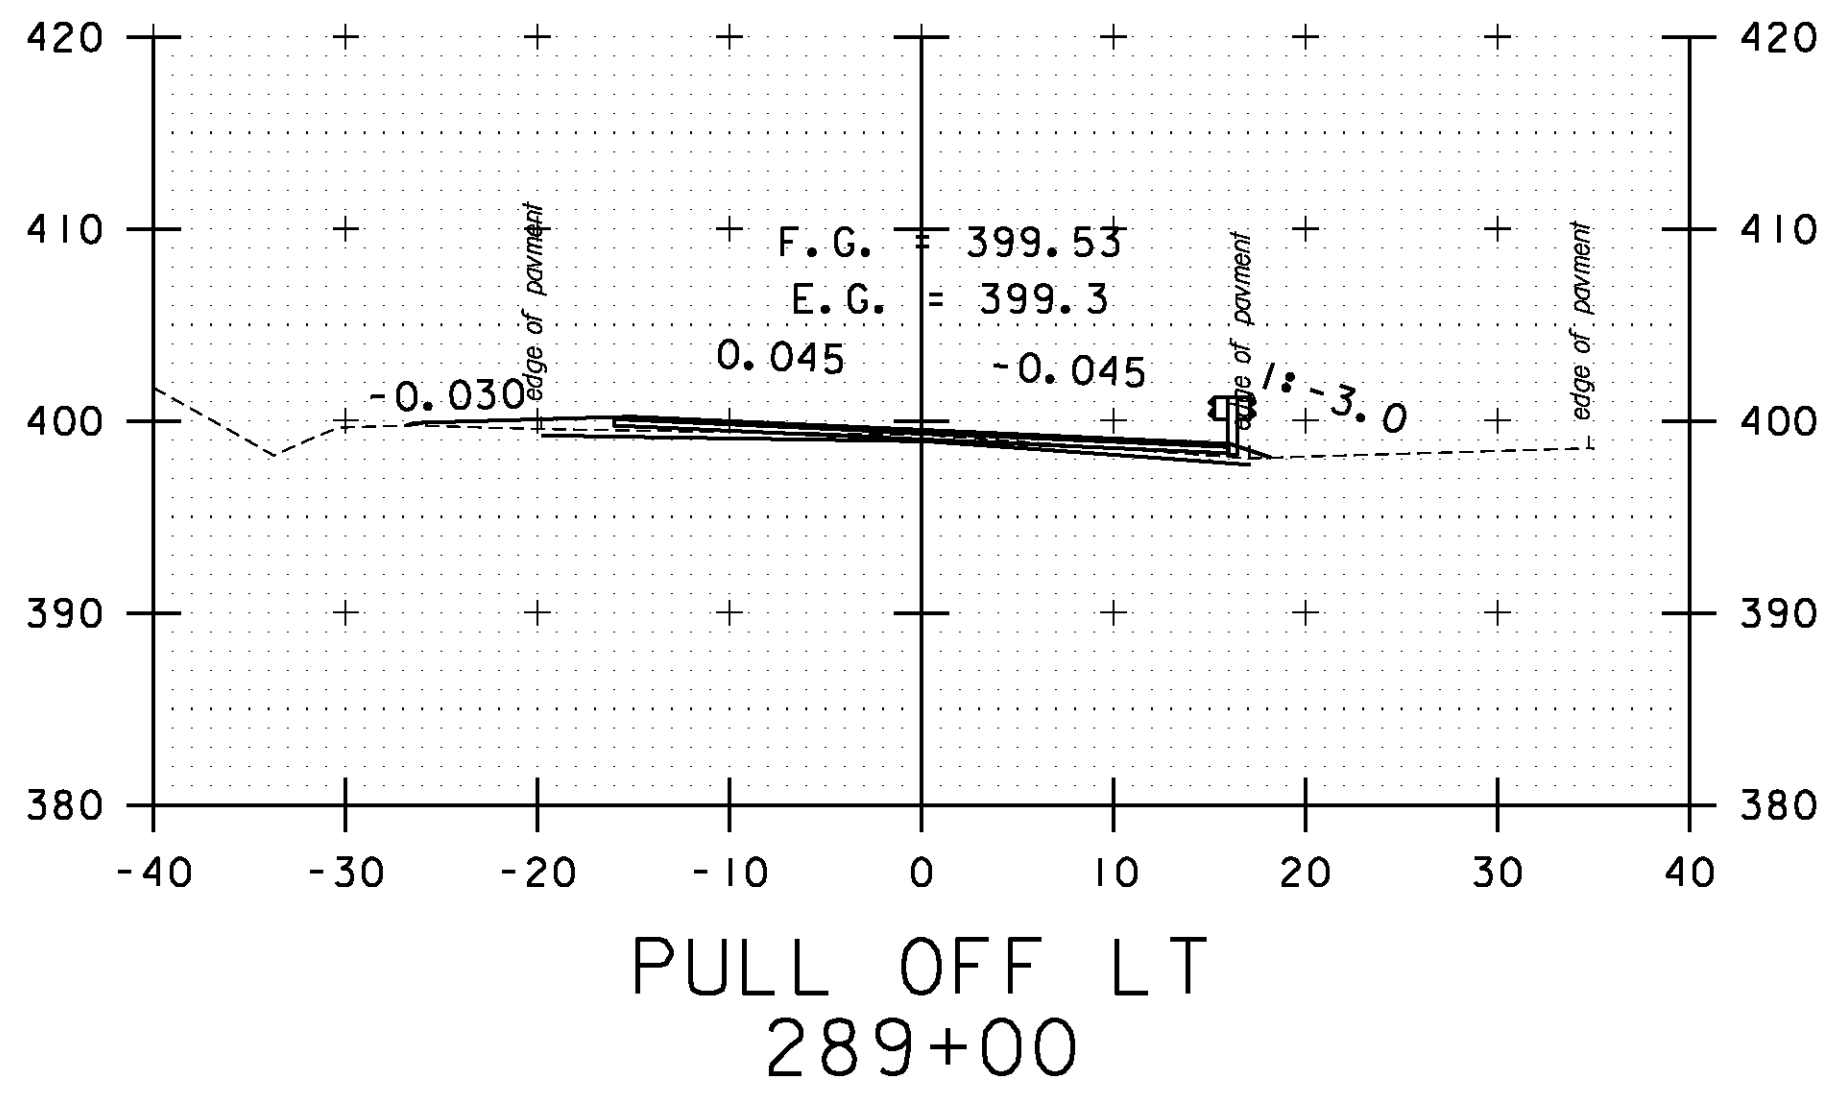


PULL OFF LT
289+00

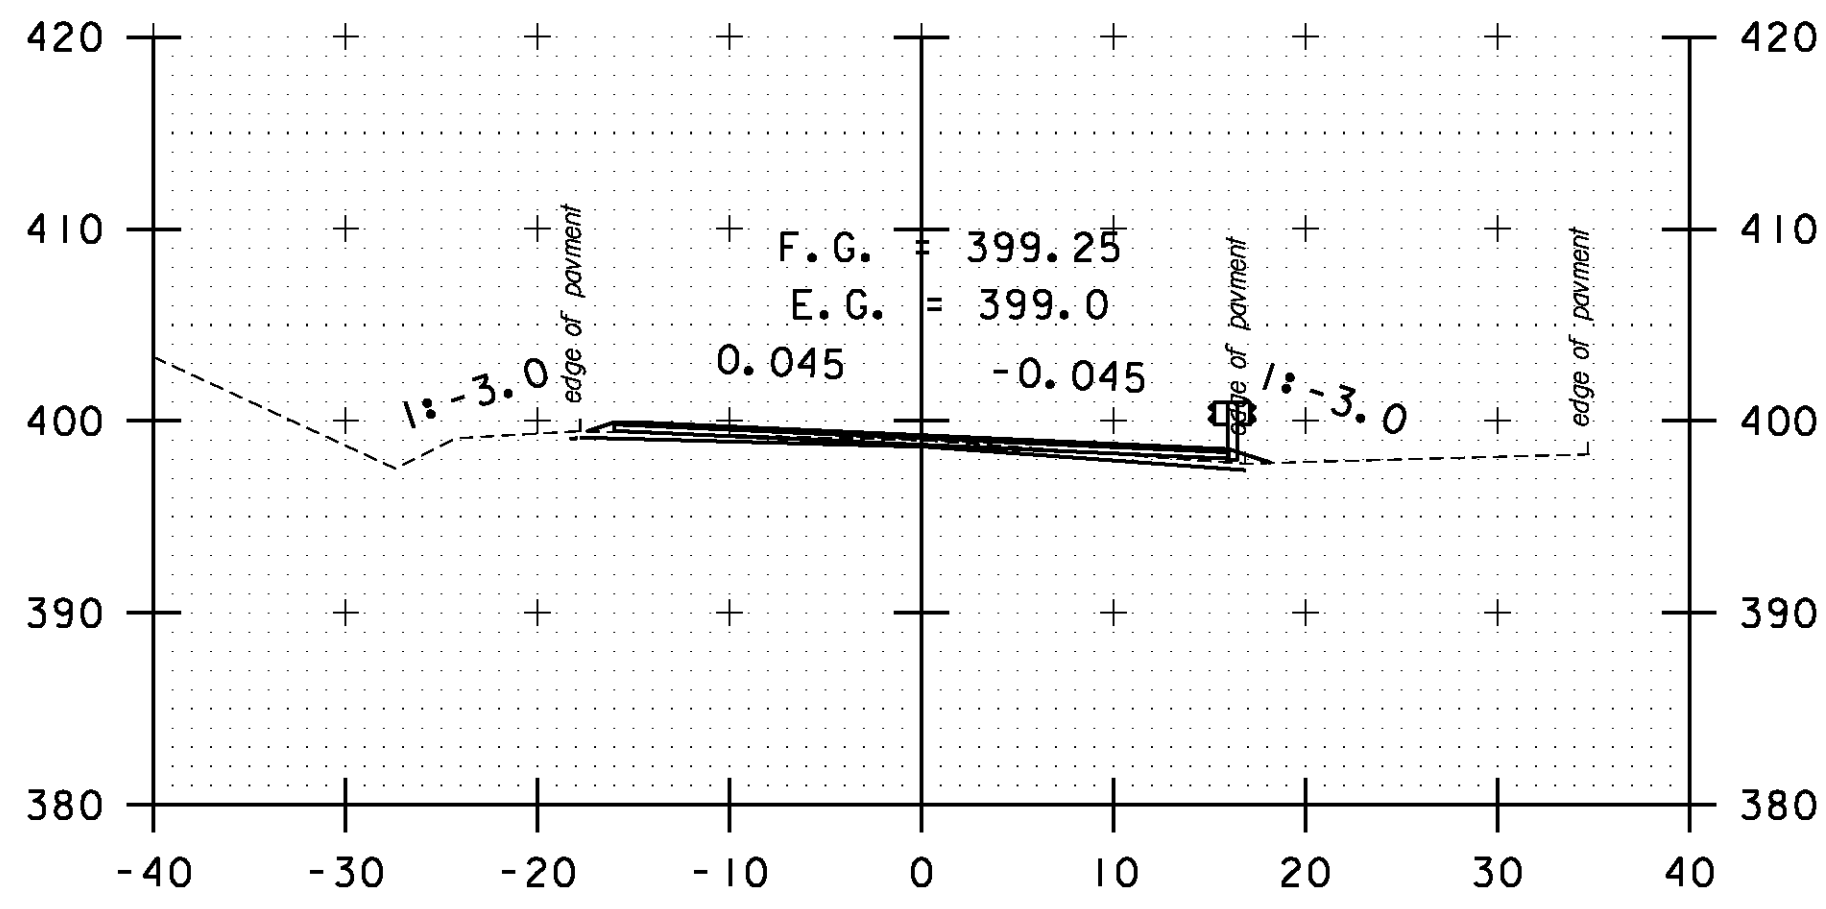


288+50

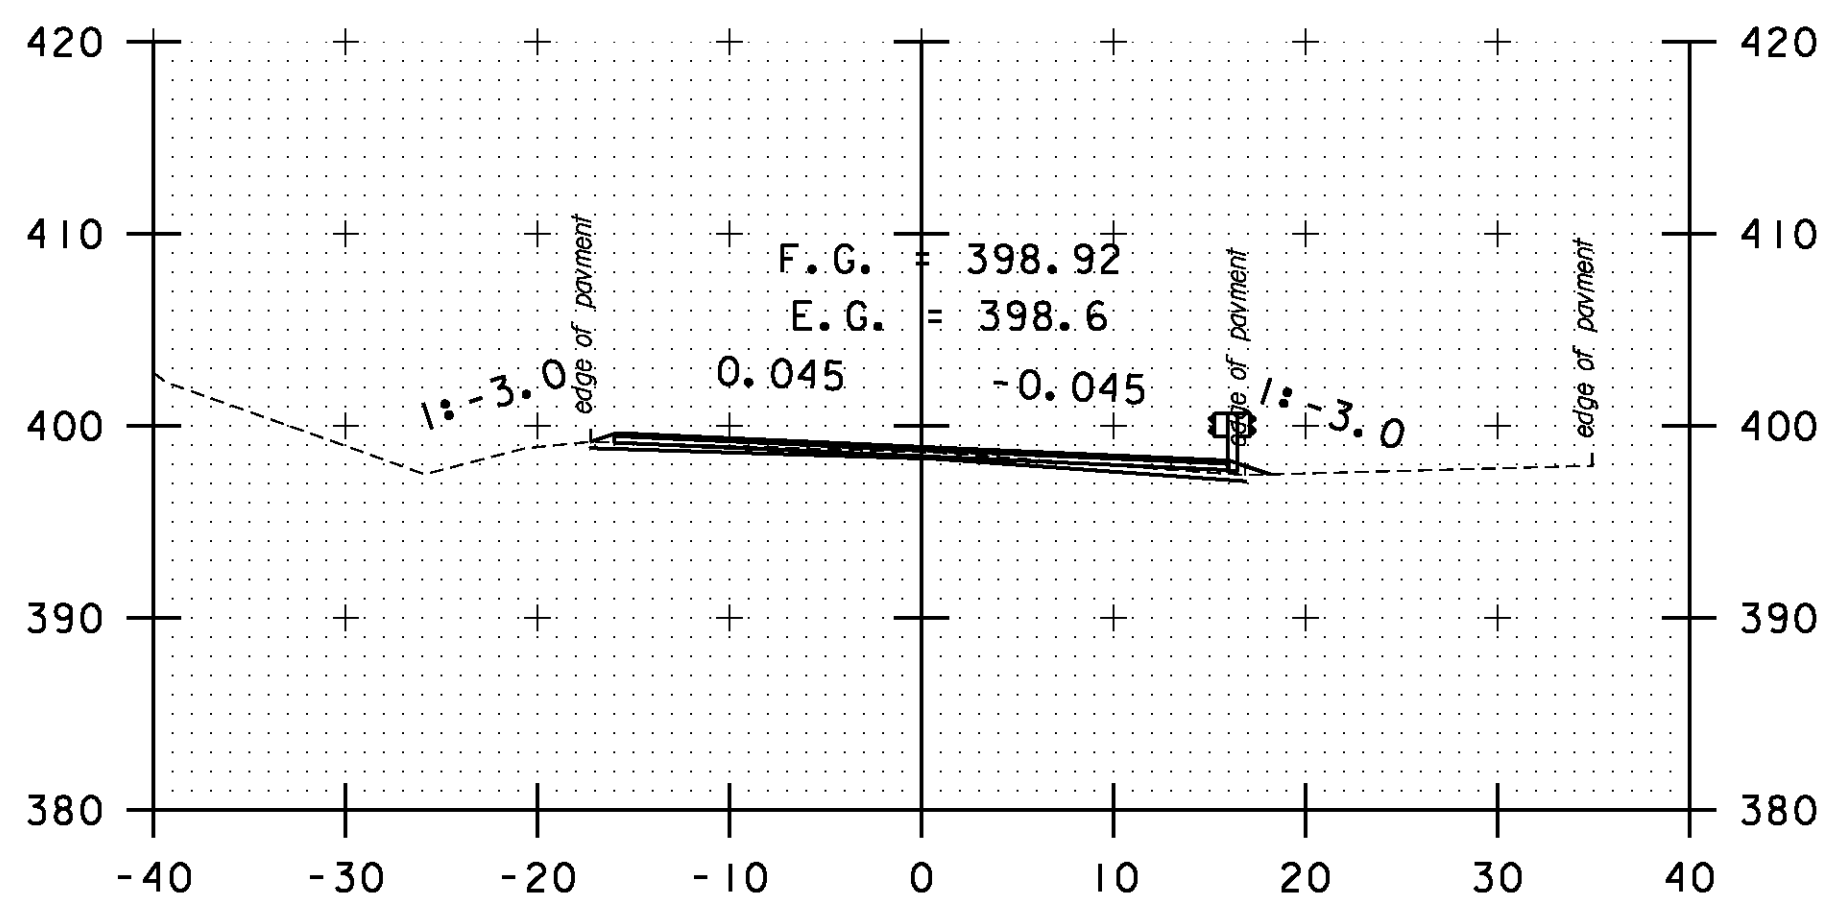


288+00

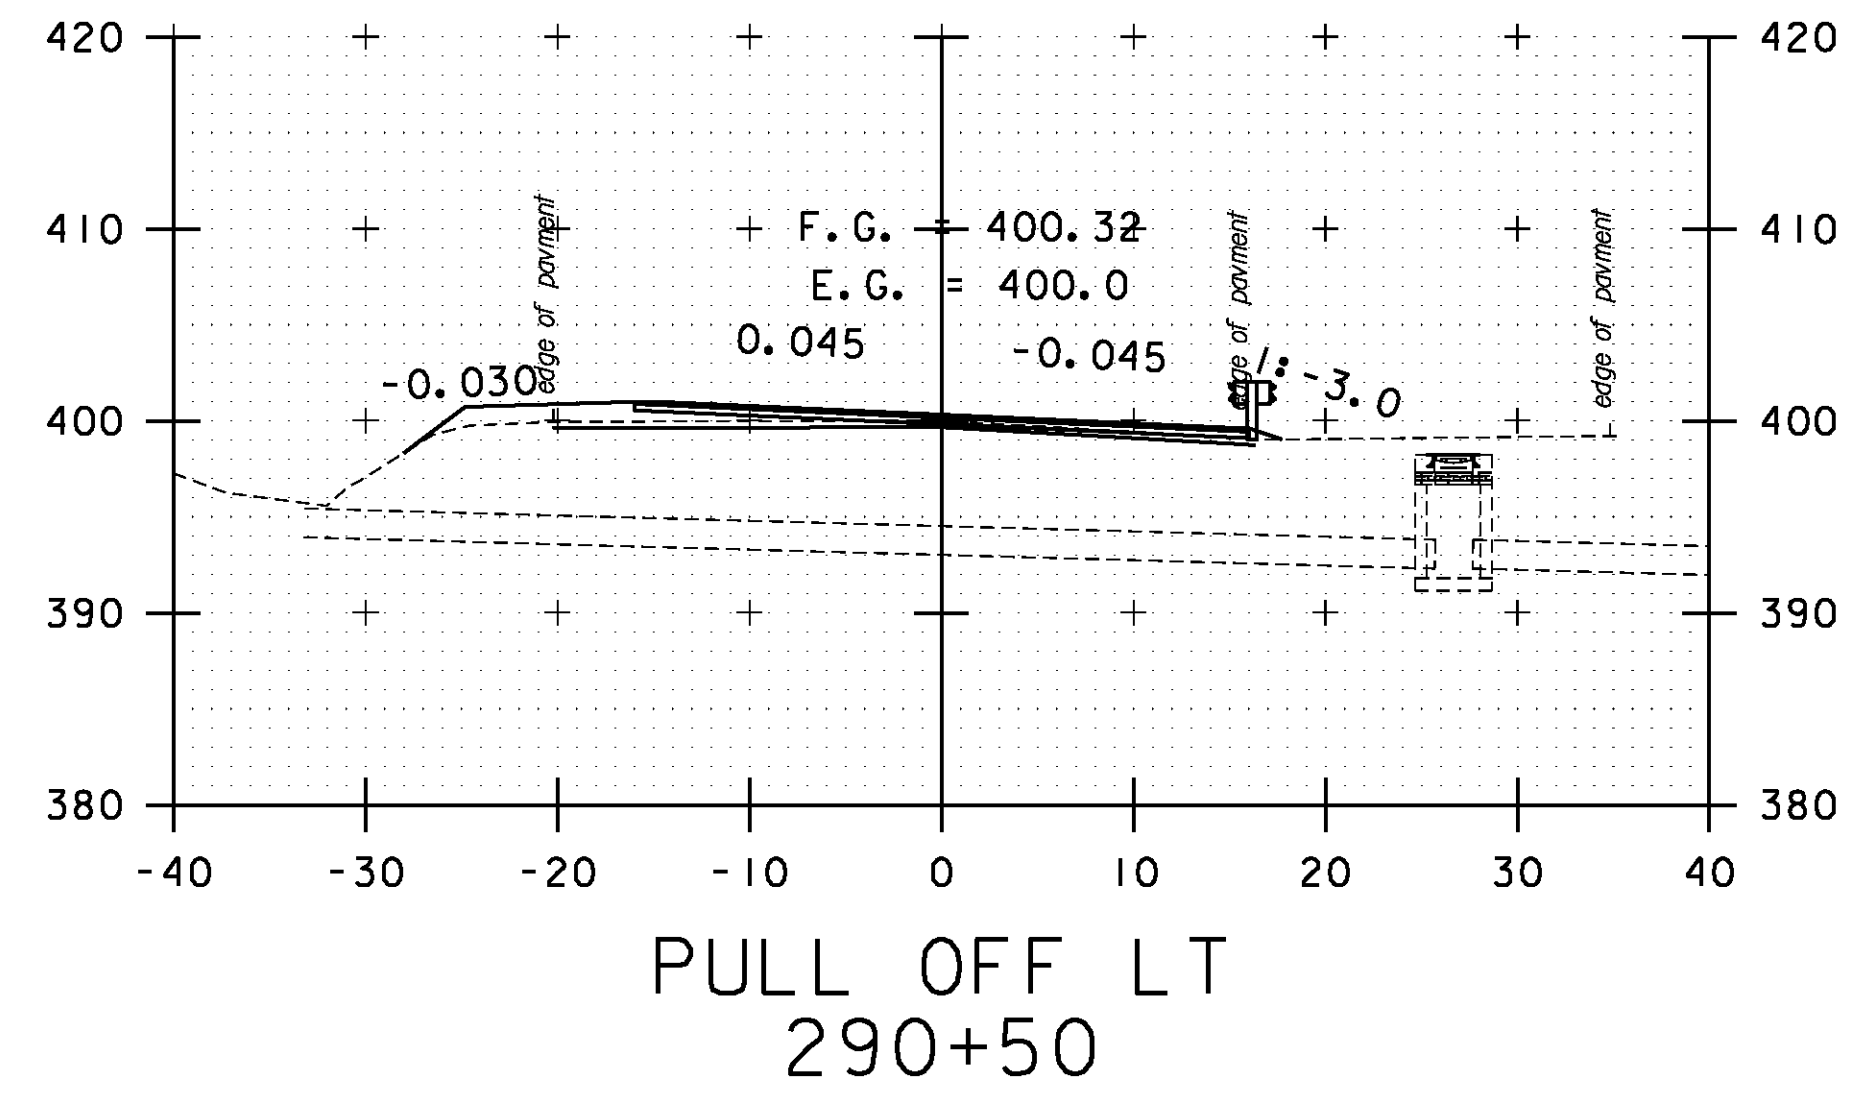

PULL OFF LT
290+50

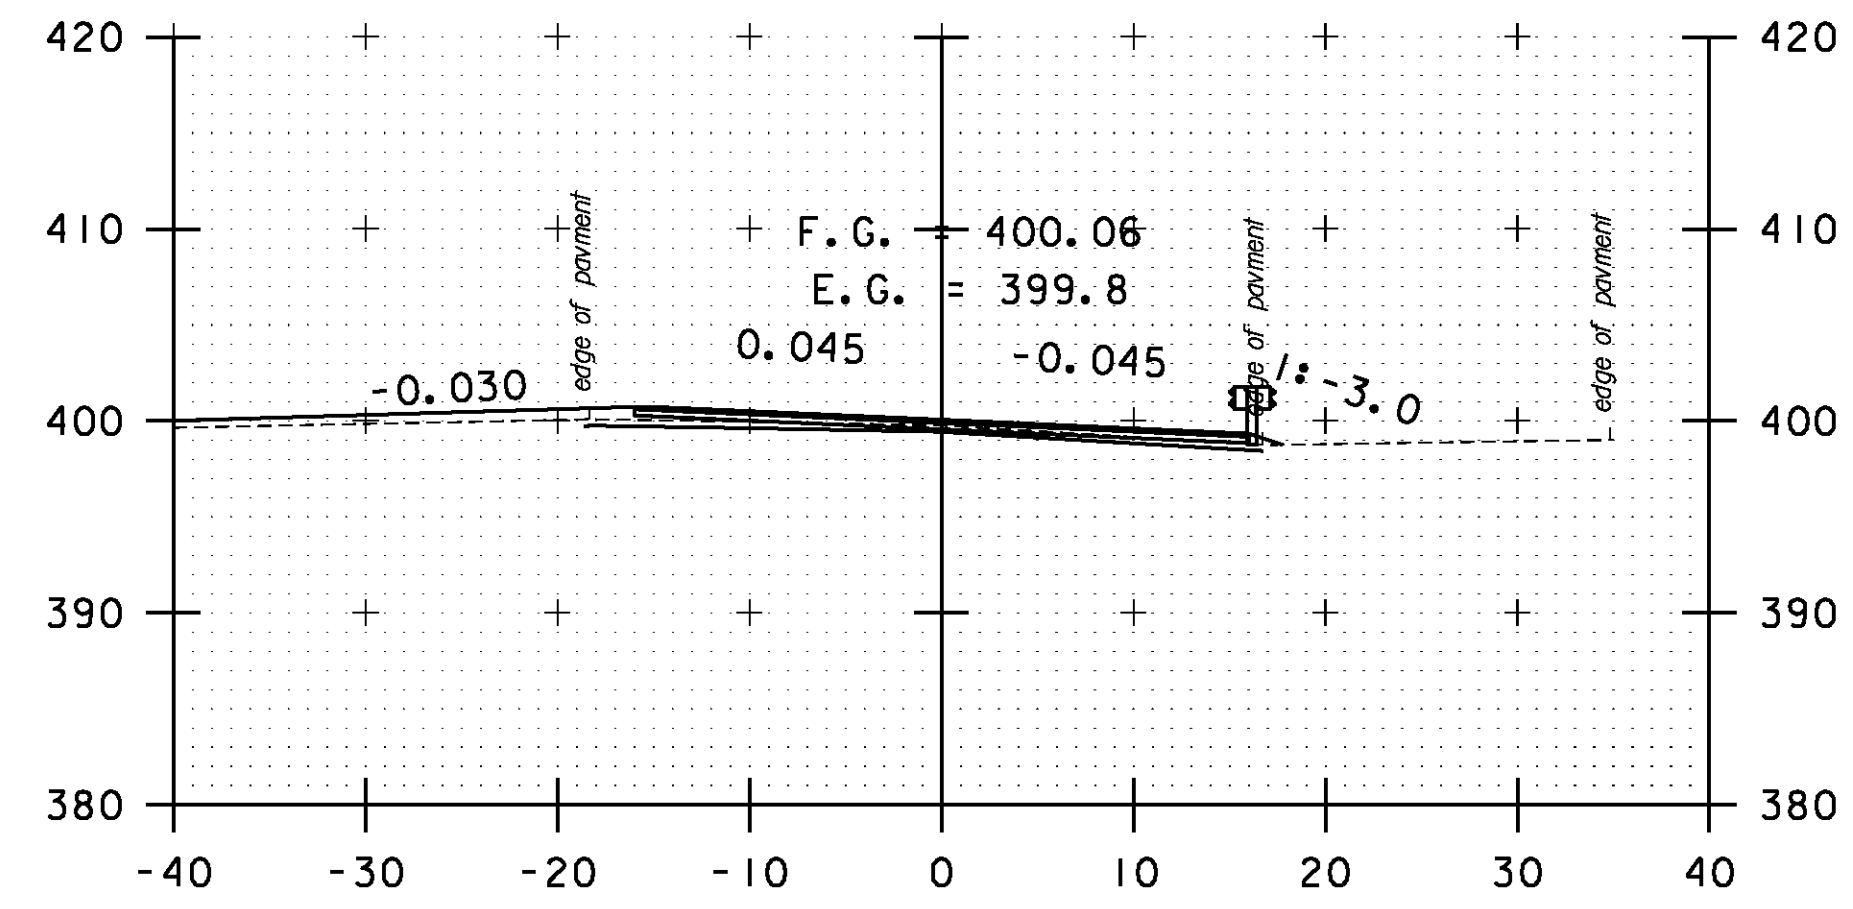

PULL OFF LT
290+00

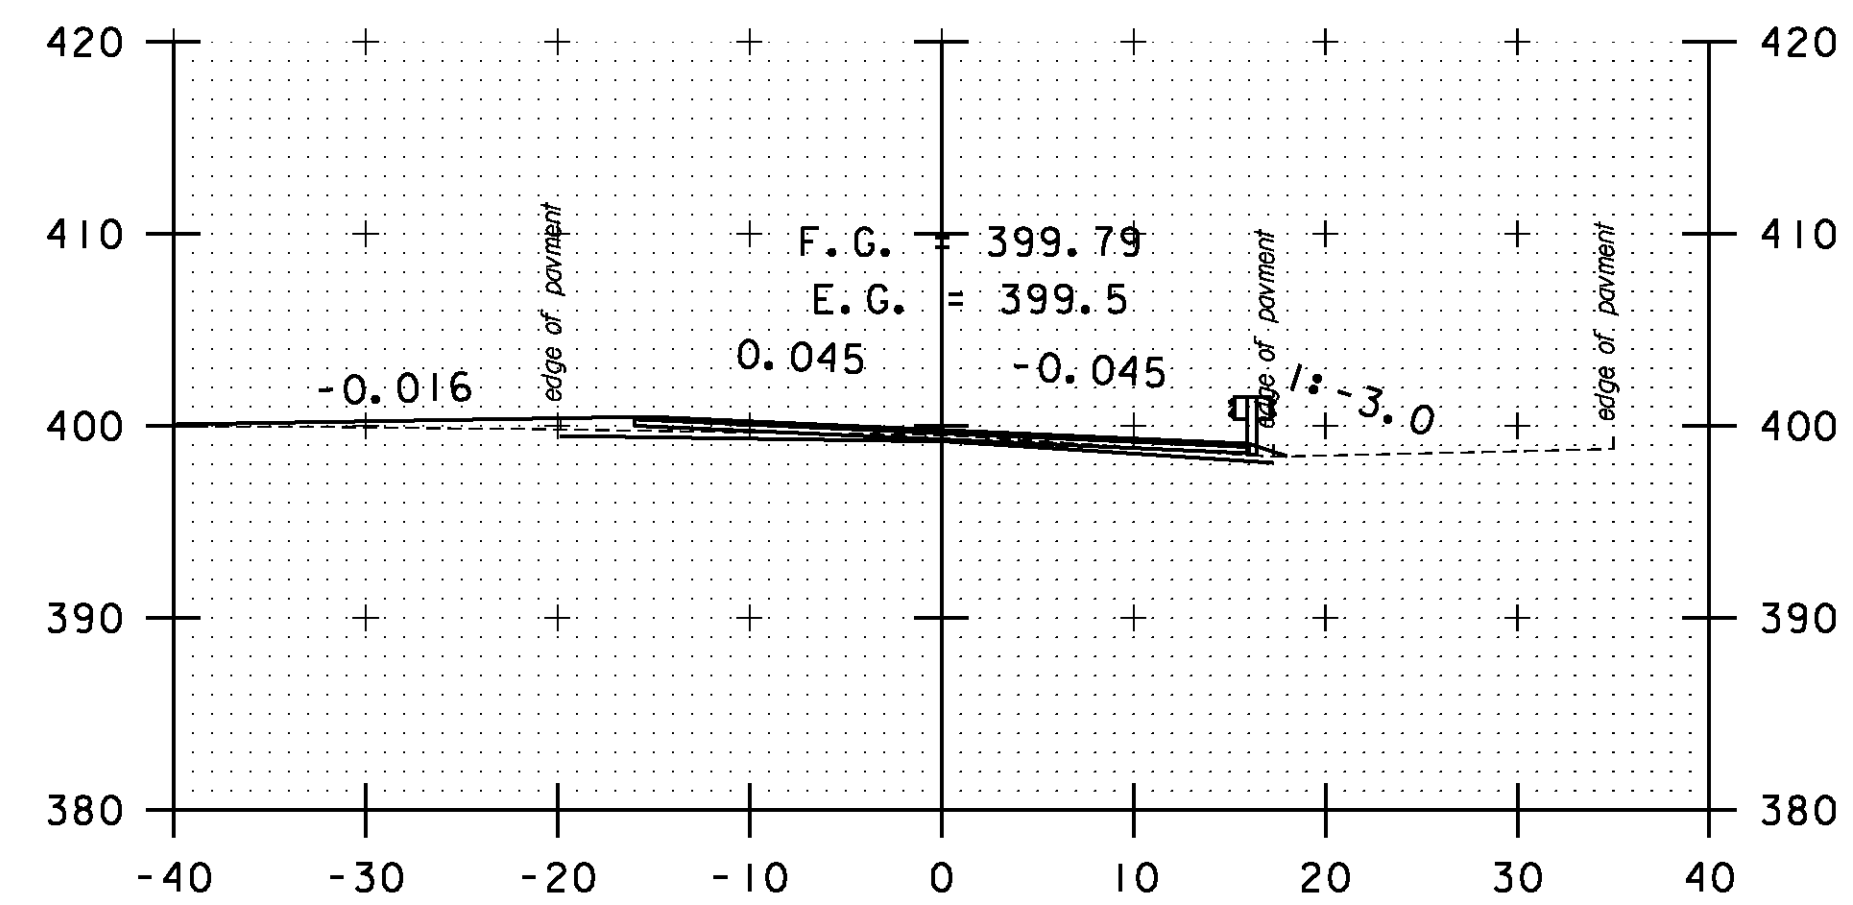

PULL OFF LT
289+50

STA. 286+50 TO STA. 290+50

SCALE 1" = 10'-0"
0 10

CROSS SECTION SHEET 44

PROJECT NAME: BOLTON-WATERBURY

PROJECT NUMBER: STP 2709(I)

FILE NAME: p07C172.dgn

PROJECT LEADER: CDL

DESIGNED BY: BMB

PLOT FILE: p07C172_I70.1

PLOT DATE: 4/16/2013

DRAWN BY: BMB

CHECKED BY: CDL

SHEET 170 OF 217