




292+00

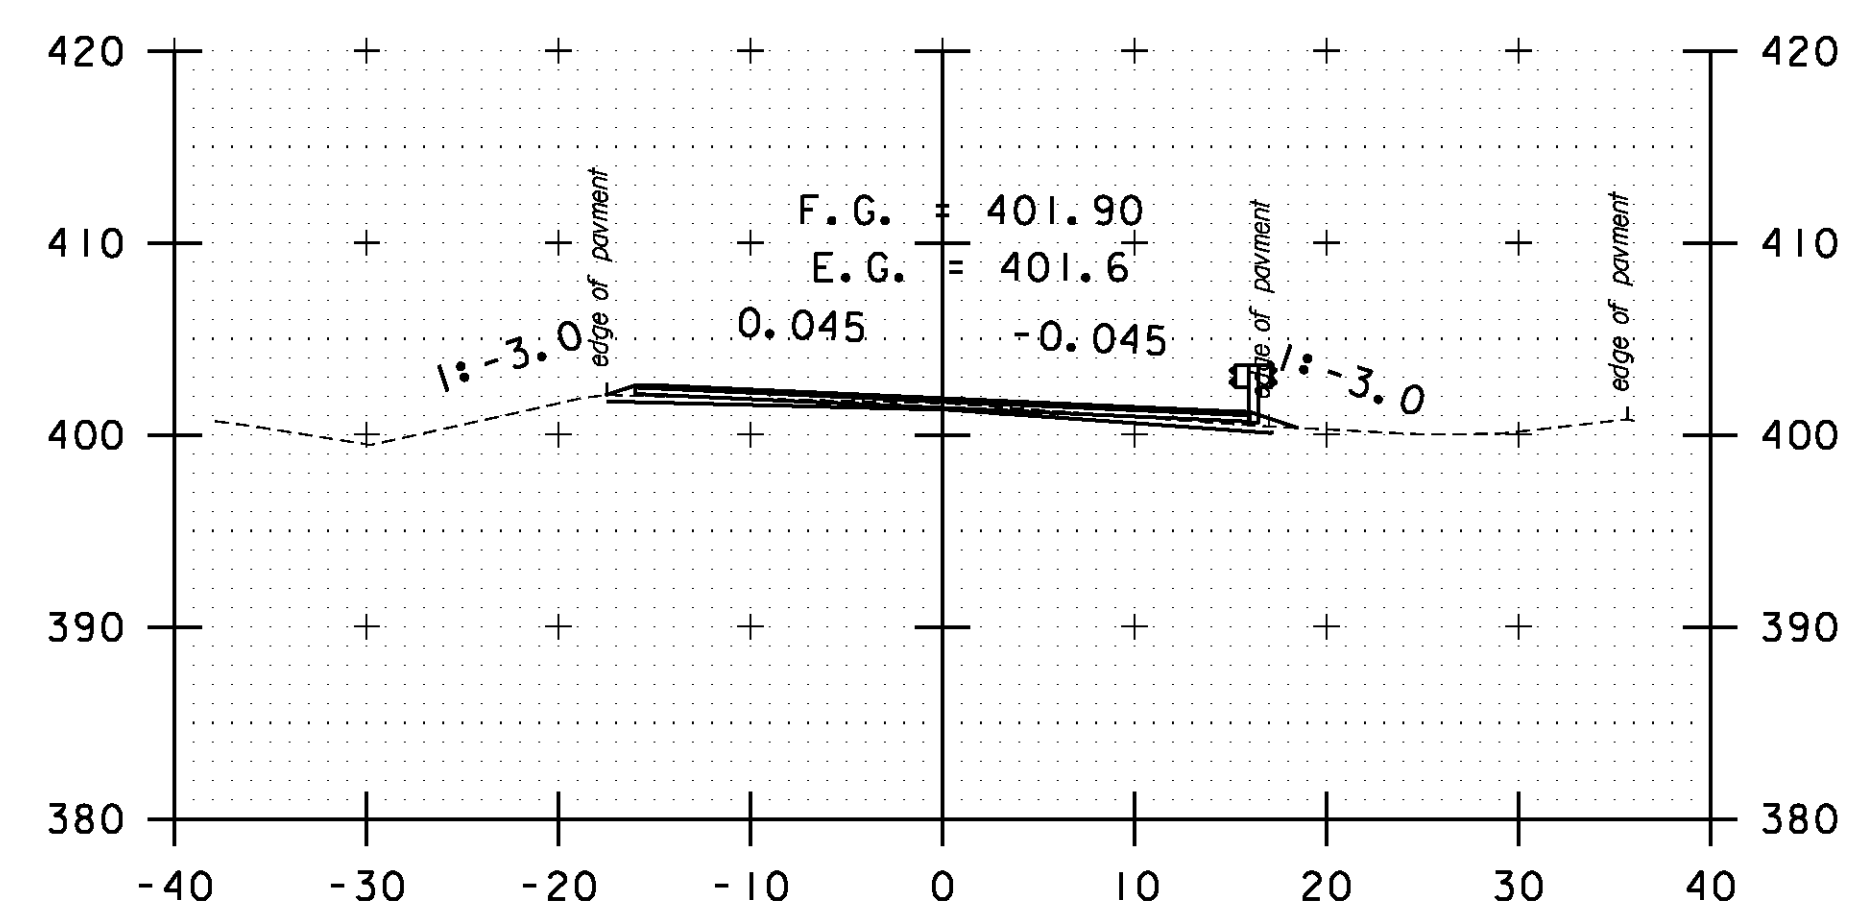


293+50

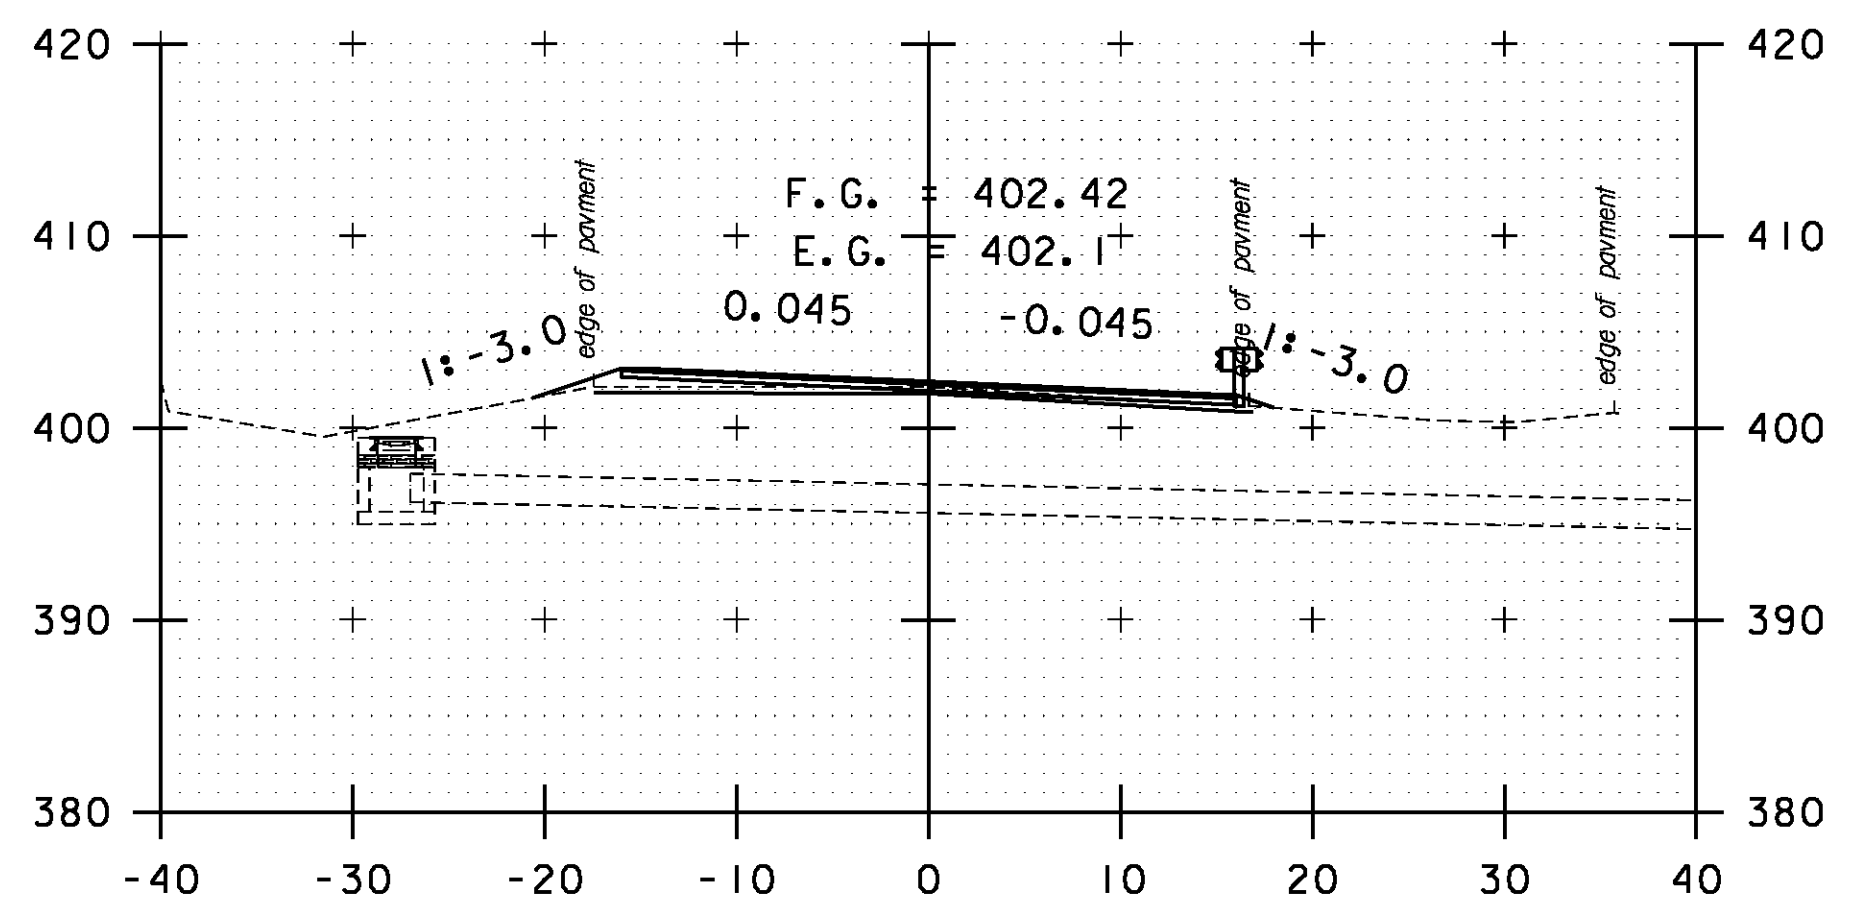


295+00

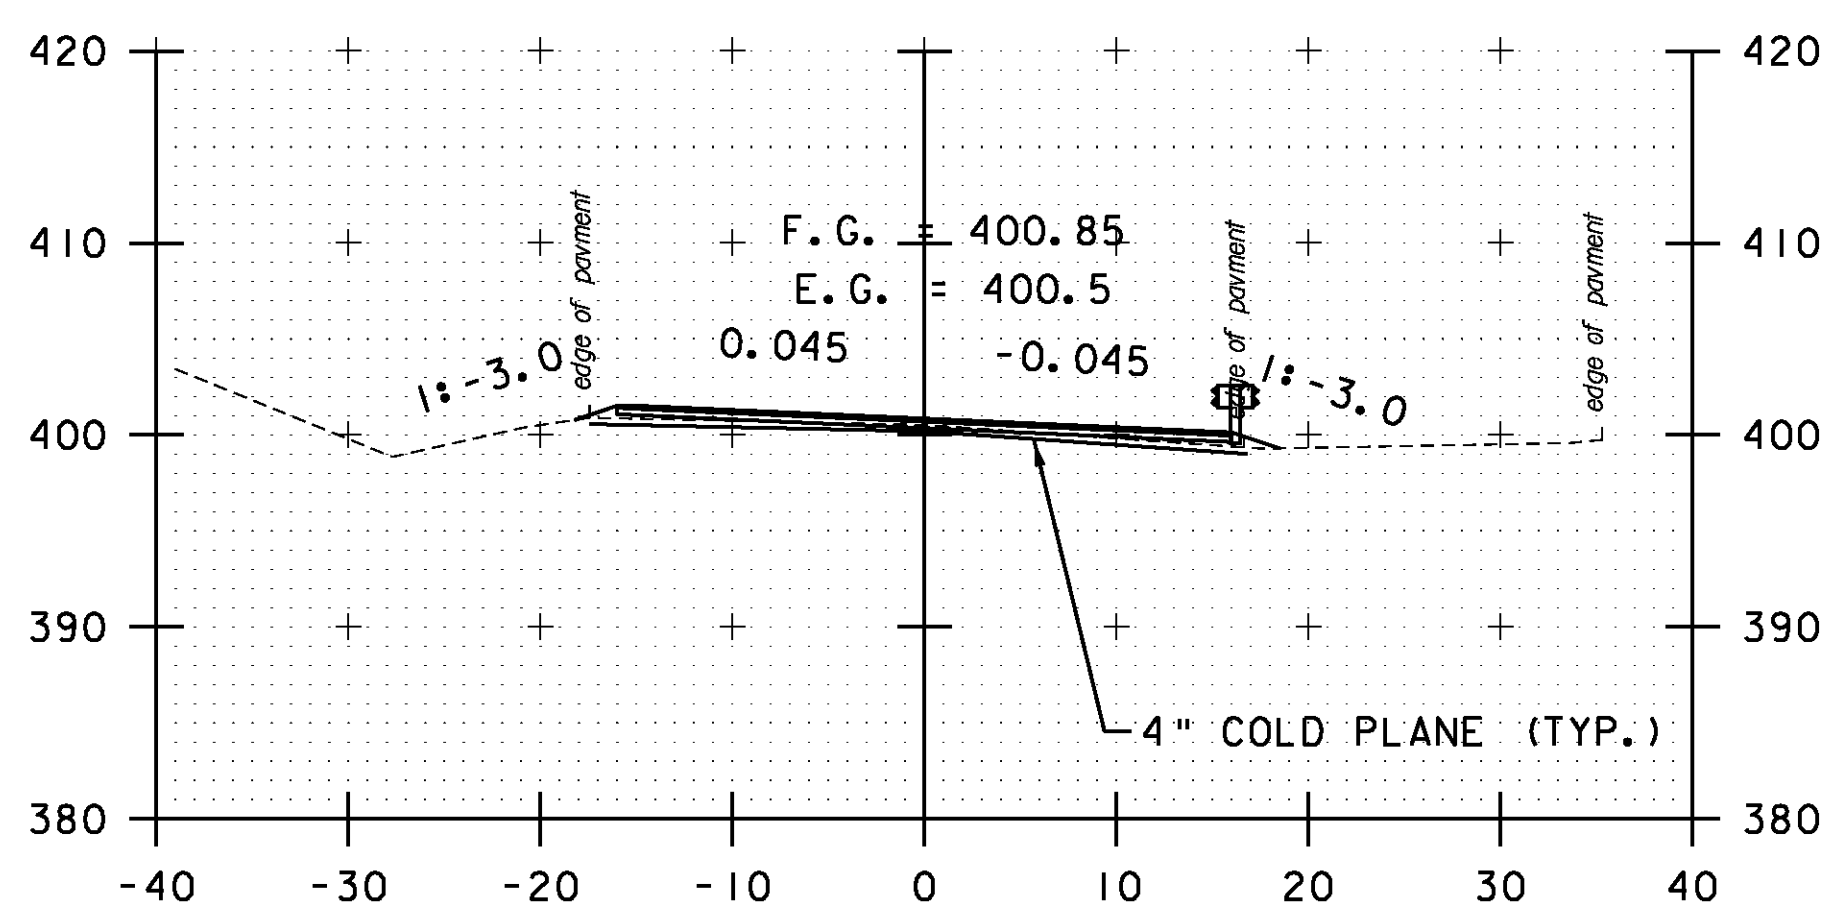


291+50

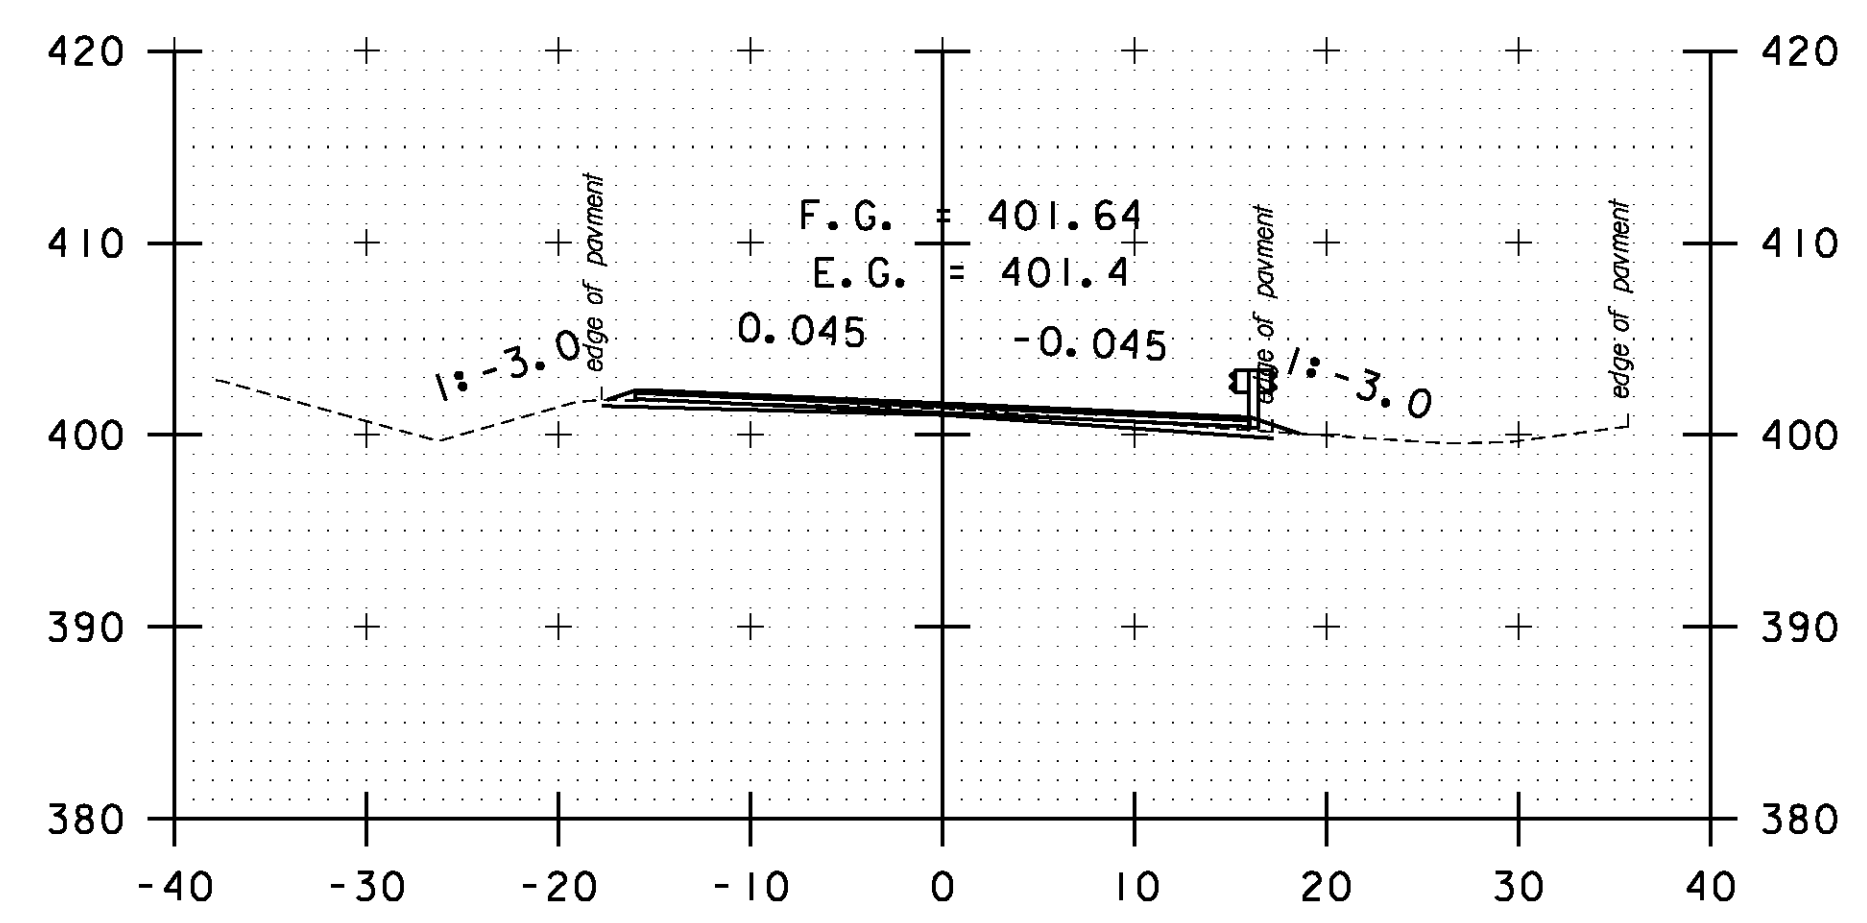


293+00

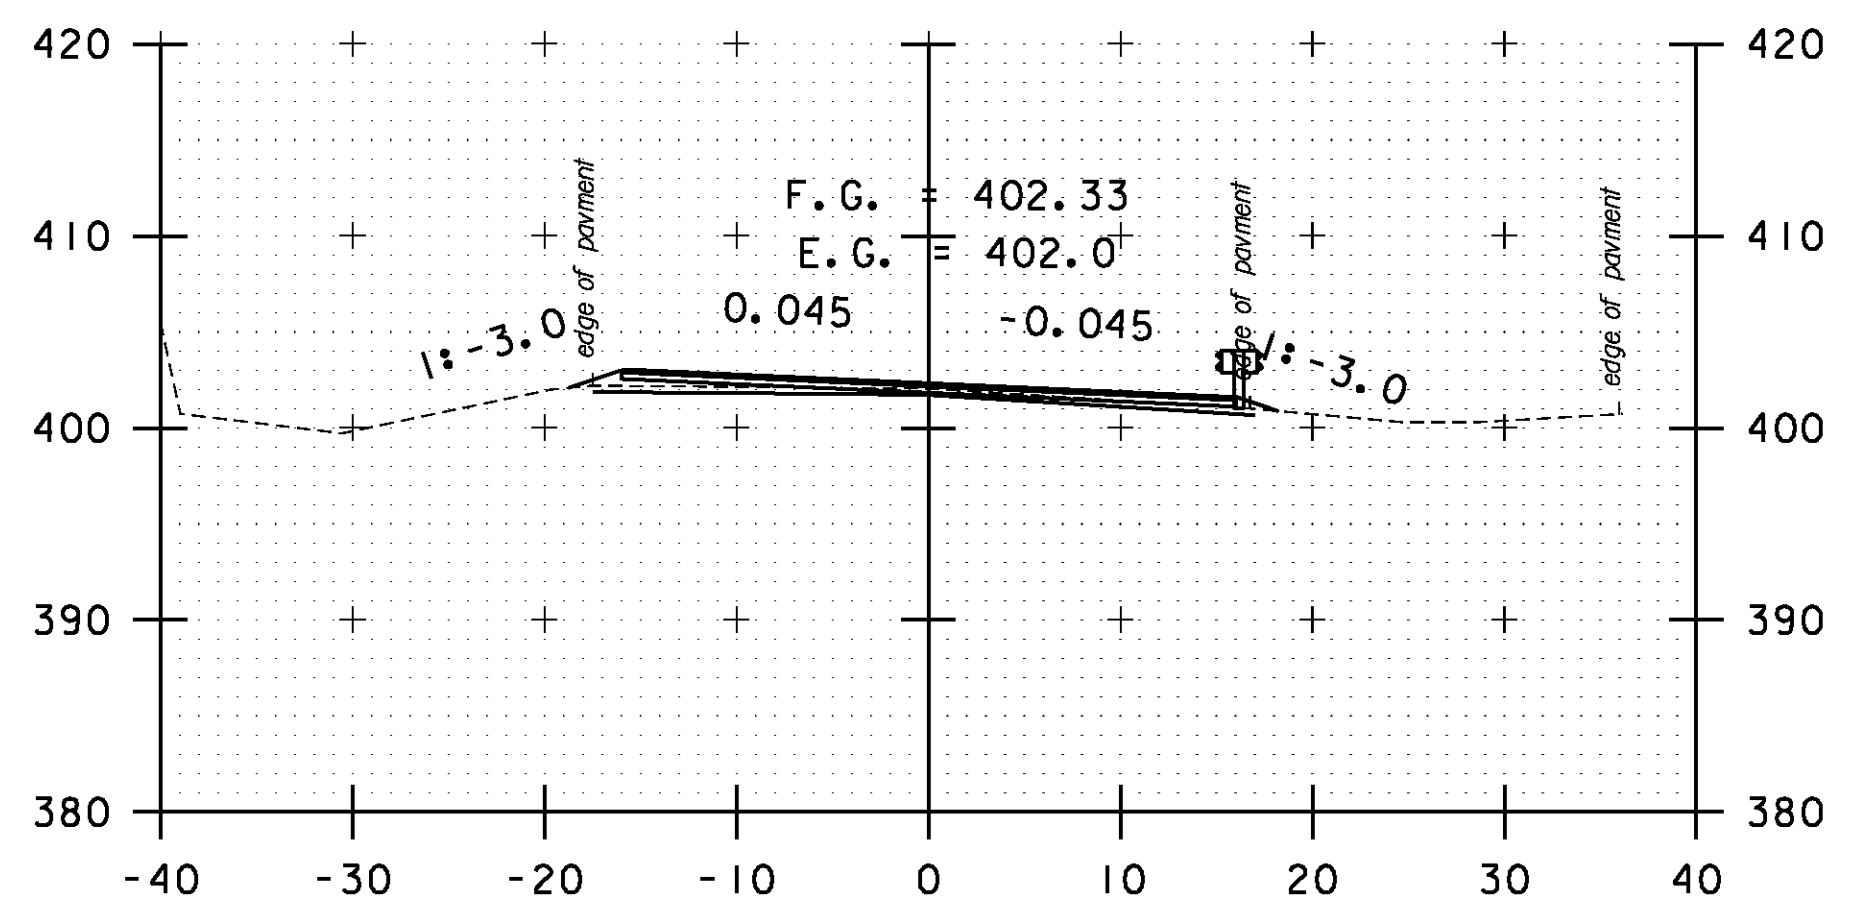


294+50

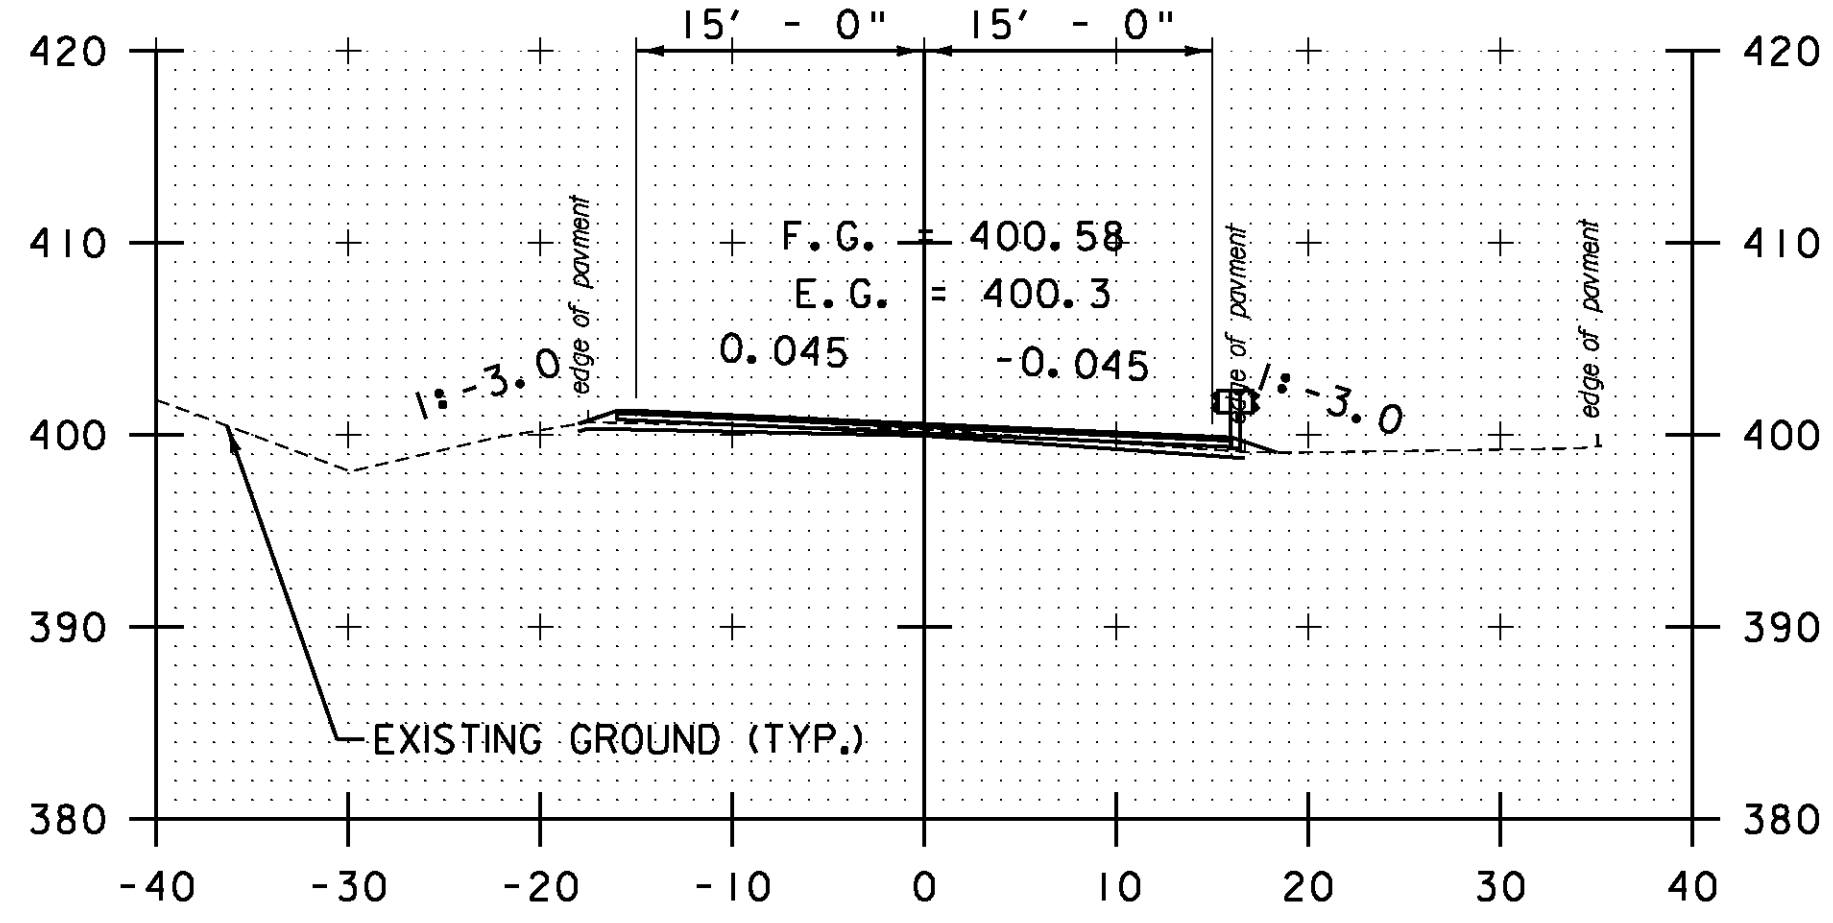

291+00

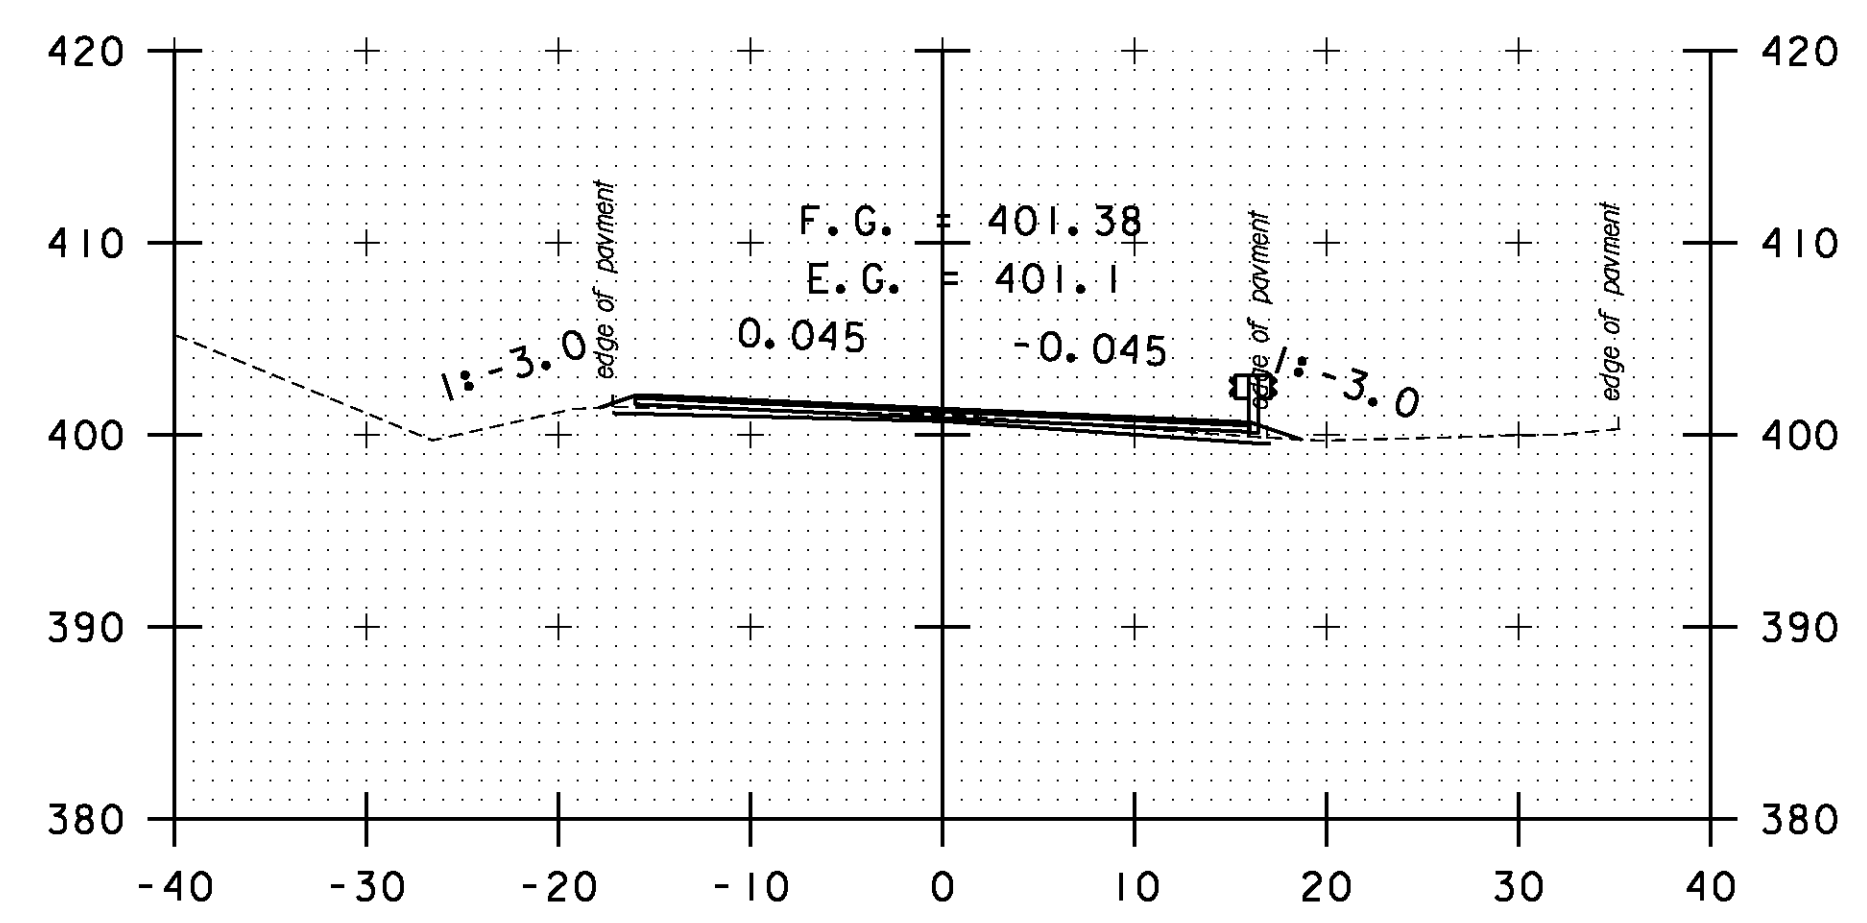

292+50

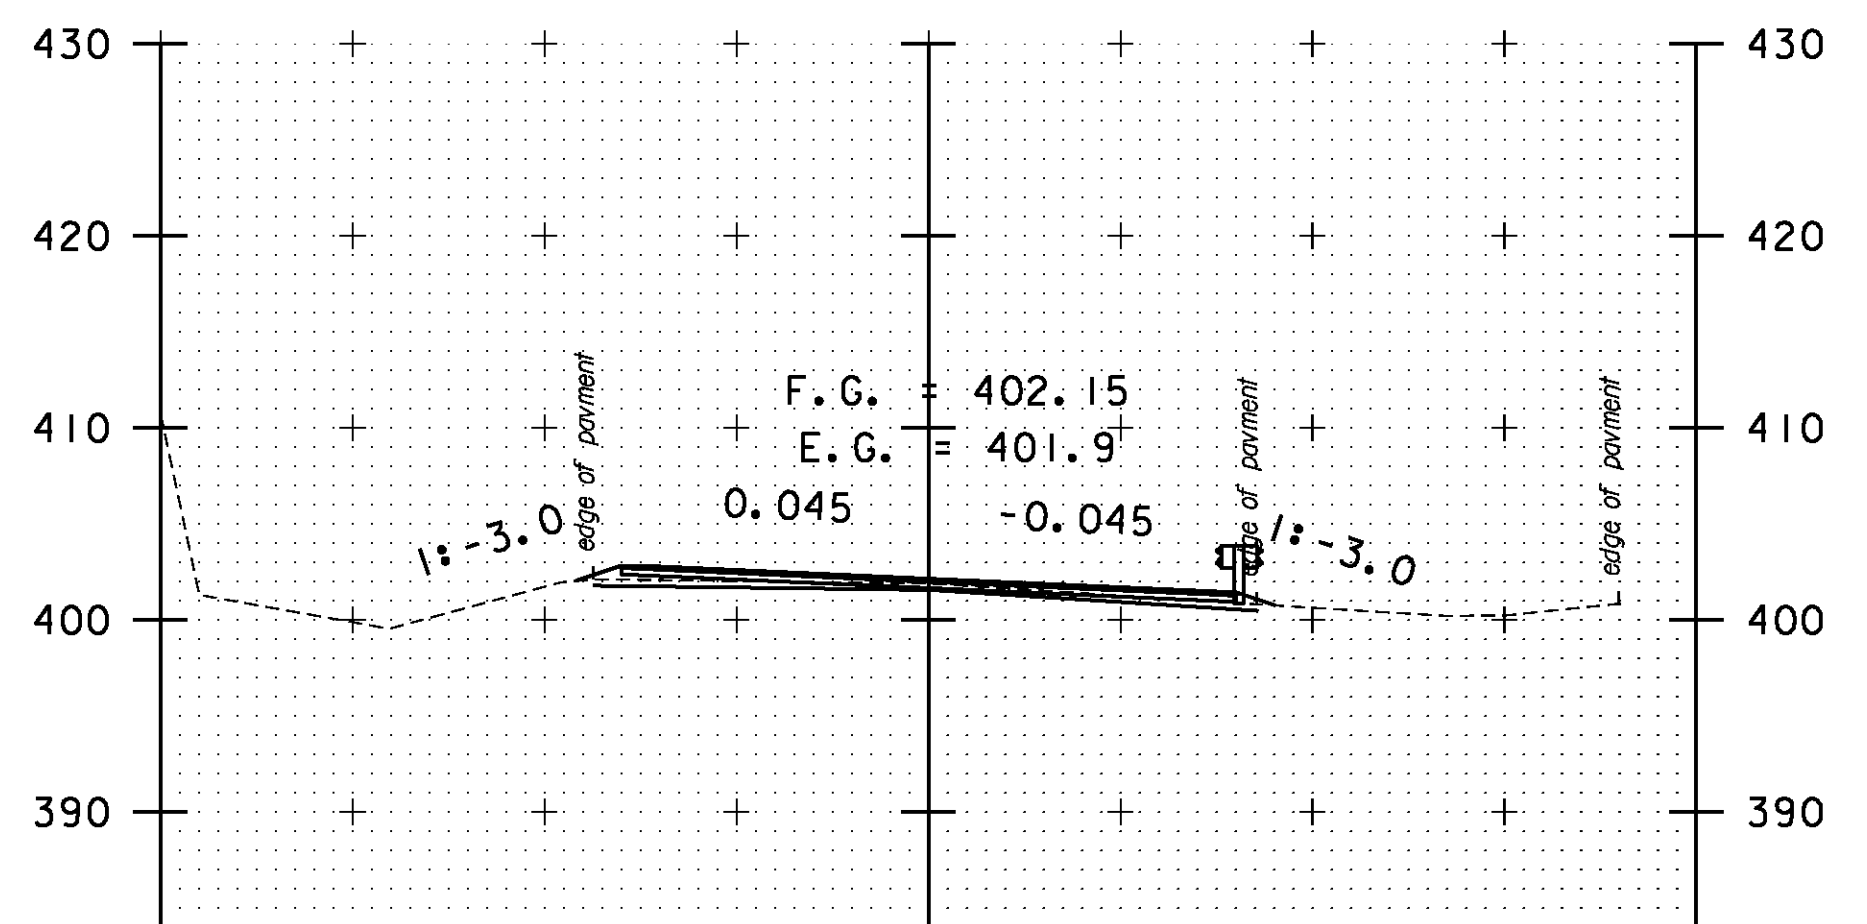

294+00

STA. 291+00 TO STA. 295+00

SCALE 1" = 10'-0"

CROSS SECTION SHEET 45

PROJECT NAME: BOTLON-WATERBURY	PLOT DATE: 4/16/2013
PROJECT NUMBER: STP 2709(I)	DRAWN BY: BMB
FILE NAME: p07C172.dgn	CHECKED BY: CDL
PROJECT LEADER: CDL	SHEET 171 OF 217
DESIGNED BY: BMB	
PLOT FILE: p07C172_171.r	