




296+00

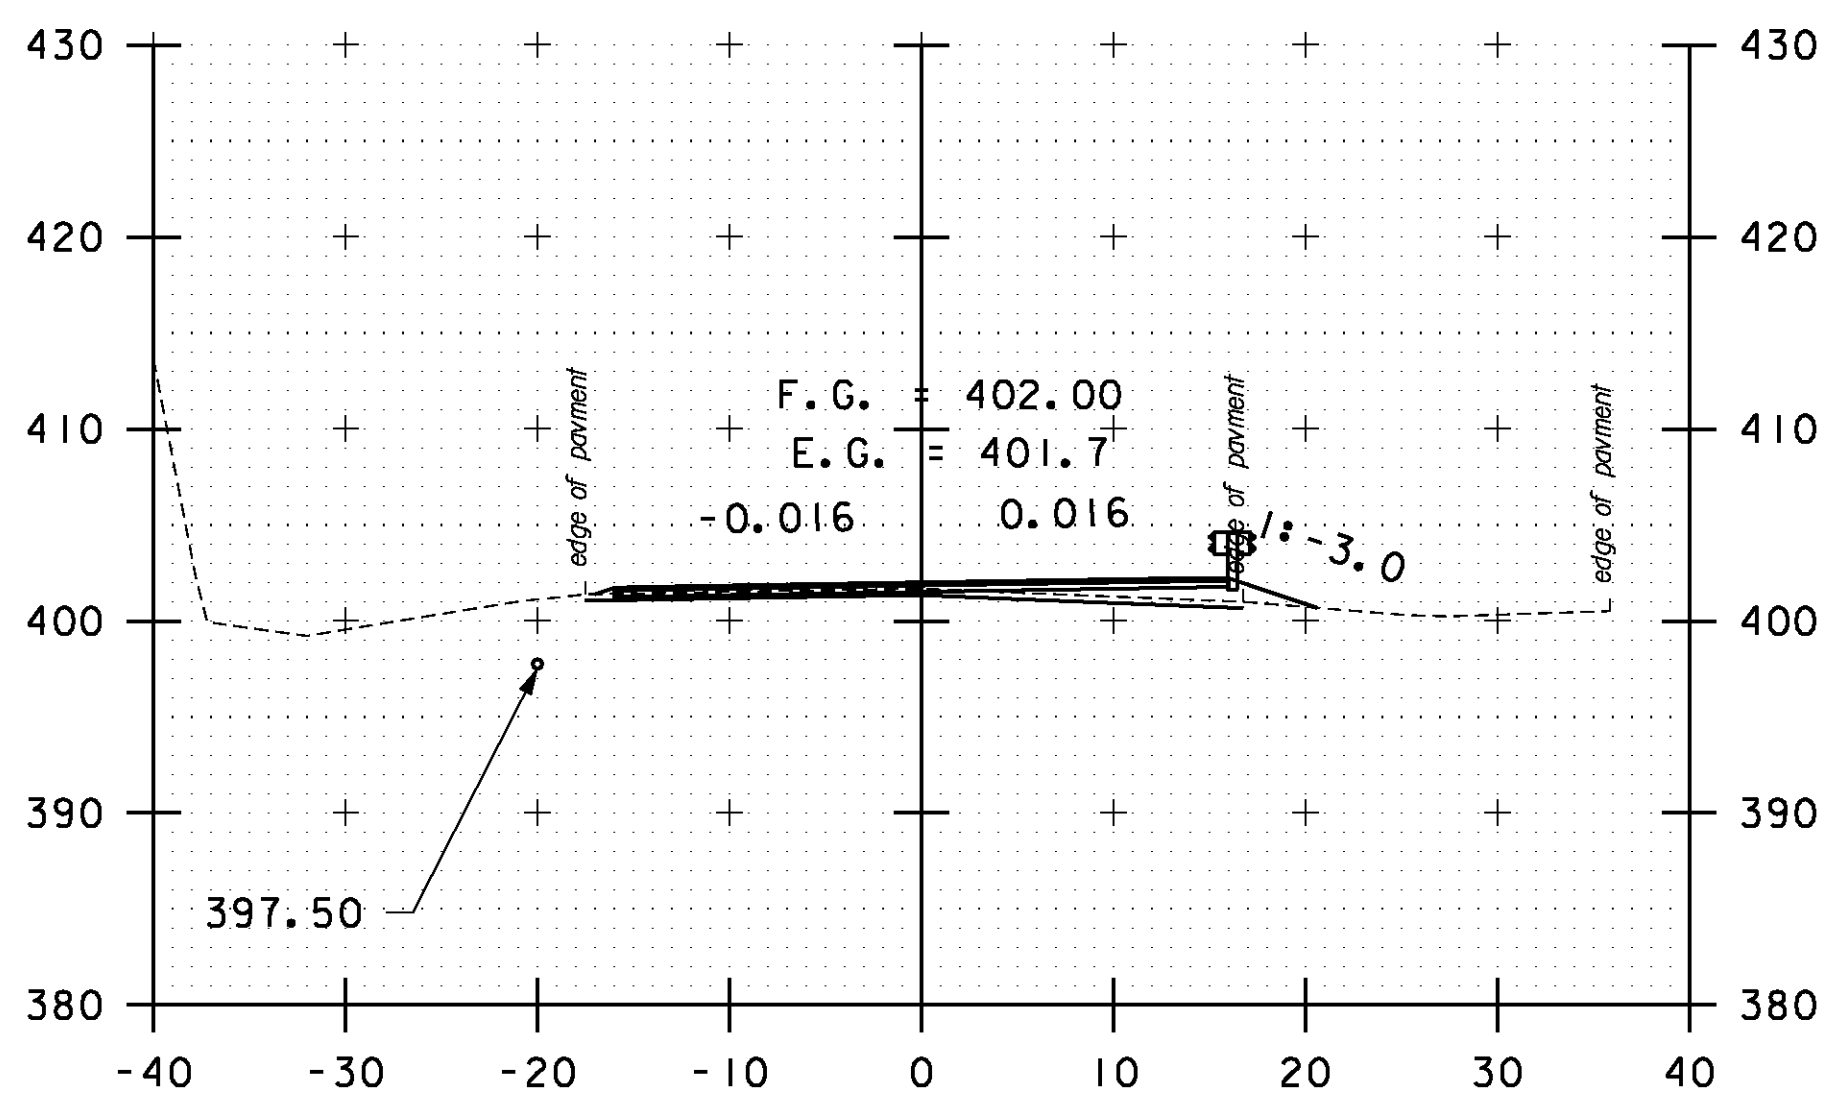


297+00

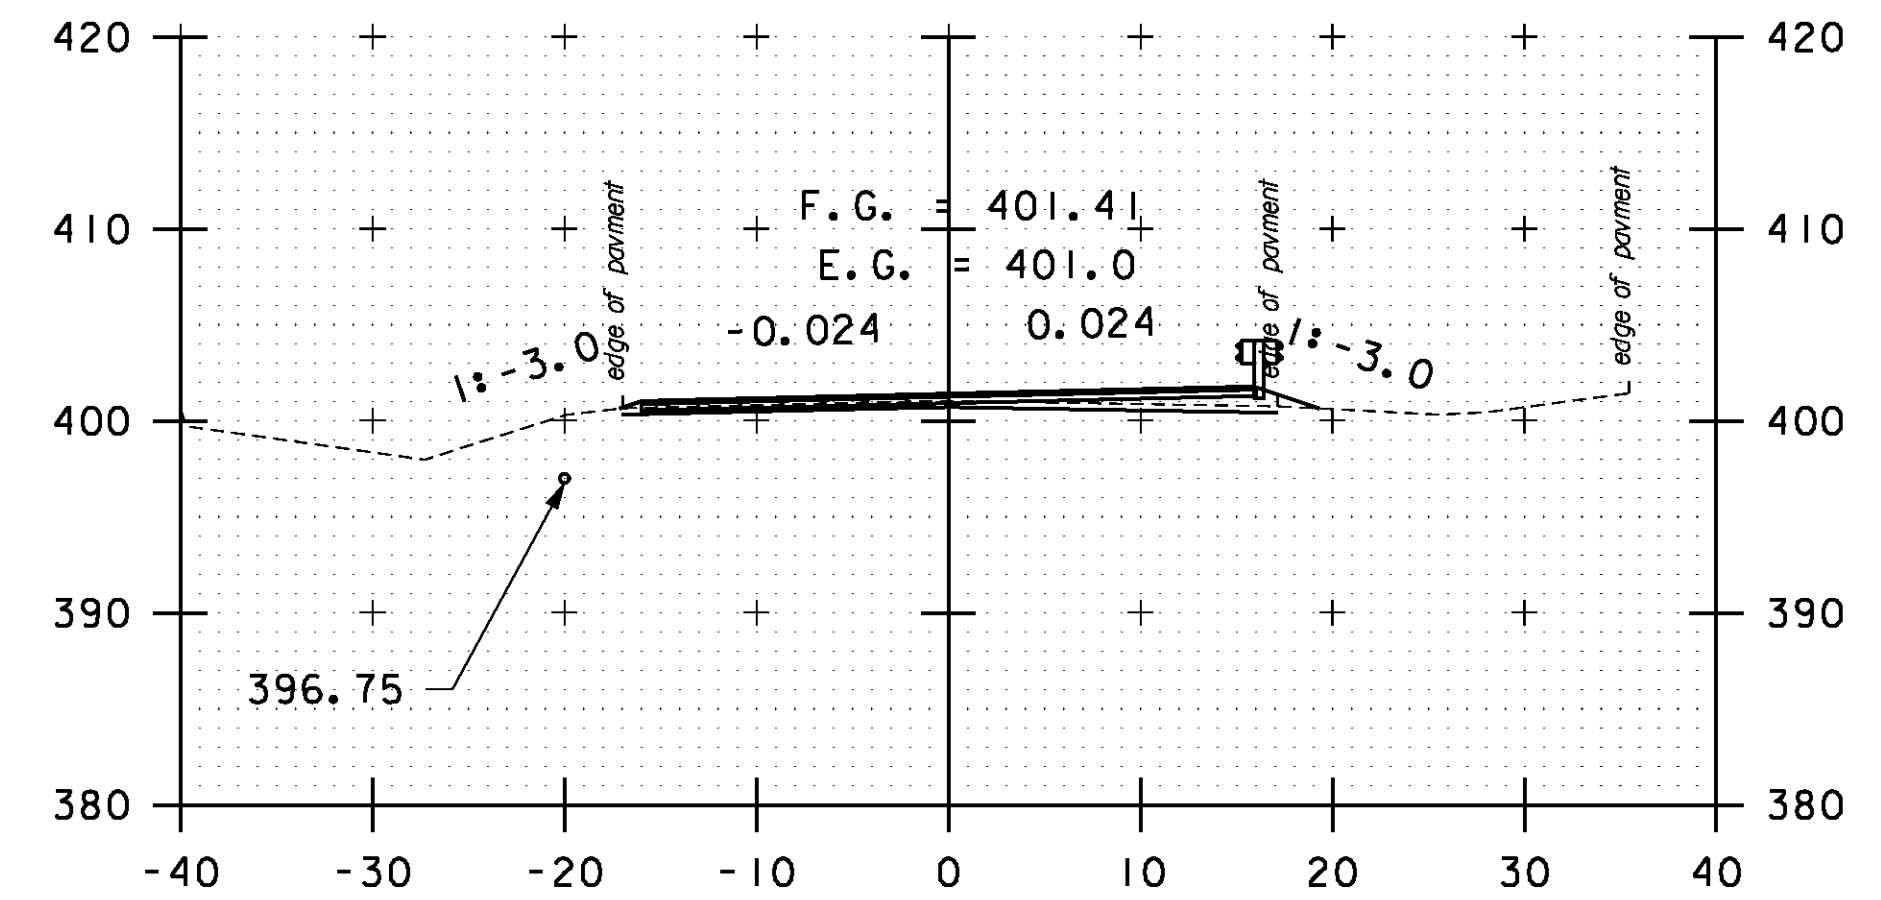


298+50

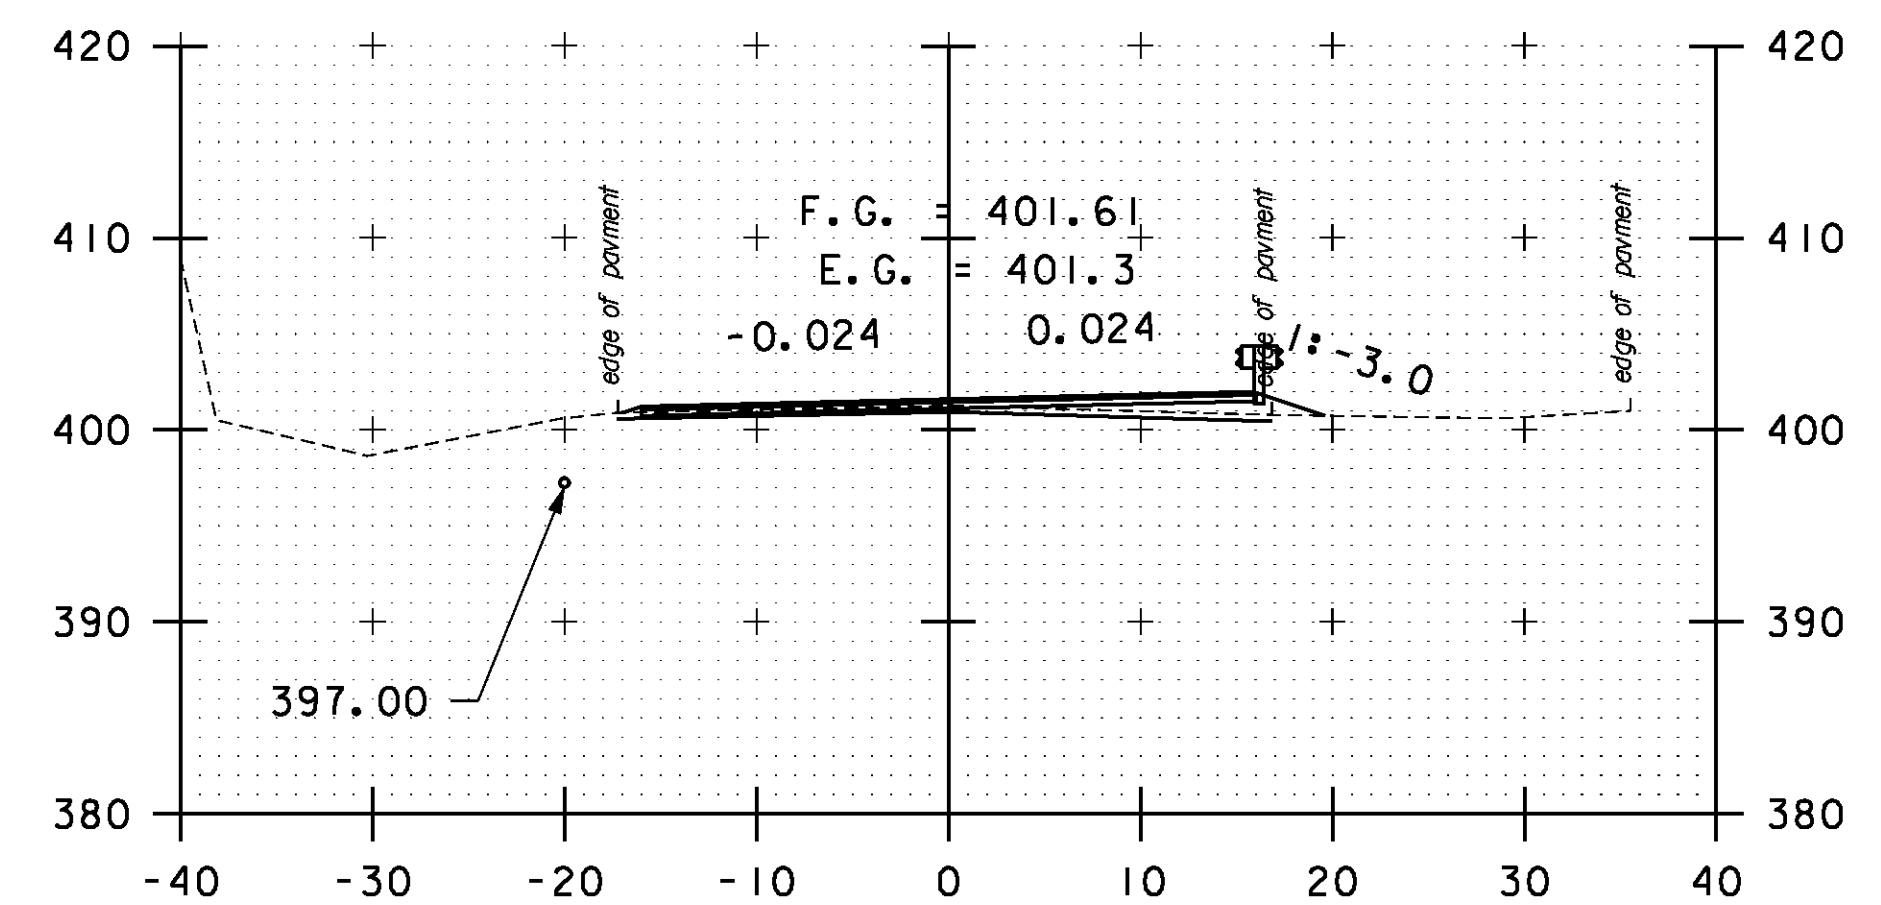


298+00

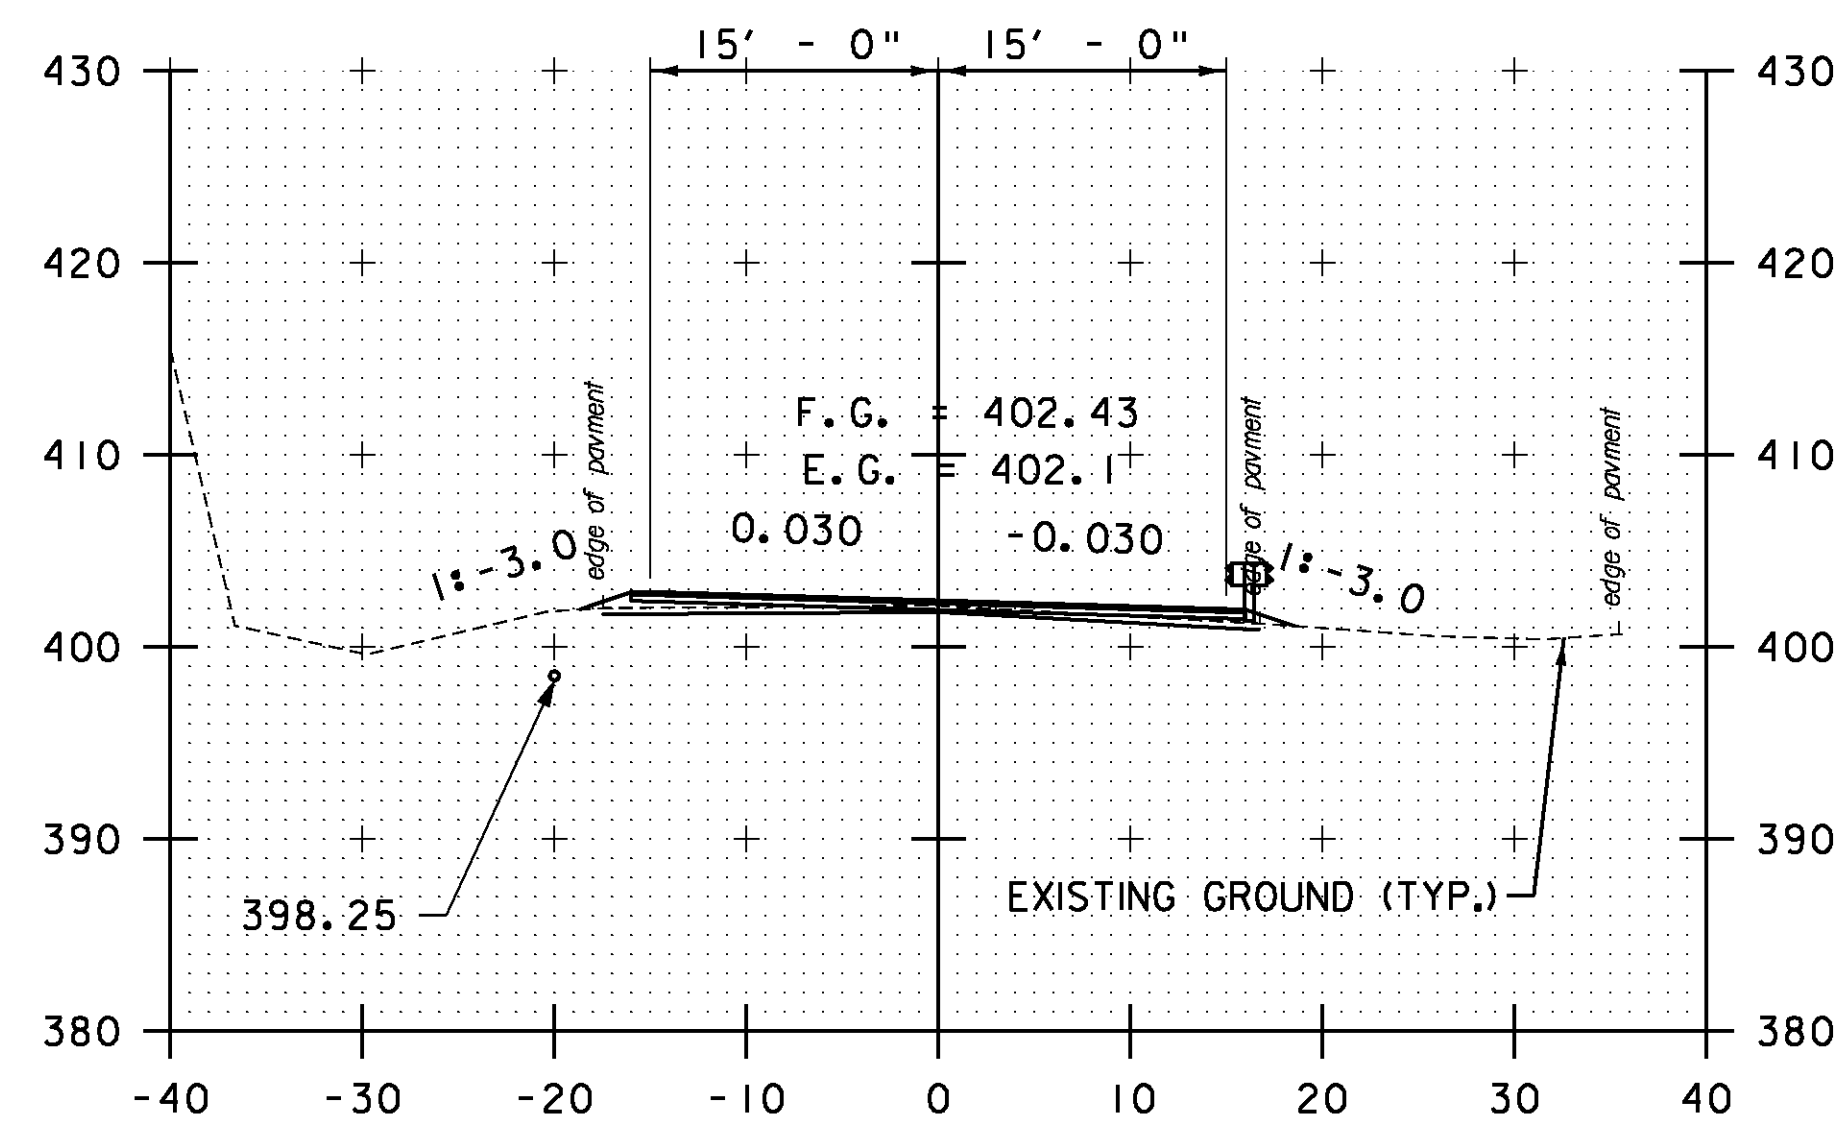

295+50

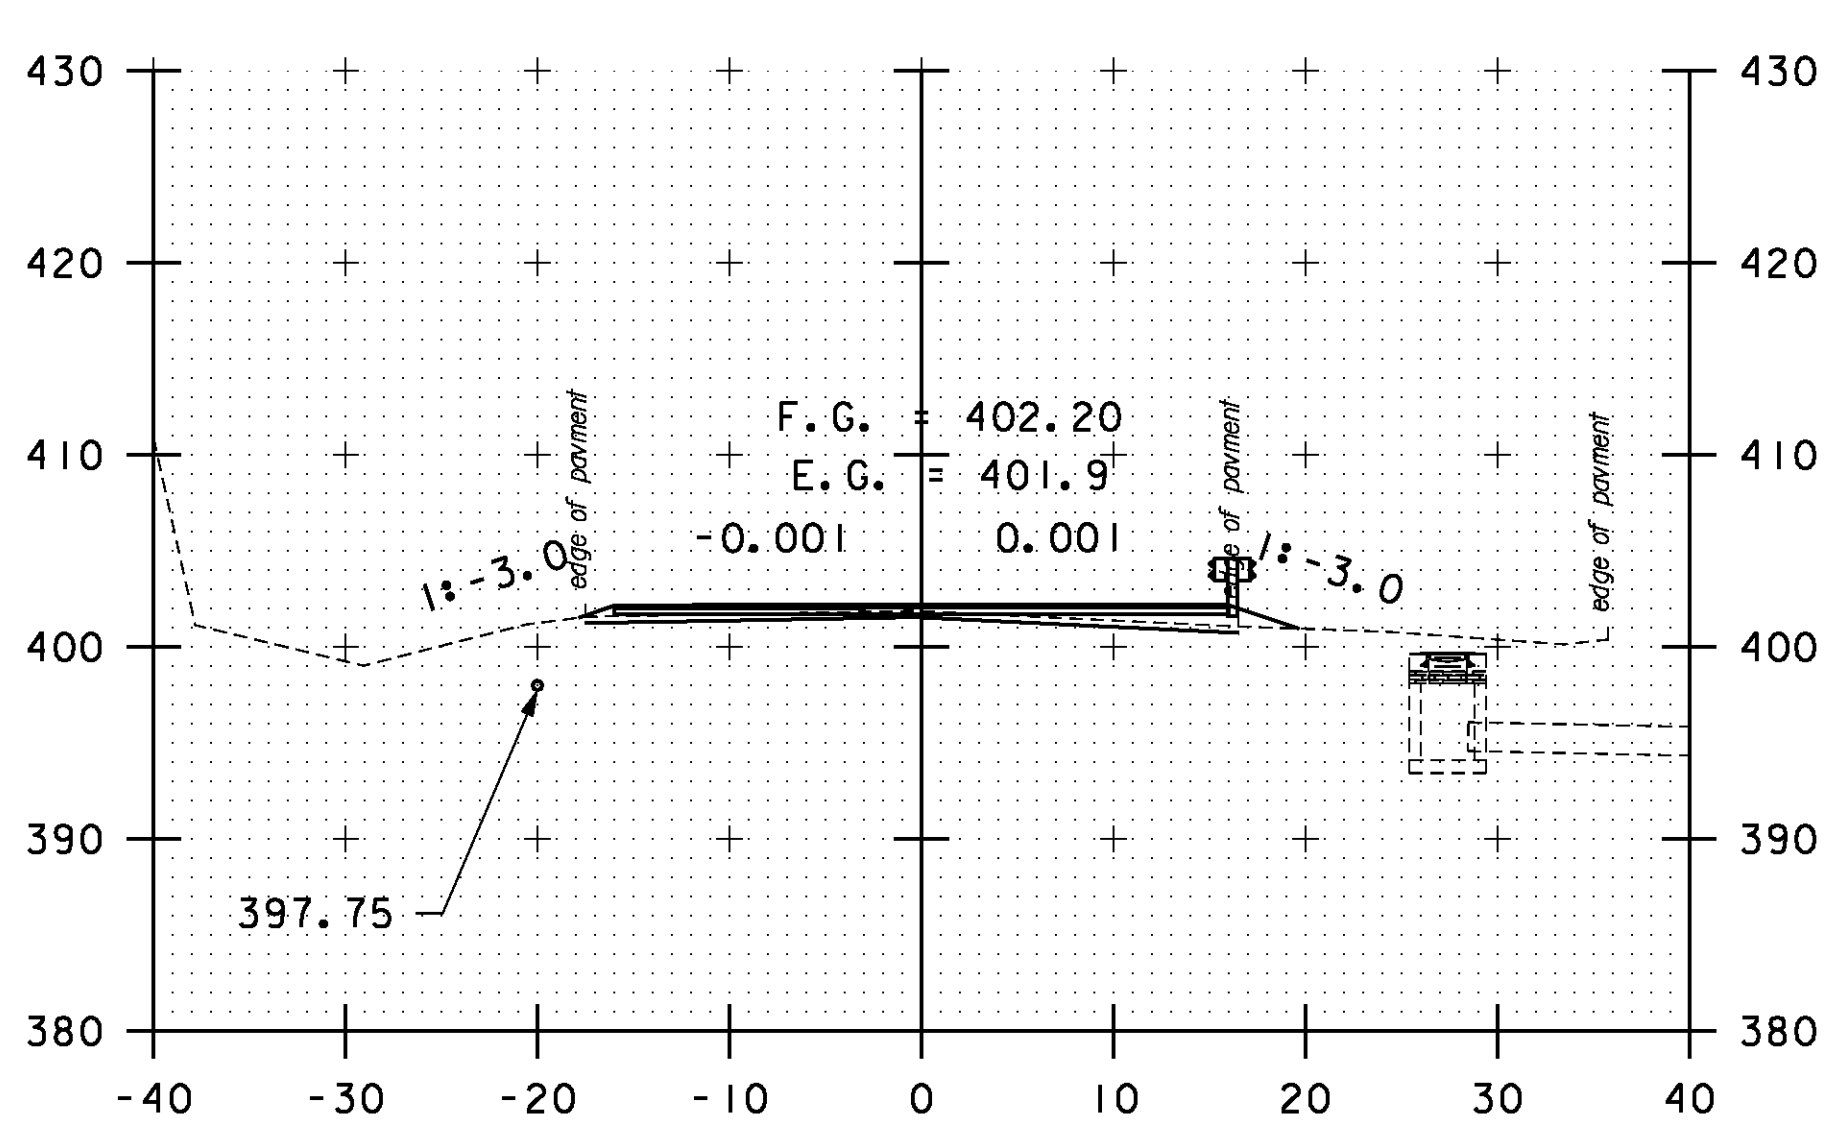


296+50

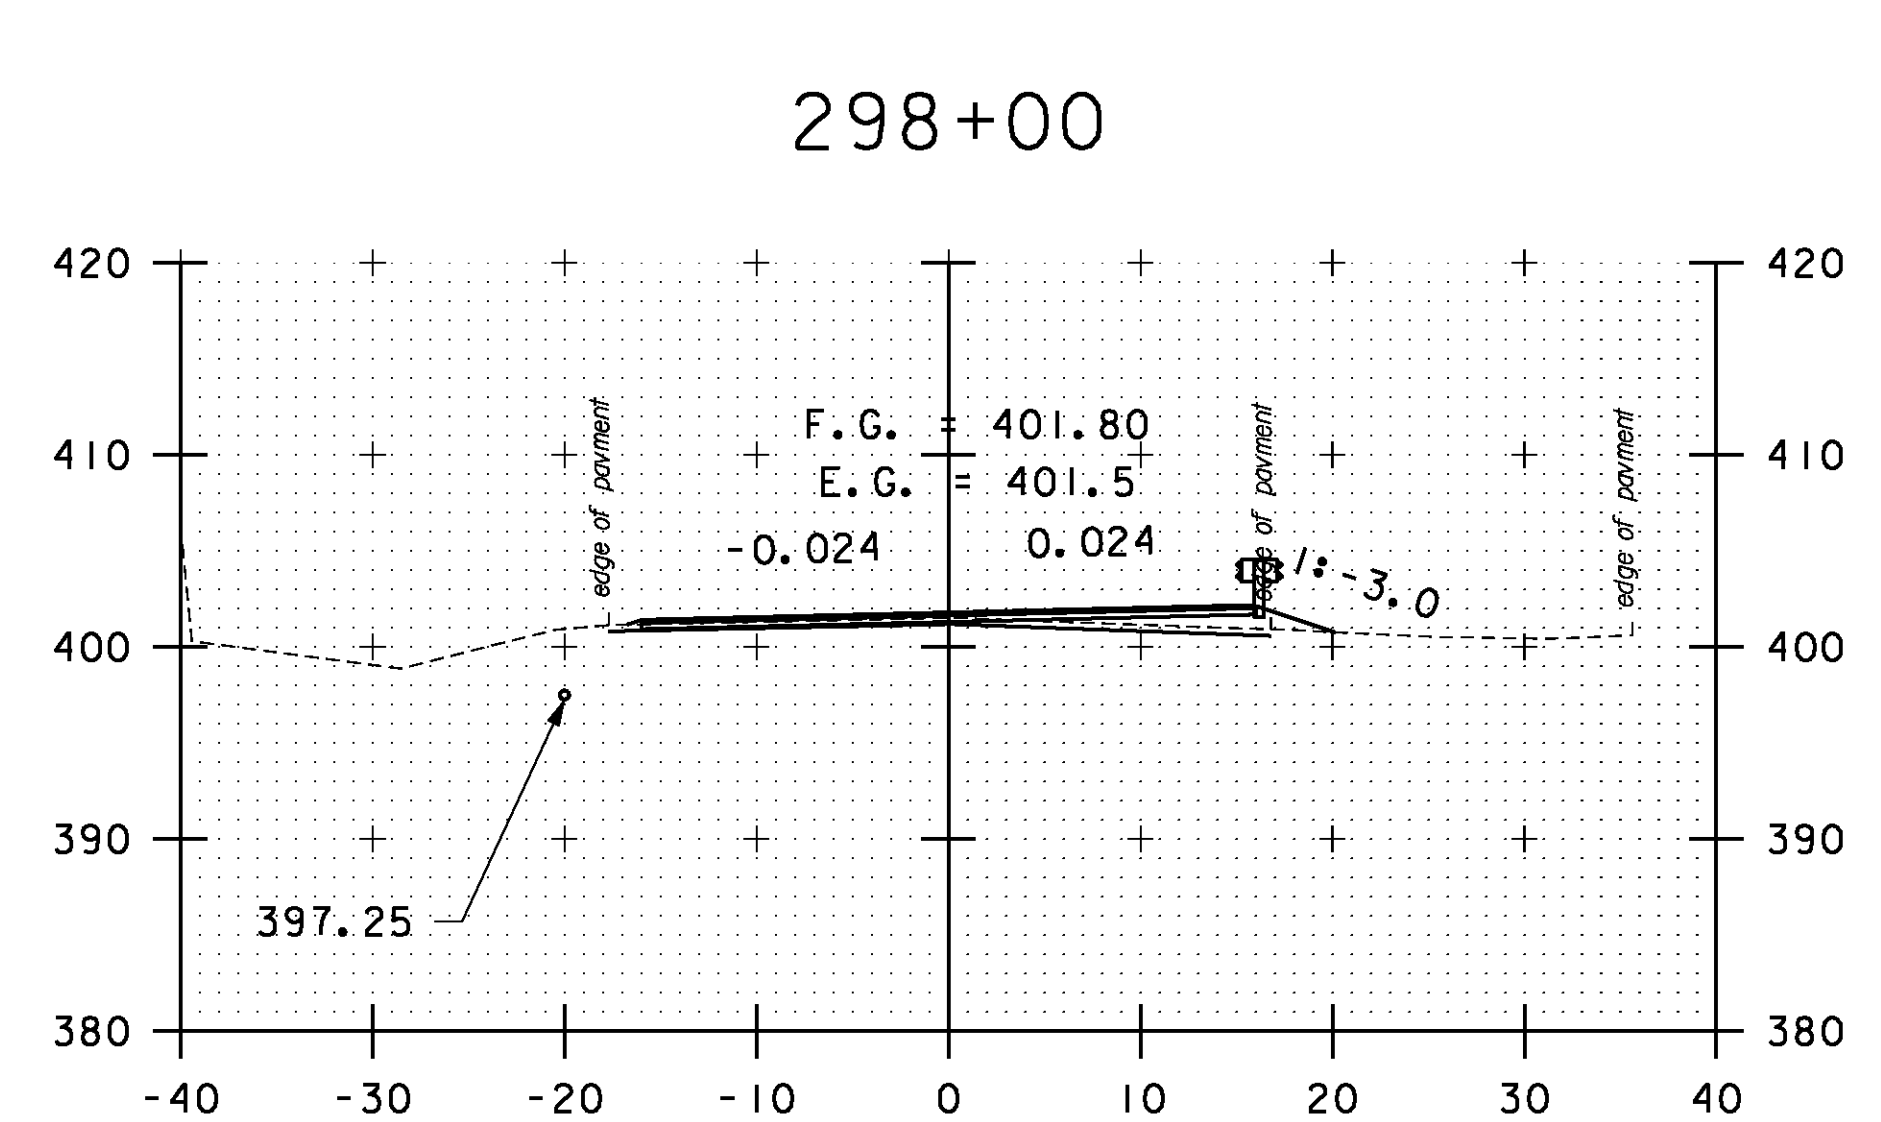

297+50

STA. 295+50 TO STA. 298+50

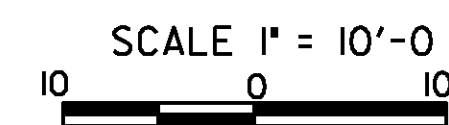

**CROSS SECTION SHEET 46**

PROJECT NAME: BOLTON-WATERBURY  
 PROJECT NUMBER: STP 2709(I)

FILE NAME: p07C172.dgn  
 PROJECT LEADER: CDL  
 DESIGNED BY: BMB  
 PLOT FILE: p07C172\_172.1

PLOT DATE: 4/16/2013  
 DRAWN BY: BMB  
 CHECKED BY: CDL  
 SHEET 172 OF 217