




A 13+50

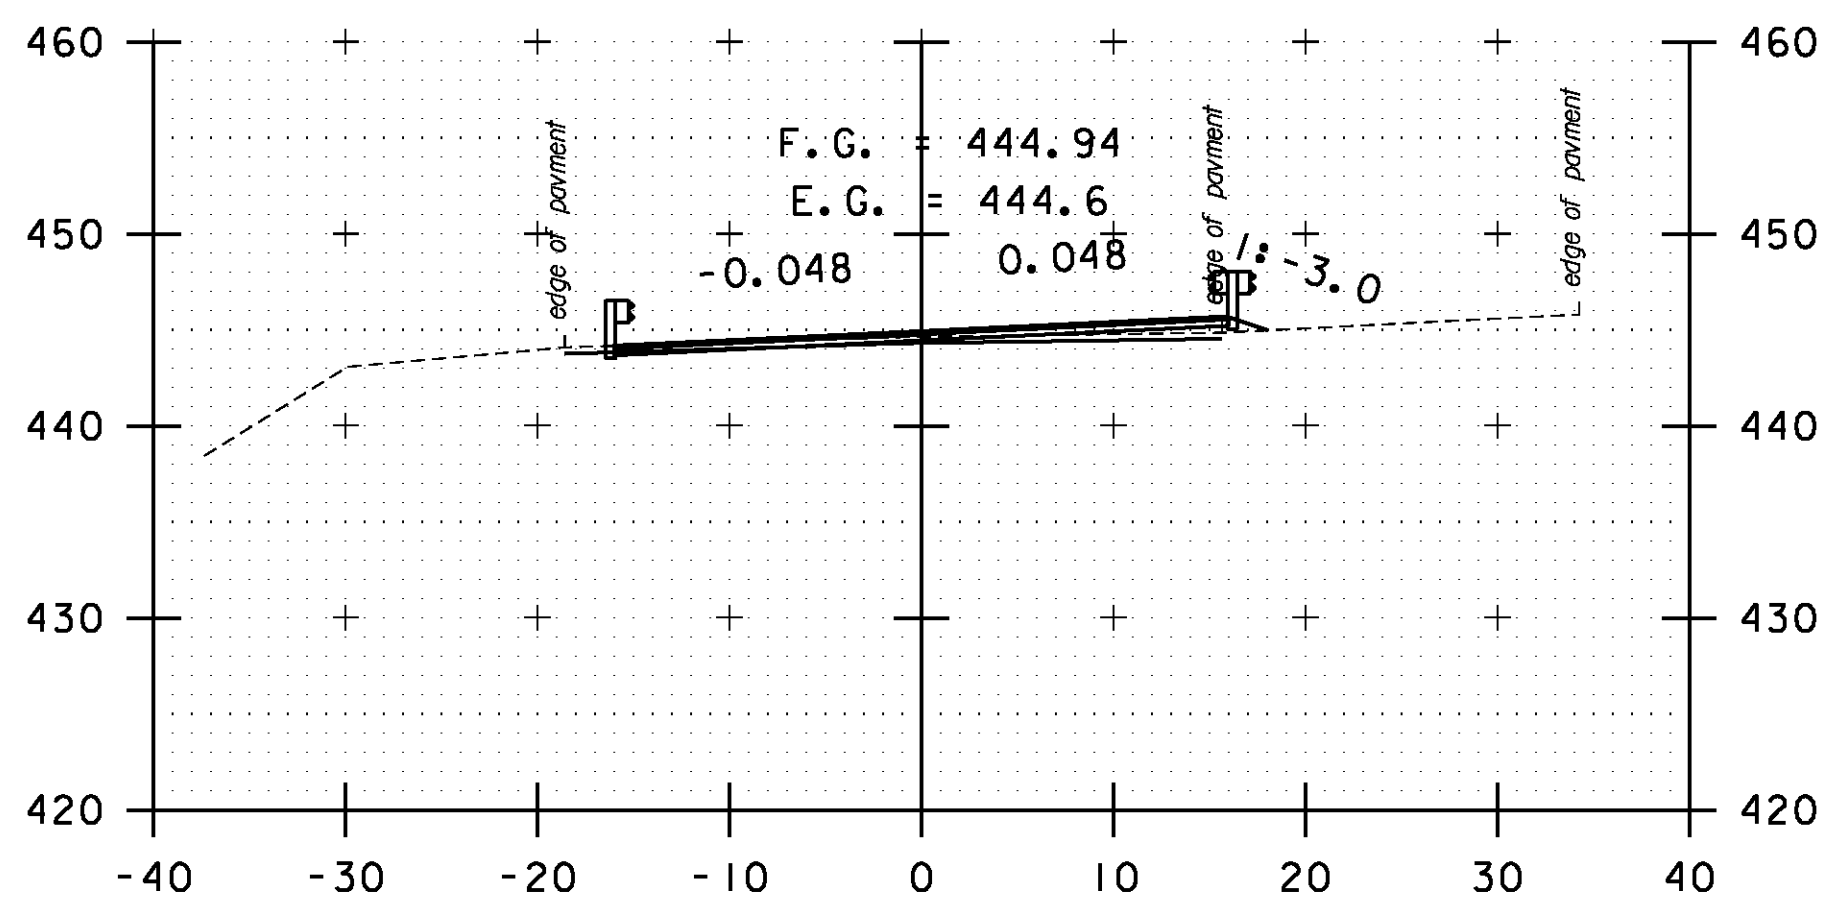


A 15+00

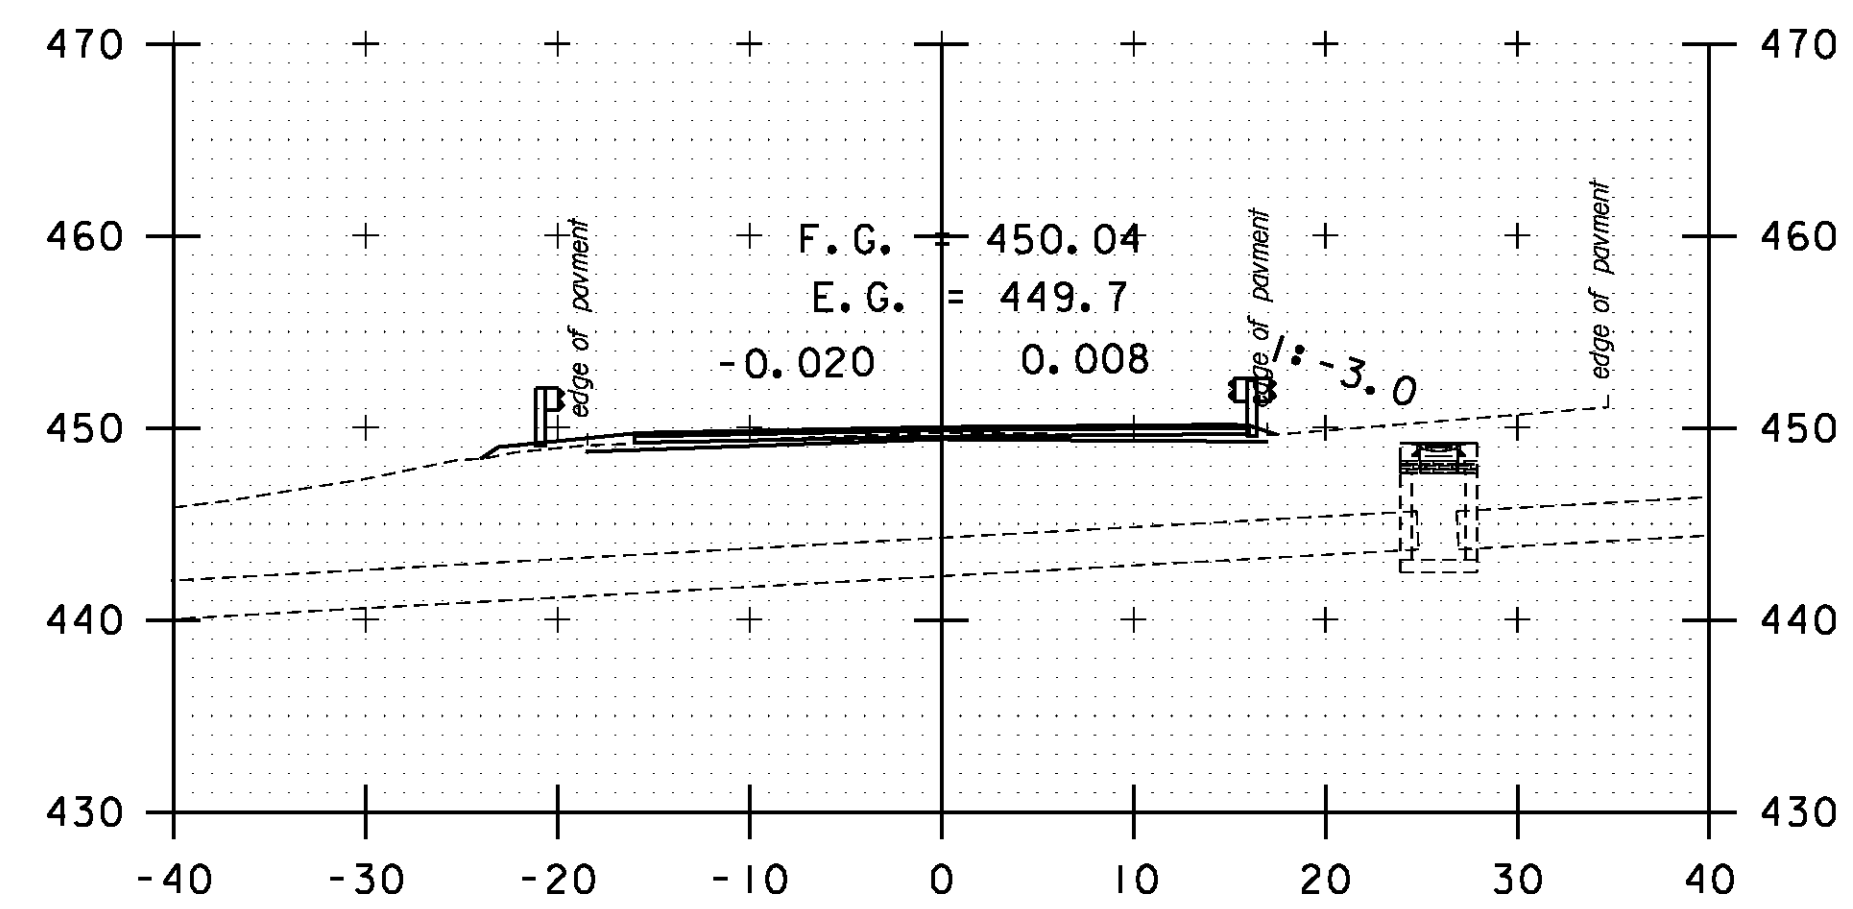


A 16+50

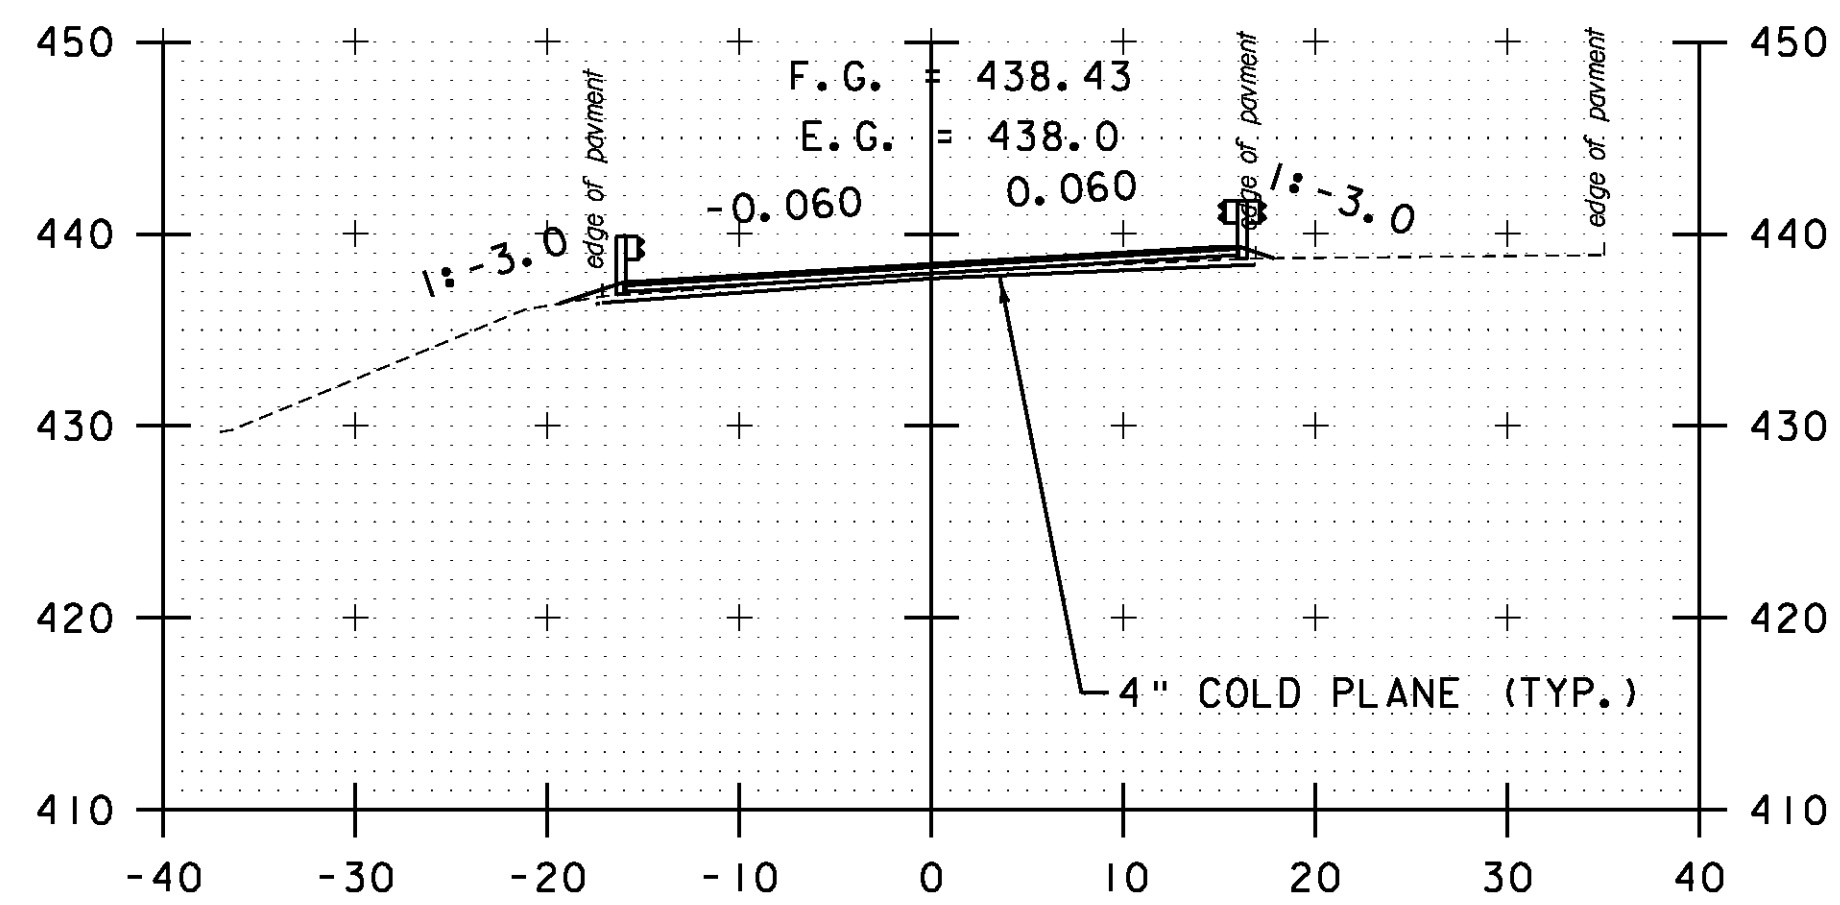


A 13+00

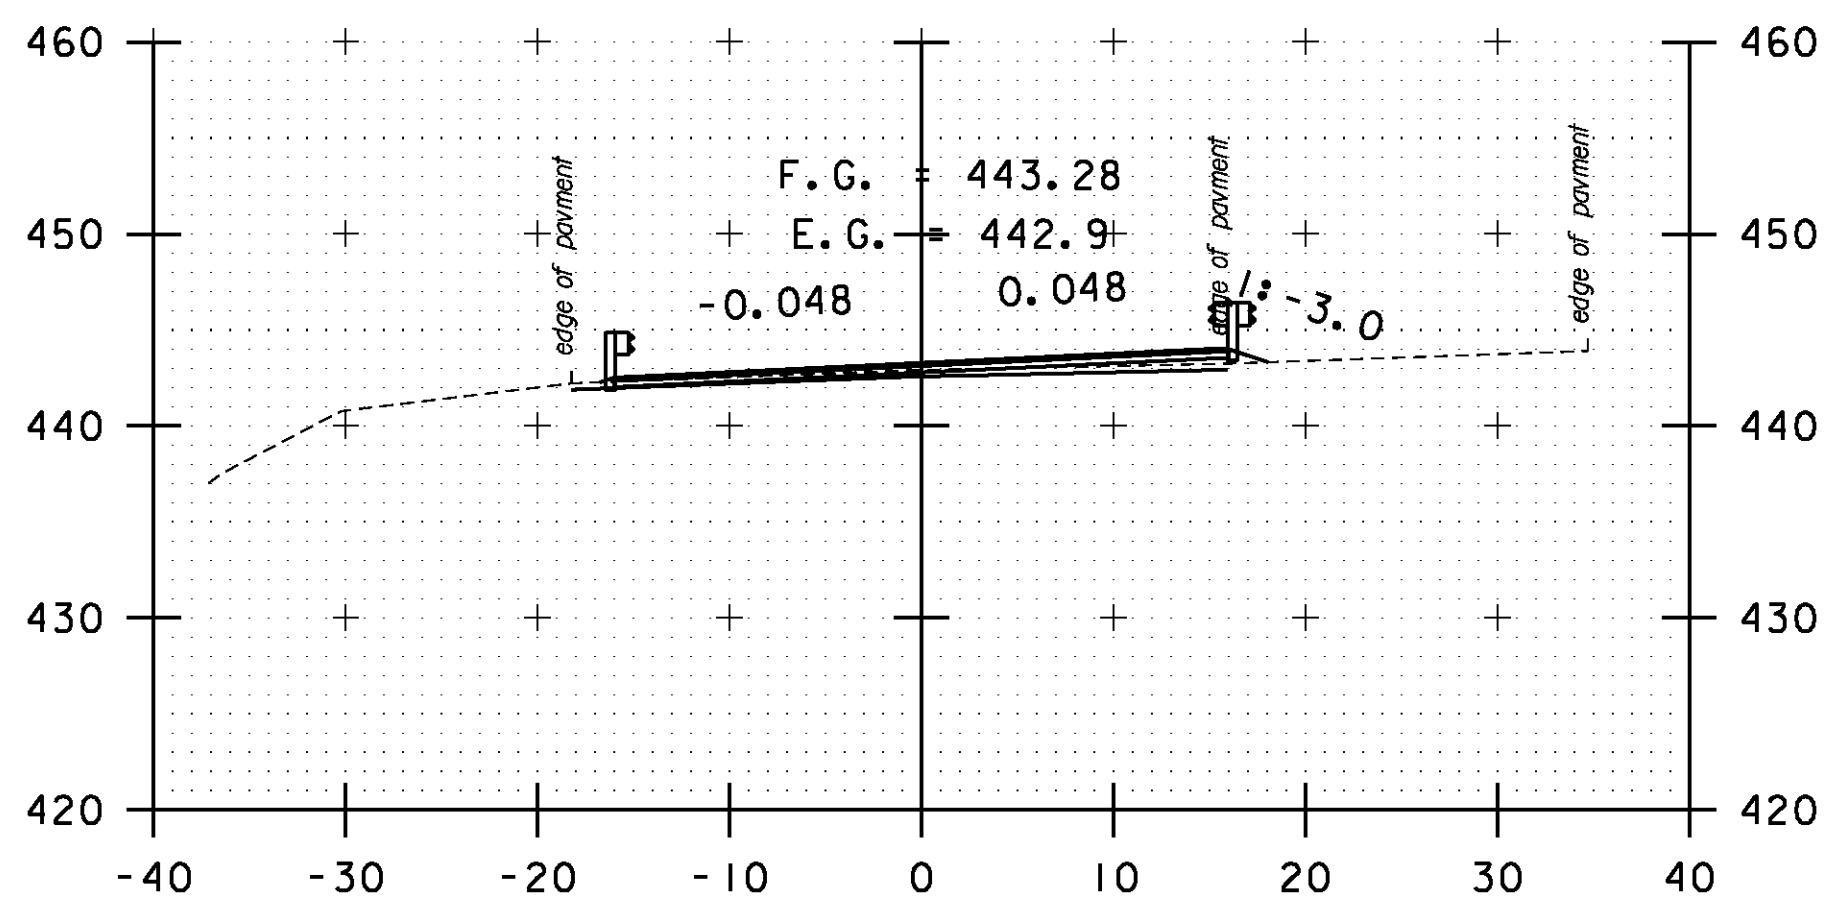


A 14+50

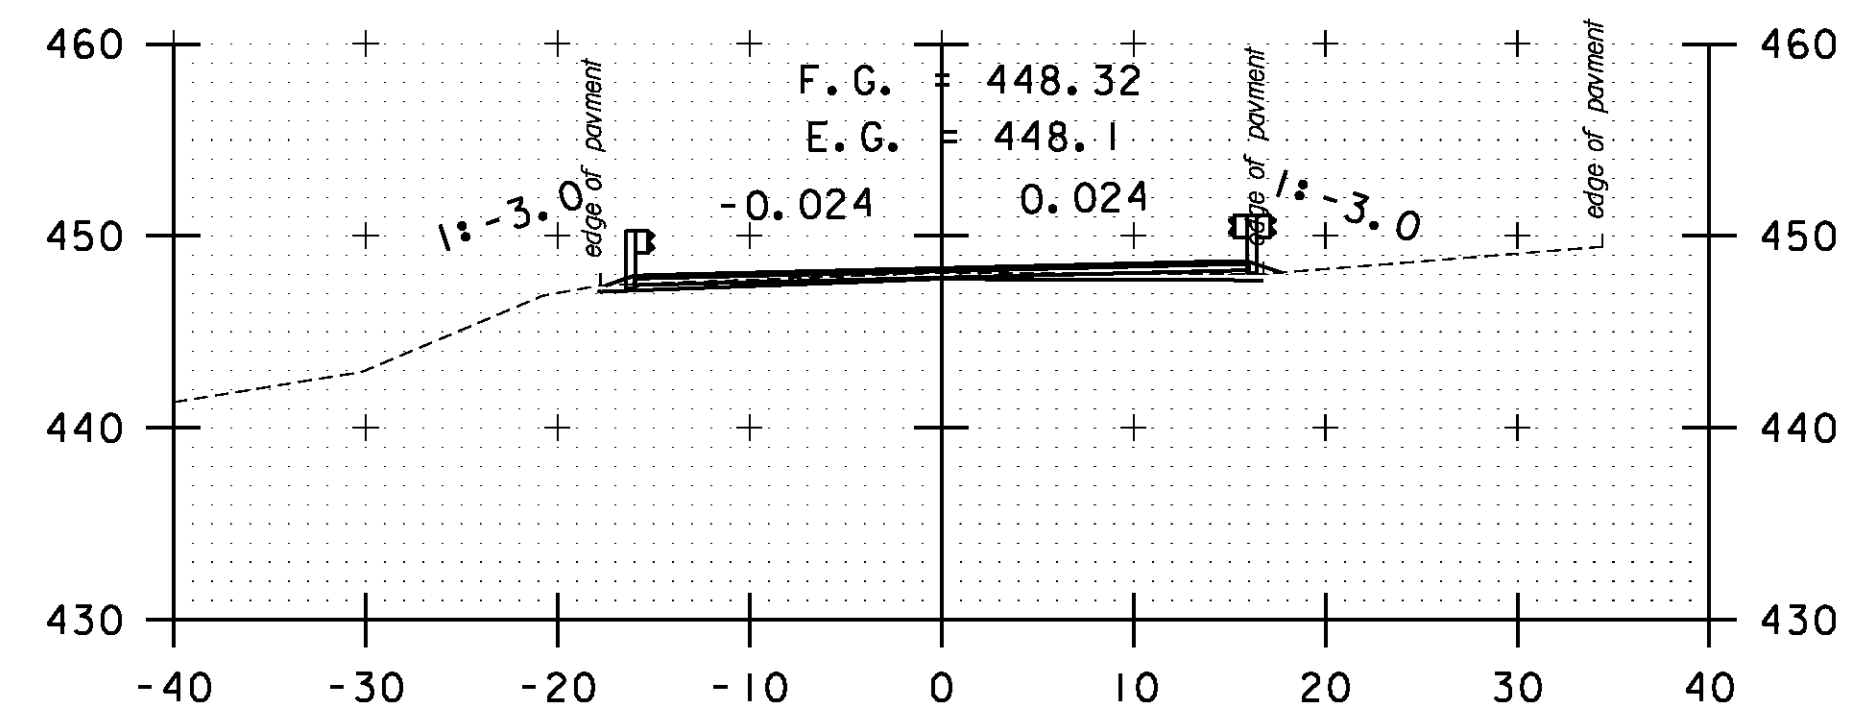


A 16+00

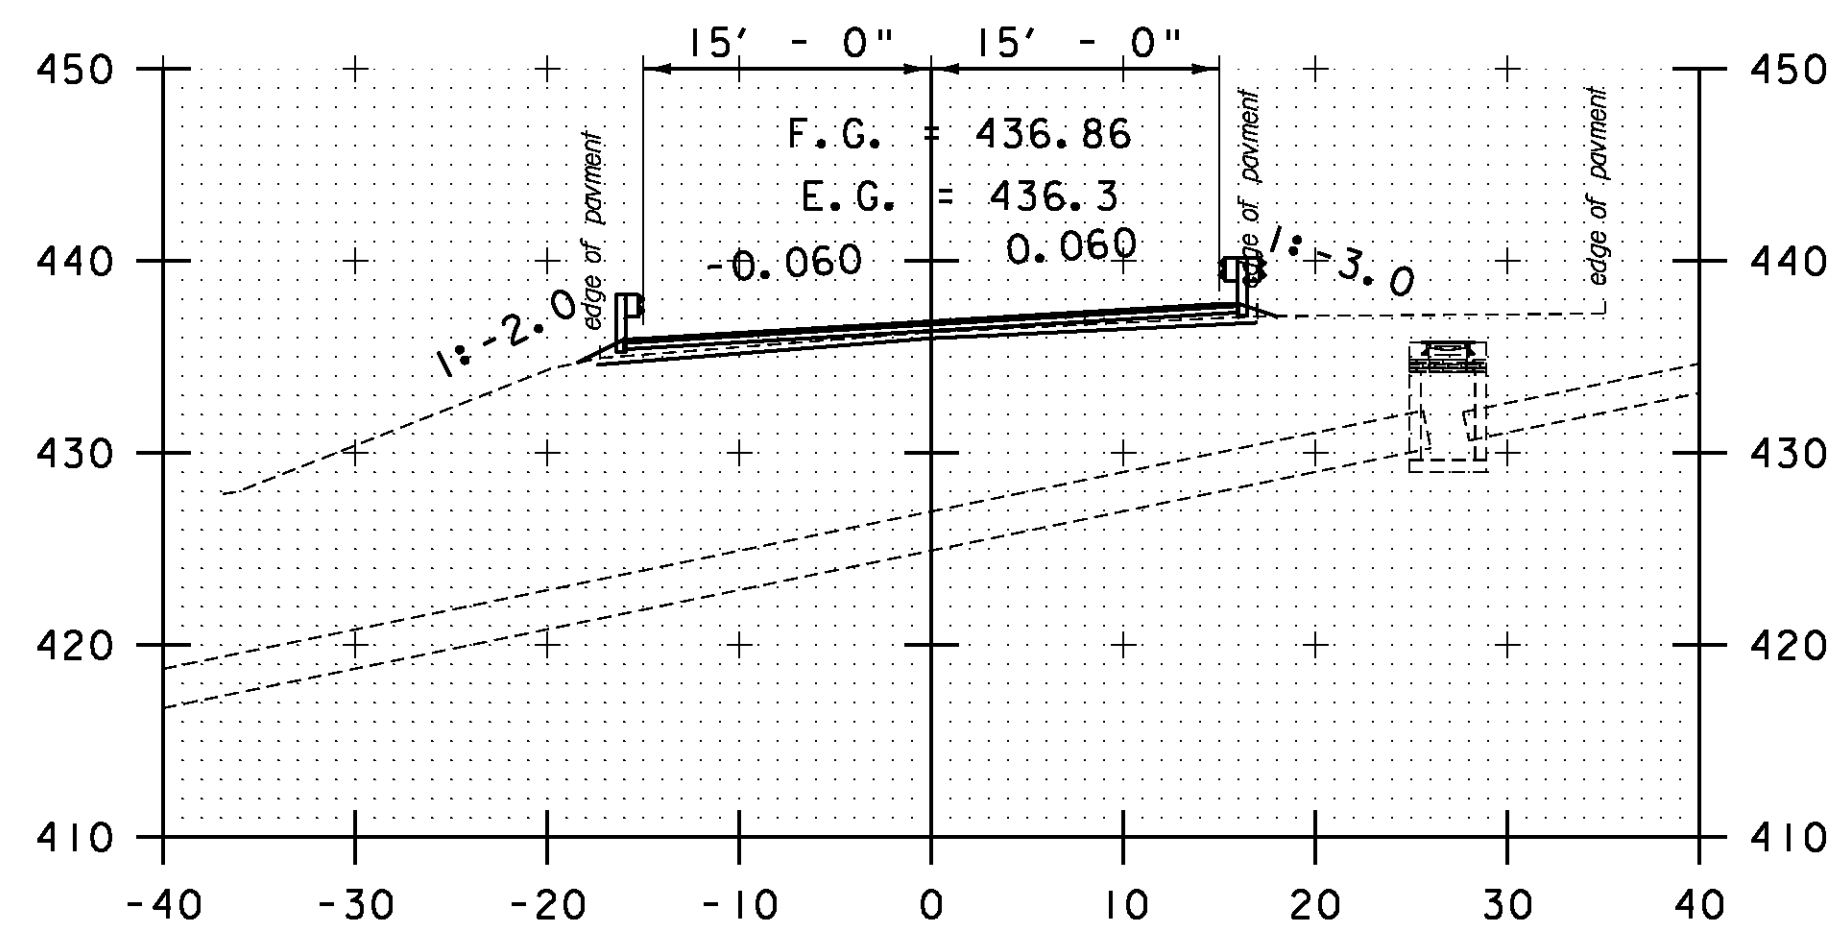

A 12+50

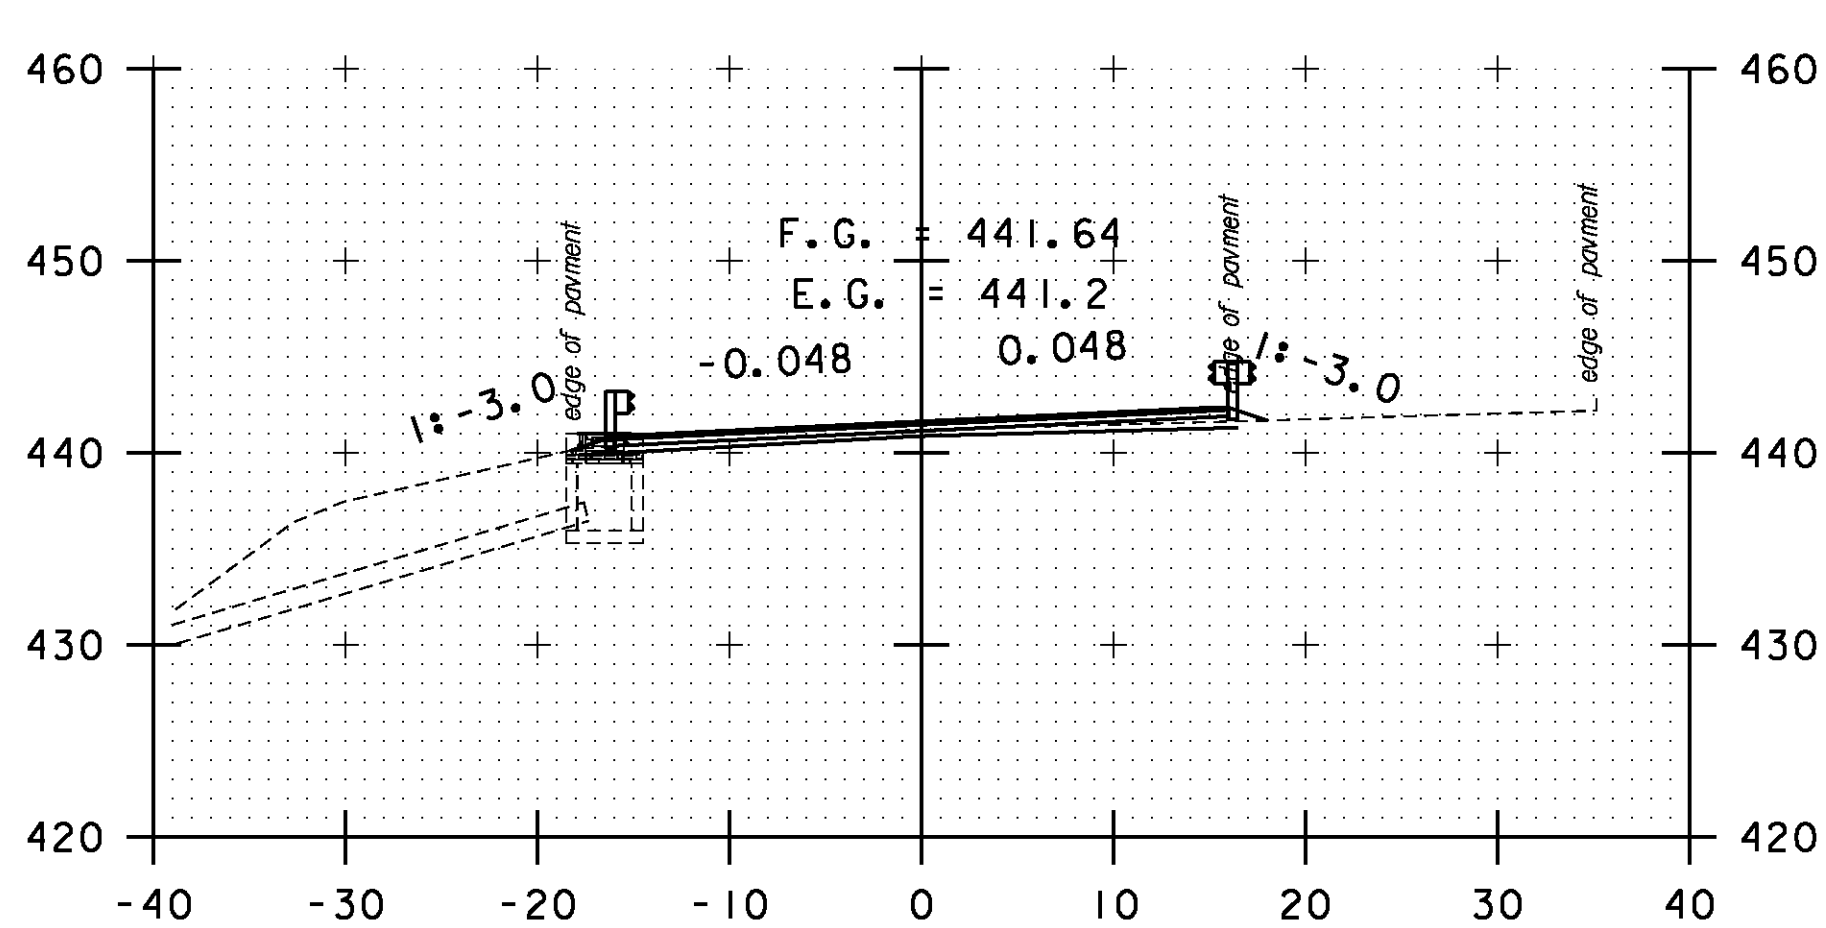

A 14+00

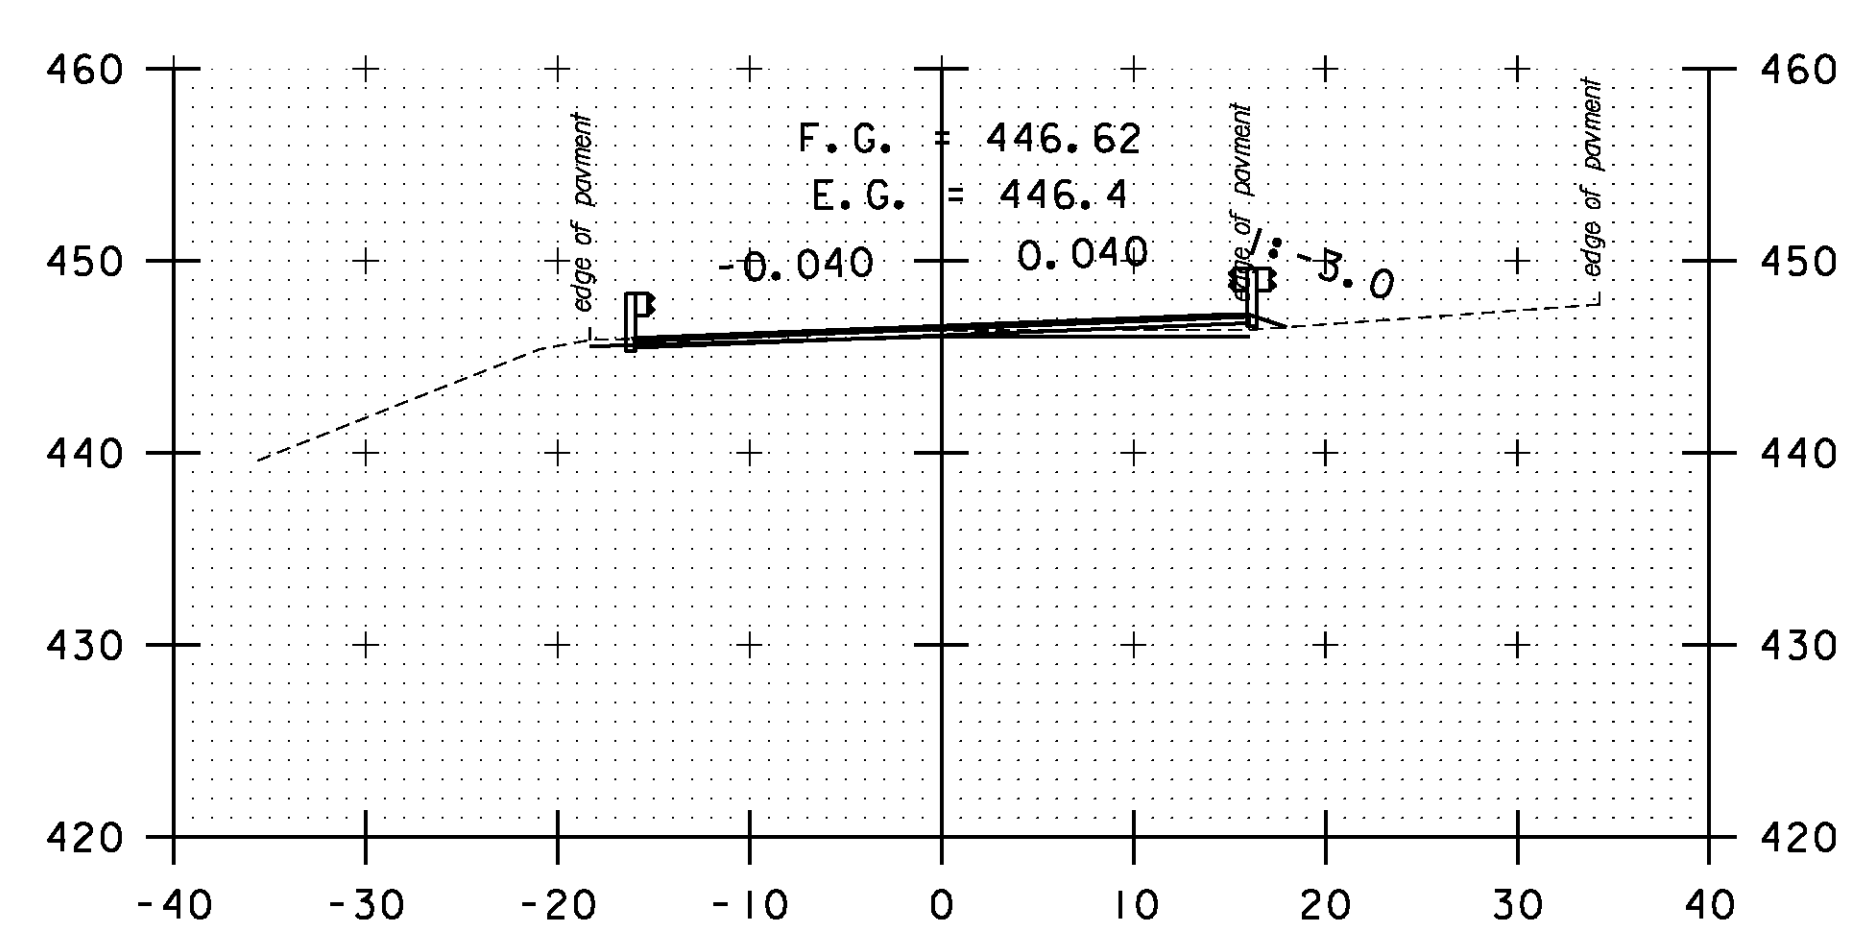

A 15+50

STA. A 12+50 TO STA. A 16+50

SCALE 1" = 10'-0"

CROSS SECTION SHEET 50

PROJECT NAME: BOLTON-WATERBURY
PROJECT NUMBER: STP 2709(I)

FILE NAME: p07C172.dgn
PROJECT LEADER: CDL
DESIGNED BY: BMB
PLOT FILE: p07C172_176.1

PLOT DATE: 4/16/2013
DRAWN BY: BMB
CHECKED BY: CDL
SHEET 176 OF 217