




A 18+00

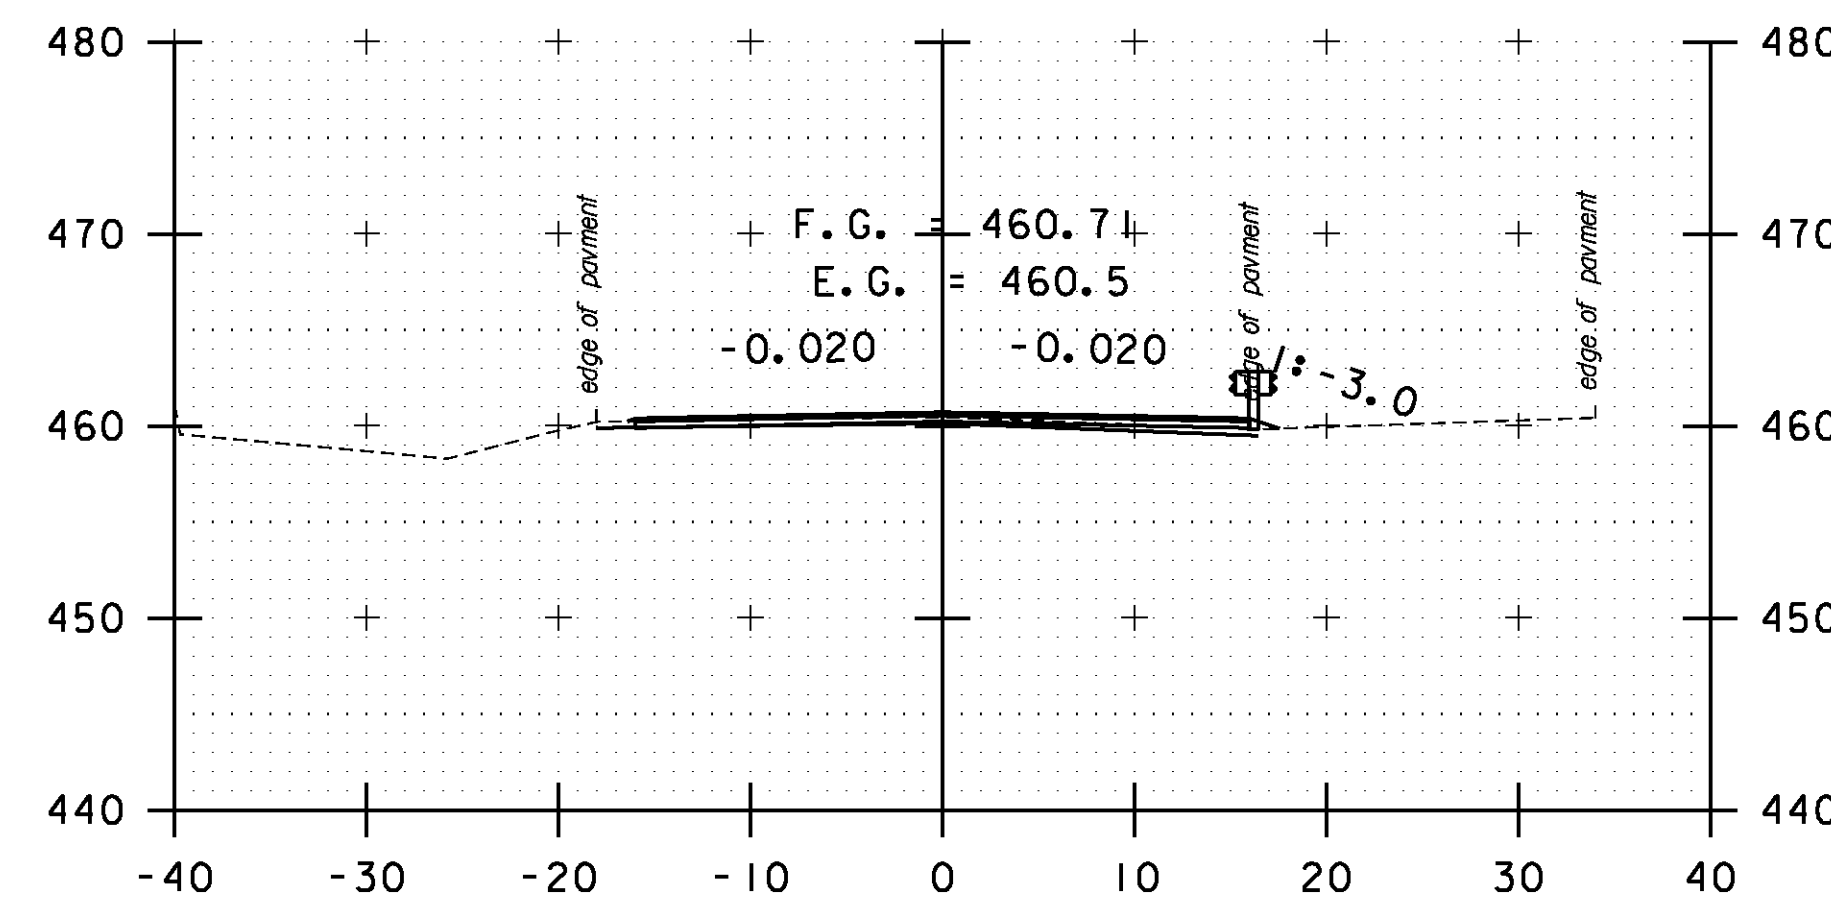


A 19+50

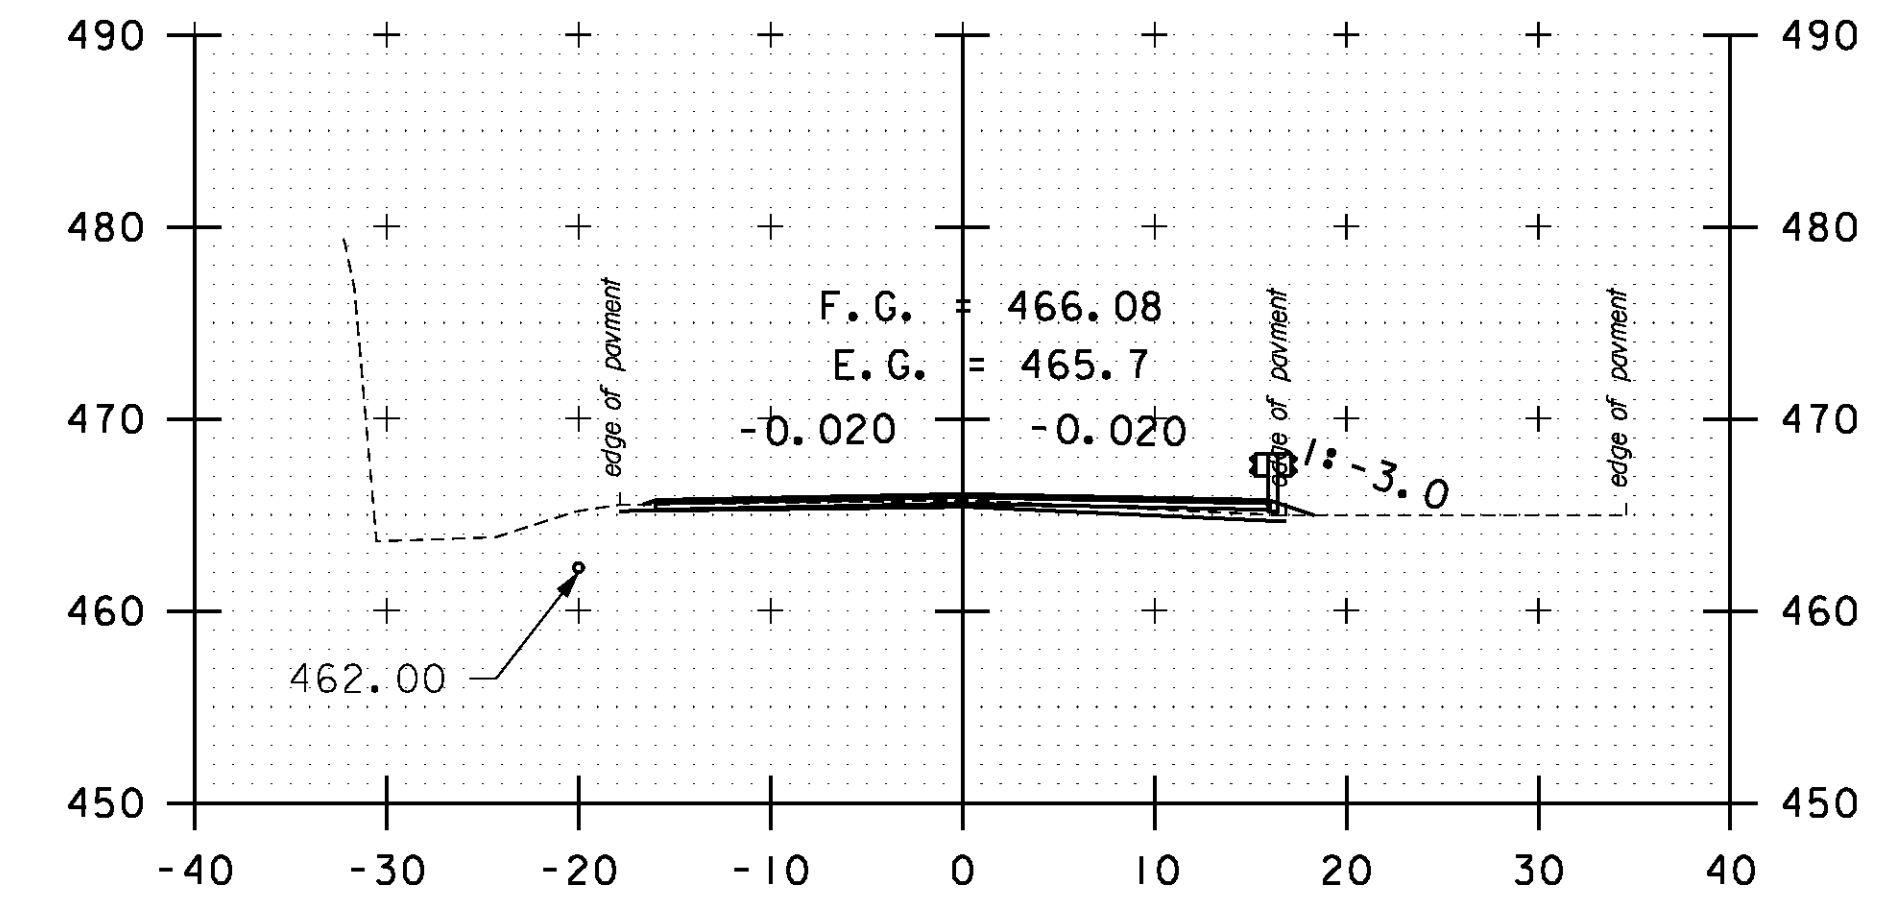


A 21+00

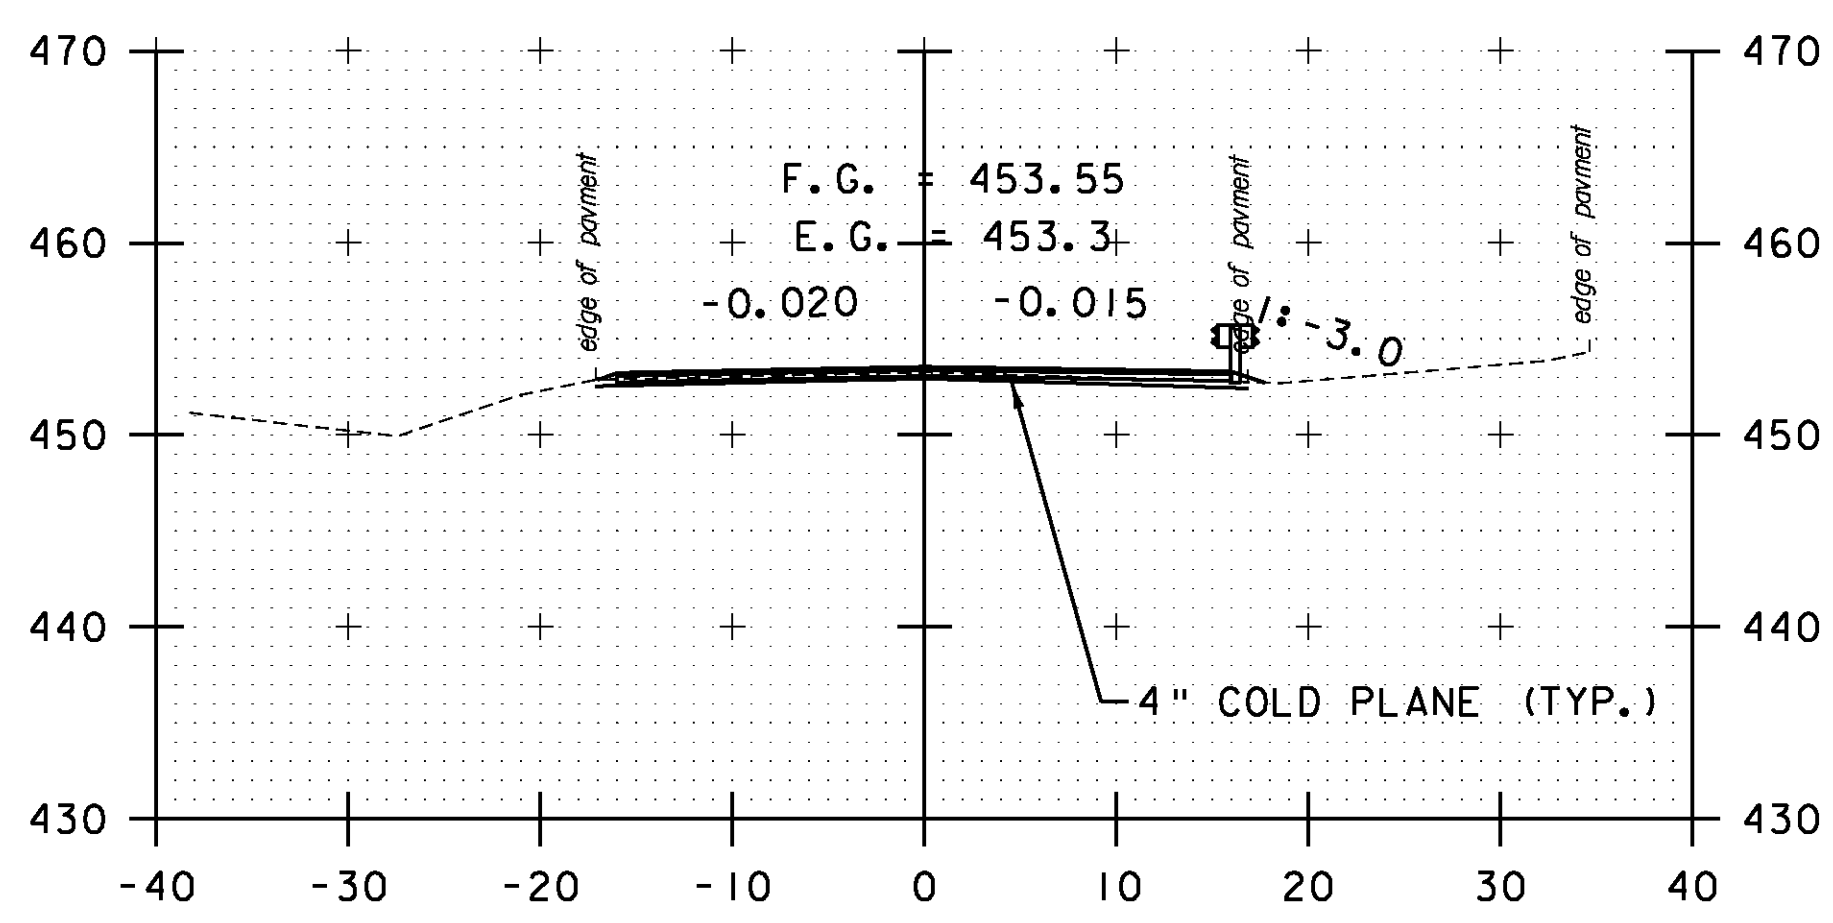


A 17+50

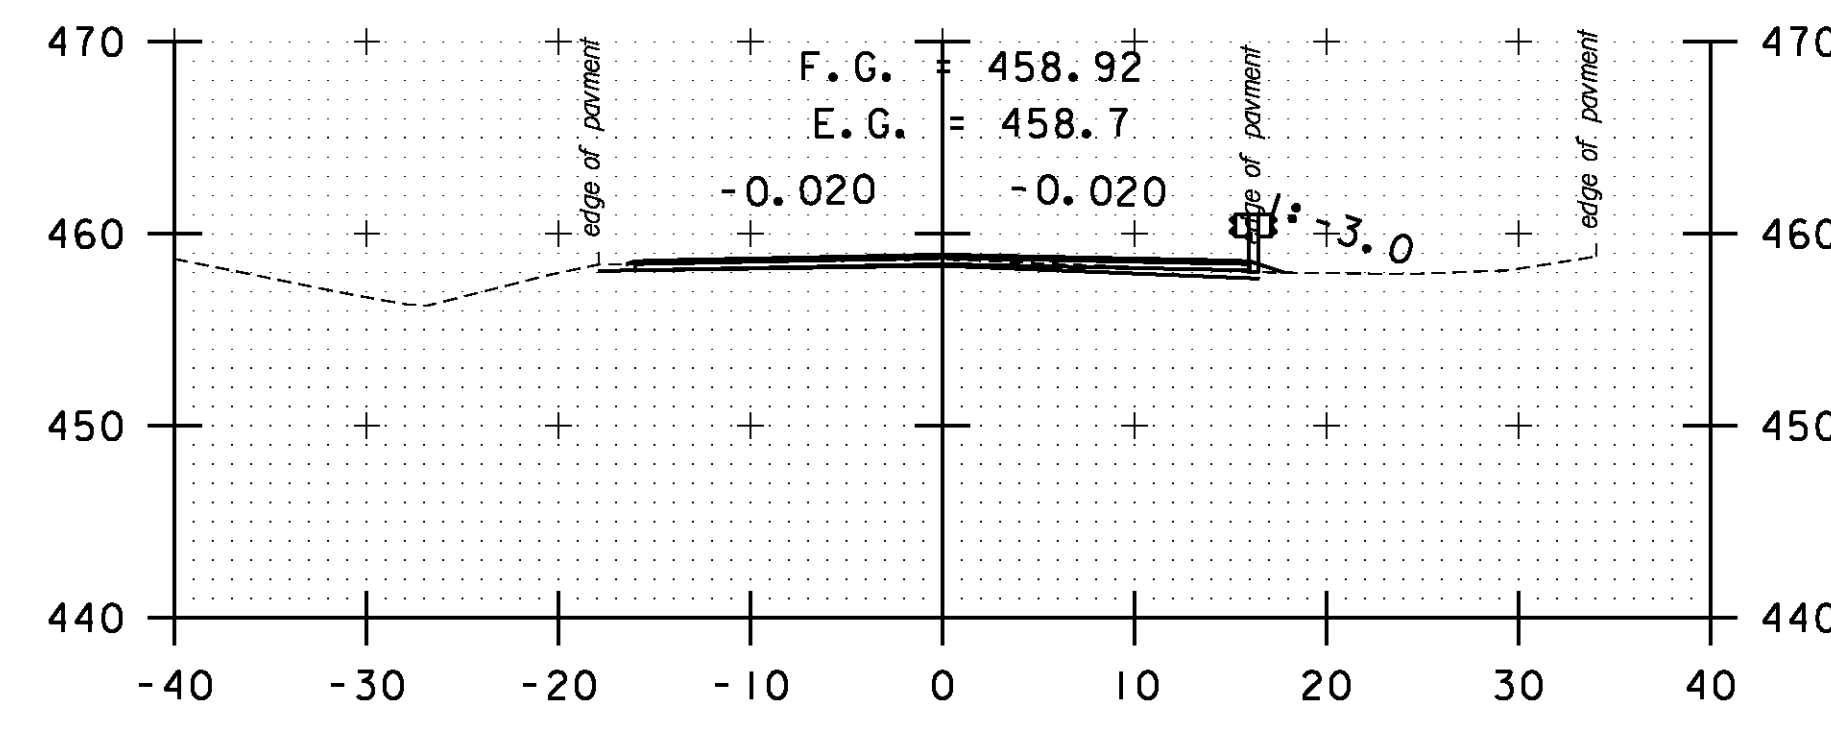


A 19+00

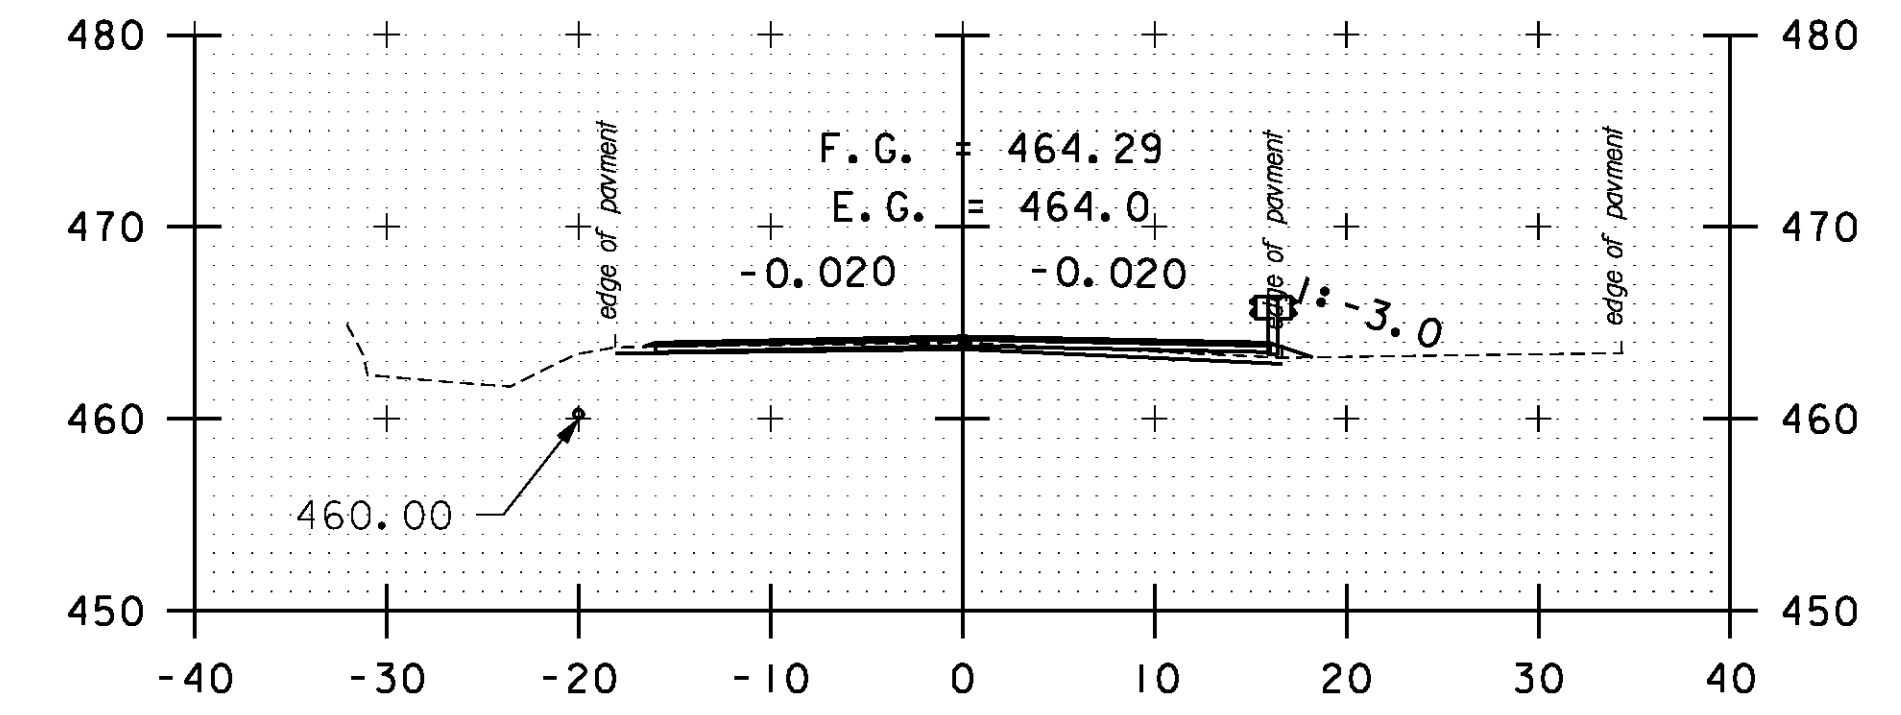


A 20+50

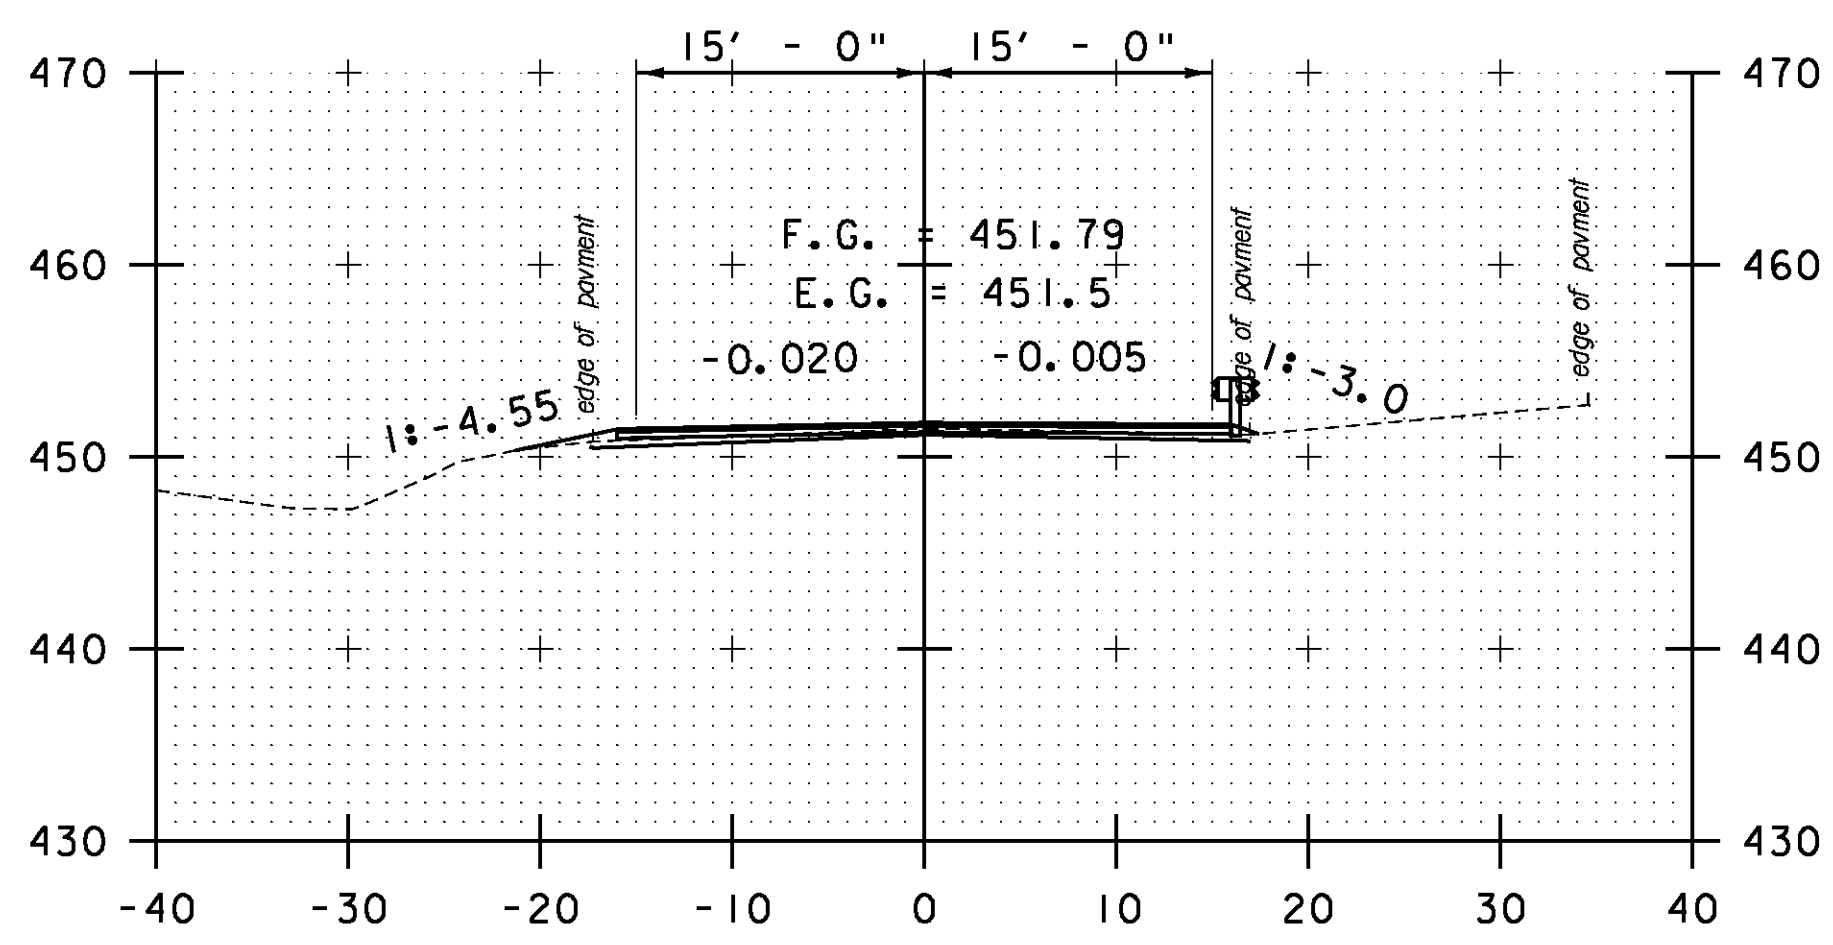

DRIVE LT
A 17+00

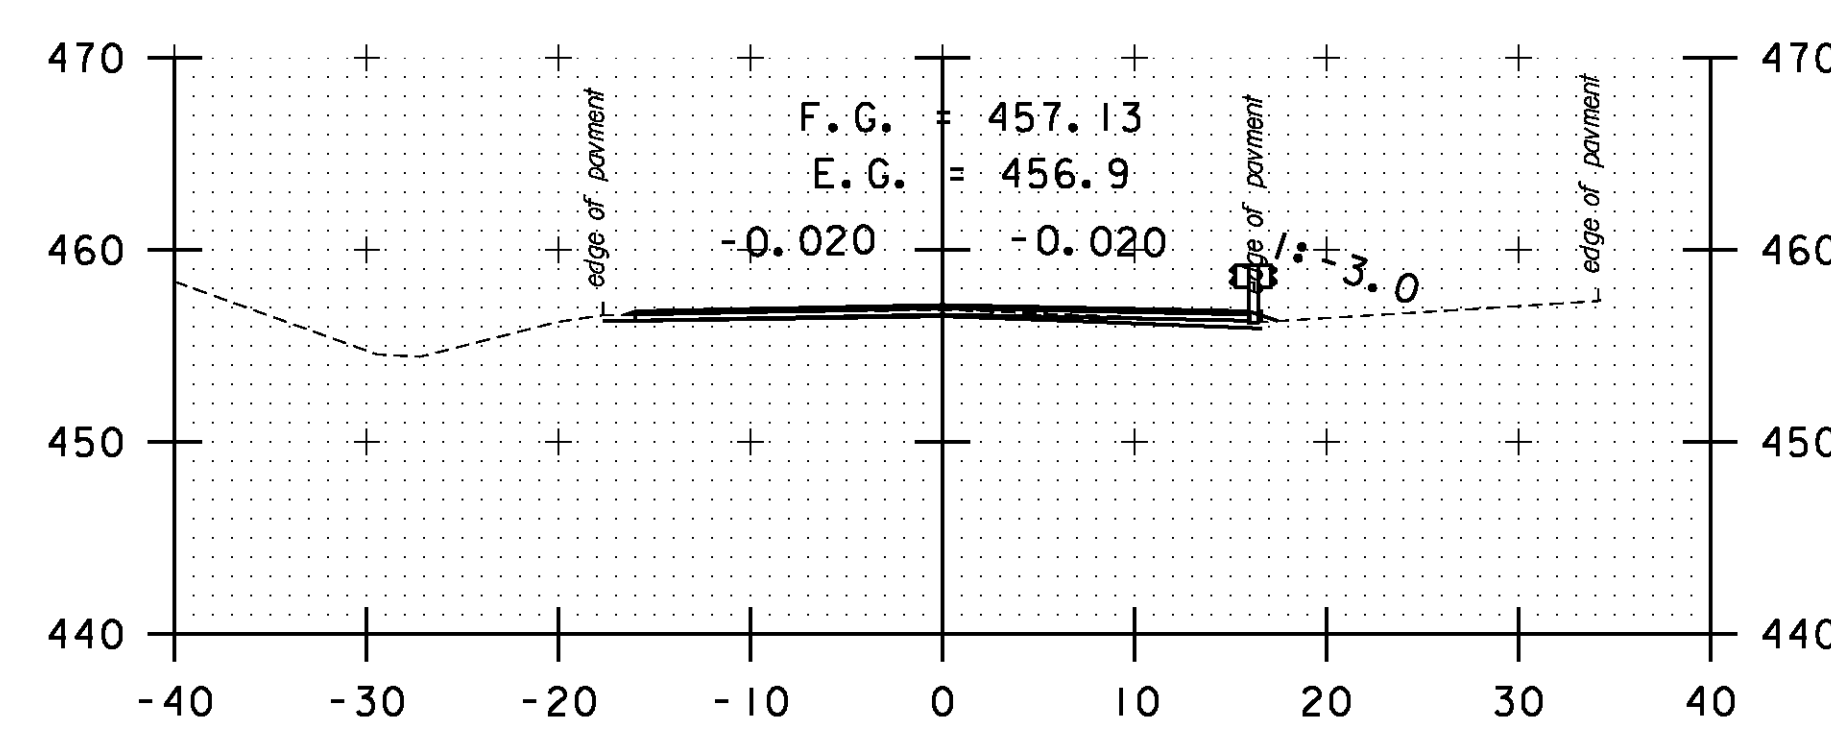


A 18+50

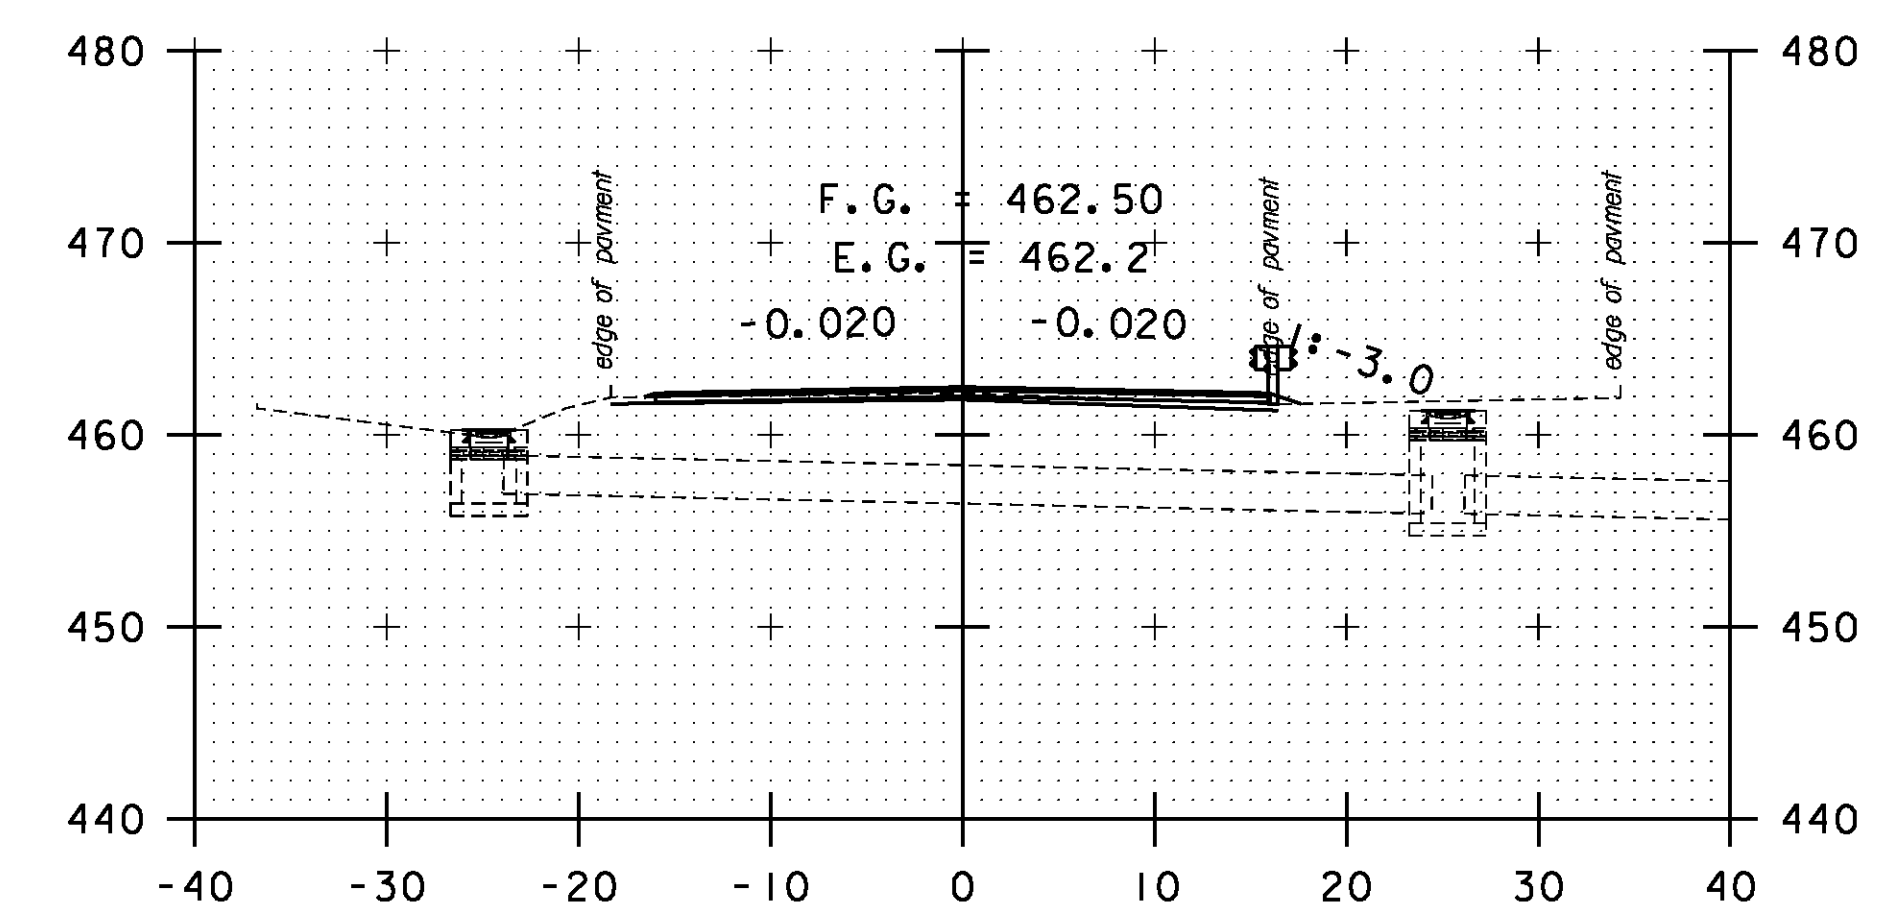

A 20+00

STA. A 17+00 TO STA. A 21+00

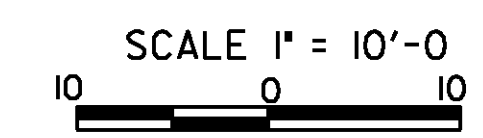

CROSS SECTION SHEET 51

PROJECT NAME: BOLTON-WATERBURY	PLOT DATE: 4/16/2013
PROJECT NUMBER: STP 2709(I)	DRAWN BY: BMB
FILE NAME: p07C172.dgn	CHECKED BY: CDL
PROJECT LEADER: CDL	SHEET 177 OF 217
DESIGNED BY: BMB	
PLOT FILE: p07C172_177.I	