




A 31+50

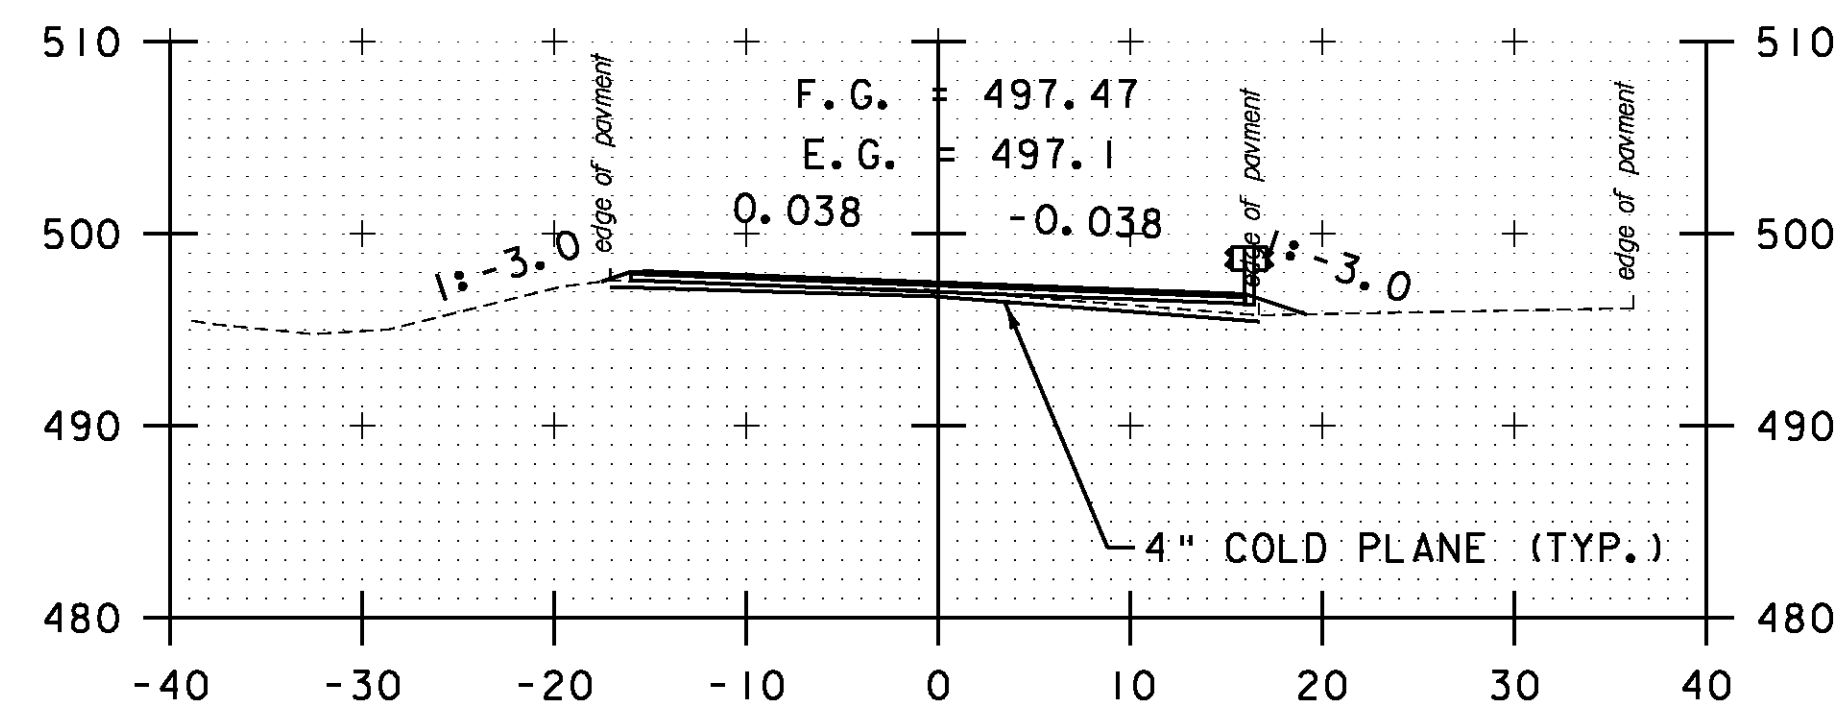


A 31+00

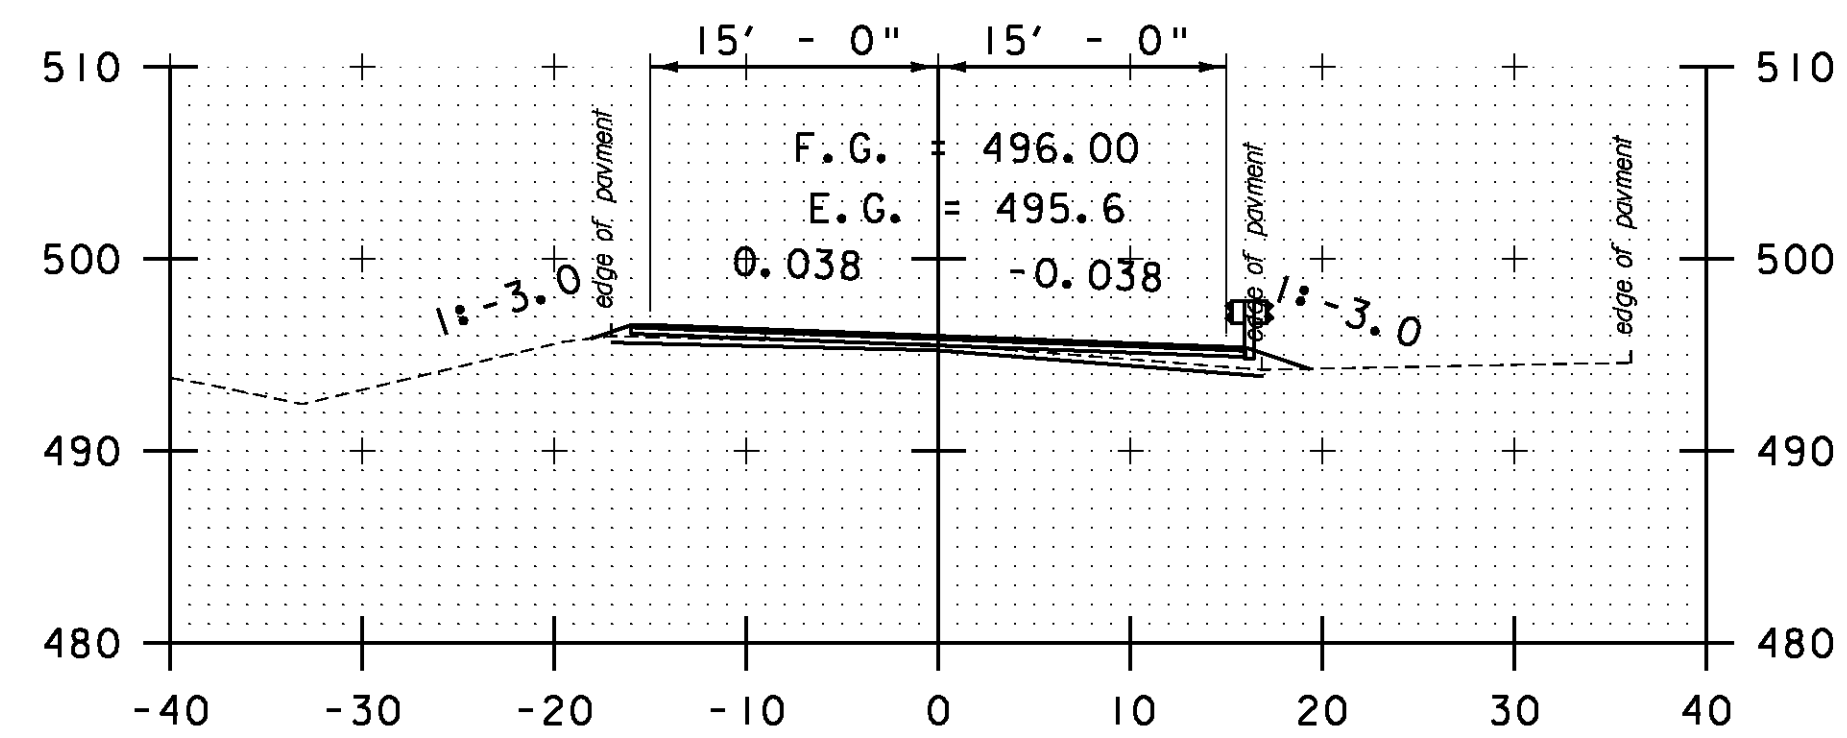


A 30+50

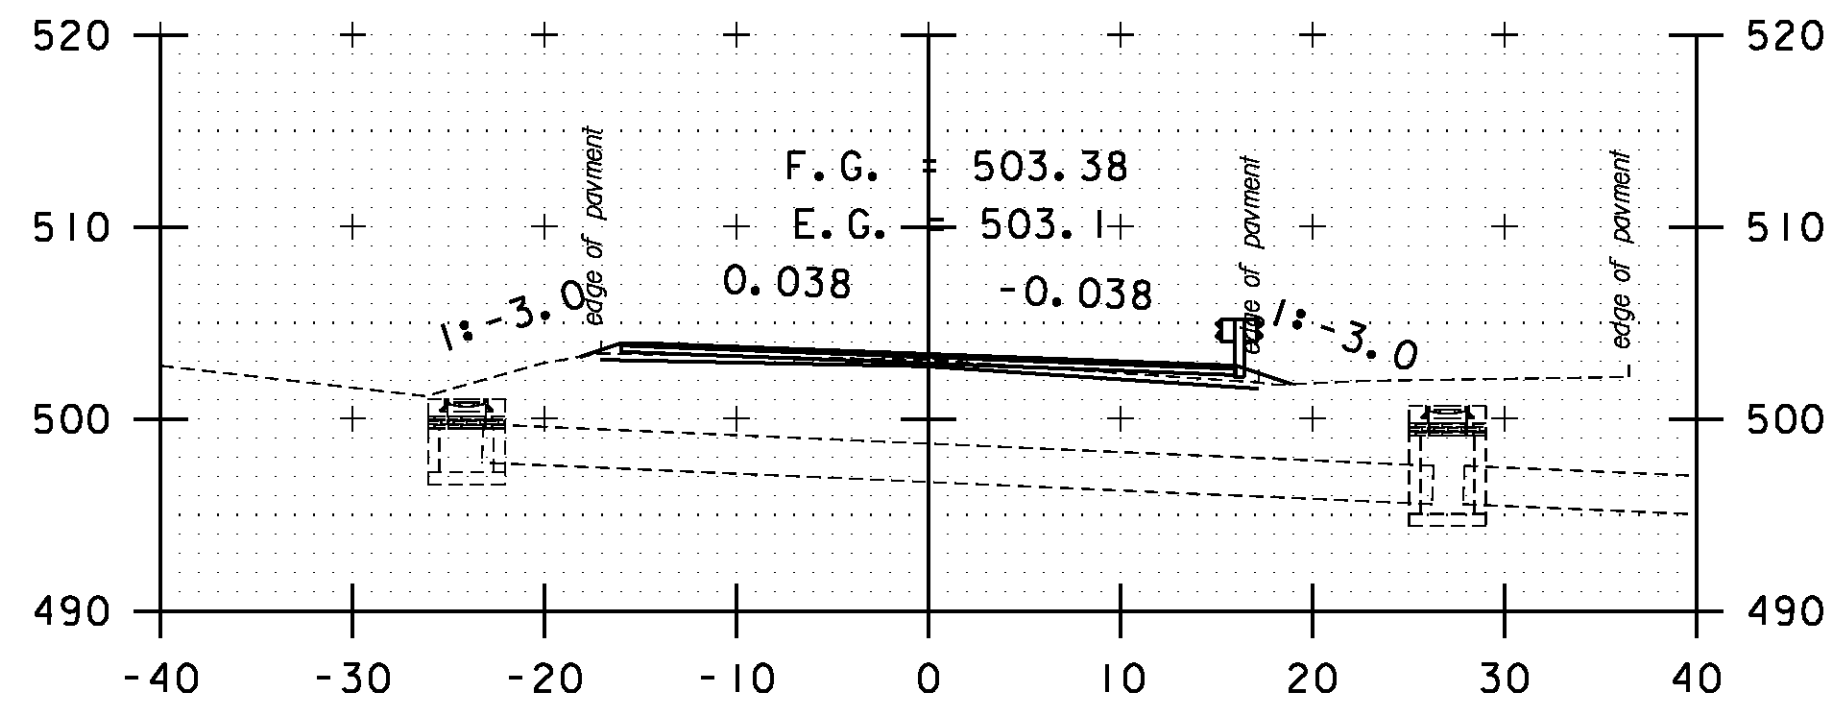


A 33+00

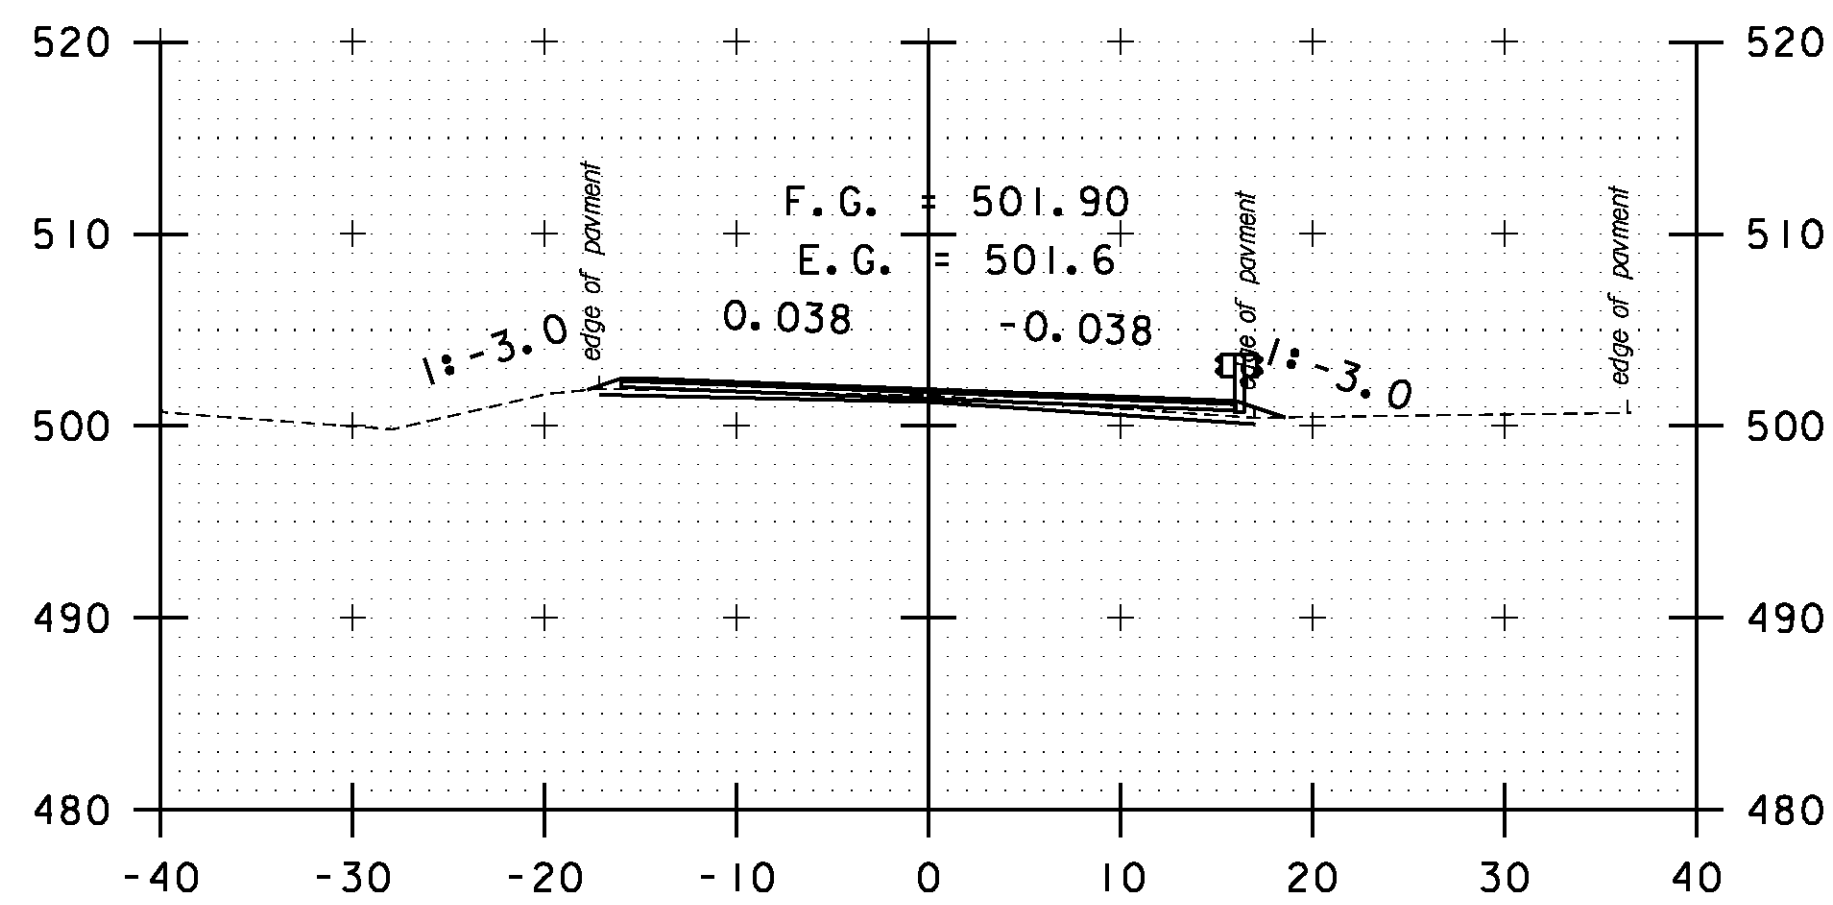


A 32+50

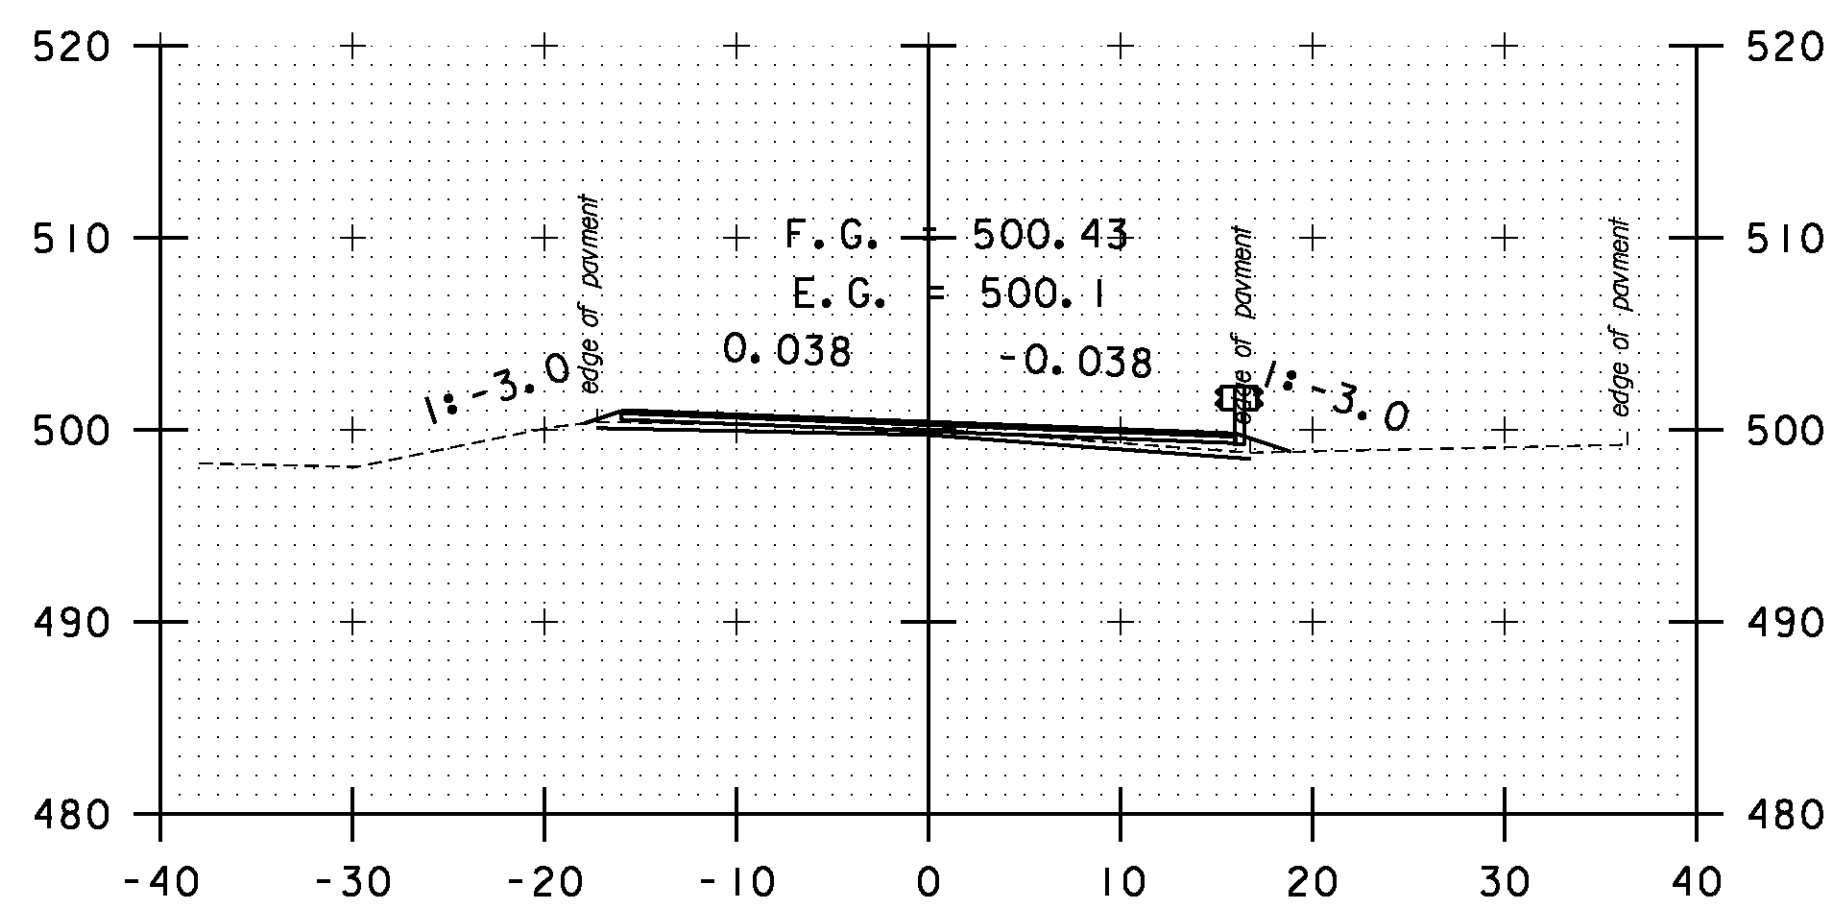


A 32+00

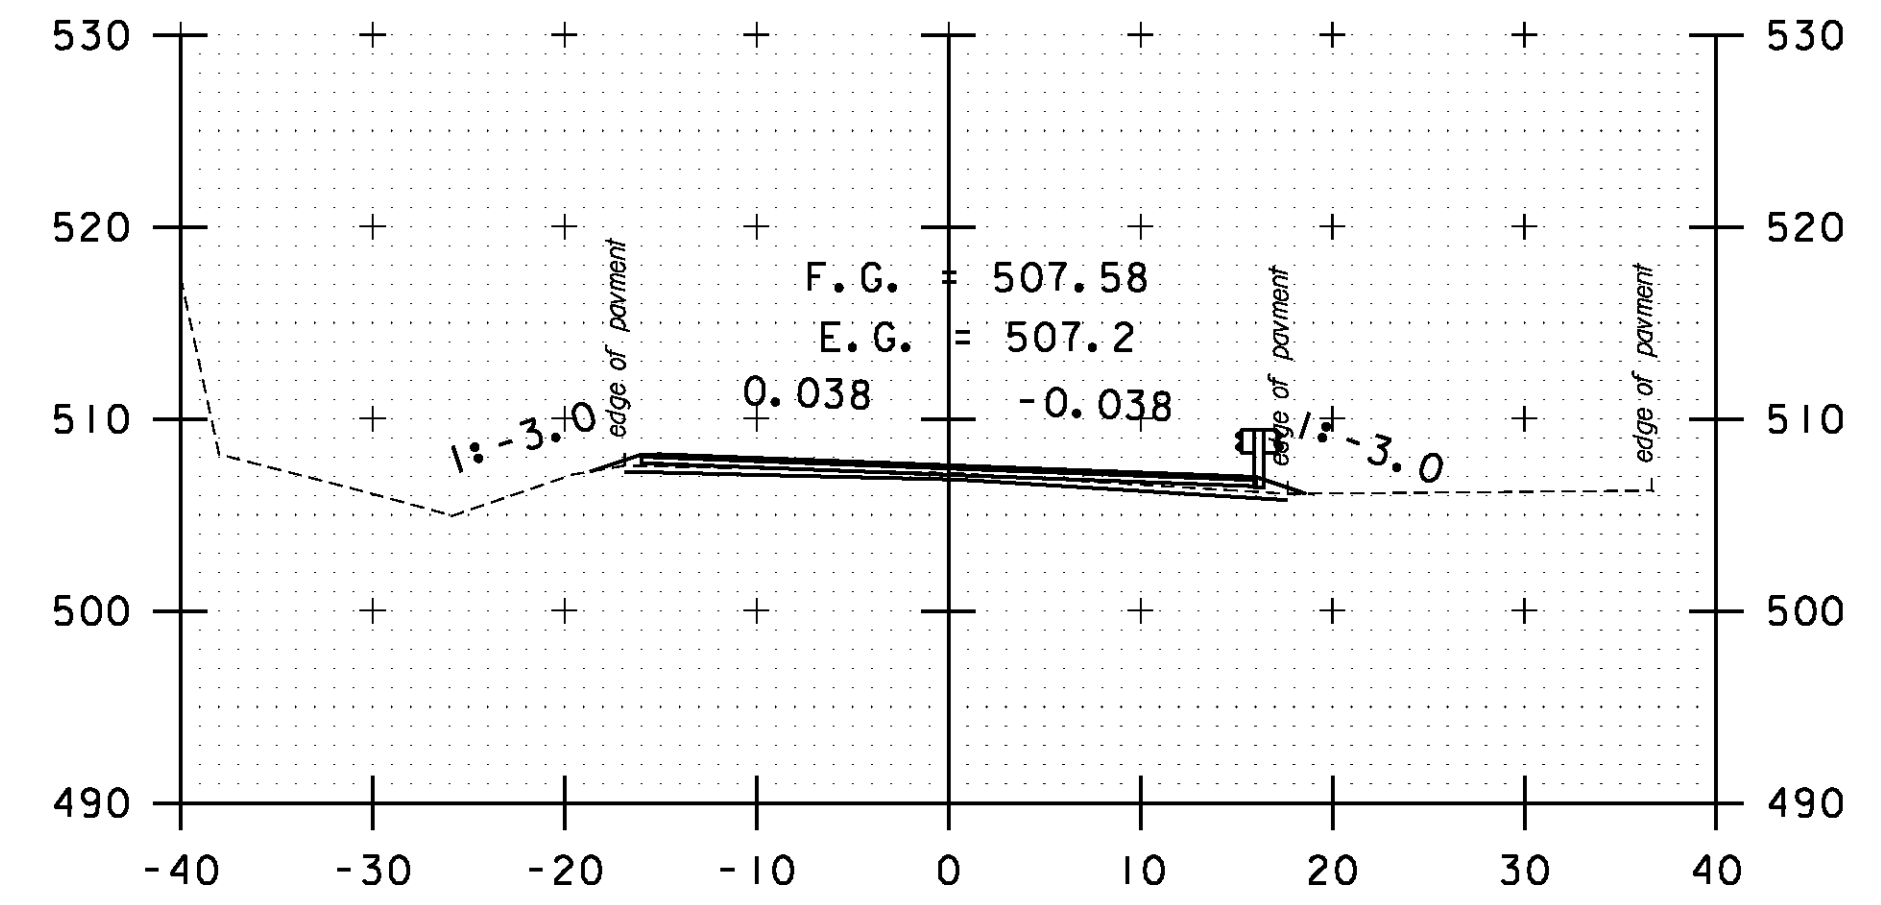

A 34+50

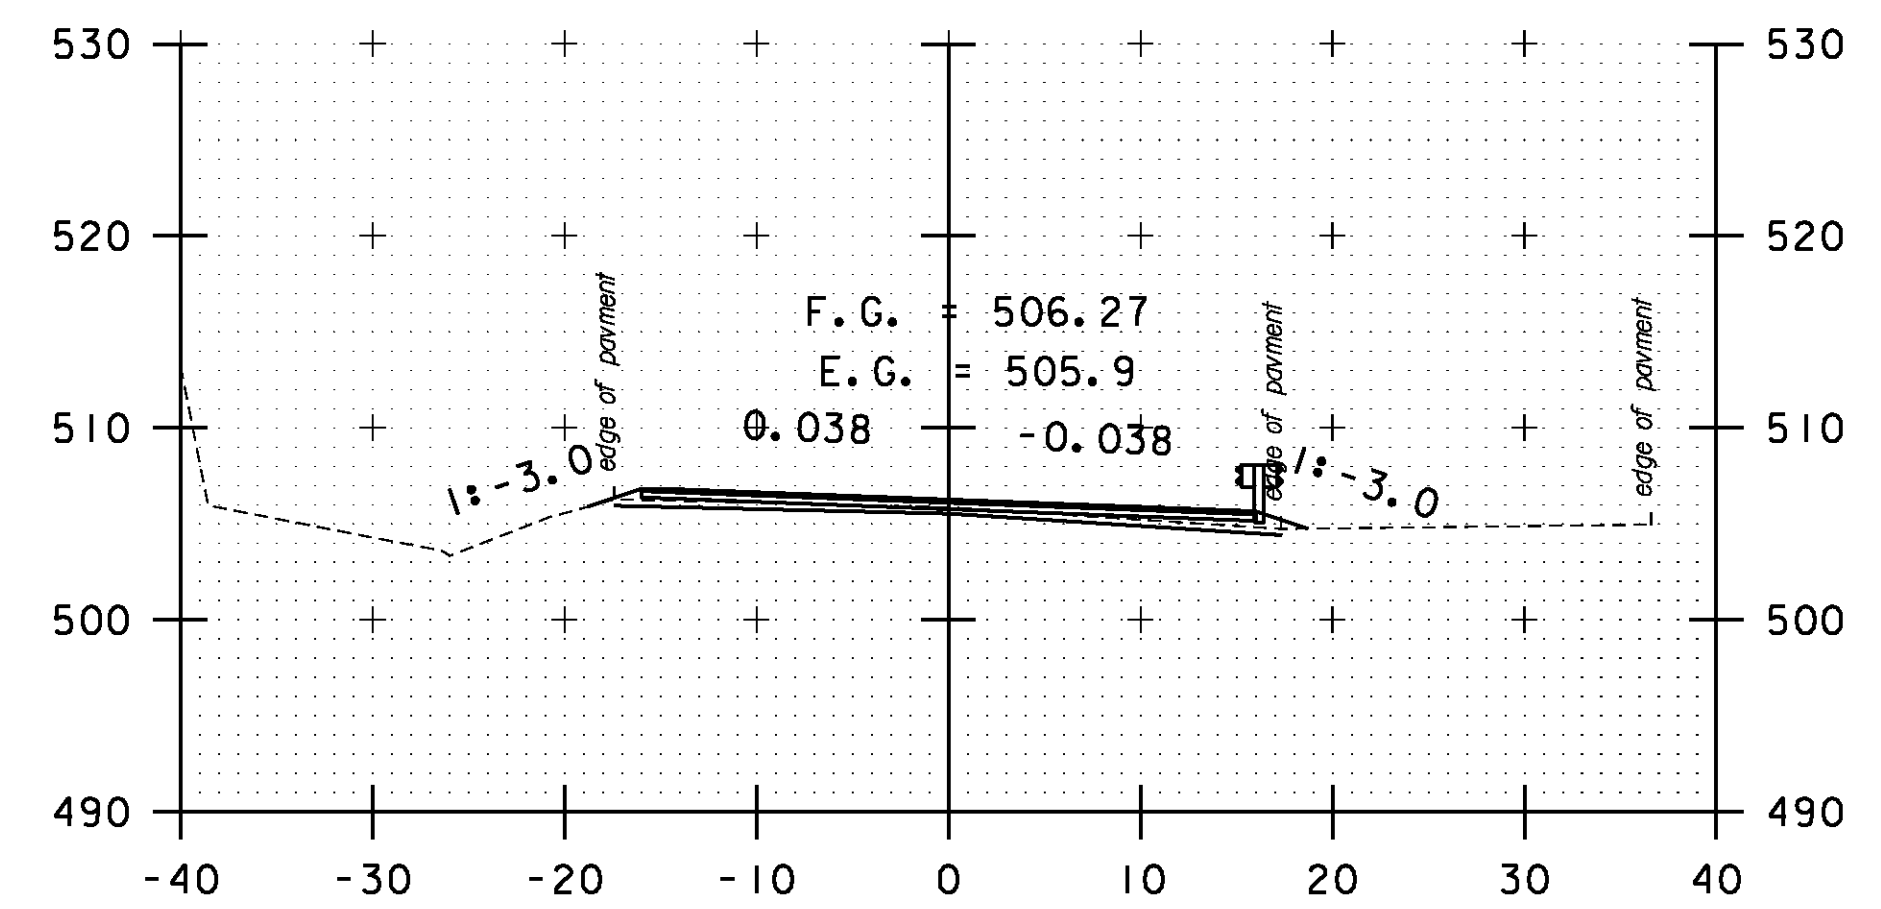

A 34+00

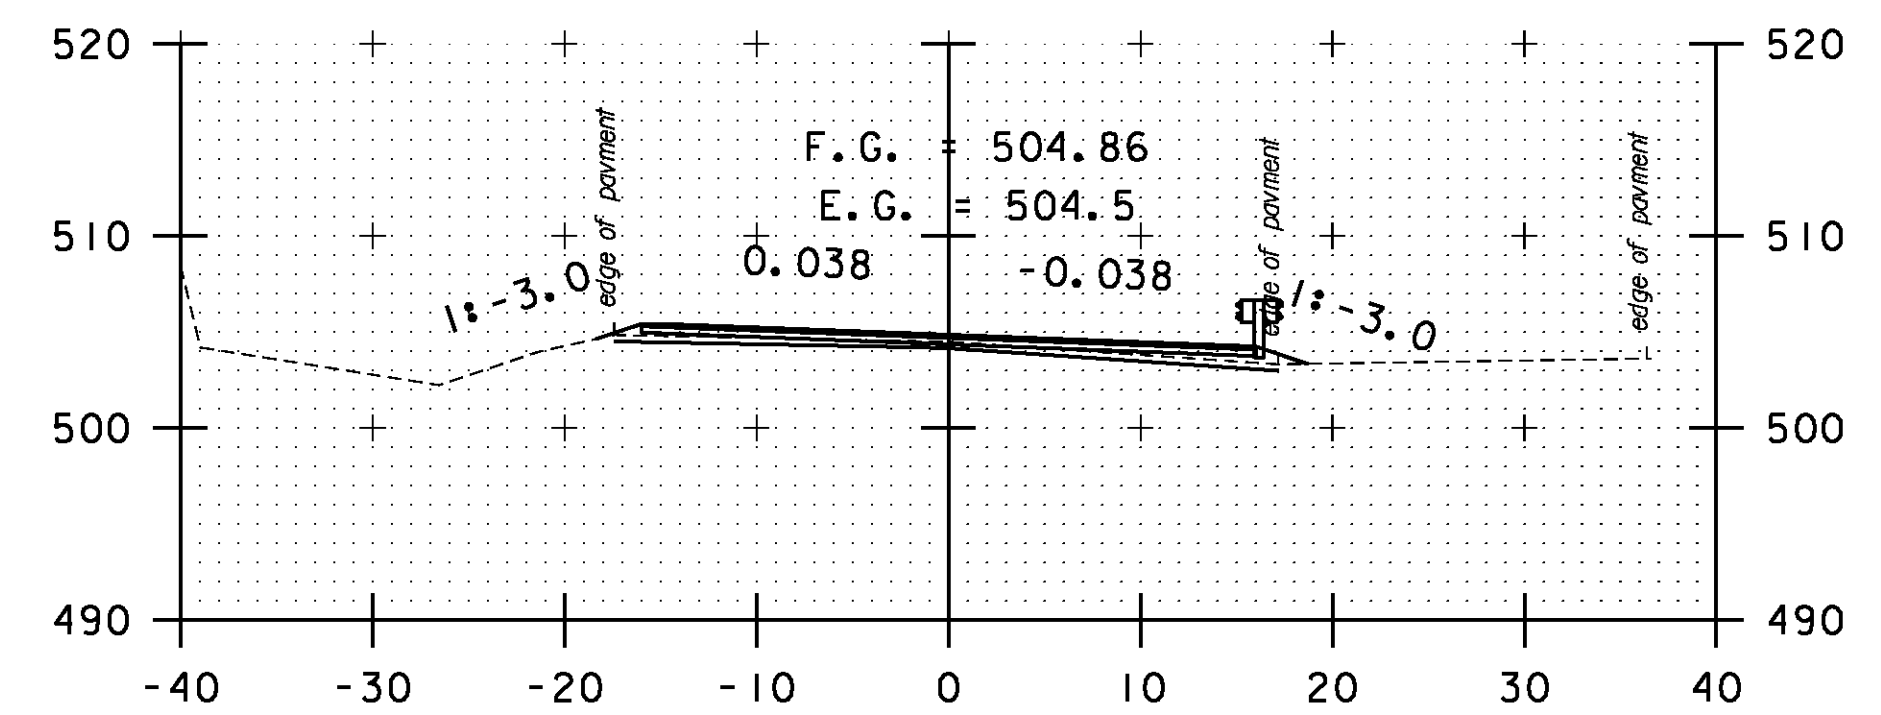

A 33+50

STA. A 30+50 TO STA. A 34+50



CROSS SECTION SHEET 54

PROJECT NAME: BOLTON-WATERBURY

PROJECT NUMBER: STP 2709(1)

FILE NAME: p07C172.dgn

PROJECT LEADER: CDL

DESIGNED BY: BMB

PLOT FILE: p07C172_180.1

PLOT DATE: 4/16/2013

DRAWN BY: BMB

CHECKED BY: CDL

SHEET 180 OF 217