




A 36+00

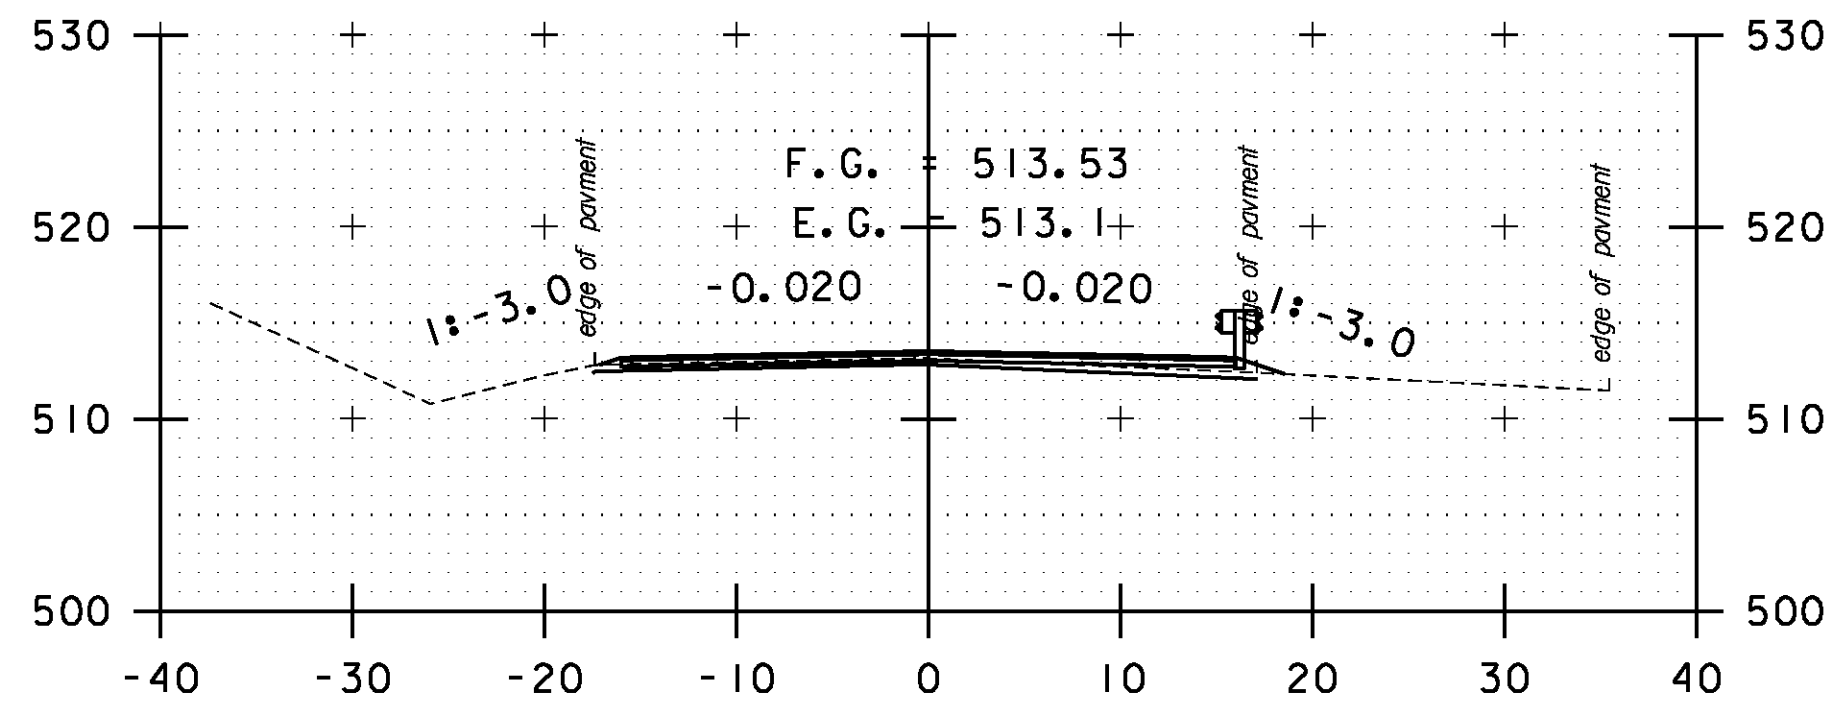


A 37+50

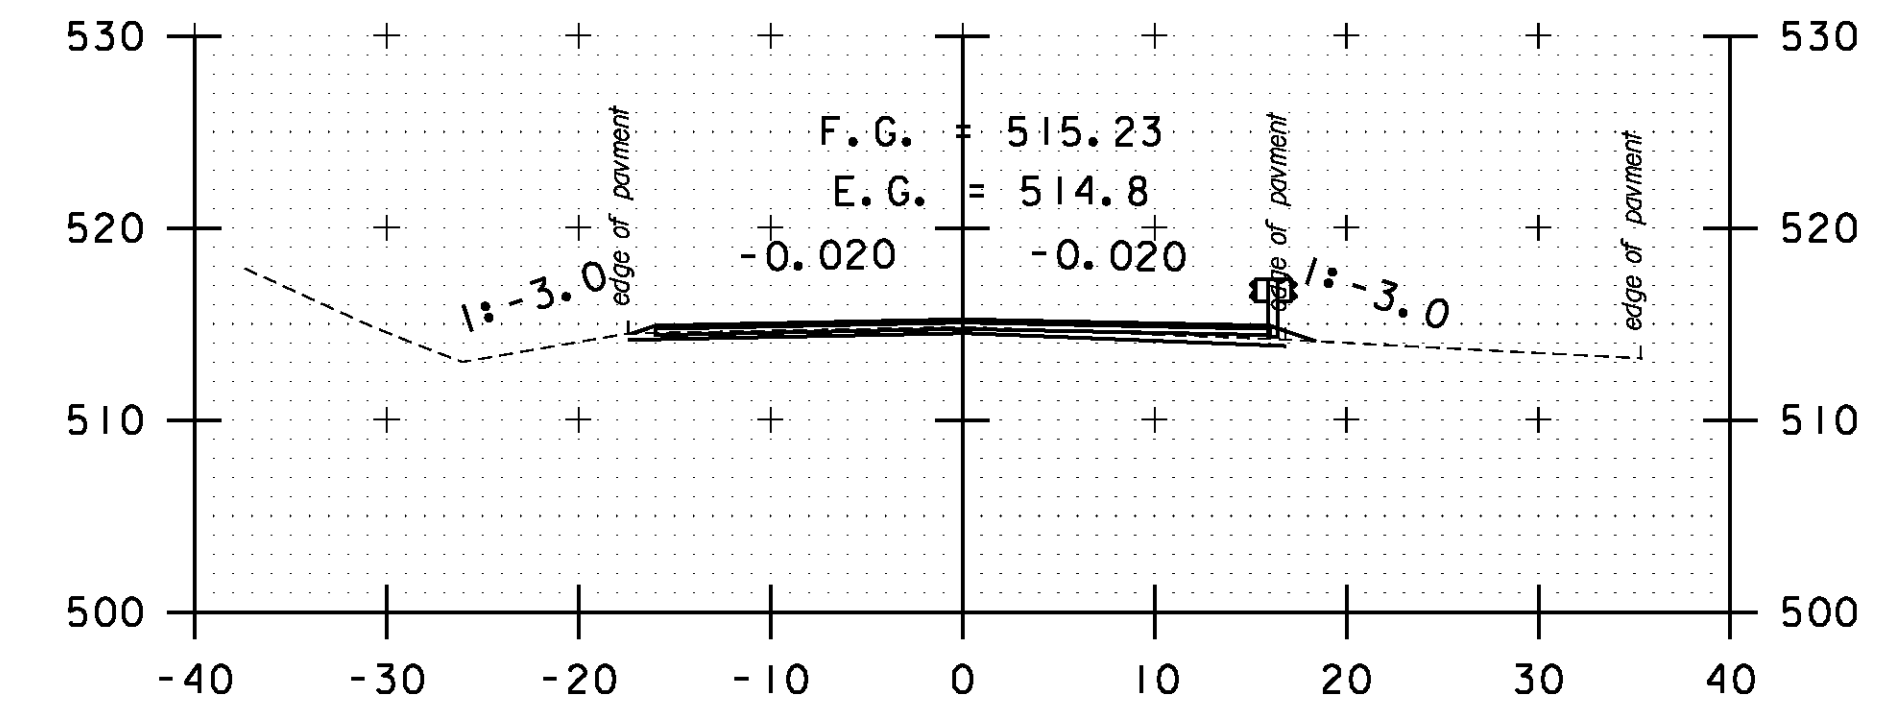


A 39+00

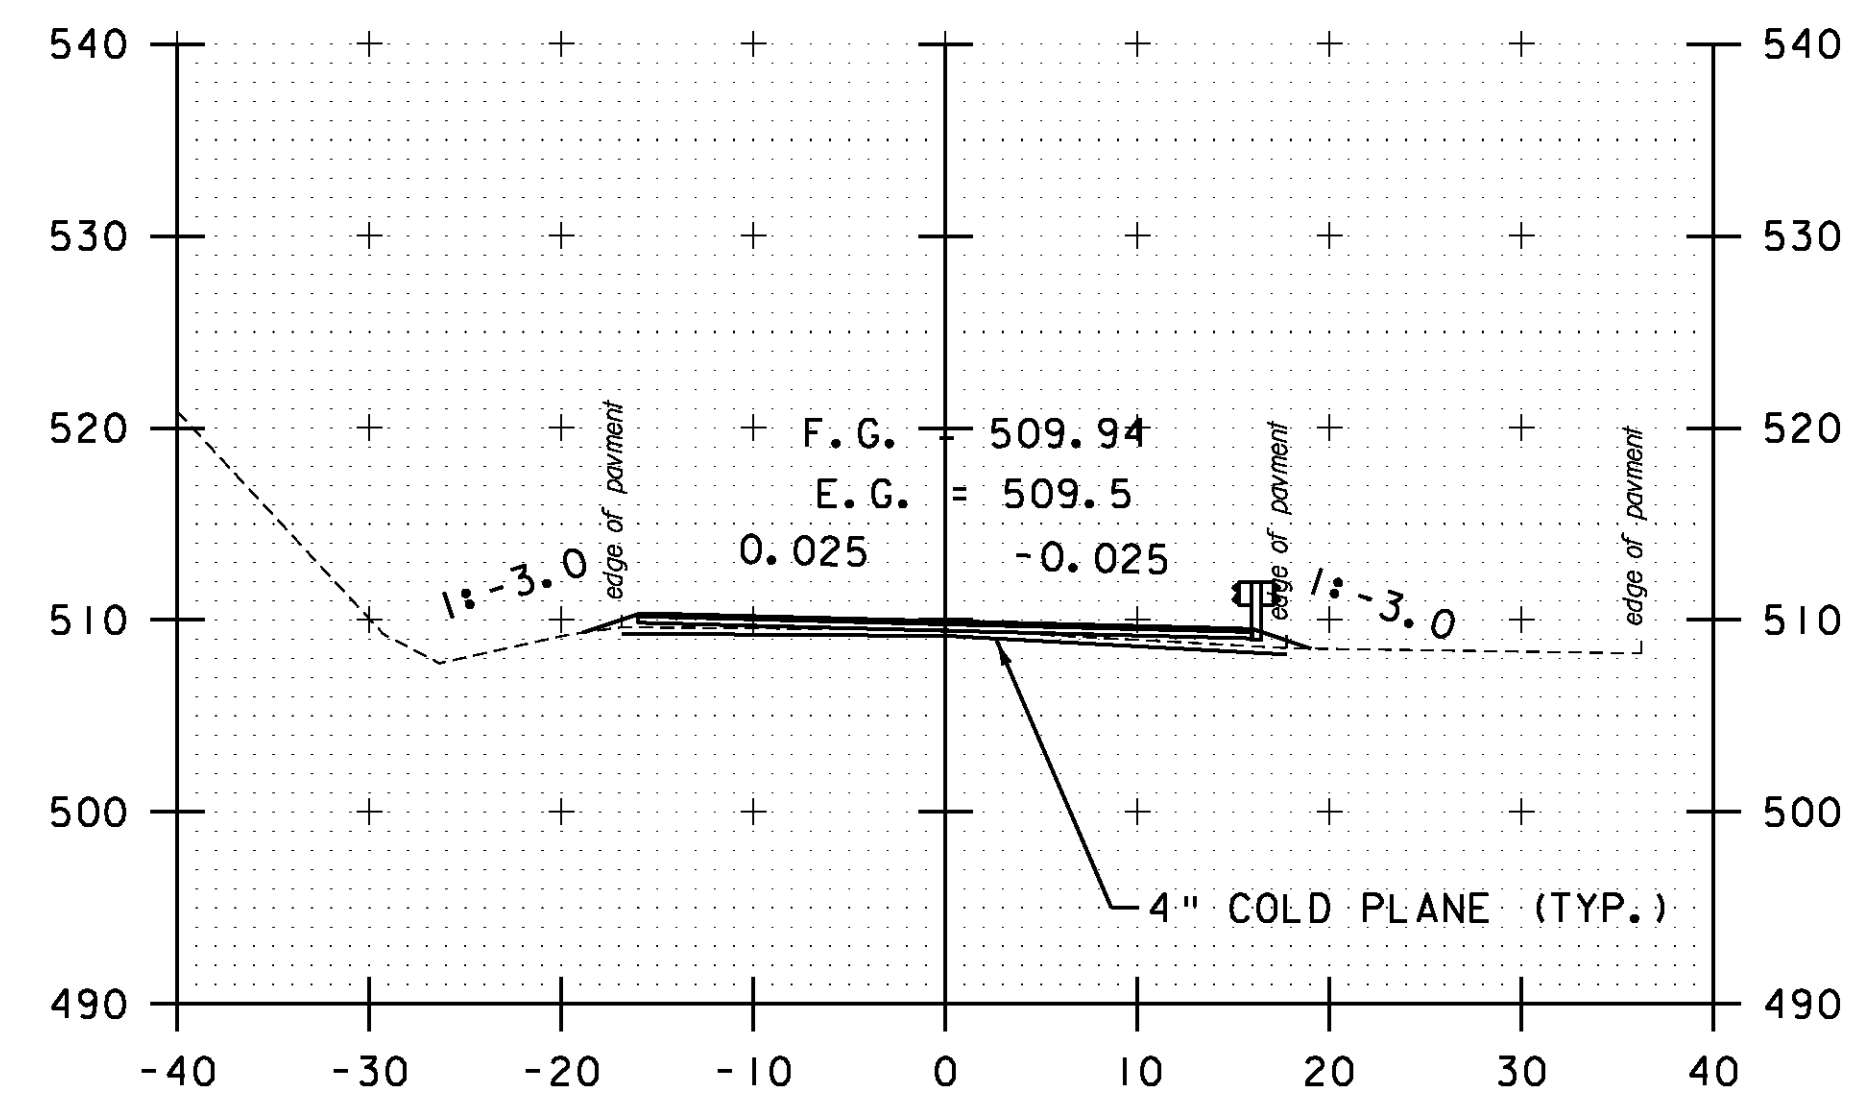


A 35+50

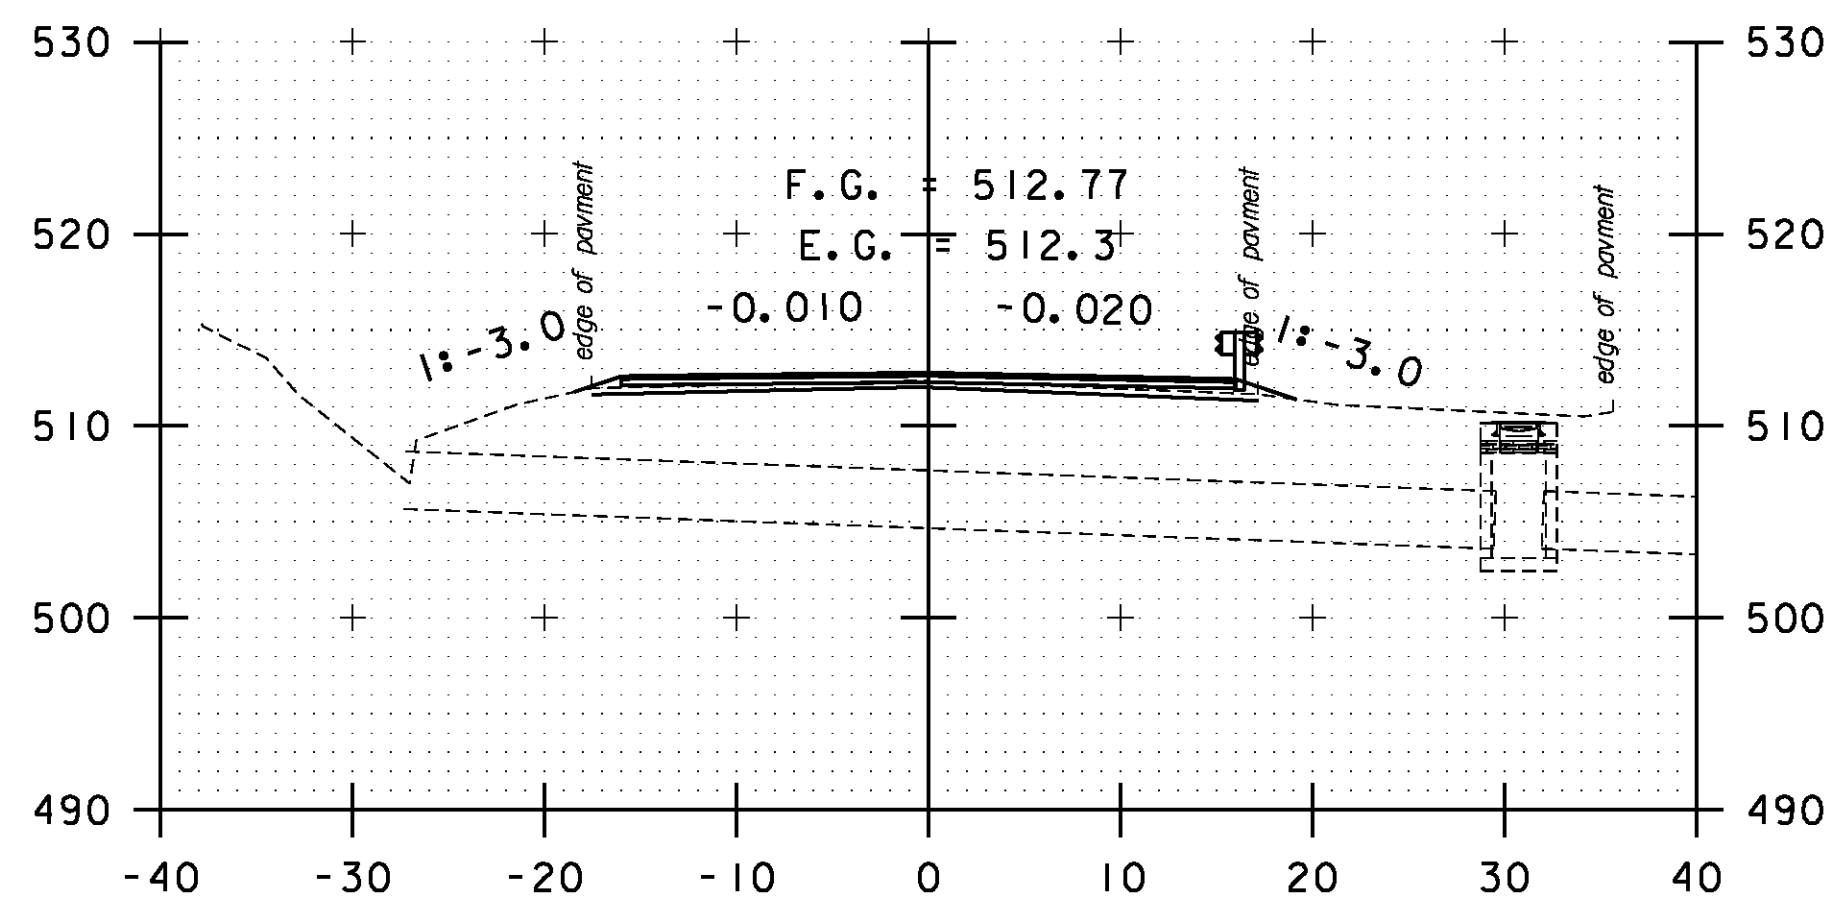


A 37+00

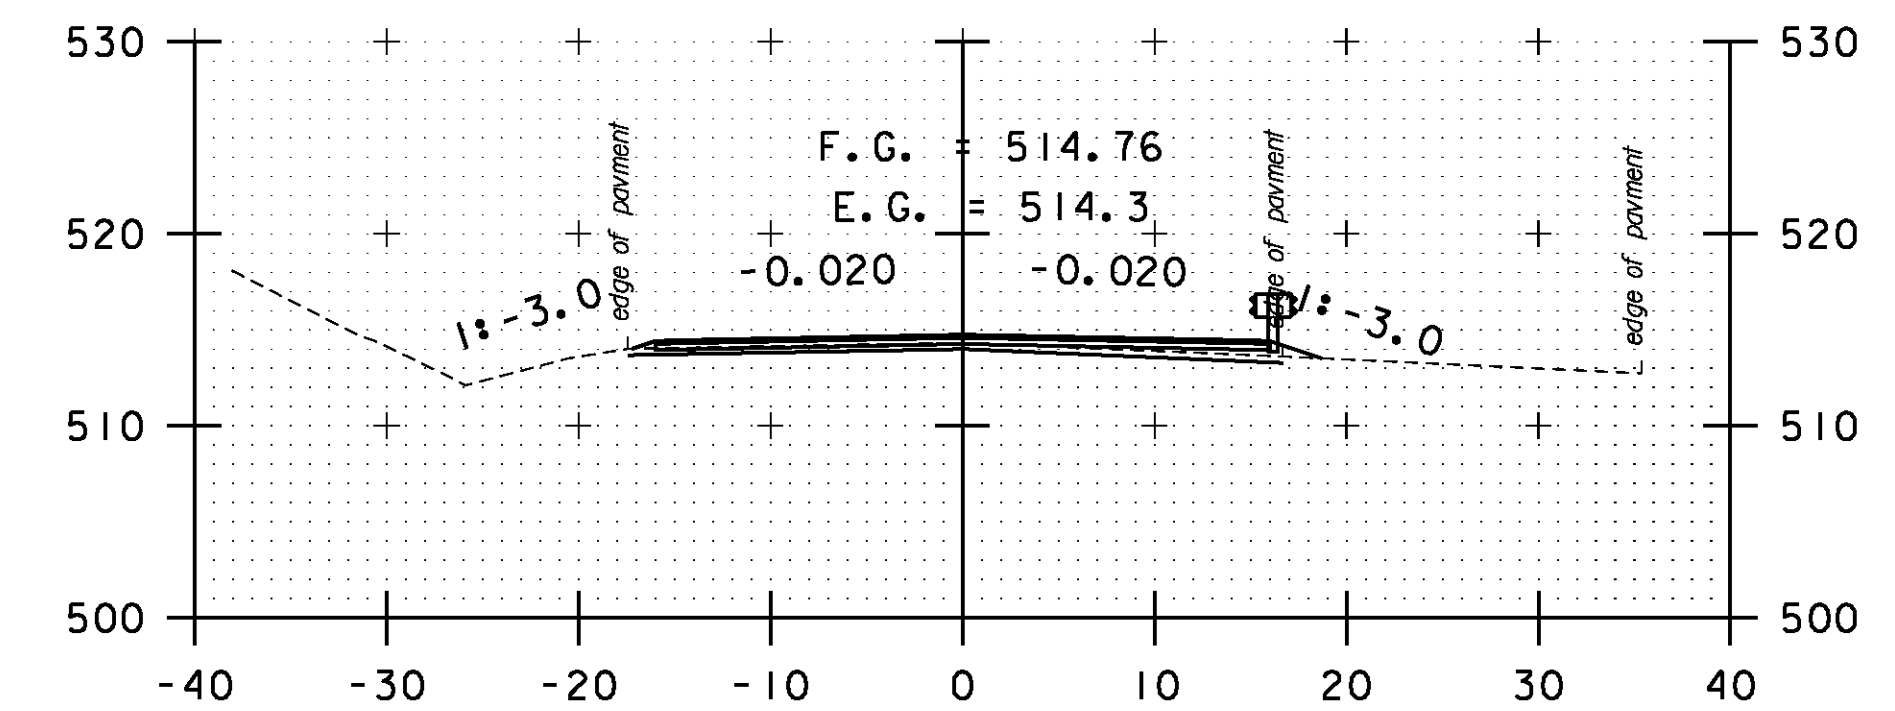


A 38+50

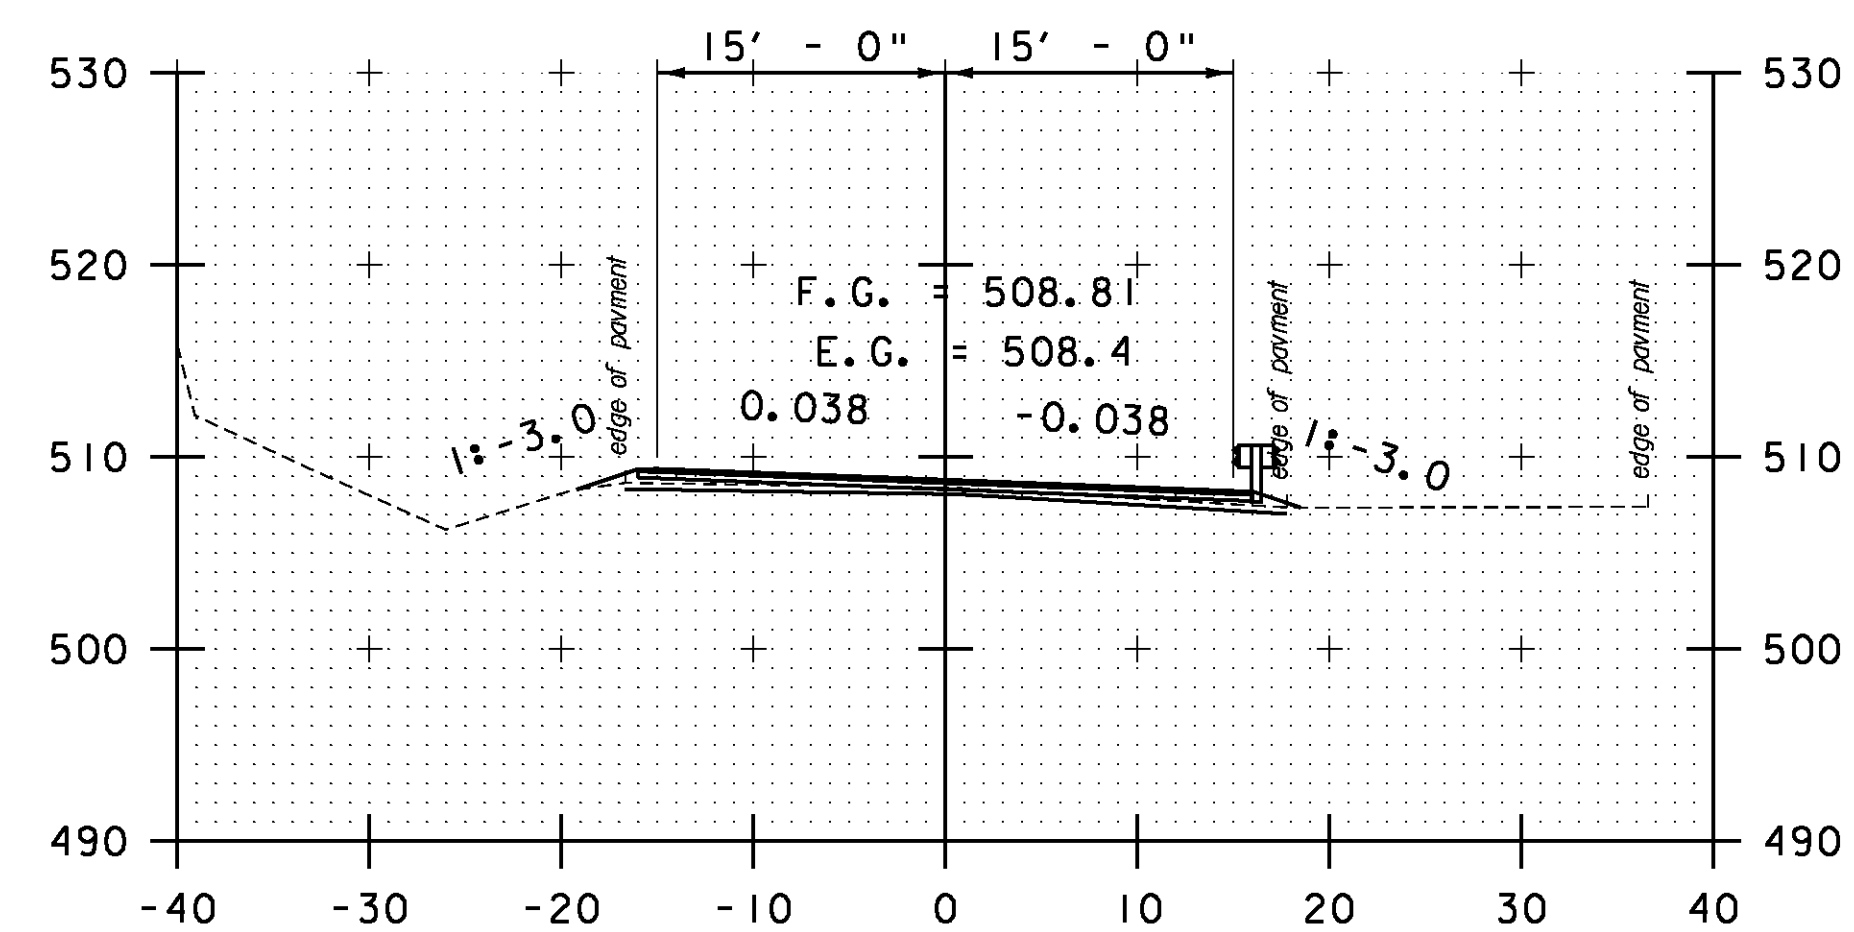

A 35+00

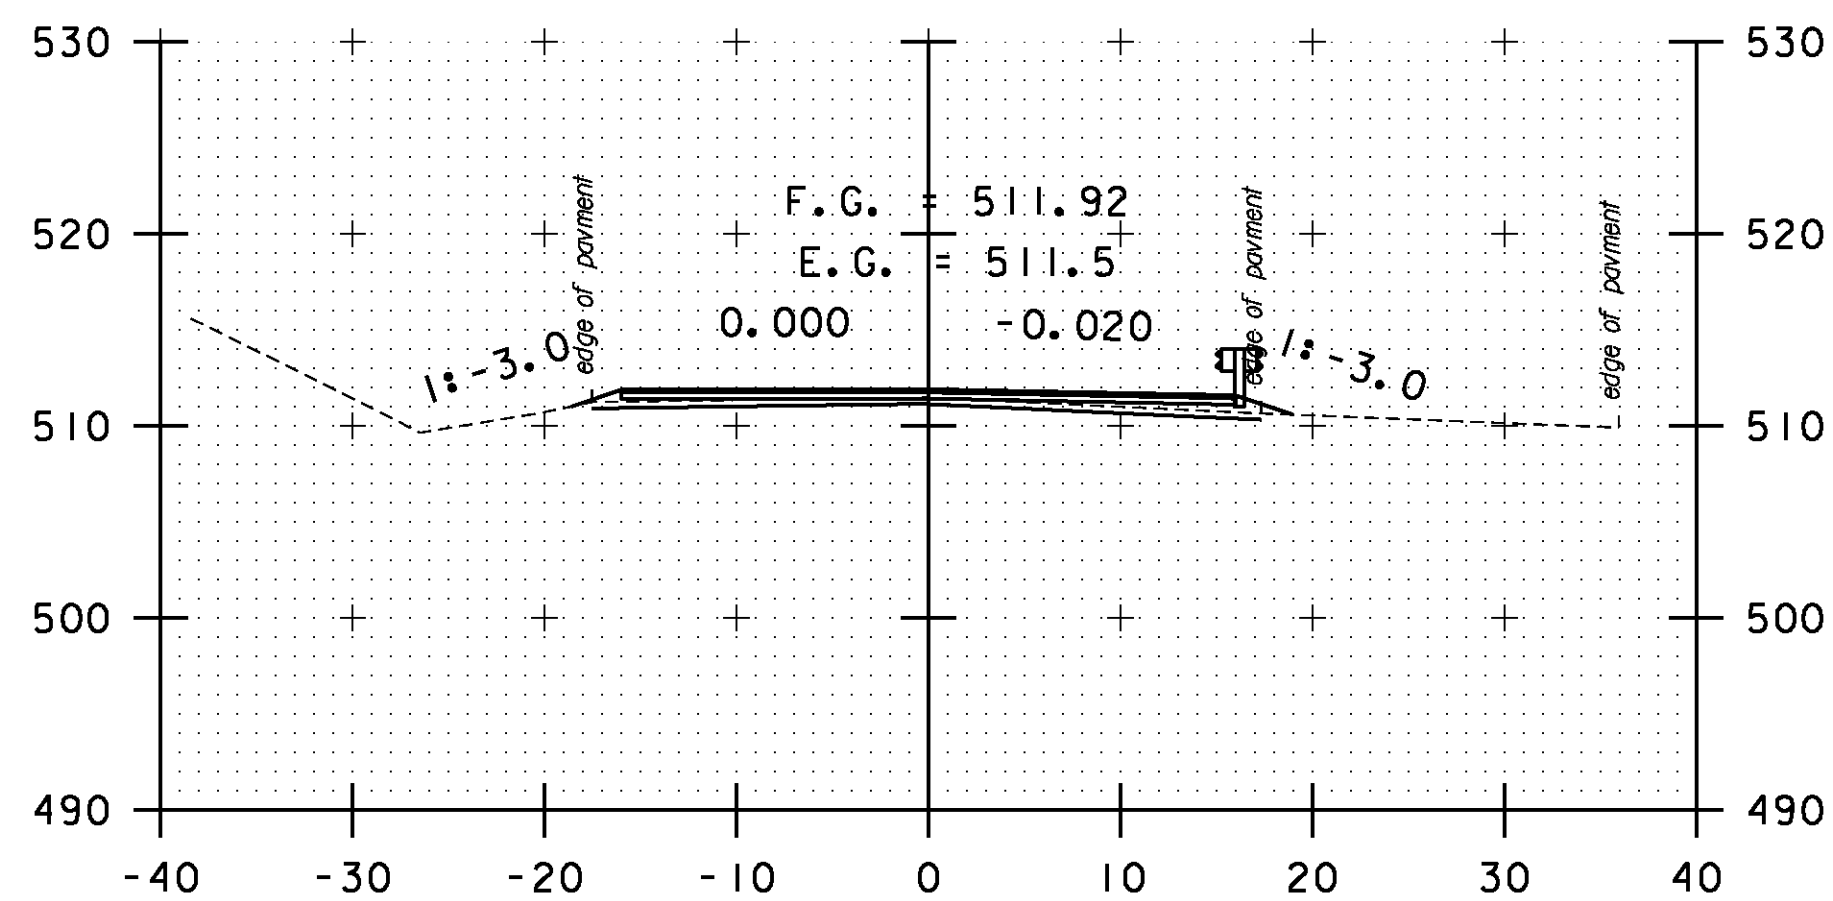

A 36+50

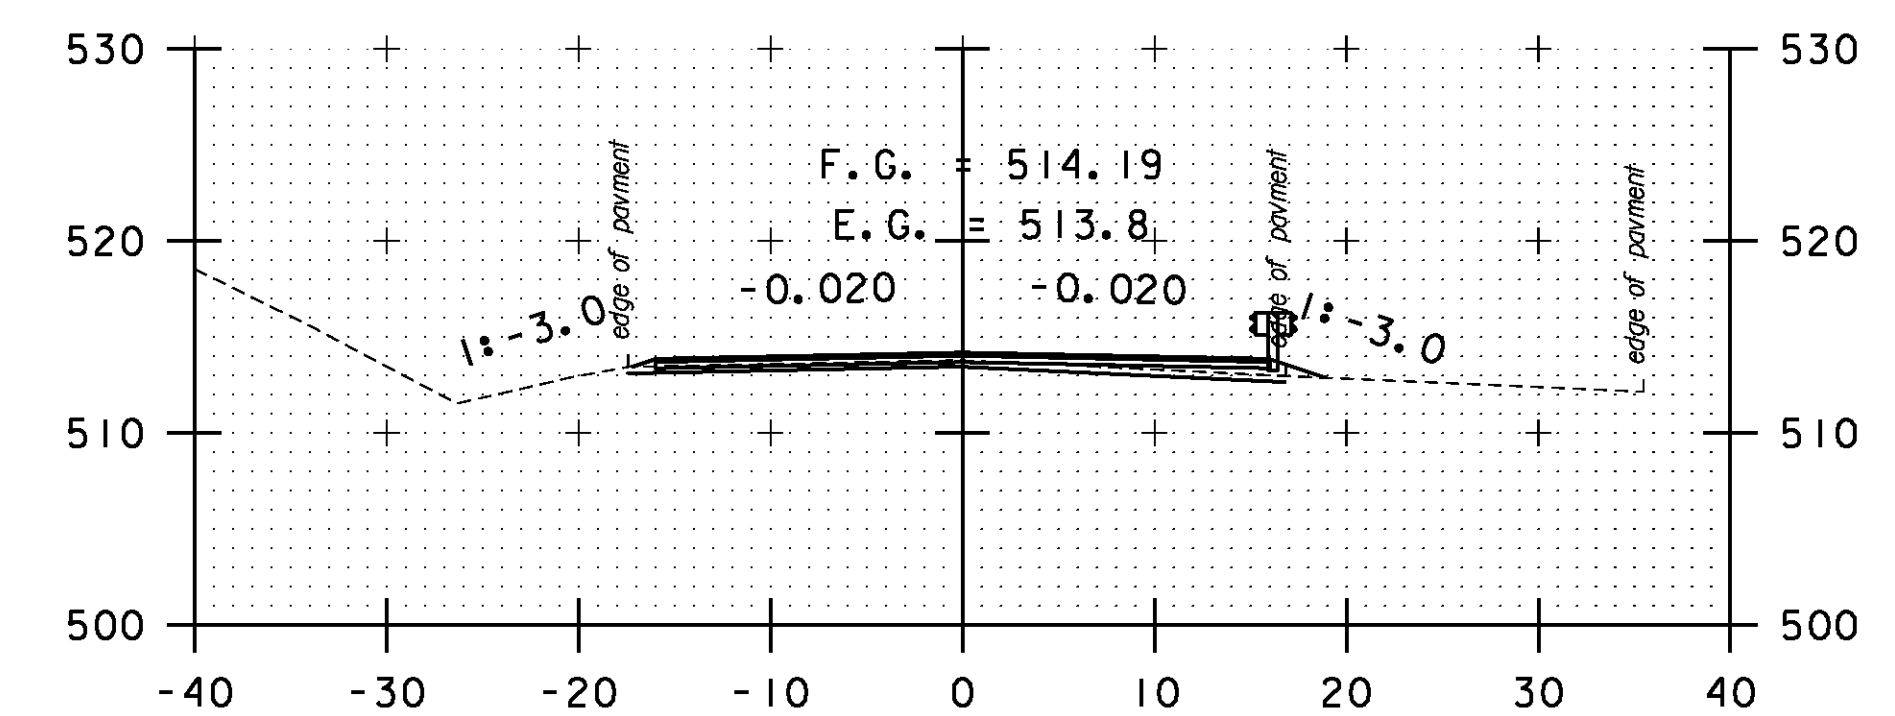

A 38+00

STA. A 35+00 TO STA. A 39+00

SCALE 1" = 10'-0"
0 10

CROSS SECTION SHEET 55

PROJECT NAME: BOLTON-WATERBURY

PROJECT NUMBER: STP 2709(I)

FILE NAME: p07C172.dgn

PROJECT LEADER: CDL

DESIGNED BY: BMB

PLOT FILE: p07C172_181.t

PLOT DATE: 4/16/2013

DRAWN BY: BMB

CHECKED BY: CDL

SHEET 181 OF 217